	INDEX TO DRAWINGS	
SHEET NO.	DESCRIPTION	
	TITLE SHEET	
2	STANDARD PLAN SUMMARY SHEET	
3	GENERAL NOTES AND LEGEND	
4-5	TYPICAL SECTIONS AND DETAILS	
6-8	PLANS	
9	PAVEMENT MARKING LEGEND,	
	DETAILS AND NOTES	
10 - 12	SIGNING AND PAVEMENT MARKING	
	PLANS	
13	SIGN DETAILS AND NOTES	
14	MISCELLANEOUS SUMMARIES	

Plan Sht. No. 12 S-1 is a supplementary sheet to this project.

TOTAL SHEET COUNT after "AS BUILT" postings.

15 Sheets.

STATE OF HAWAII

DEPARTMENT OF TRANSPORTATION


HIGHWAYS DIVISION HONOLULU, HAWAII


"AS-BUILT"

PLANS FOR

HALEAKALA HIGHWAY, WHARF STREET AND HOBRON STREET RESURFACING PROJECT NO. HWY-M-OI-9IM

DISTRICT OF WAILUKU
ISLAND OF MAUI

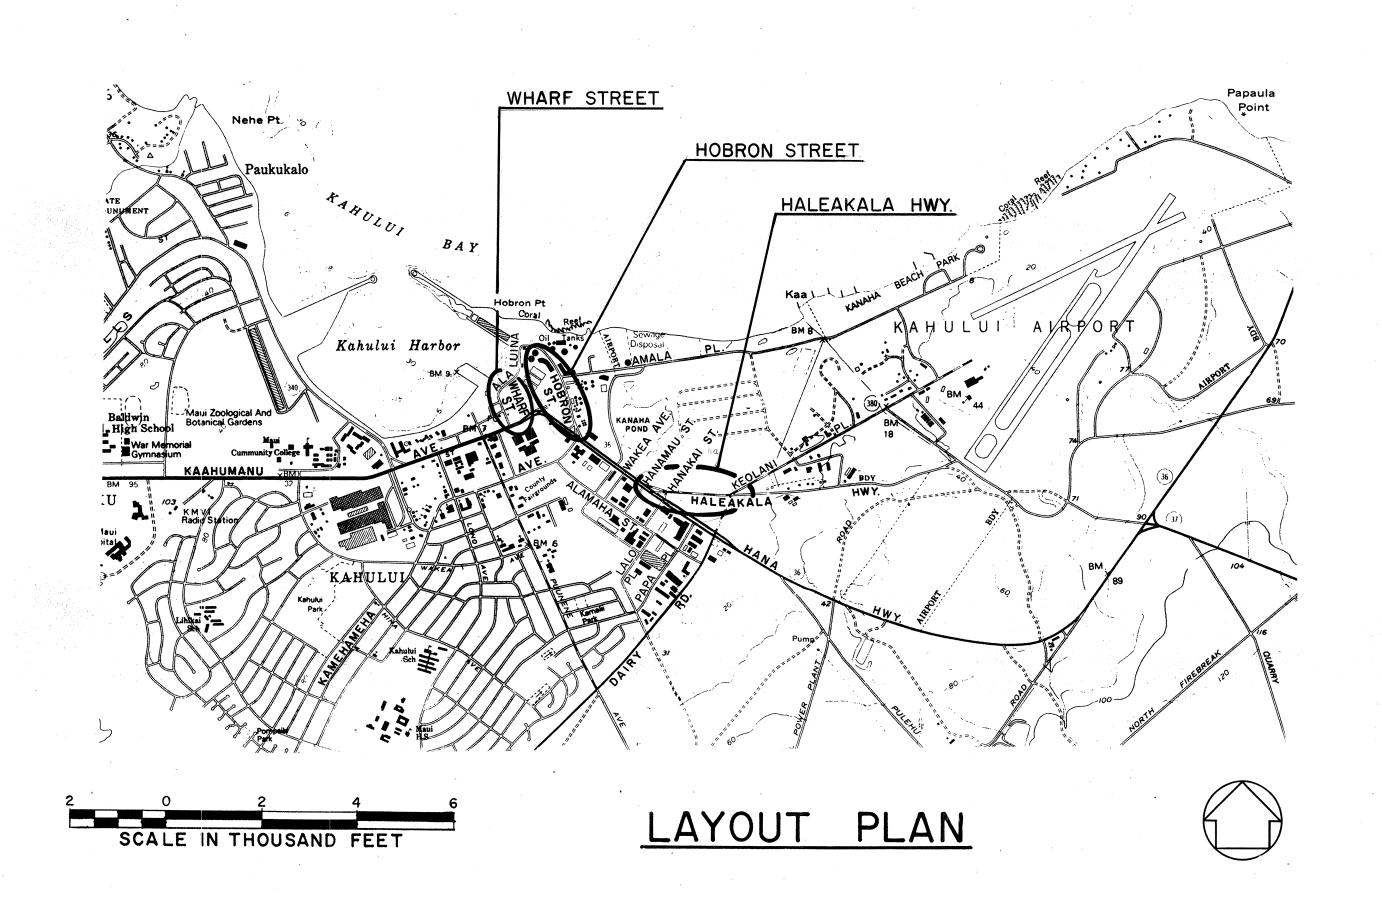

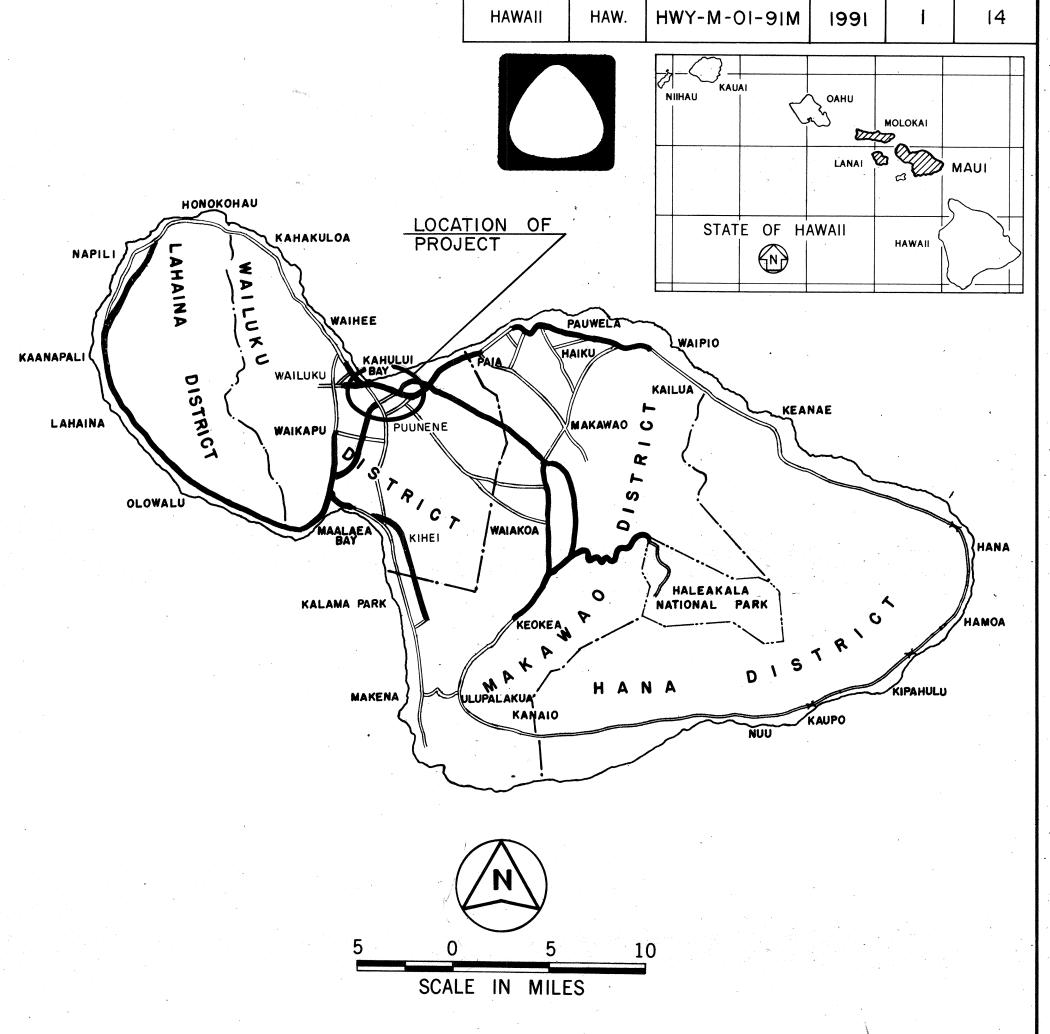

FED. ROAD DIST. NO. FISCAL SHEET TOTAL YEAR NO. SHEETS

PROJ. NO.

FEDERAL AID PROJECTS PREVIOUSLY CONSTRUCTED OR UNDER CONSTRUCTION

MILE POST _____ TO MILE POST ____ HALEAKALA HIGHWAY M.P. 0.00 TO M.P. 0.11 WHARF STREET M.P. 0.00 TO M.P. 0.41 HOBRON STREET M.P. 0.00 TO M.P. 0.32

CHANGES MADE DURING CONSTRUCTION HAVE
BEEN INCORPORATED ON THESE PLANS EXCEPT
CHANGES IN THE ORIGINAL THEORETICAL
QUANTITIES. FOR ACTUAL QUANTITIES, REFER TO
PROJECT, LEDGER, AND/OR COMPUTATION BOOK.

RESIDENT ENGINEER DATE

DEPARTMENT OF TRANSPORTATION STATE OF HAWAII		
APPROVED:		
Elen Albrida	4/16/91	
DIR. OF TRANSPORTATION	DATE	