

INDEX TO DRAWINGS	
SHEET NO	DESCRIPTION
1	TITLE SHEET
2	TYPICAL SECTION
3 - 5	PLAN & PROFILE
6 - 7	WAIEHU STREAM REALIGNMENT
8 - 16	STANDARD DETAILS
17 - 31	CROSS SECTIONS


STATE OF HAWAII
DEPARTMENT OF TRANSPORTATION
HIGHWAYS DIVISION
HONOLULU, HAWAII

"AS BUILT" PLANS OF
WAIEHU BEACH ROAD
FEDERAL AID SECONDARY PROJECT NO S-0341 (3)

DISTRICT OF WAILUKU
ISLAND OF MAUI

SCALES


PLAN	1 IN. = 100 FT.
PROFILE	HOR. 1 IN. = 100 FT. VER. 1 IN. = 10 FT.
X-SECTIONS	HOR. 1 IN. = 10 FT. VER. 1 IN. = 10 FT.

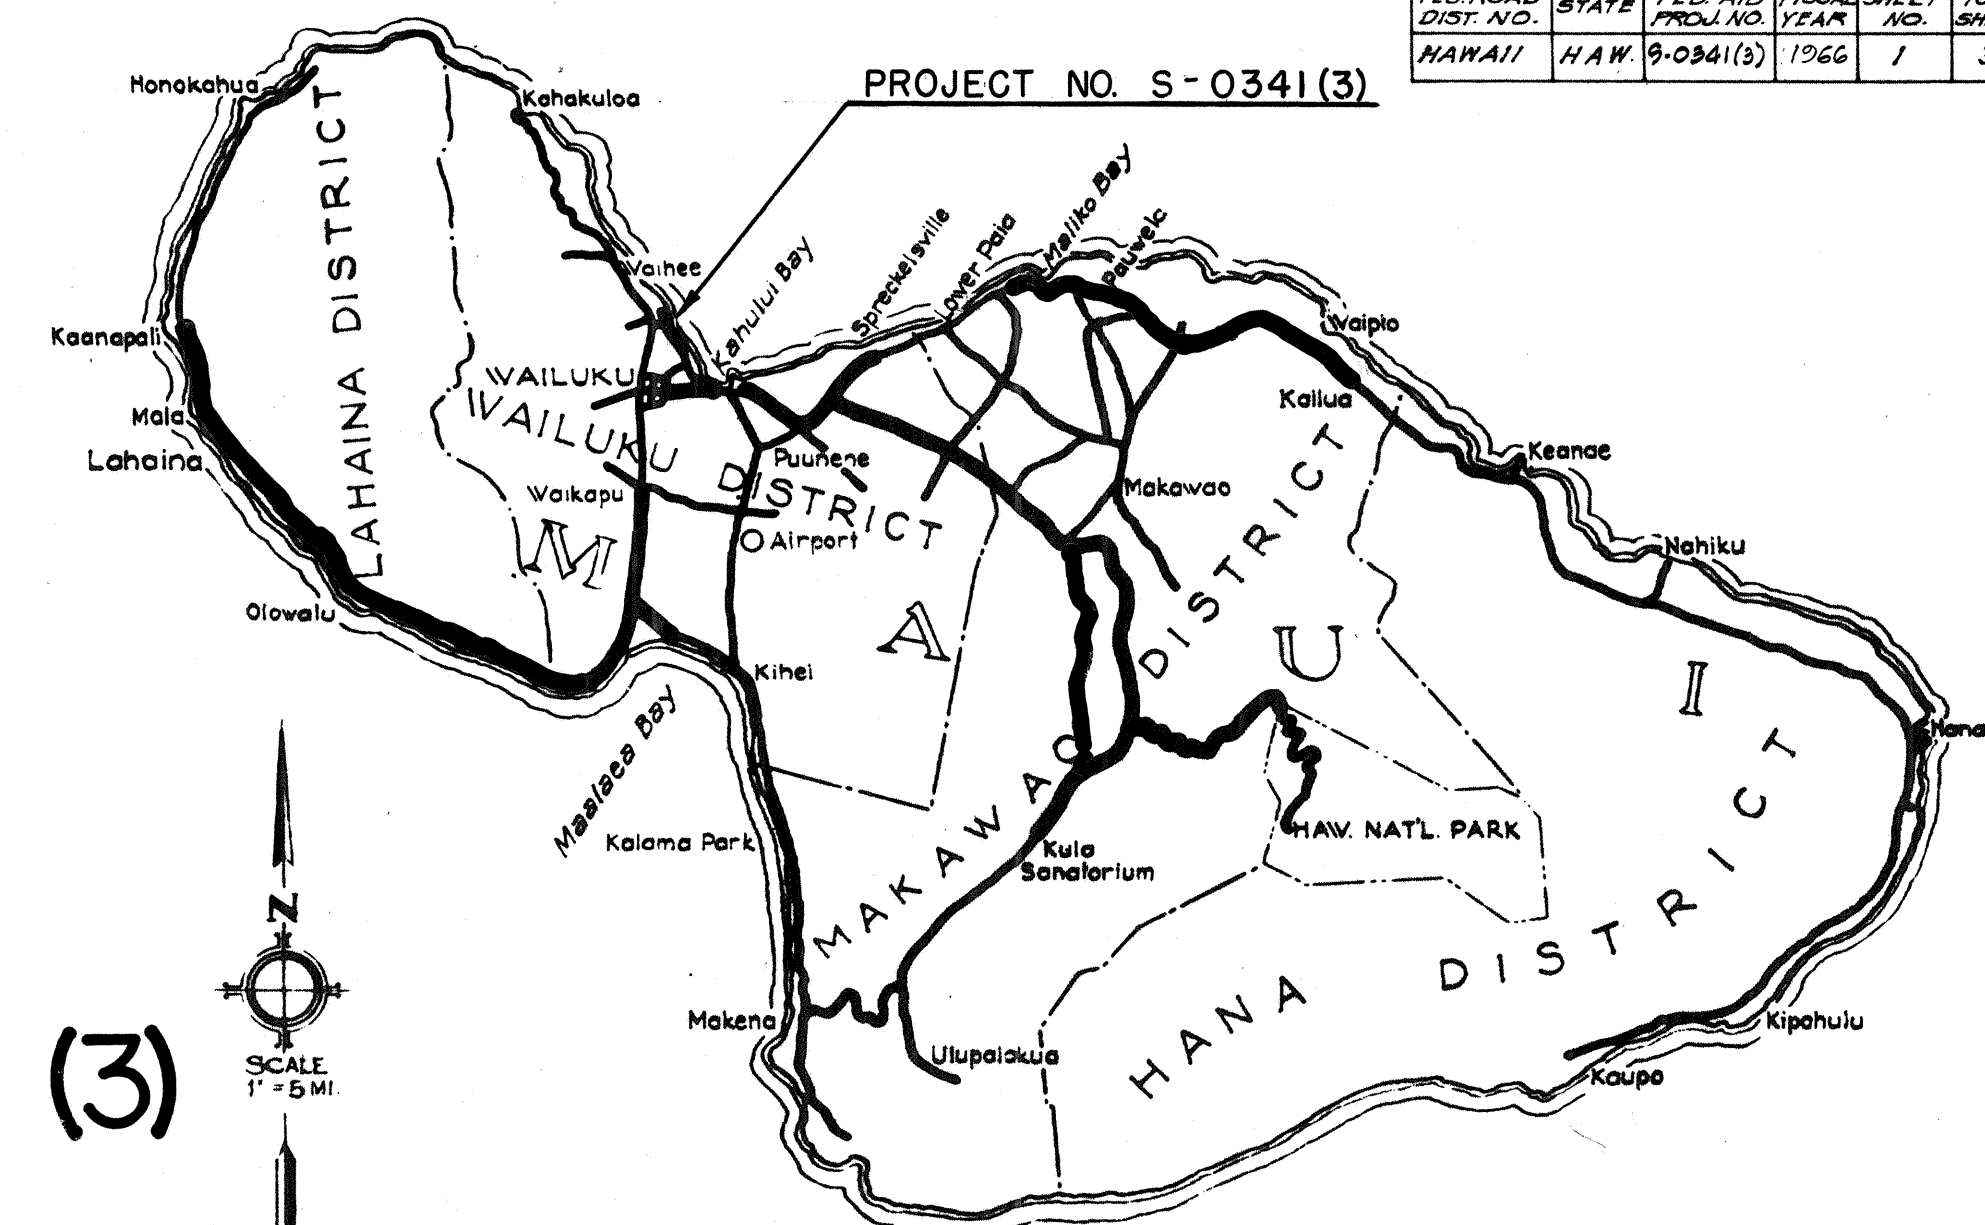

LOCATION MAP

Federal Aid Projects previously constructed or under construction.

CONVENTIONAL SIGNS	
Centerline	125
Boundary Lines	01
Fences (Named)	
Existing Roadways	
Circular Culvert	
Box Culvert	
Bridge	
Telephone Pole	
Electric Power Pole	
Water Main	W ₁ W ₂ (W ₁ , 6, 12, Etc)
Storm Drain	SD ₁ SD ₂ (SD ₁ , 24, Etc)
Concrete Drop Intake	C.D.I.
Standard Catch Basin	S.C.B.
Standard Manhole	M.H.S.
Sewer Manhole	S.M.H.
Telephone Manhole	T.M.H.
Fire Hydrant	F.H.
Trees (Named)	Mango, Coco, etc.
Railroad	

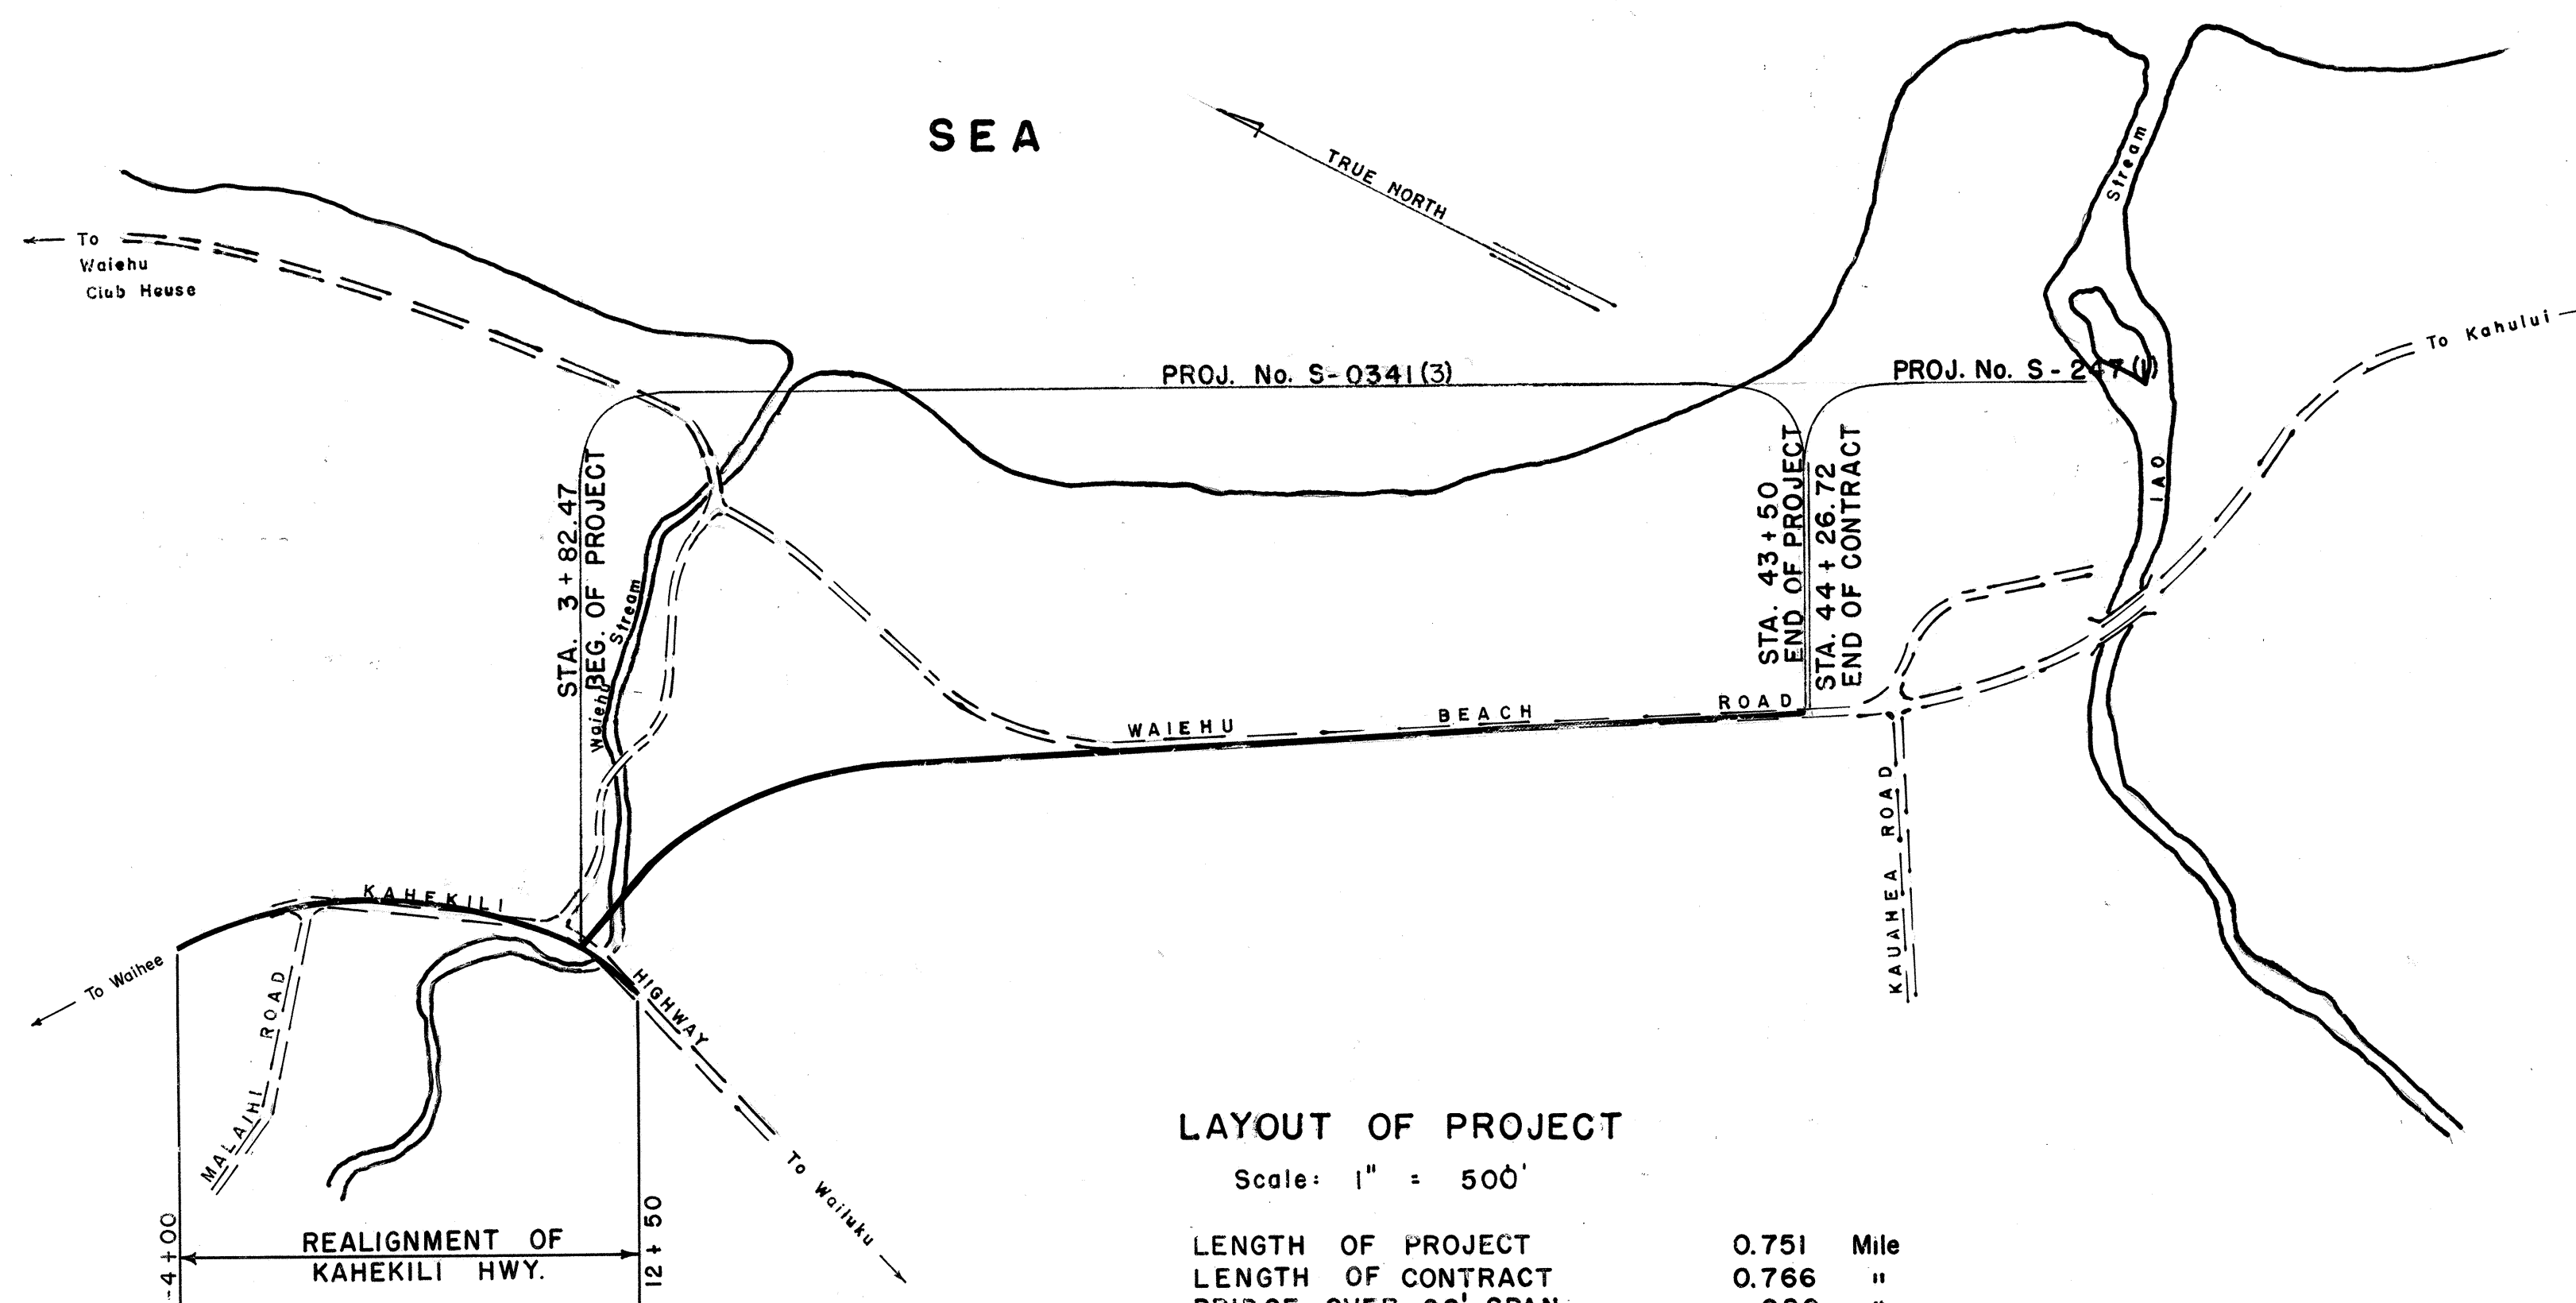

LAYOUT OF PROJECT

Scale: 1" = 500'

LENGTH OF PROJECT	0.751	Mile
LENGTH OF CONTRACT	0.766	"
BRIDGE OVER 20' SPAN	.000	"
REALIGNMENT	.294	"
GROSS LENGTH OF CONTRACT	1.060	"

NOTE:

ALL CHANGES MADE DURING CONSTRUCTION
HAVE BEEN NOTED IN RED ON THESE TRACINGS
AND CHECKED BY:

Harren S. Lenemori
PROJECT ENGINEER

11-3-67
DATE

APPROVED: *John M. Jones*
FOR DIRECTOR OF TRANSPORTATION

DESIGN CLASSIFICATION

ADT (1963)	681
DESIGN ADT (1987)	950
DHV	12%
D	65/35
T	1%
V	50 MPH.

DEPARTMENT OF COMMERCE
BUREAU OF PUBLIC ROADS

APPROVED: *John B. Dalhouse*
DIVISION ENGINEER DATE 5/9/68