


FED. ROAD DIST. NO.	STATE	PROJ. NO.	FISCAL YEAR	SHEET NO.	TOTAL SHEETS
HAWAII	HAW.	3800A-01-03M	2003	8	17

BEGIN PROJECT
Project No. 3800A-01-03M
Sta. 276+82.00

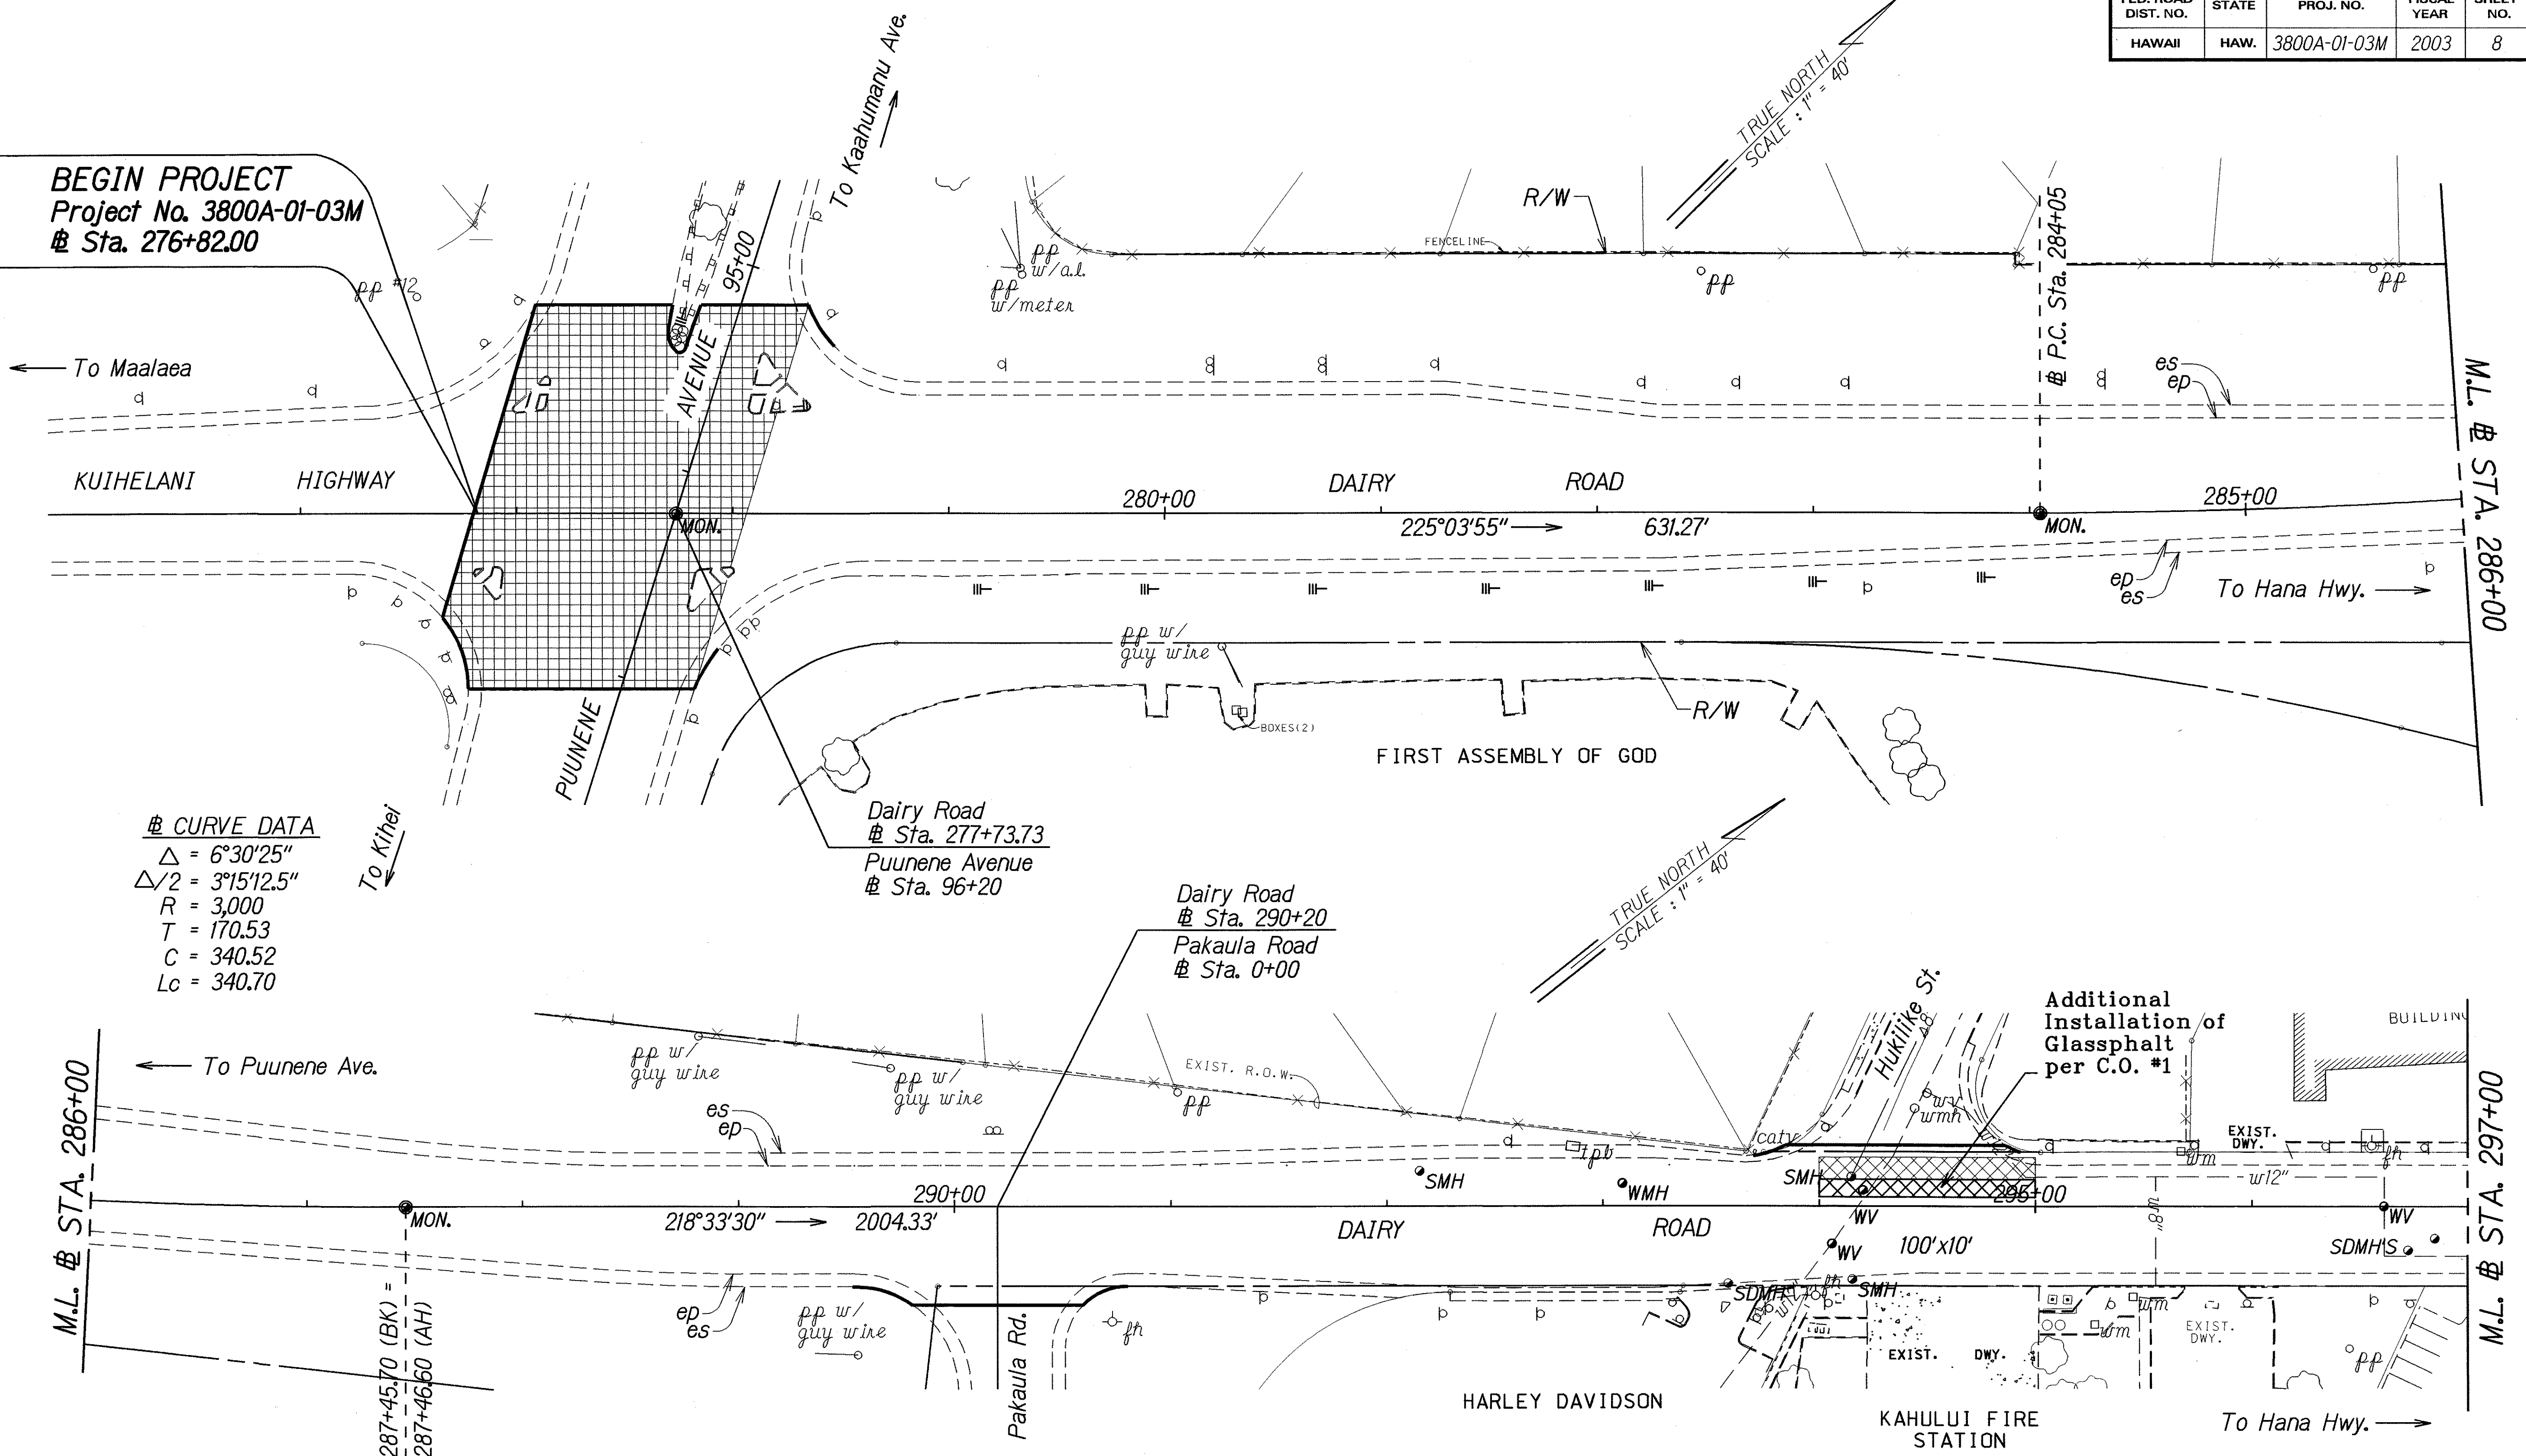

CURVE DATA
 $\Delta = 6^{\circ}30'25''$
 $\Delta/2 = 3^{\circ}15'12.5''$
 $R = 3,000$
 $T = 170.53$
 $C = 340.52$
 $Lc = 340.70$

Dairy Road
Sta. 277+73.73
Puunene Avenue
Sta. 96+20

Dairy Road
Sta. 290+20
Pakaula Road
Sta. 0+00

Additional
Installation of
Glassphalt
per C.O. #1

LEGEND FOR AS-BUILT POSTINGS	
	Squiggly line for as-built deletion
	Double line for as-built deletion
Roadway	Text for as-built posting

STATE OF HAWAII
DEPARTMENT OF TRANSPORTATION
HIGHWAYS DIVISION

ROADWAY PLAN

DAIRY ROAD RESURFACING
Keolani Place to Kuihelani Highway
Project No. 3800A-01-03M

Scale: 1" = 40' Date: September, 2002


SHEET No. 1 OF 3 SHEETS

ORIGINAL PLAN	DATE
DRAWN BY	
DESIGNED BY	
CHECKED BY	
NOTED BY	
DATE	
BY	

asbuilt.dwg



"AS-BUILT"

FED. ROAD DIST. NO.	STATE	PROJ. NO.	FISCAL YEAR	SHEET NO.	TOTAL SHEETS
HAWAII	HAW.	3800A-01-03M	2003	9	17

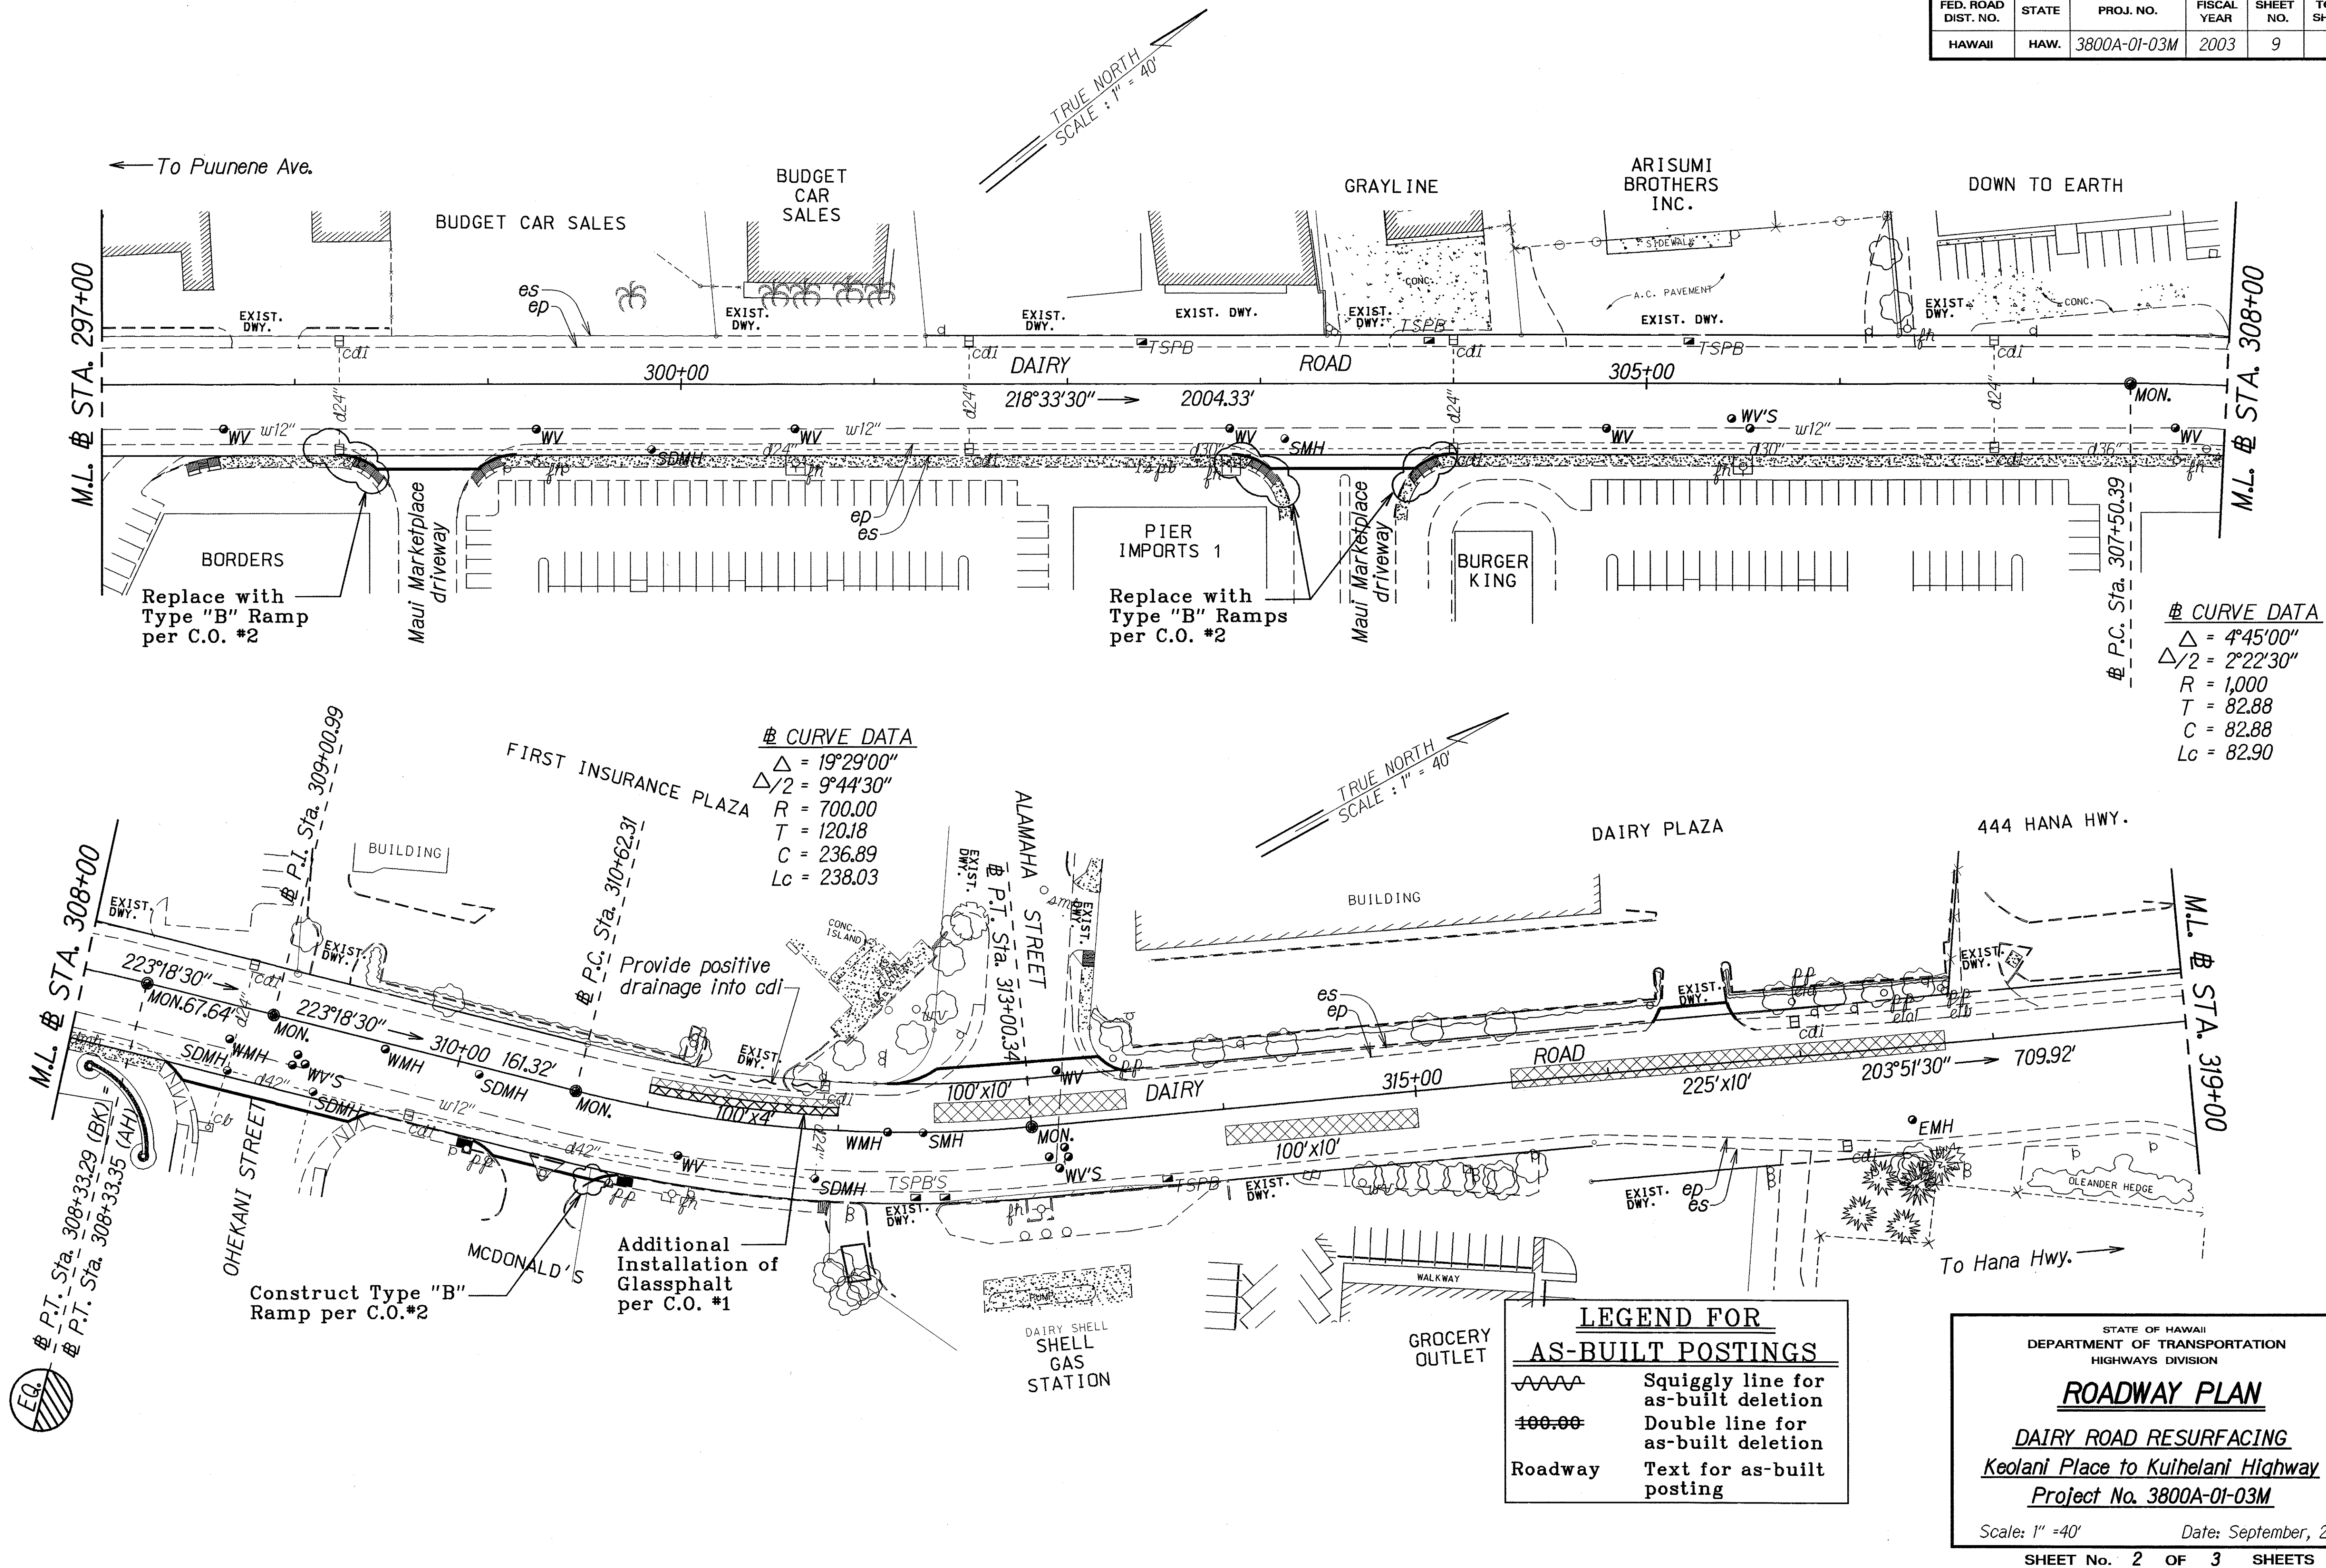

"AS-BUILT"

FED. ROAD DIST. NO.	STATE	PROJ. NO.	FISCAL YEAR	SHEET NO.	TOTAL SHEETS
HAWAII	HAW.	3800A-01-03M	2003	10	17

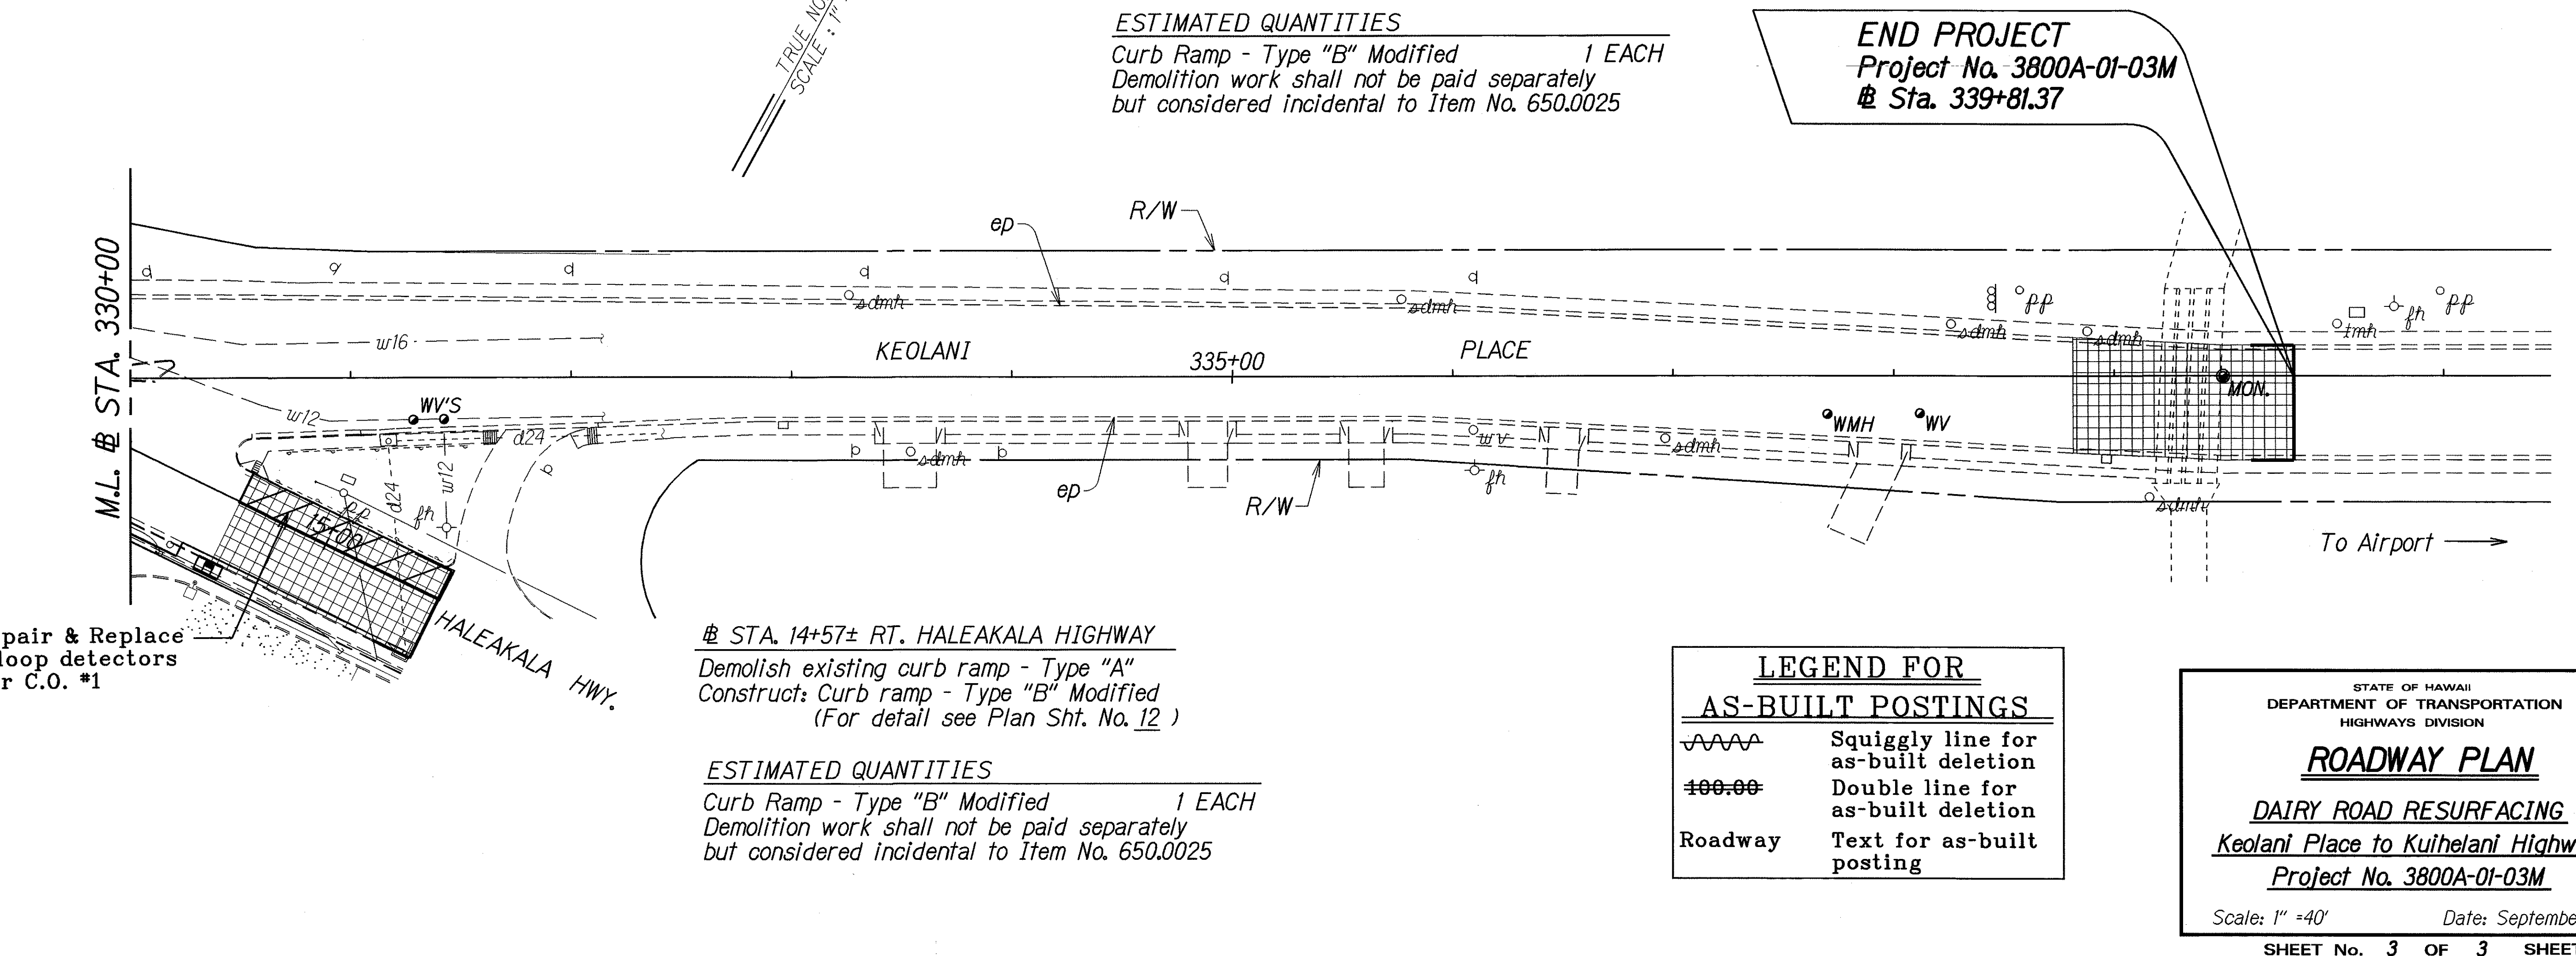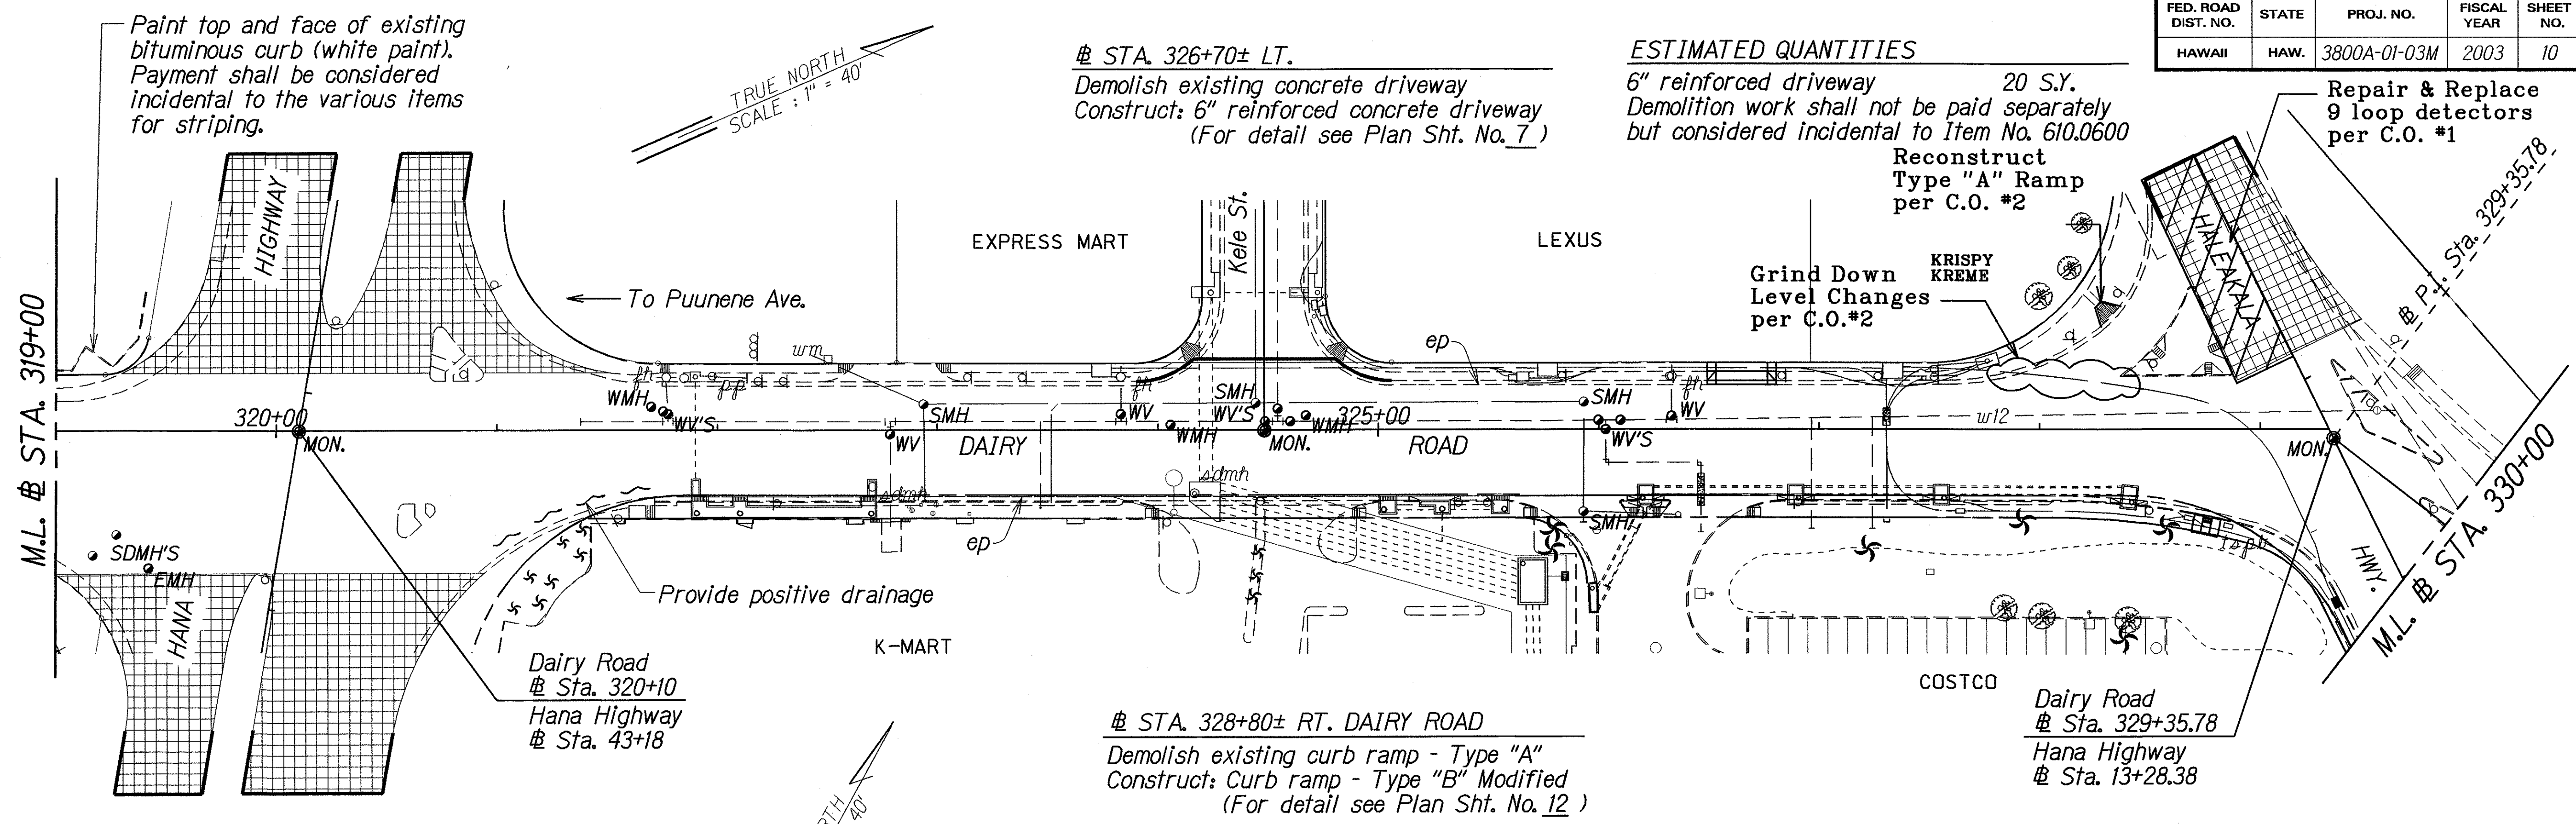

DESIGNED BY	DATE
TRACED BY	
NOTED BY	
CHECKED BY	

"AS-BUILT"