	INDEX TO DRAWINGS		
SHEET NO.	DESCRIPTION		
	TITLE SHEET		
2	TRAFFIC CONTROL PLAN		
3	TYPICAL PAVEMENT SECTIONS AND NOTES		
4-6	GEOMETRICS AND STRIPING PLAN		
7-8	TRAFFIC SIGNAL PLAN		
9-10	CROSS SECTIONS		
11-23	STANDARD DETAILS		
	g.		
	-31'		
~			
· ·			
	•		



STATE OF HAWAII

DEPARTMENT OF TRANSPORTATION HIGHWAYS DIVISION

HONOLULU, HAWAII

"AS-BUILT"

PLANS FOR


KAHULUI BEACH ROAD TRAFFIC SIGNALS AT WAIEHU BEACH ROAD

AND

HANA HIGHWAY

TRAFFIC SIGNALS AT DAIRY ROAD FEDERAL AID URBAN PROJECT NO. MG-0900(15)


DISTRICT OF WAILUKU ISLAND OF MAUI

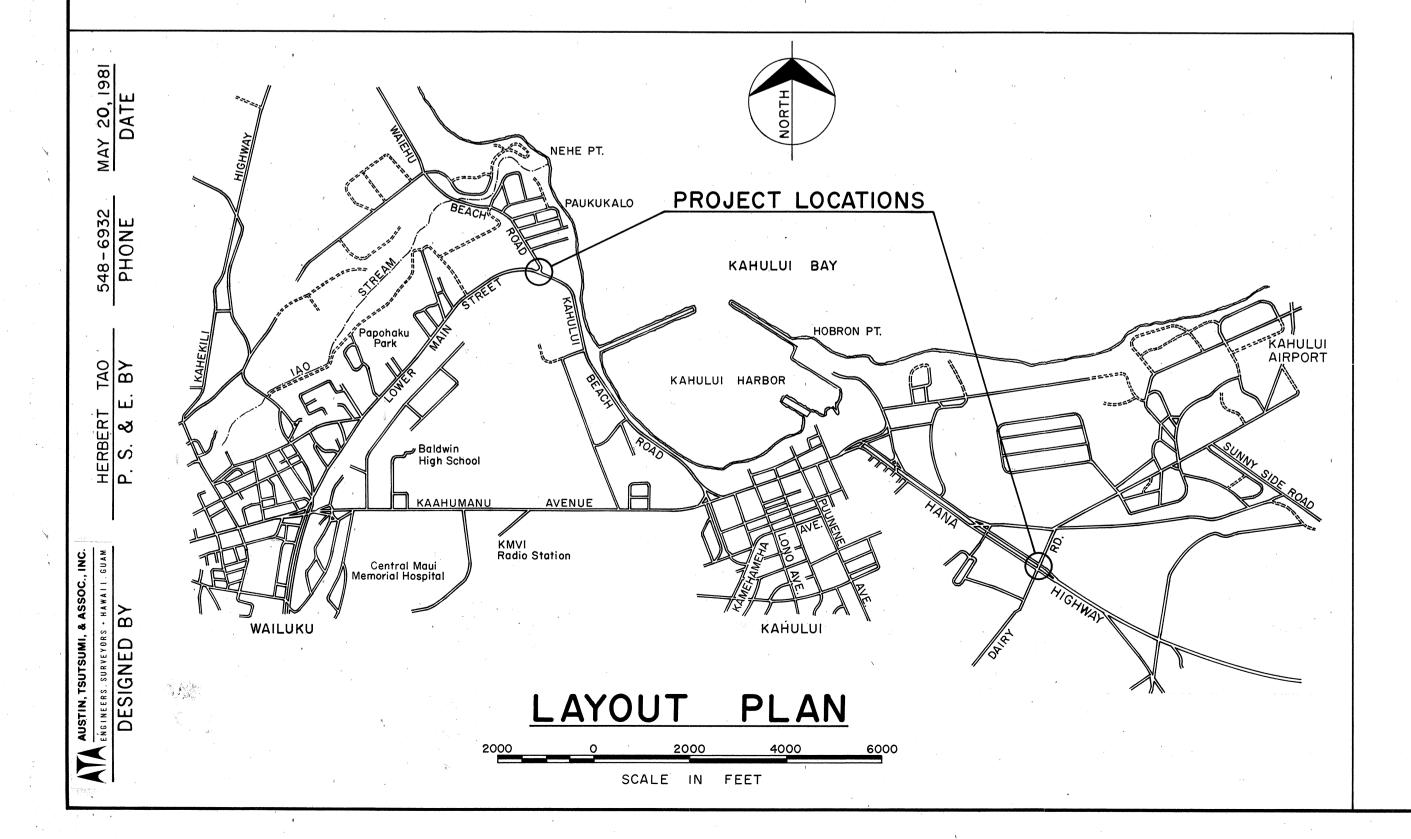

ALL CHANGES MADE DURING CONSTRUCTION HAVE BEEN INCORPORATED ON THESE PLANS IN RED EXCEPT CHANGES IN THE ORIGINAL THEORETICAL QUANTITIES. FOR ACTUAL QUANTITIES, REFER TO PROJECT LEDGER AND/OR COMPUTATION BOOK.

RESIDENT ENGINEER

DATE

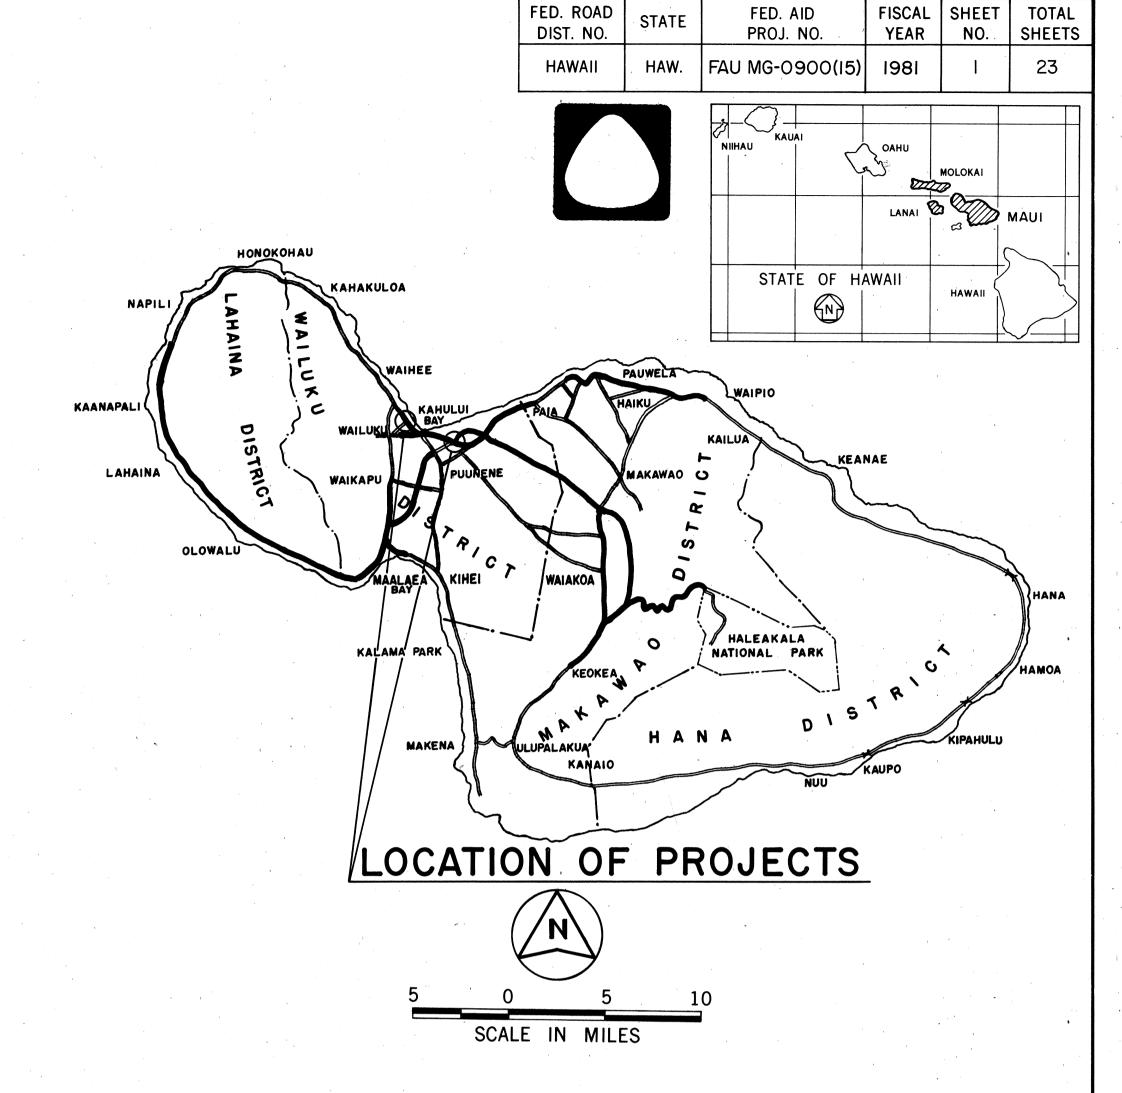

FEDERAL AID PROJECTS PREVIOUSLY CONSTRUCTED OR UNDER CONSTRUCTION

DESIGN	<u>DATA</u>	DESIGN	<u>DATA</u>
KAHULUI BEACH RD./	WAIEHU BEACH RD.	HANA HIGHWAY/	DAIRY ROAD
ADT (1980)	16,500	ADT (1980)	18,500
ADT (2000)	30,800	ADT (2000)	34,900
DHV	3,390	DHV	2,970
K	11%	K	11%
D	55/45	D	70/30
T	2.5%	T	3.5%
T ₂₄	4.0%	T ₂₄	3.5%
V	25 MPH	V .	45 MPH

,	DEPARTMENT OF TRANSPO	RTATION
	FEDERAL HIGHWAY ADMINIS	STRATION
	APPROVED:	
	MSHALL O	7.30.81
	DIVISION ADMINISTRATOR	DATE

	DEPARTMENT OF TRANSPORTATION STATE OF HAWAII		
	APPROVED:	3	
	James R. Canas DIR. OF TRANSPORTATION	7/2/81	
0	DIR. OF TRANSPORTATION	DATE	