



FED. ROAD DIST. NO.	STATE	FED. AID PROJ. NO.	FISCAL YEAR	SHEET NO.	TOTAL SHEETS
MAUI	HAW.	ER-16(010)	2012	1	9

GENERAL NOTES:


1. The Scope of Work for this project consists of improvements to Hana Highway at MP 16. Improvements consist of stabilizing the steep mauka slope with a wire mesh and deep soil nail anchors.
2. The Contractor's attention is directed to the following Sections of the Standard Specifications and Special Provisions: Subsection 104.11 - Utilities and Services Section 107 - Legal Relations and Responsibility to Public; and Section 645 - Work Zone Traffic Control.
3. At the end of each day's work, the Contractor shall remove all equipment and other obstructions to permit free and safe passage of public traffic.
4. The existence and location of underground utilities, manholes, monuments and structures as shown on the plans are from the latest available data but the accuracy is not guaranteed. The encountering of other obstacles during the course of work is possible. The Contractor shall be held liable for any damages incurred to the existing facilities and/or improvements as a result of his operations.
5. Dressing of shoulders shall consist of clearing, grubbing, grading, reshaping, and compacting the unpaved shoulders with suitable material as shown on the plans and/or as directed by the Engineer. This work shall be considered incidental to the various contract items.
6. Existing drainage system will be functional at all times during construction. The Contractor is to furnish materials, equipment, labor, tools and incidentals necessary to maintain flow. This work shall be considered incidental to various contract items.
7. Earth swales shall be graded to drain. This work shall be considered incidental to the various contract items.
8. The Contractor shall clean and remove any accumulation of aggregates along the roadside within 15 feet of the edge of pavement. This work shall be considered incidental to the various contract items.
9. All necessary permits shall be obtained by the Contractor at his own cost.
10. The Contractor shall comply with the State of Hawaii's Occupational Safety and Health Law (DOSH).
11. All lanes shall be opened to traffic during the morning peak hours from 6:30 a.m. to 8:30 a.m., during the afternoon peak hours from 3:30 p.m. to 6:00 p.m. and off work hours or as directed by the Engineer. As a minimum, one lane of highway shall remain open during work hours.
12. In the event that historical resources, including human skeletal remains, cultural materials, lava tubes, and lava blisters/bubbles are discovered during construction activities, the contractor shall cease work in the immediate vicinity of the find, protect it from additional disturbances, and call the State Historical Preservation Division, Maui Island Section at (808) 243-1285.

LEGEND FOR AS-BUILT POSTINGS	
	Squiggly line for as-built deletion
	Double line for as-built deletion
Roadway	Text for as-built posting

ORIGINAL PLAN	SURVEY PLOTTED BY	DATE
NOTE BOOK	DRAWN BY	
No.	DESIGNED BY	
	QUANTITIES BY	
	CHECKED BY	

PRINTED: 05/10/2012 11:33 AM FILED: 05-10-2012 12:05 PM

AECOM

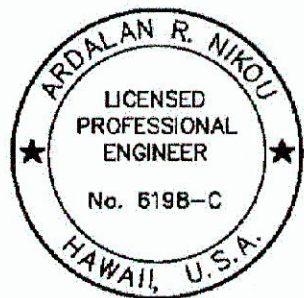

EXPIRATION DATE OF THE LICENSE: 4/30/2014  
THIS WORK WAS PREPARED BY  
ME OR UNDER MY SUPERVISION.

MILEPOST 16.0

STATE OF HAWAII  
DEPARTMENT OF TRANSPORTATION  
HIGHWAYS DIVISION

GENERAL NOTES

HANA HIGHWAY EMERGENCY REPAIRS

MILEPOST 16.0

FEDERAL-AID PROJECT NO. ER-16(010)

Scale: As Noted

Date: July 10, 2012

SHEET No. 1 OF 9 SHEETS

"AS-BUILT"