
FISCAL SHEET TOTAL YEAR NO. SHEETS FED. ROAD STATE FED. AID PROJ. NO. 2012 5 HAW. ER-16(008)

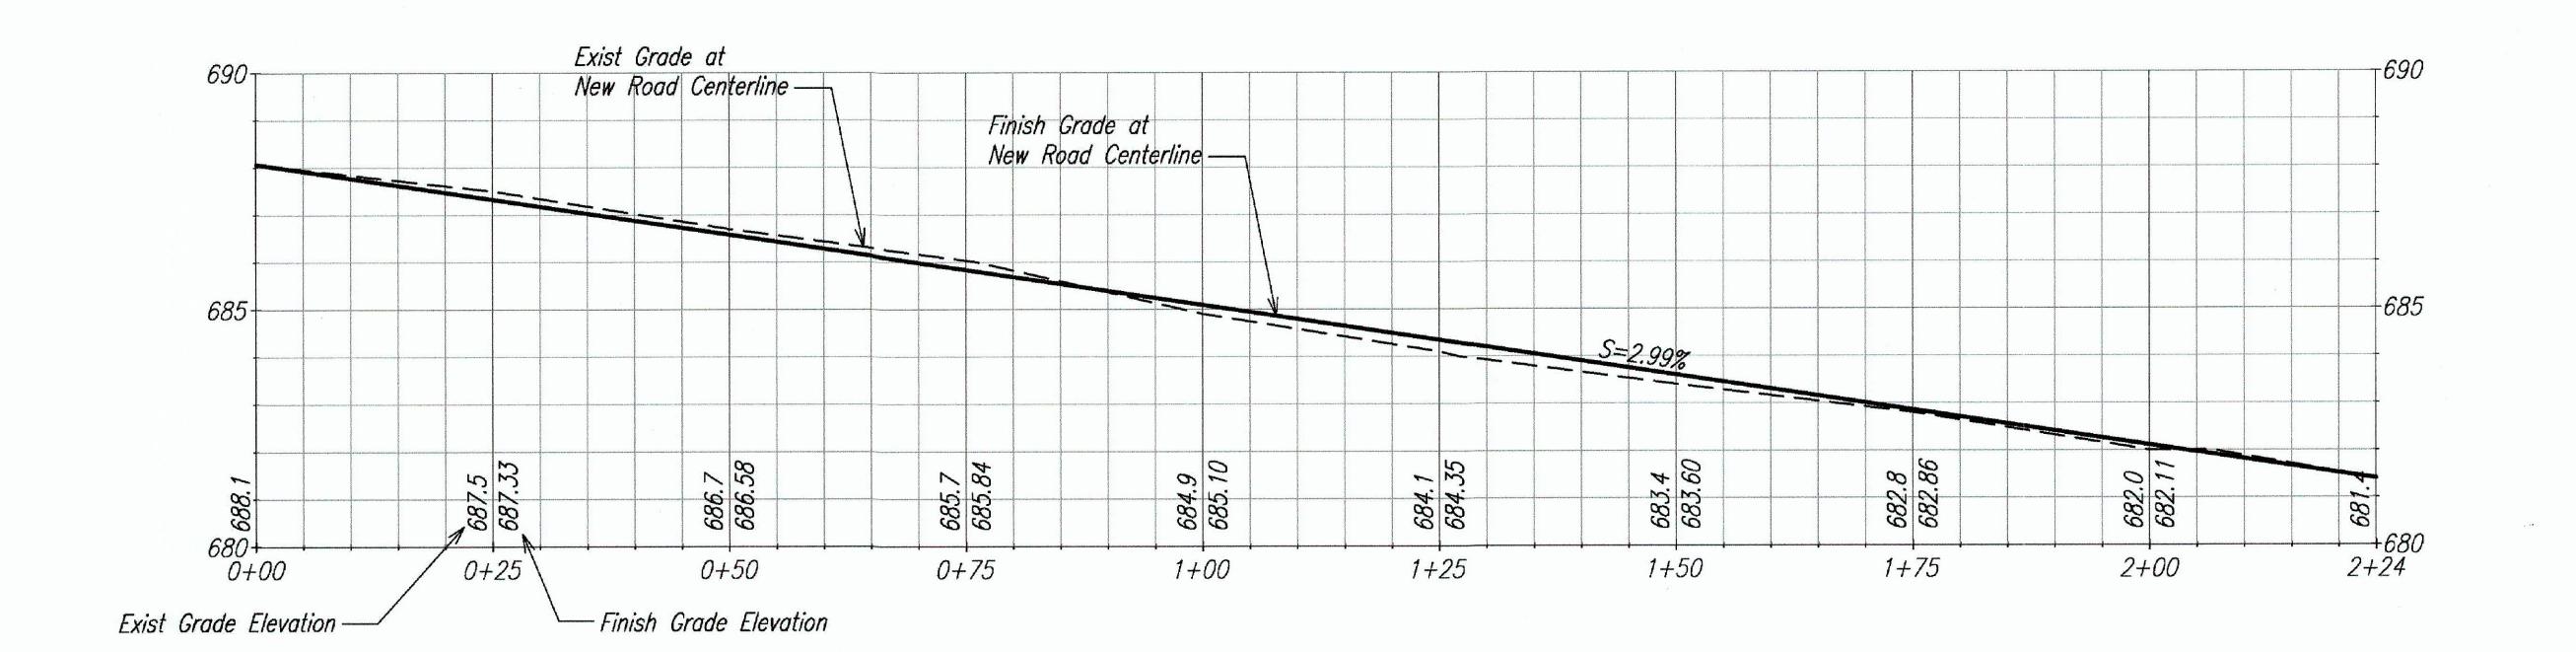


LEGEND FOR AS-BUILT POSTINGS Squiggly line for as-built deletion

Double line for as-built deletion Roadway Text for as-built

MP 10.4 ROAD PROFILE

Horiz. Scale: 1"=10'

Vert. Scale: 1"=2'

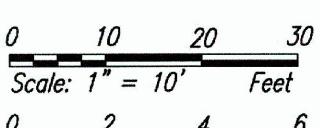



AECOM

DYPIRATION DATE OF THE LICENSE 4/30/2014
THIS WORK WAS PREPARED BY
ME OR UNDER MY SUPERVISION.

STATE OF HAWAII
DEPARTMENT OF TRANSPORTATION HIGHWAYS DIVISION

ROAD PROFILE

HANA HIGHWAY EMERGENCY REPAIRS MILEPOST 10.4

FEDERAL—AID PROJECT NO. ER—16(008)
Scale: As Noted Date: July 10, 2012

SHEET No. 5 OF 14 SHEETS