



FED. ROAD DIST. NO.	STATE	FED. AID PROJ. NO.	FISCAL YEAR	SHEET NO.	TOTAL SHEETS
MAUI	HAW.	ER-16(010)	2012	3	9

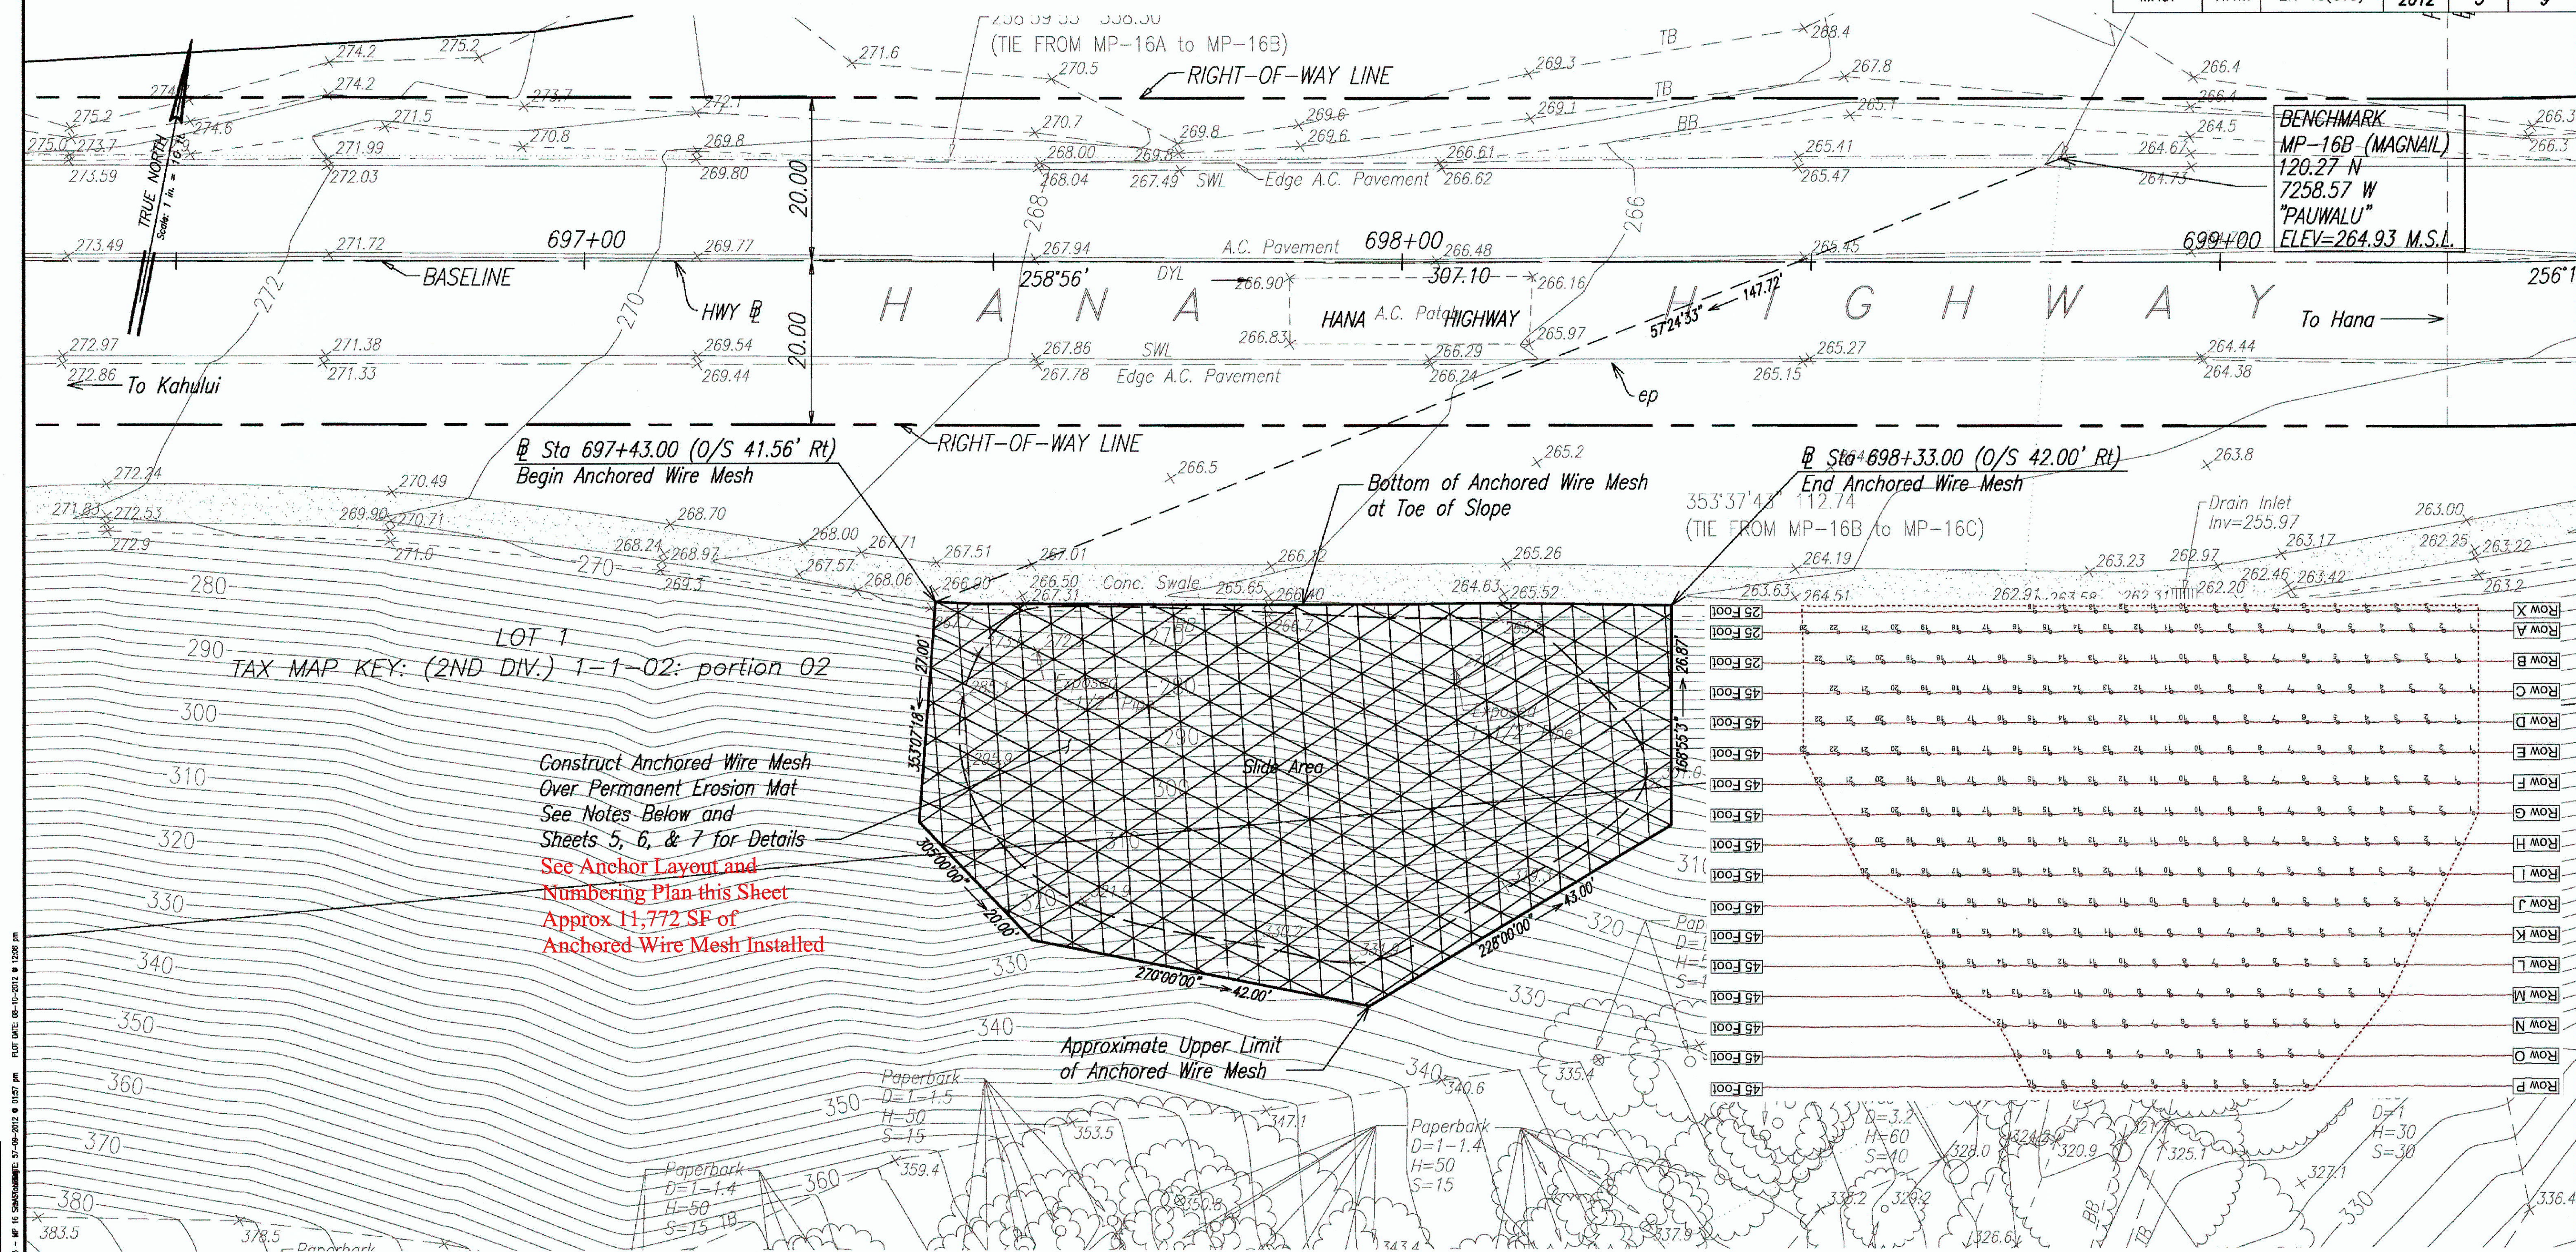

AECOM

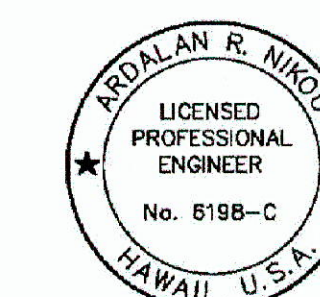

STATE OF HAWAII
DEPARTMENT OF TRANSPORTATION
HIGHWAYS DIVISION

SITE PLAN

HANA HIGHWAY EMERGENCY REPAIRS
MILEPOST 16.0
FEDERAL-AID PROJECT NO. ER-16(010)
Scale: As Noted Date: July 10, 2012

SHEET No. 3 OF 9 SHEETS

0 10 20 30
Scale: 1" = 10' Feet

"AS-BUILT"