


FED. ROAD DIST. NO.	STATE	FED. AID PROJ. NO.	FISCAL YEAR	SHEET NO.	TOTAL SHEETS
MAUI	HAW.	ER-16(00B)	2012	3	14

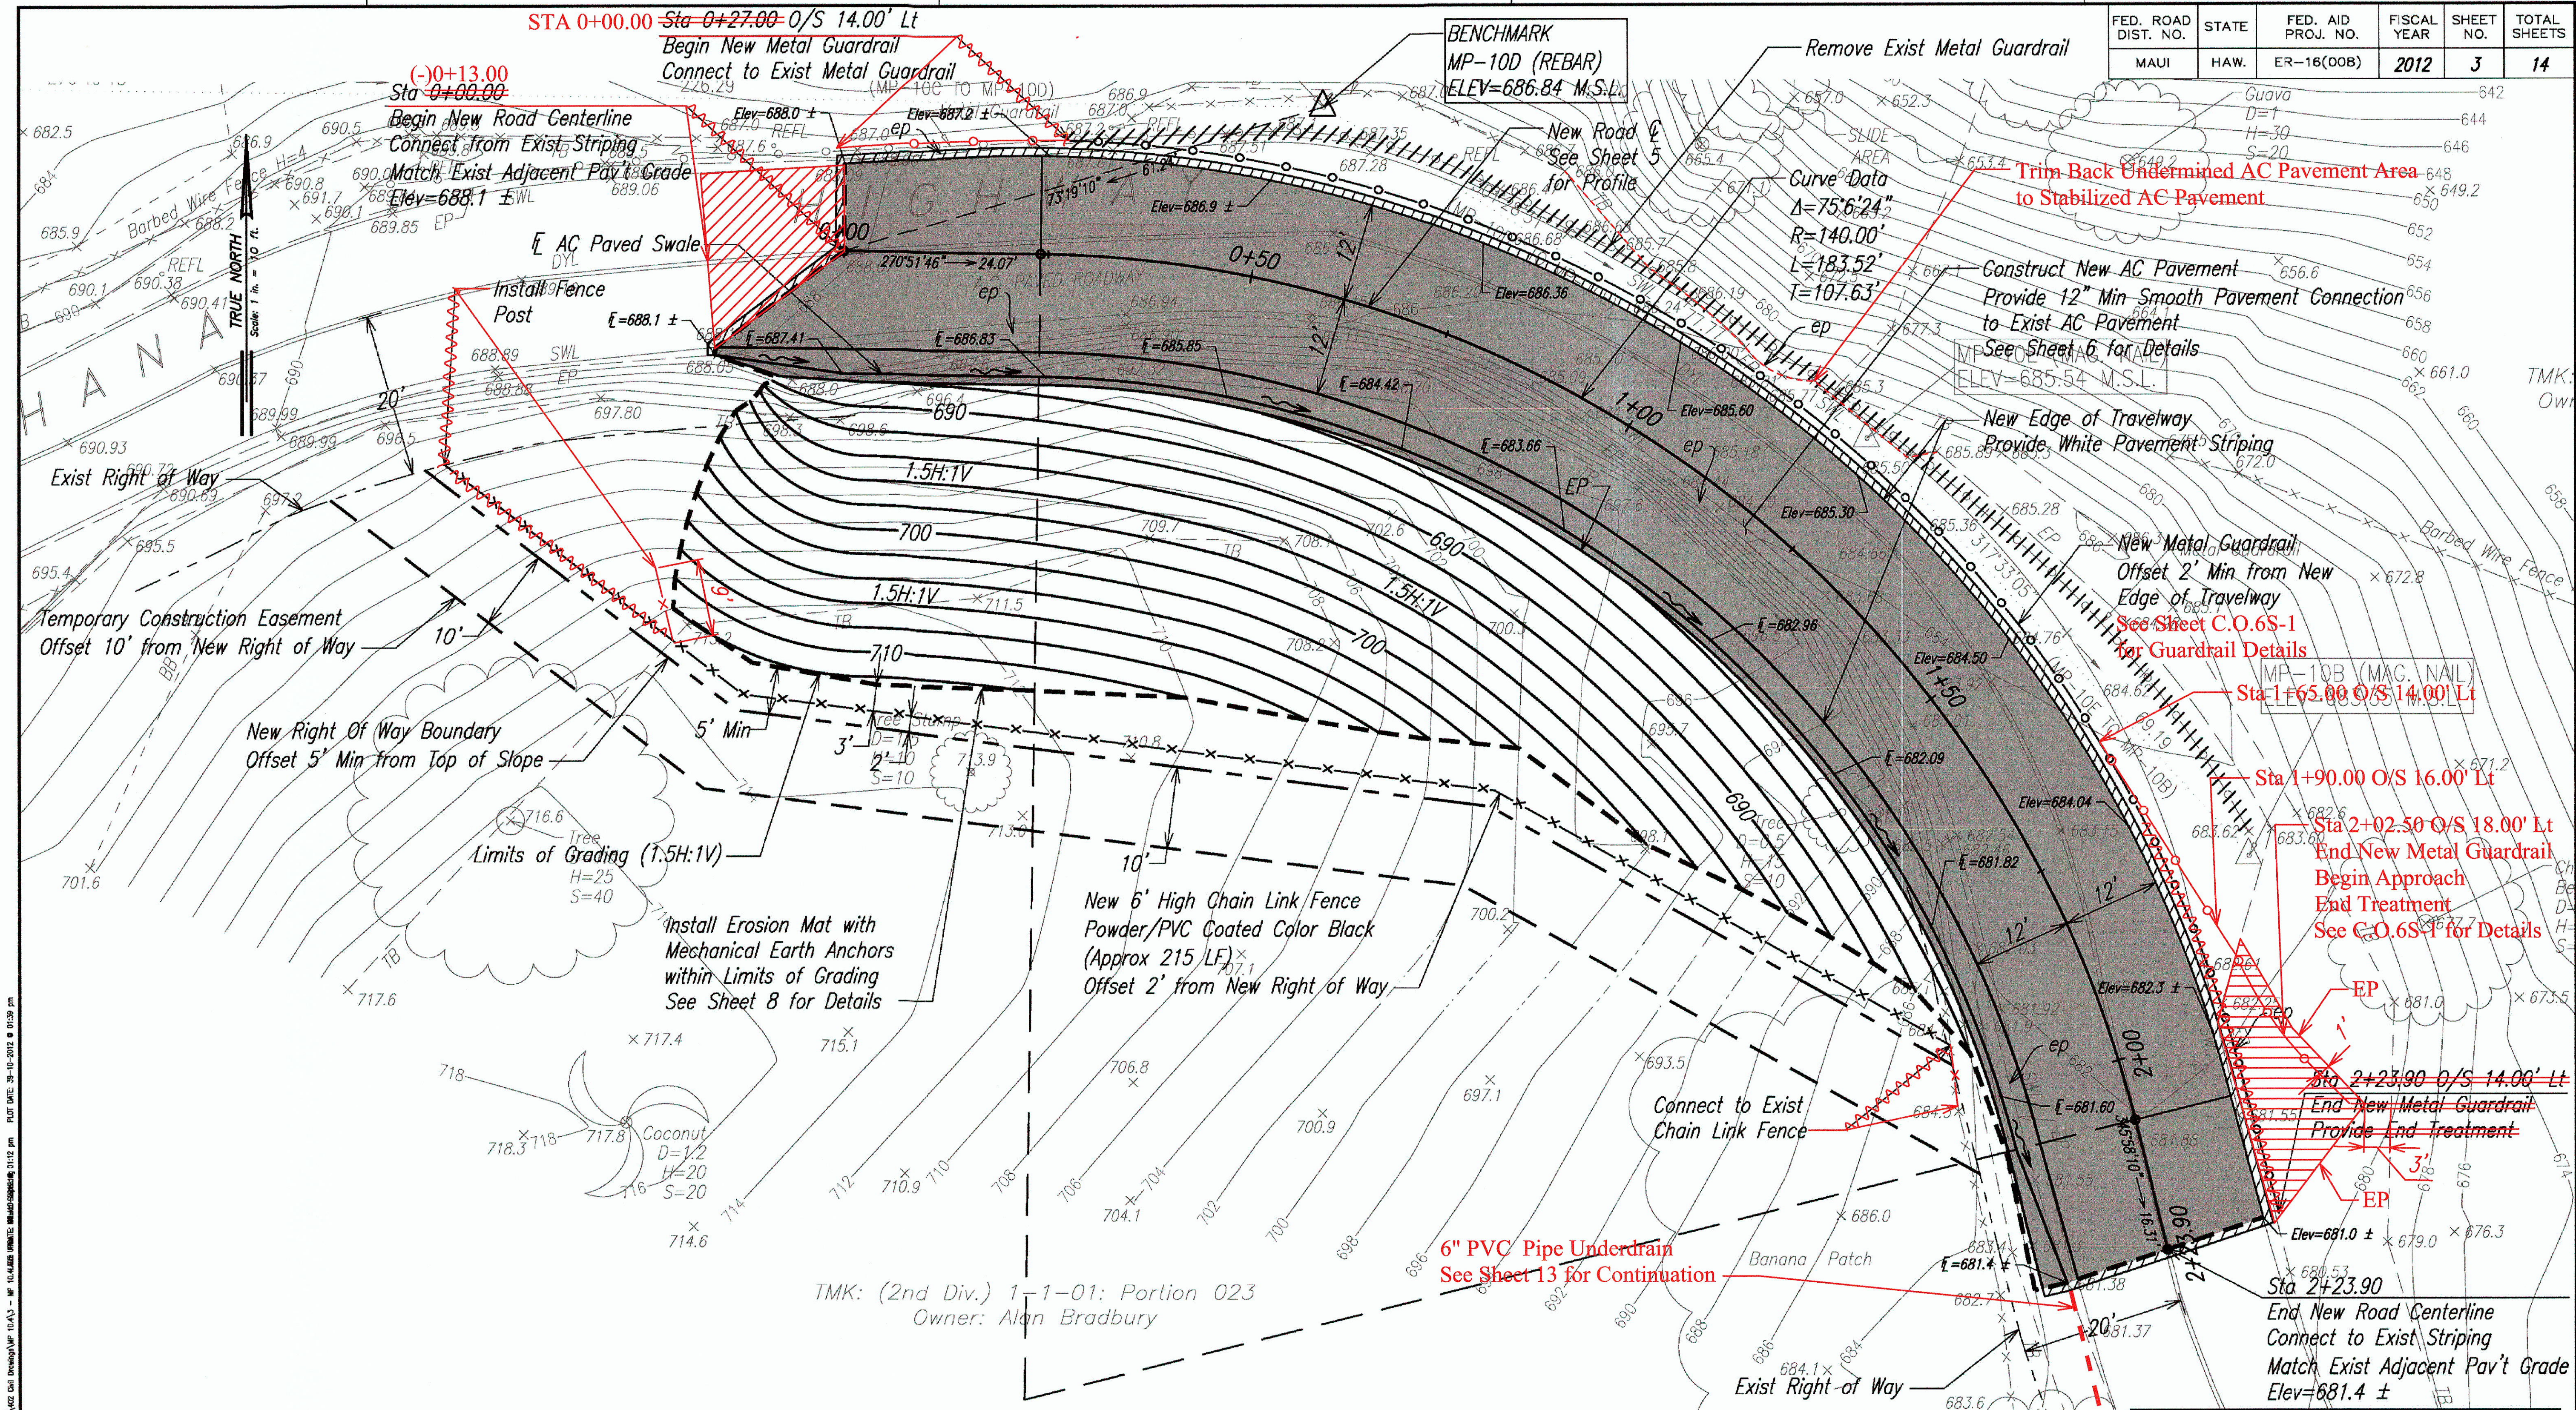

LEGEND FOR AS-BUILT POSTINGS



Squiggly line for as-built deletion

Double line for as-built deletion

Roadway Text for as-built posting

MP 10.4 SITE PLAN - MAUKA SLOPE

Scale: 1"=10'

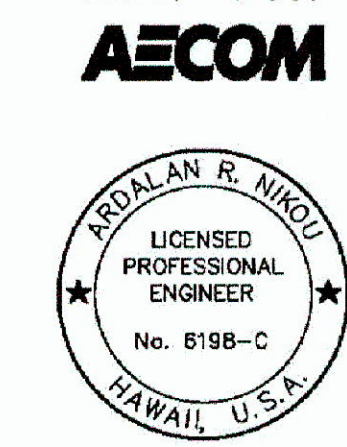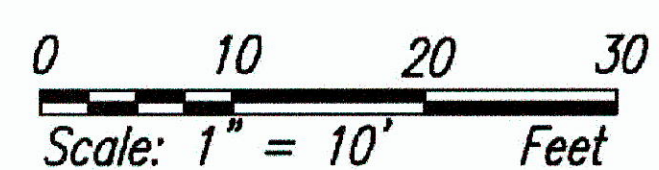

STATE OF HAWAII
DEPARTMENT OF TRANSPORTATION
HIGHWAYS DIVISION

SITE PLAN
MAUKA SLOPE

HANA HIGHWAY EMERGENCY REPAIRS
MILEPOST 10.4

FEDERAL-AID PROJECT NO. ER-16(00B)
Scale: As Noted Date: July 10, 2012

SHEET No. 3 OF 14 SHEETS

"AS-BUILT"