


FED. ROAD DIST. NO.	STATE	FED. AID PROJ. NO.	FISCAL YEAR	SHEET NO.	TOTAL SHEETS
MAUI	HAW.	ER-16(009)	2012	7	13

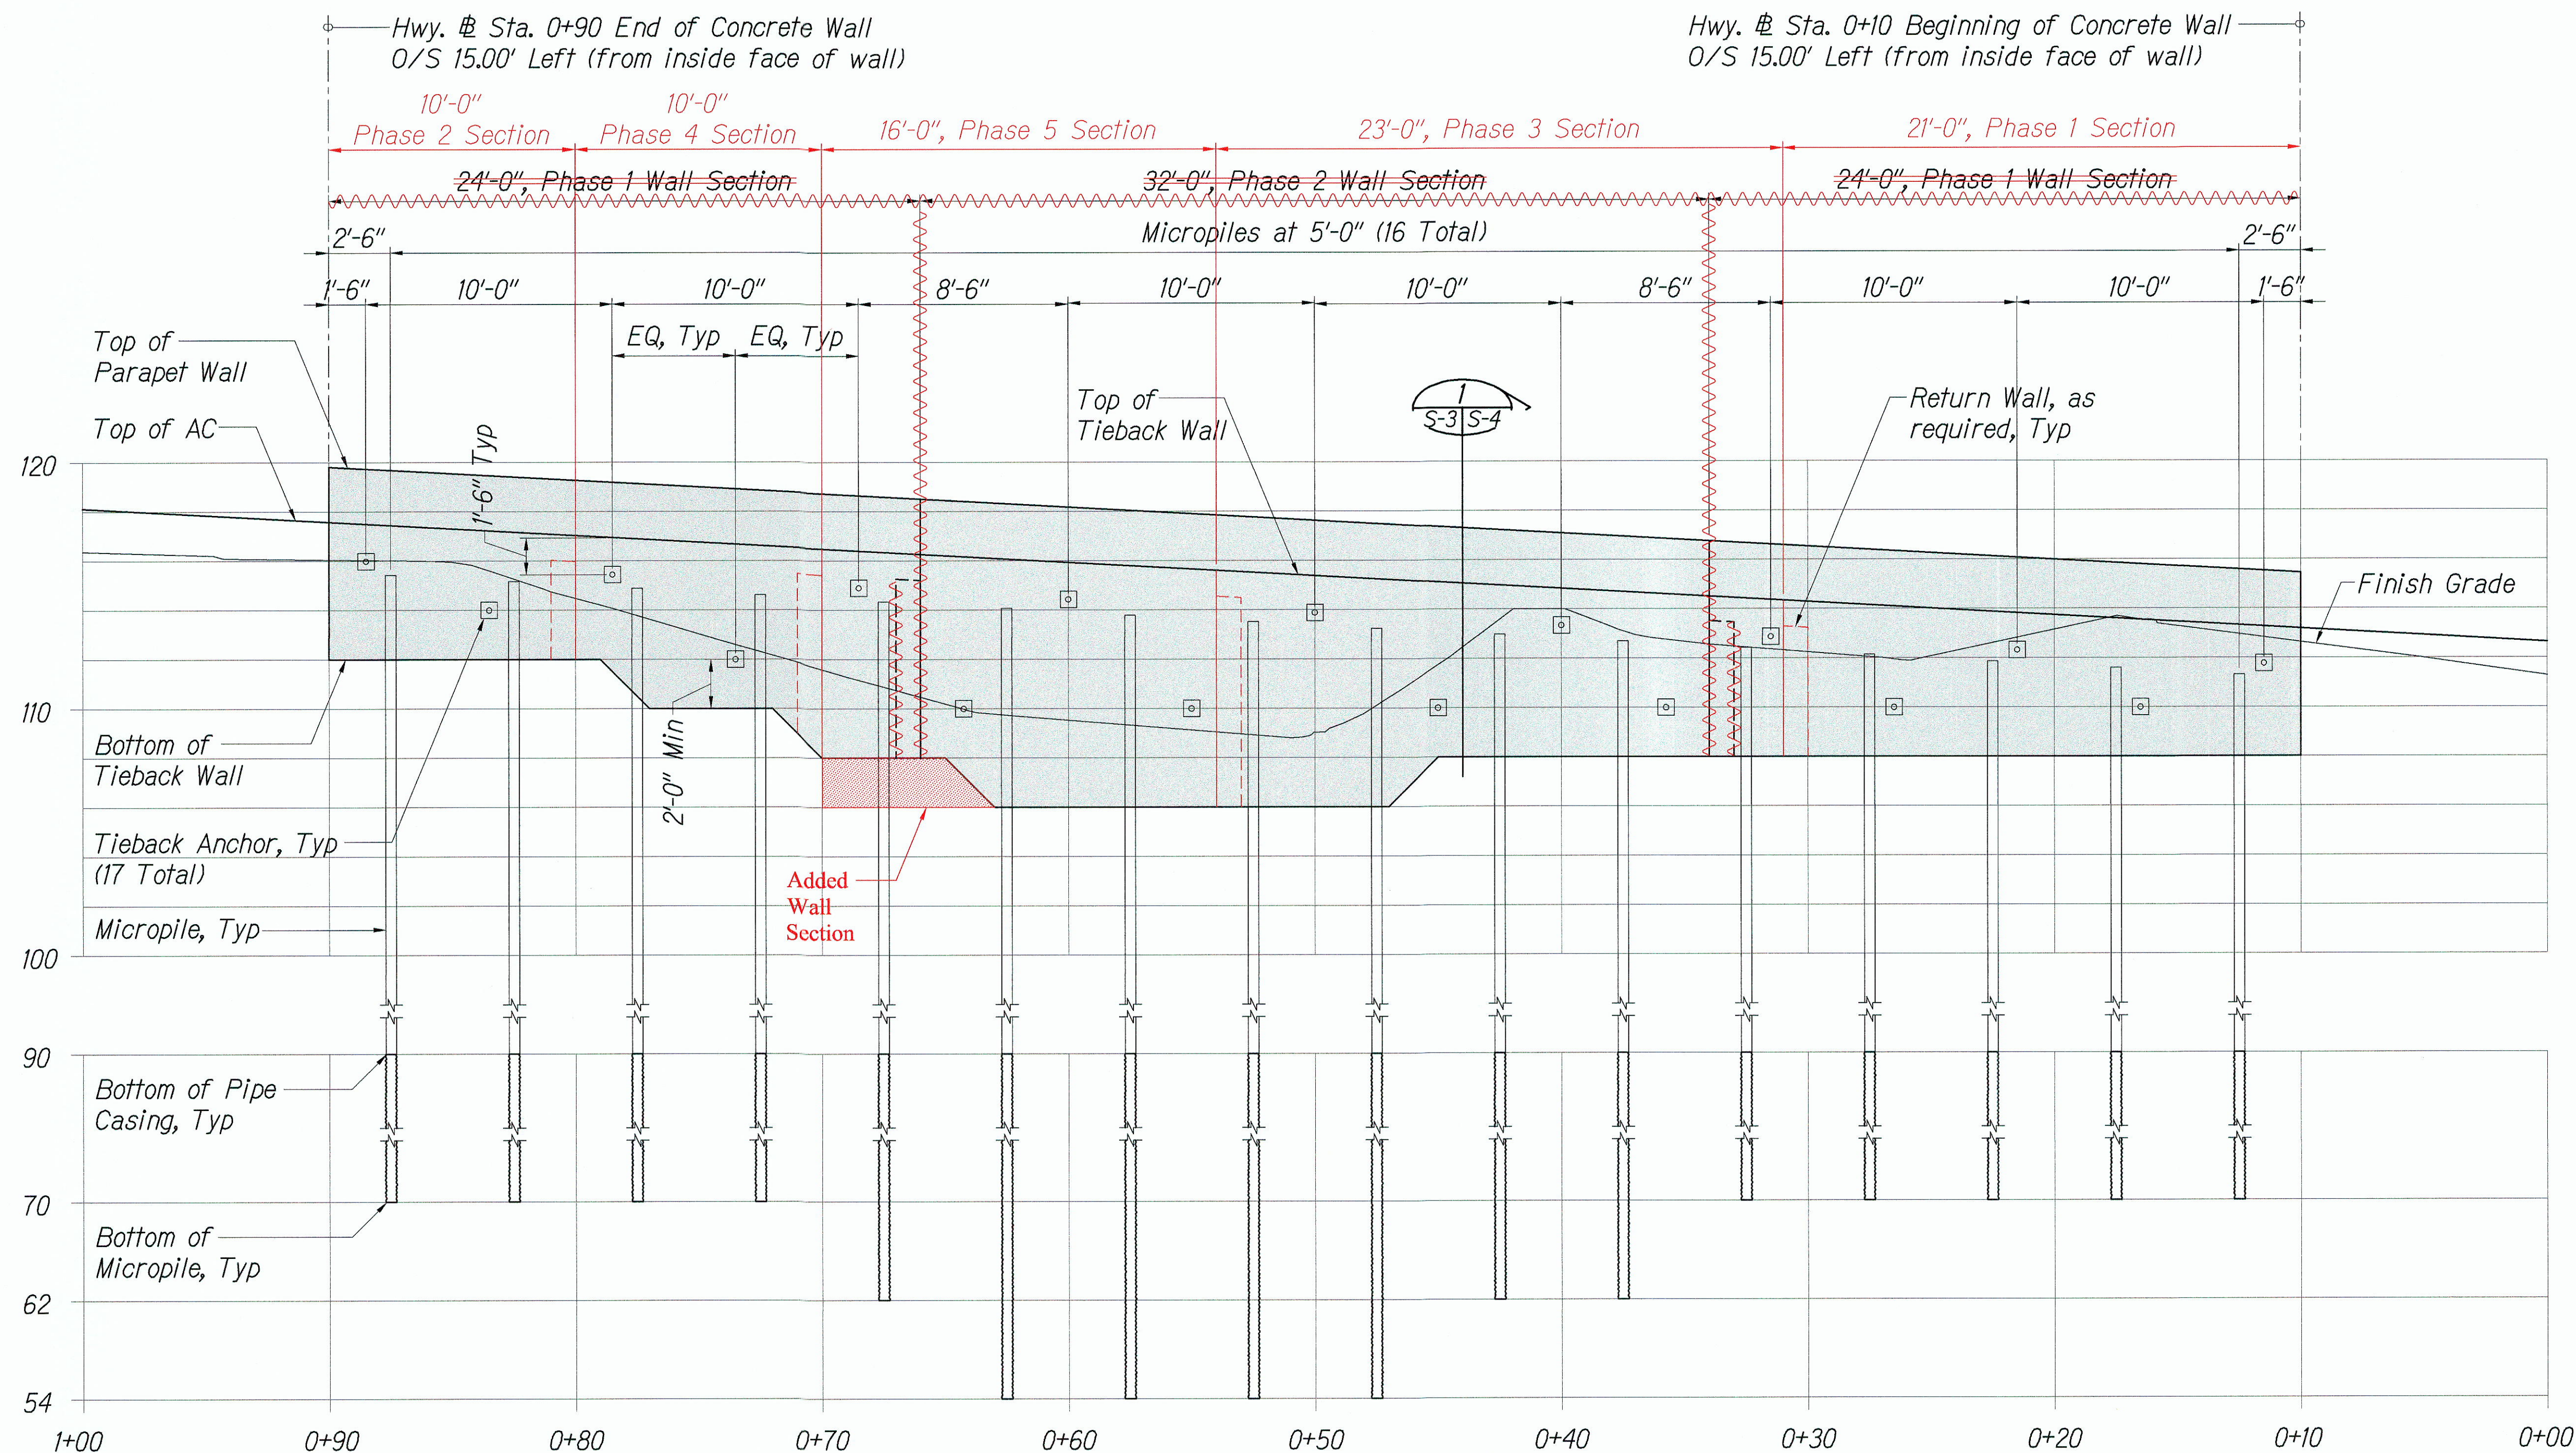

**LEGEND FOR
AS-BUILT POSTINGS**

Squiggly line for
as-built deletion

Double line for
as-built deletion

Roadway Text for as-built
posting

ORIGINAL PLAN

DATE 6/30/06

DESIGNED BY R. Yamamoto

CHECKED BY L. Chan


NO. 1

TIEBACK WALL ELEVATION

Scale: 1/4" = 1'-0"

1

S-3 S-3

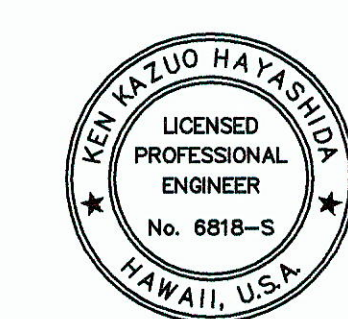

STATE OF HAWAII
DEPARTMENT OF TRANSPORTATION
HIGHWAYS DIVISION

TIEBACK WALL ELEVATION

HANA HIGHWAY EMERGENCY REPAIRS
MILEPOST 14.0
FEDERAL AID PROJECT No. ER-16(009)

Scale: As Noted Date: June 2012

SHEET No. S-3 OF 6 SHEETS

KEI KAZUO HAYASHIDA
LICENSED PROFESSIONAL ENGINEER
No. 6818-S
HAWAII, U.S.A.

"AS-BUILT"