


FED. ROAD DIST. NO.	STATE	FED. AID PROJ. NO.	FISCAL YEAR	SHEET NO.	TOTAL SHEETS
MAUI	HAW.	ER-16(009)	2012	12	13


General Notes For Traffic Control Plan

1. The Contractor shall make minor adjustments at intersections, driveways, bridges, structures, etc., to fit field conditions.
2. Cones or delineators shall be extended to a point where they are visible to approaching traffic.
3. Traffic control devices shall be installed such that the sign or device farthest from the work area is placed first. The others shall then be placed progressively toward the work area.
4. Regulatory and warning signs within the construction zone that are in conflict with the traffic control plans shall be removed or covered.
5. Flaggers shall be in sight of each other or in direct communication at all times.
6. All traffic lanes shall be a minimum of 10-feet wide.
7. All construction warning signs shall be promptly removed or covered whenever the message is not applicable or not in use.
8. Cones and delineators shall be spaced at a maximum distance of 20-feet apart. A minimum of six (6) channelizing devices shall be used for each taper length.
9. Buffer and taper areas on approach to any work area shall be kept clear of vehicles and equipment.

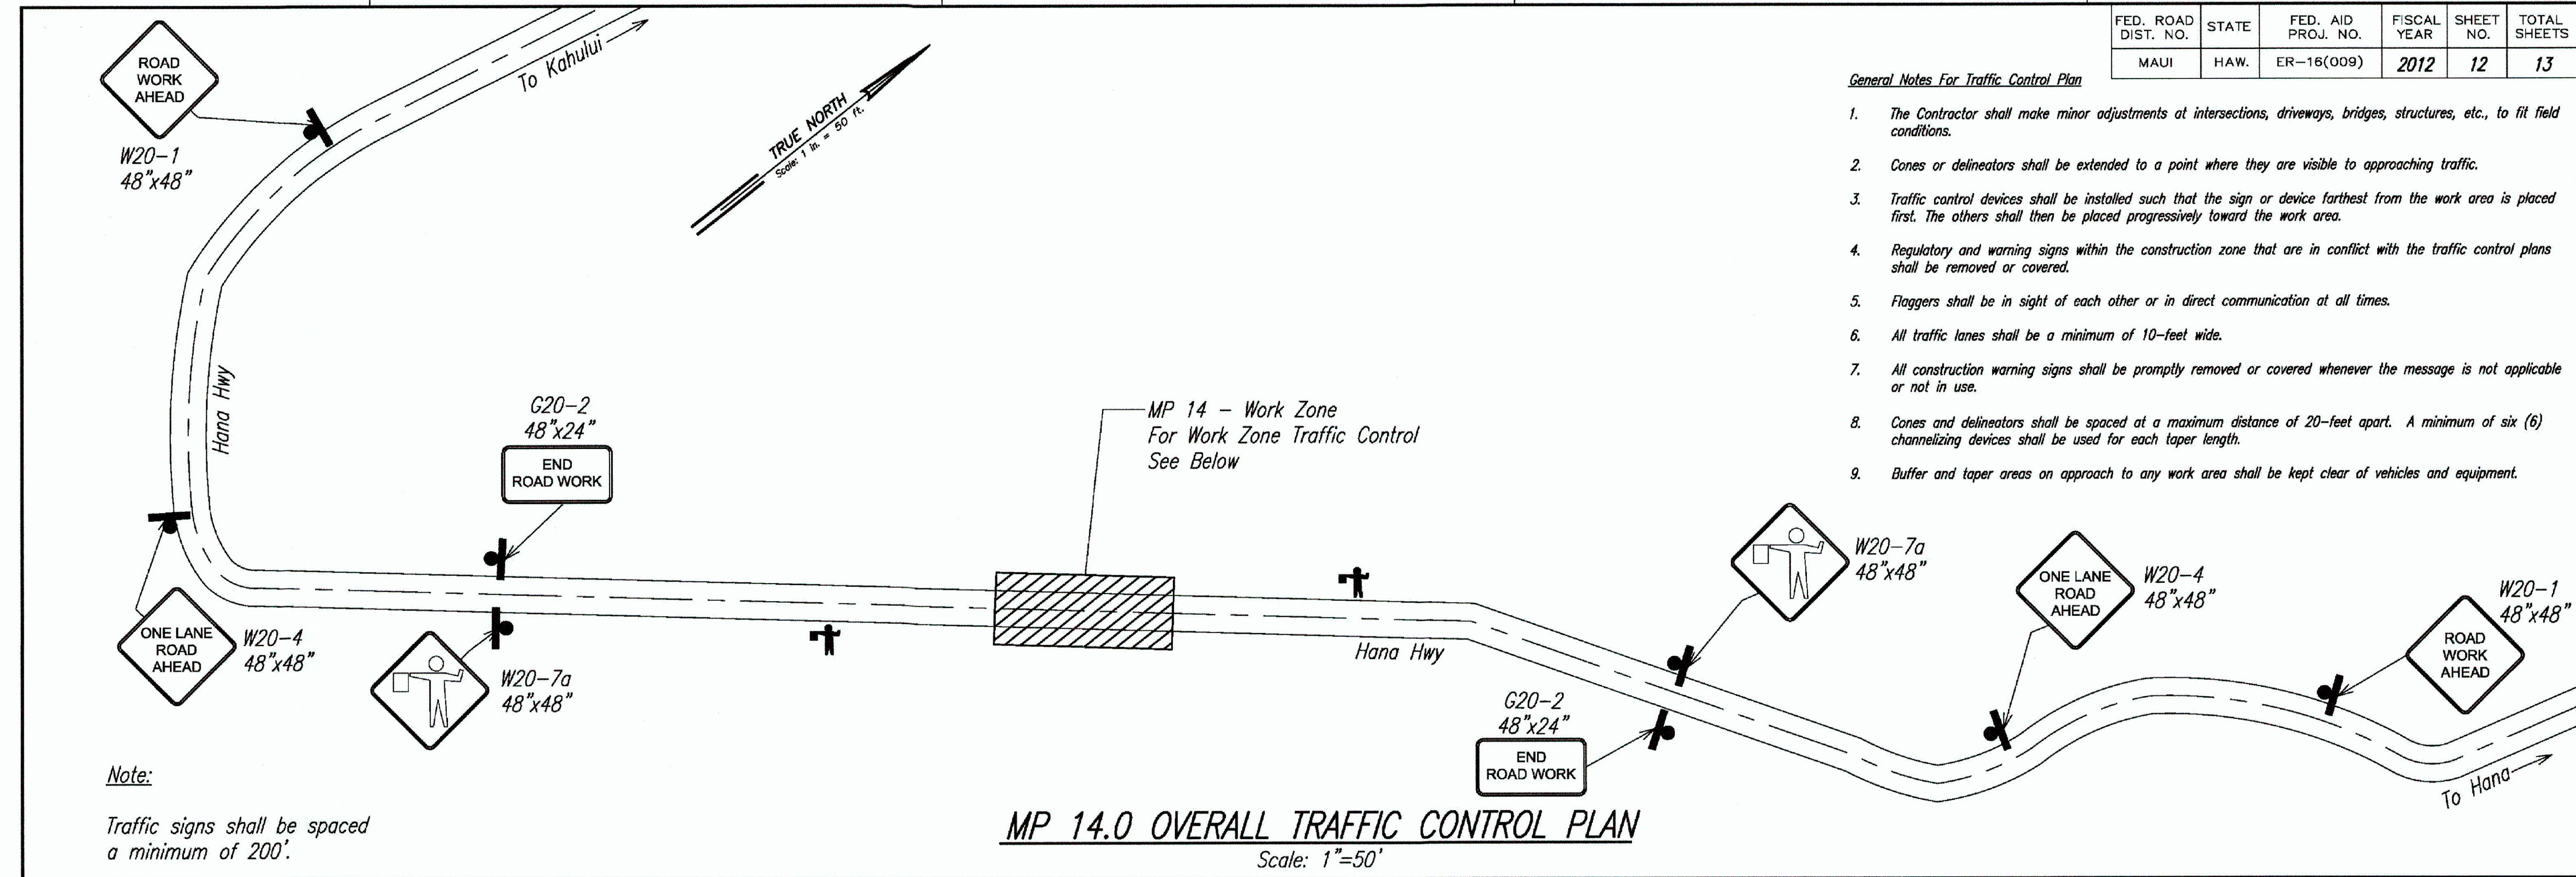

Note:
Traffic signs shall be spaced a minimum of 200'.

MP 14.0 OVERALL TRAFFIC CONTROL PLAN
Scale: 1"=50'

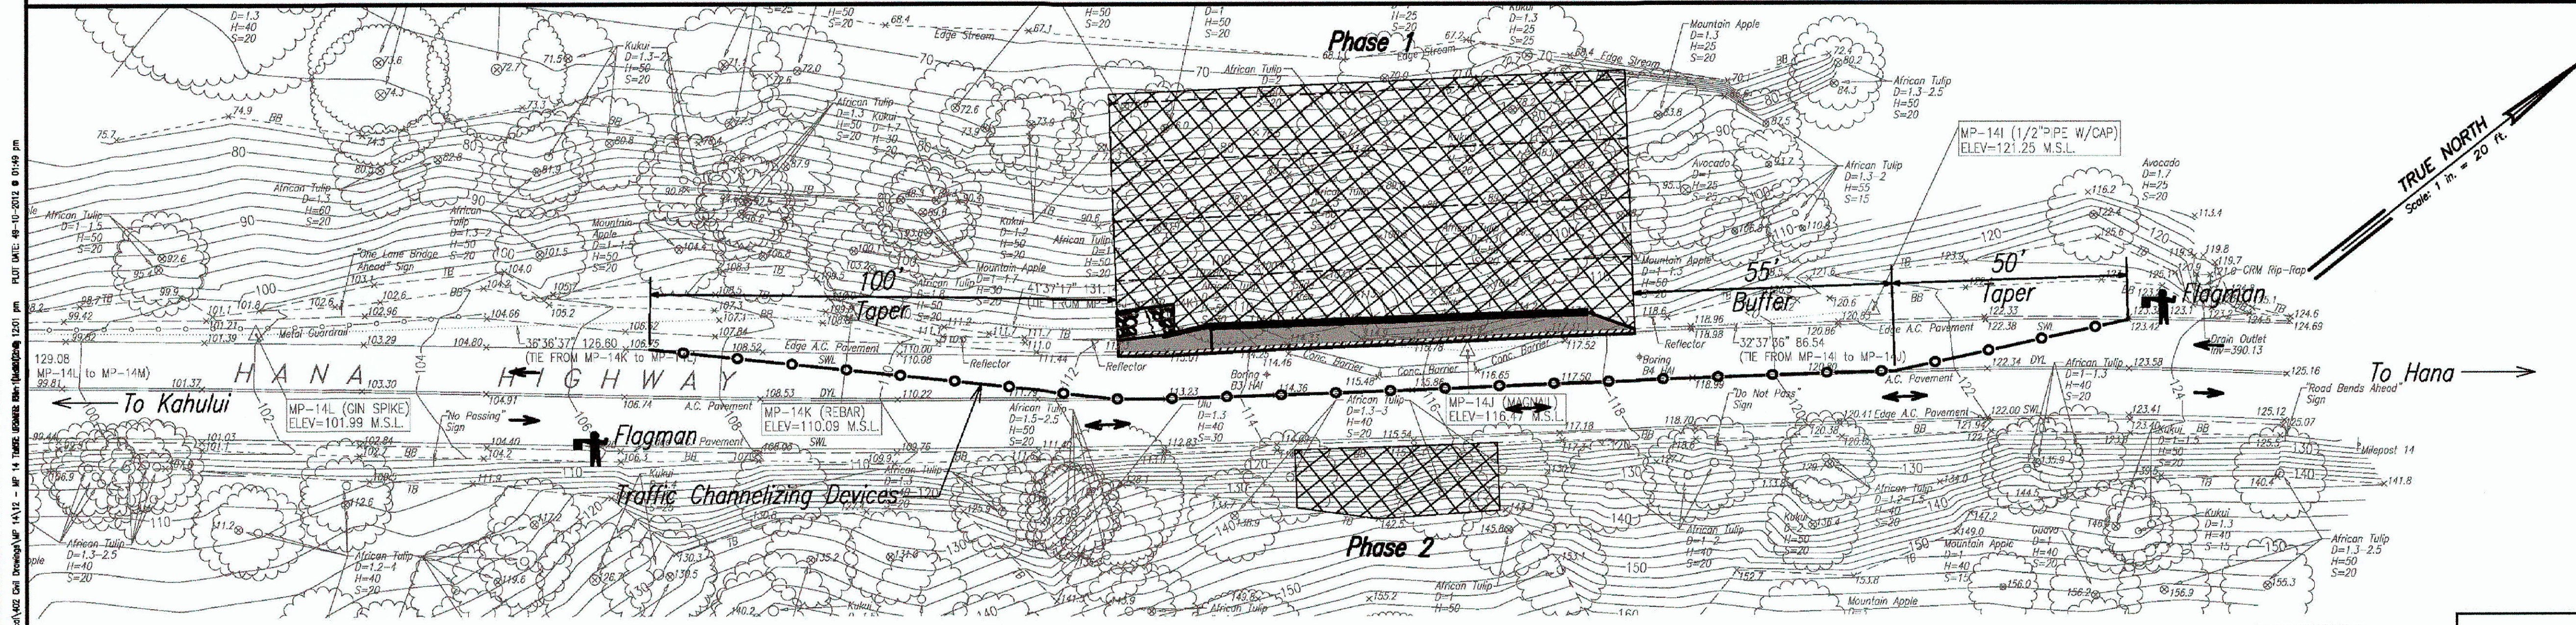

Legend:

- Flagman
- Traffic Channelizing Device
- Work Zone

MP 14.0 WORK ZONE TRAFFIC CONTROL PLAN
Scale: 1"=20'

LEGEND FOR AS-BUILT POSTINGS

- Squiggly line for as-built deletion
- Double line for as-built deletion
- Text for as-built posting

AECOM

ARDALAN R. NIKOU
LICENSED PROFESSIONAL ENGINEER
No. 8198-C
HAWAII, U.S.A.

STATE OF HAWAII
DEPARTMENT OF TRANSPORTATION
HIGHWAYS DIVISION

PH 1 - TRAFFIC CONTROL PLAN
(MAKAI WORK)

HANA HIGHWAY EMERGENCY REPAIRS
MILEPOST 14.0


FEDERAL-AID PROJECT NO. ER-16(009)
Scale: As Noted Date: July 10, 2012

SHEET No. 12 OF 13 SHEETS

DATE	_____
SURVEY PLOTTED BY	_____
DRAWN BY	_____
DESIGNED BY	_____
CHECKED BY	_____
NO.	_____


"AS-BUILT"

FED. ROAD DIST. NO.	STATE	FED. AID PROJ. NO.	FISCAL YEAR	SHEET NO.	TOTAL SHEETS
MAUI	HAW.	ER-16(009)	2012	13	13

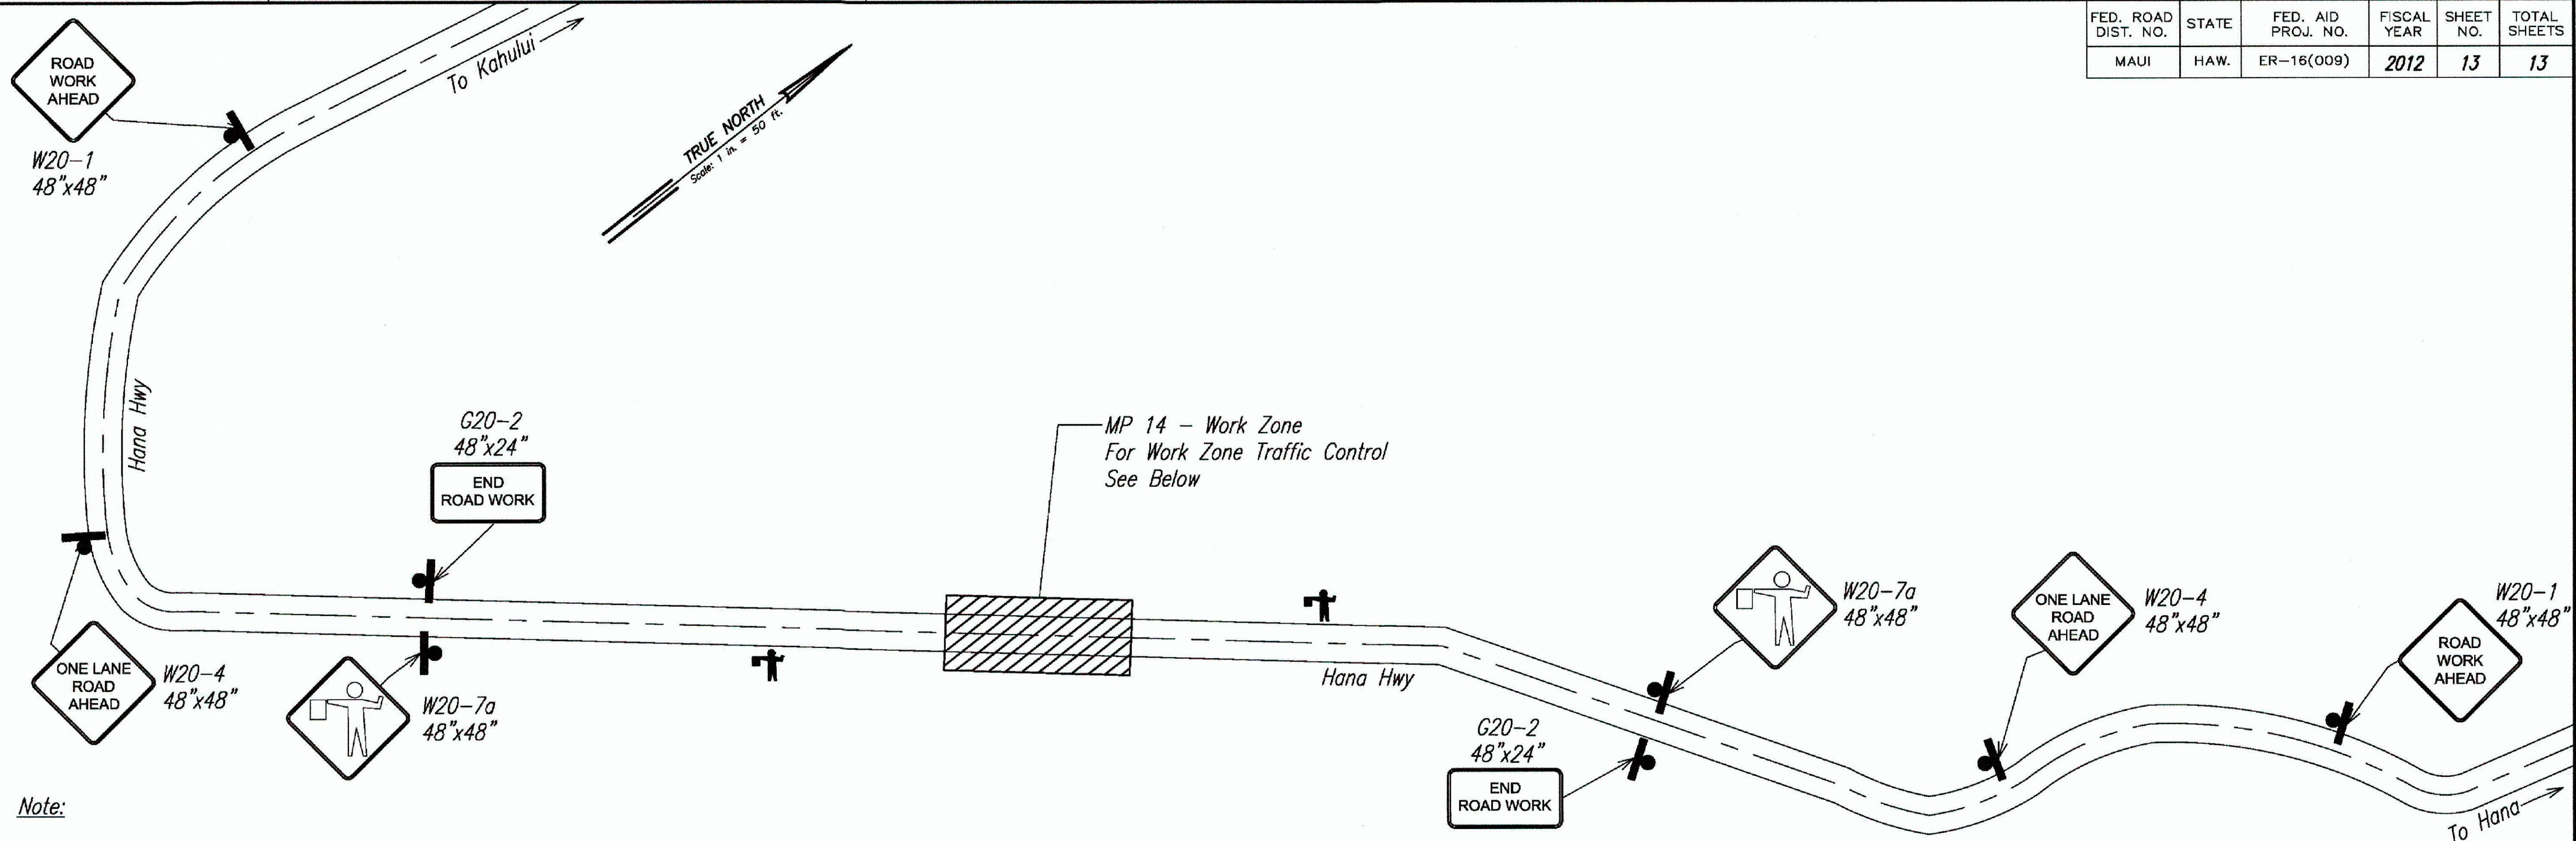

Note:
Traffic signs shall be spaced
a minimum of 200'.

MP 14.0 OVERALL TRAFFIC CONTROL PLAN
Scale: 1"=50'

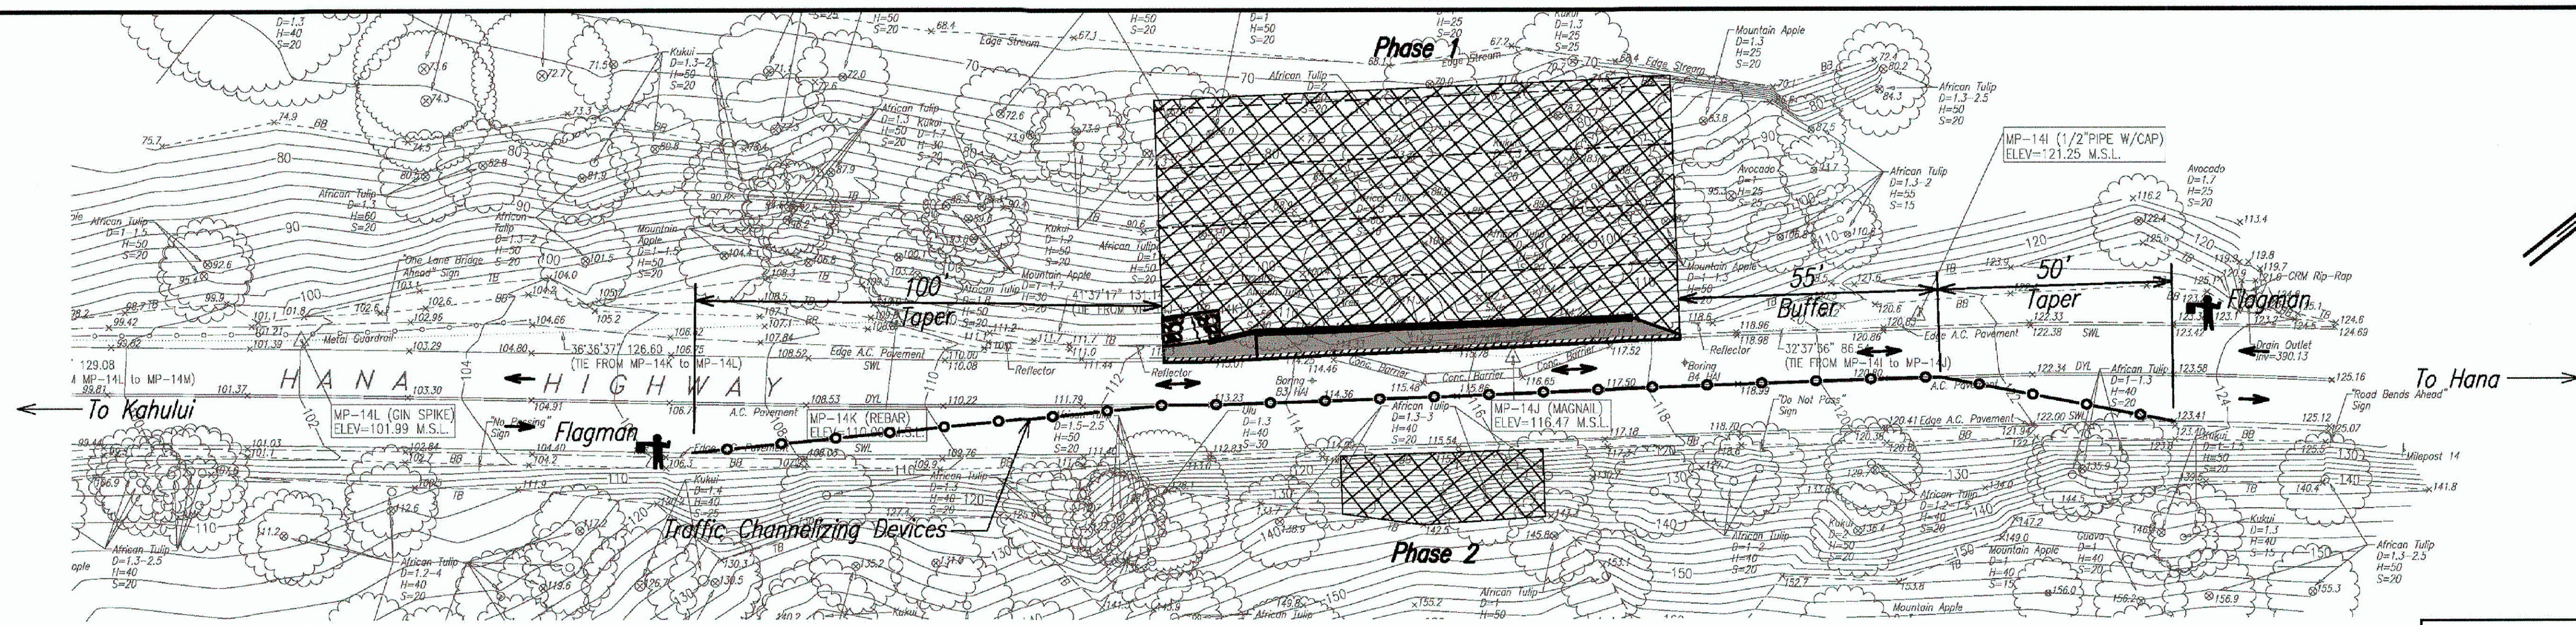

Legend:

Flagman

Traffic Channelizing Device

Work Zone


LEGEND FOR AS-BUILT POSTINGS

Squiggly line for as-built deletion

Double line for as-built deletion

Text for as-built posting

AECOM

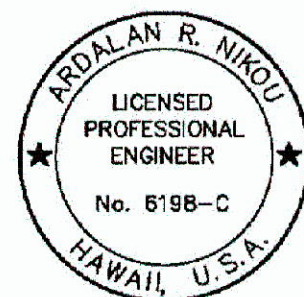

STATE OF HAWAII
DEPARTMENT OF TRANSPORTATION
HIGHWAYS DIVISION

PH 2 - TRAFFIC CONTROL PLAN
(MAUKA WORK)

HANA HIGHWAY EMERGENCY REPAIRS
MILEPOST 14.0

FEDERAL-AID PROJECT NO. ER-16(009)
Scale: As Noted Date: July 10, 2012

SHEET No. 13 OF 13 SHEETS

MP 14.0 WORK ZONE TRAFFIC CONTROL PLAN
Scale: 1"=20'

"AS-BUILT"