
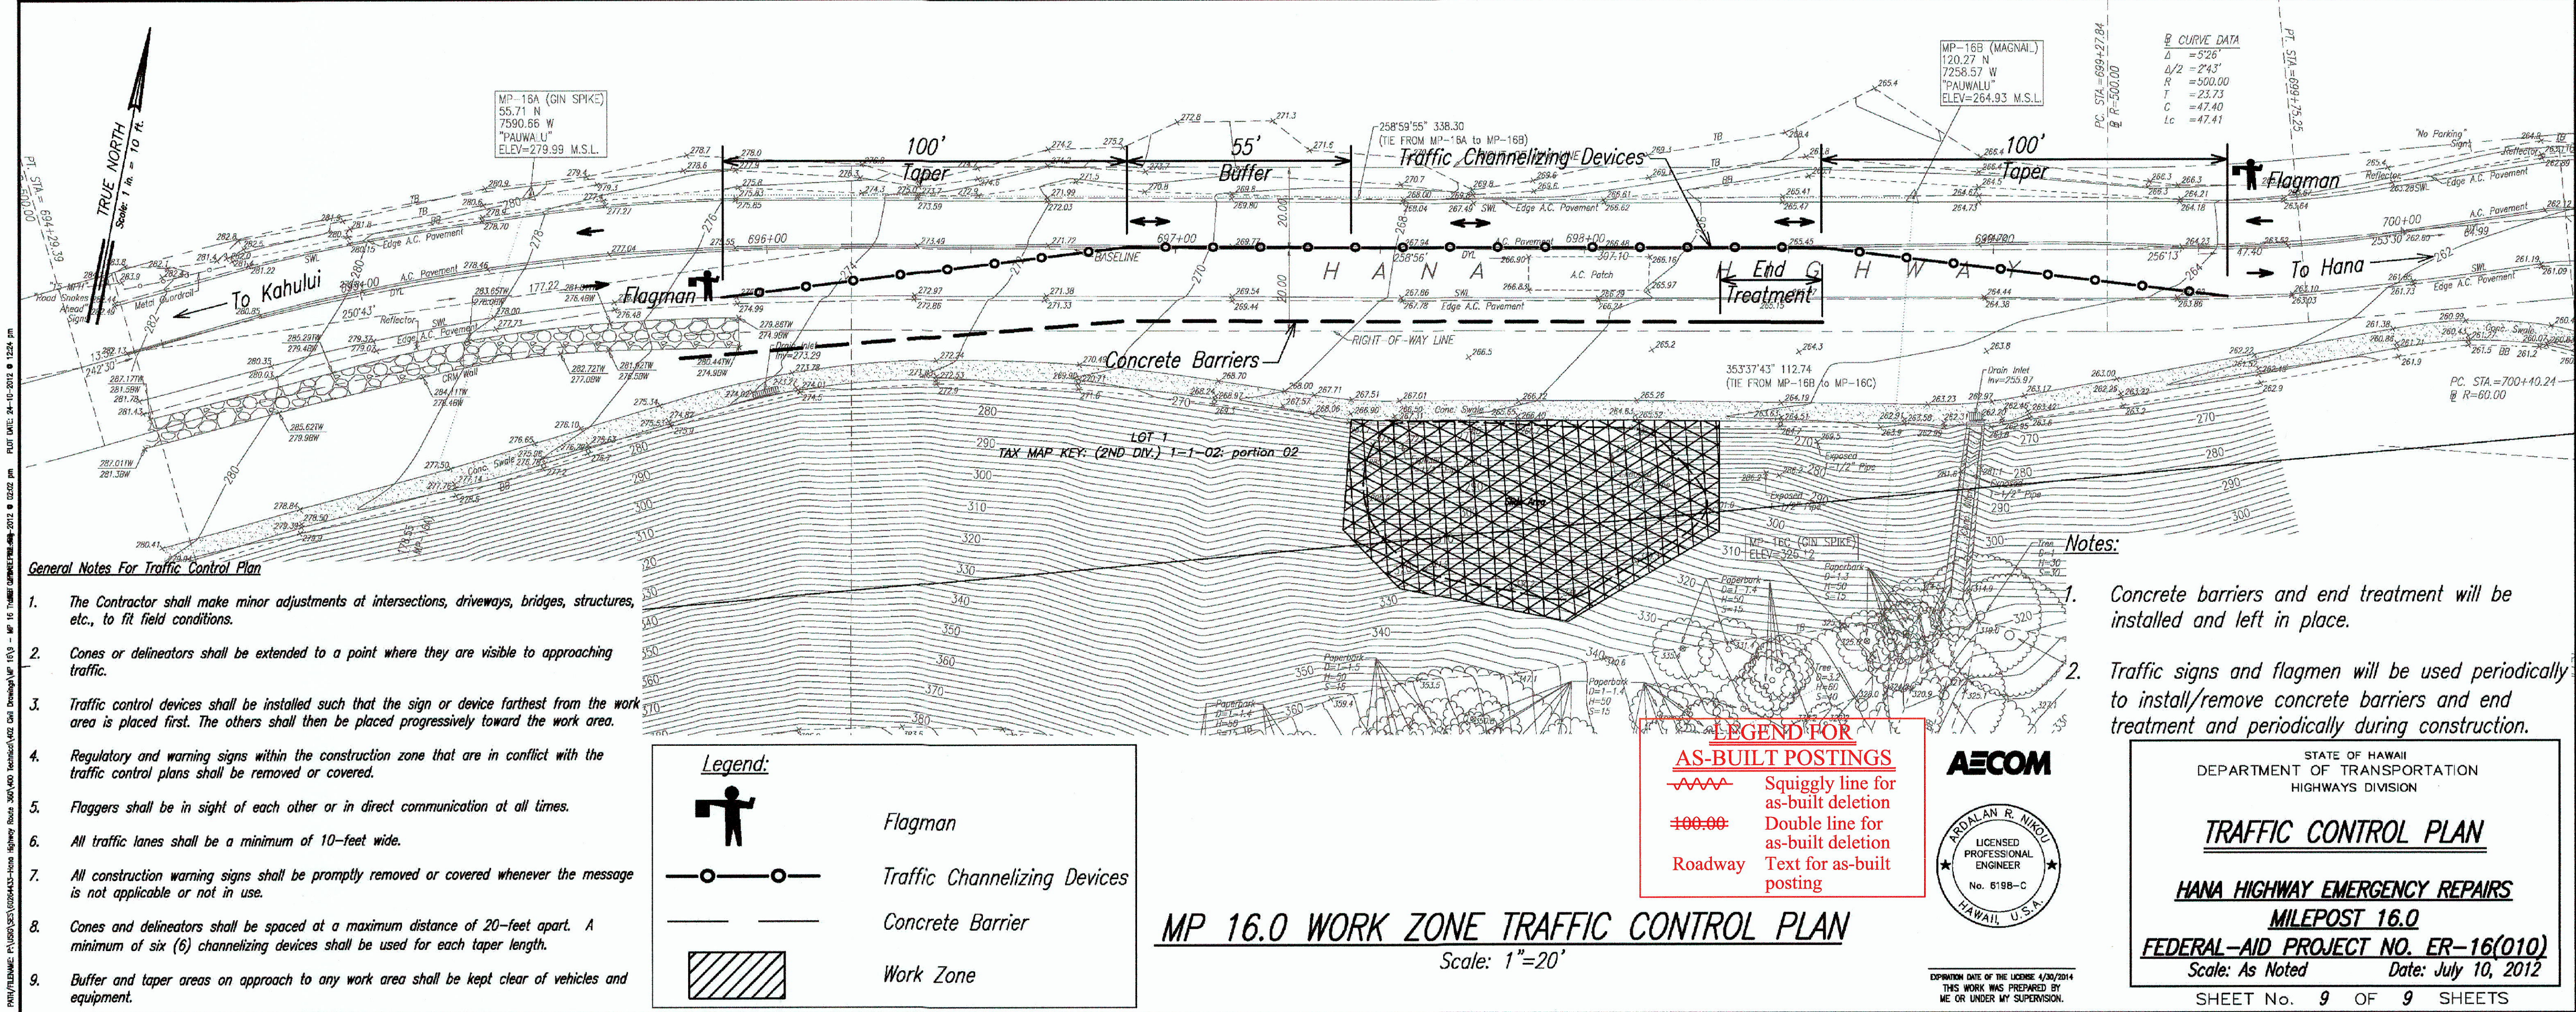


| FED. ROAD DIST. NO. | STATE | FED. AID PROJ. NO. | FISCAL YEAR | SHEET NO. | TOTAL SHEETS |
|---------------------|-------|--------------------|-------------|-----------|--------------|
| MAUI                | HAW.  | ER-16(010)         | 2012        | 9         | 9            |

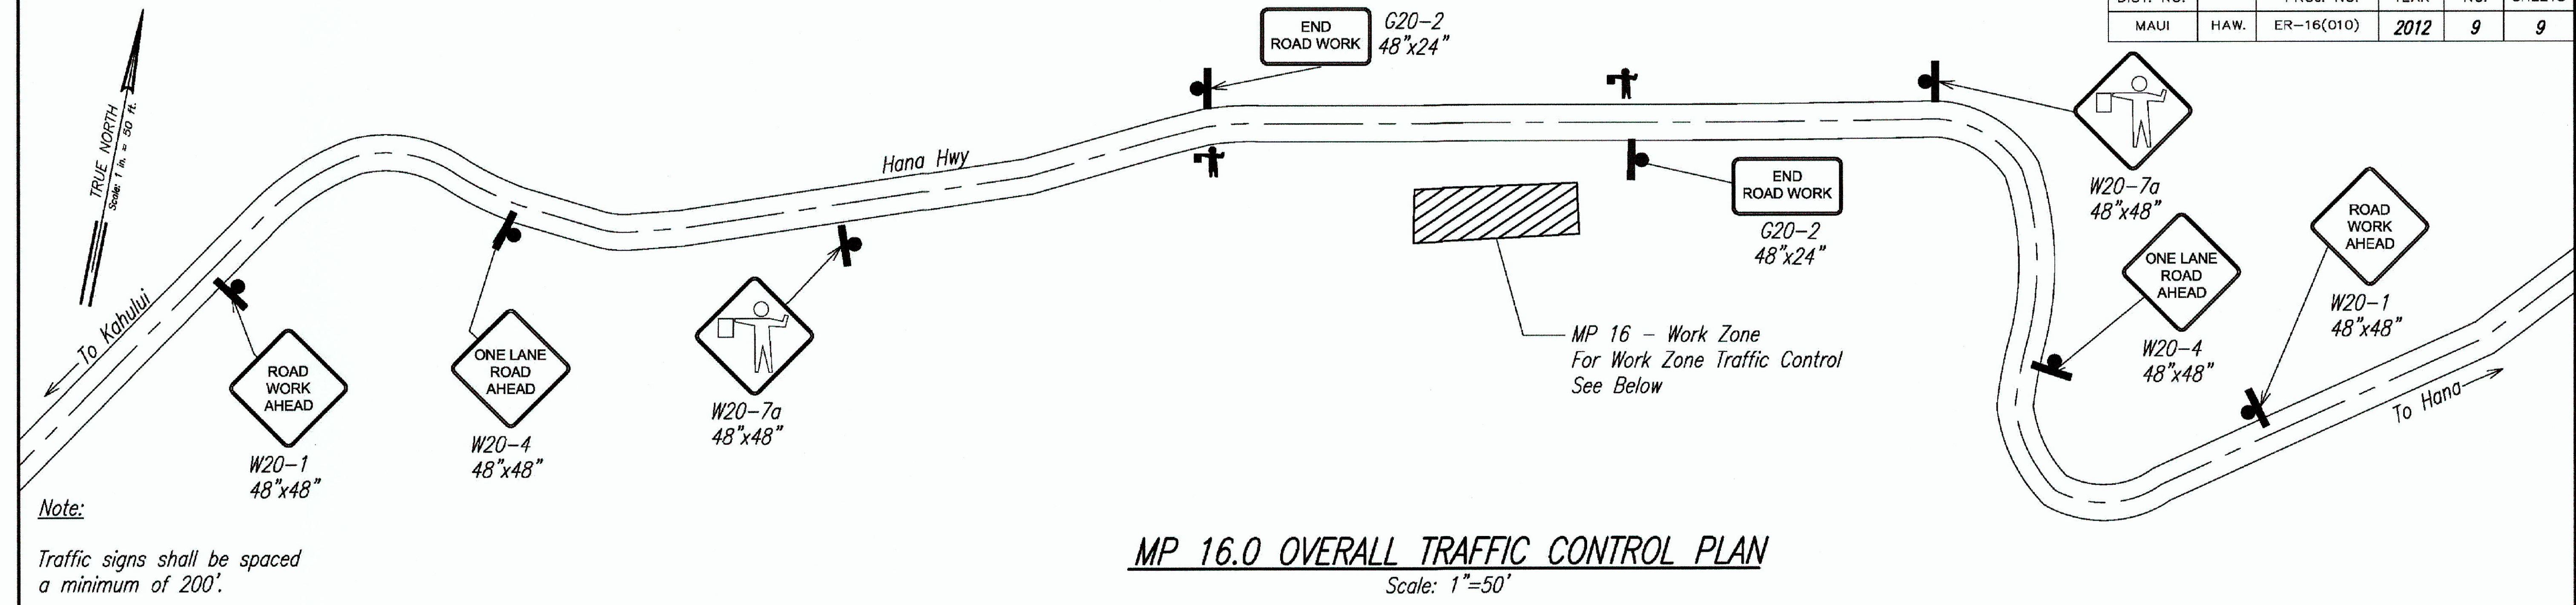

"AS-BUILT"