




FED. ROAD DIST. NO.	STATE	FED. AID PROJ. NO.	FISCAL YEAR	SHEET NO.	TOTAL SHEETS
MAUI	HAW.	ER-16(008)	2012	6	14

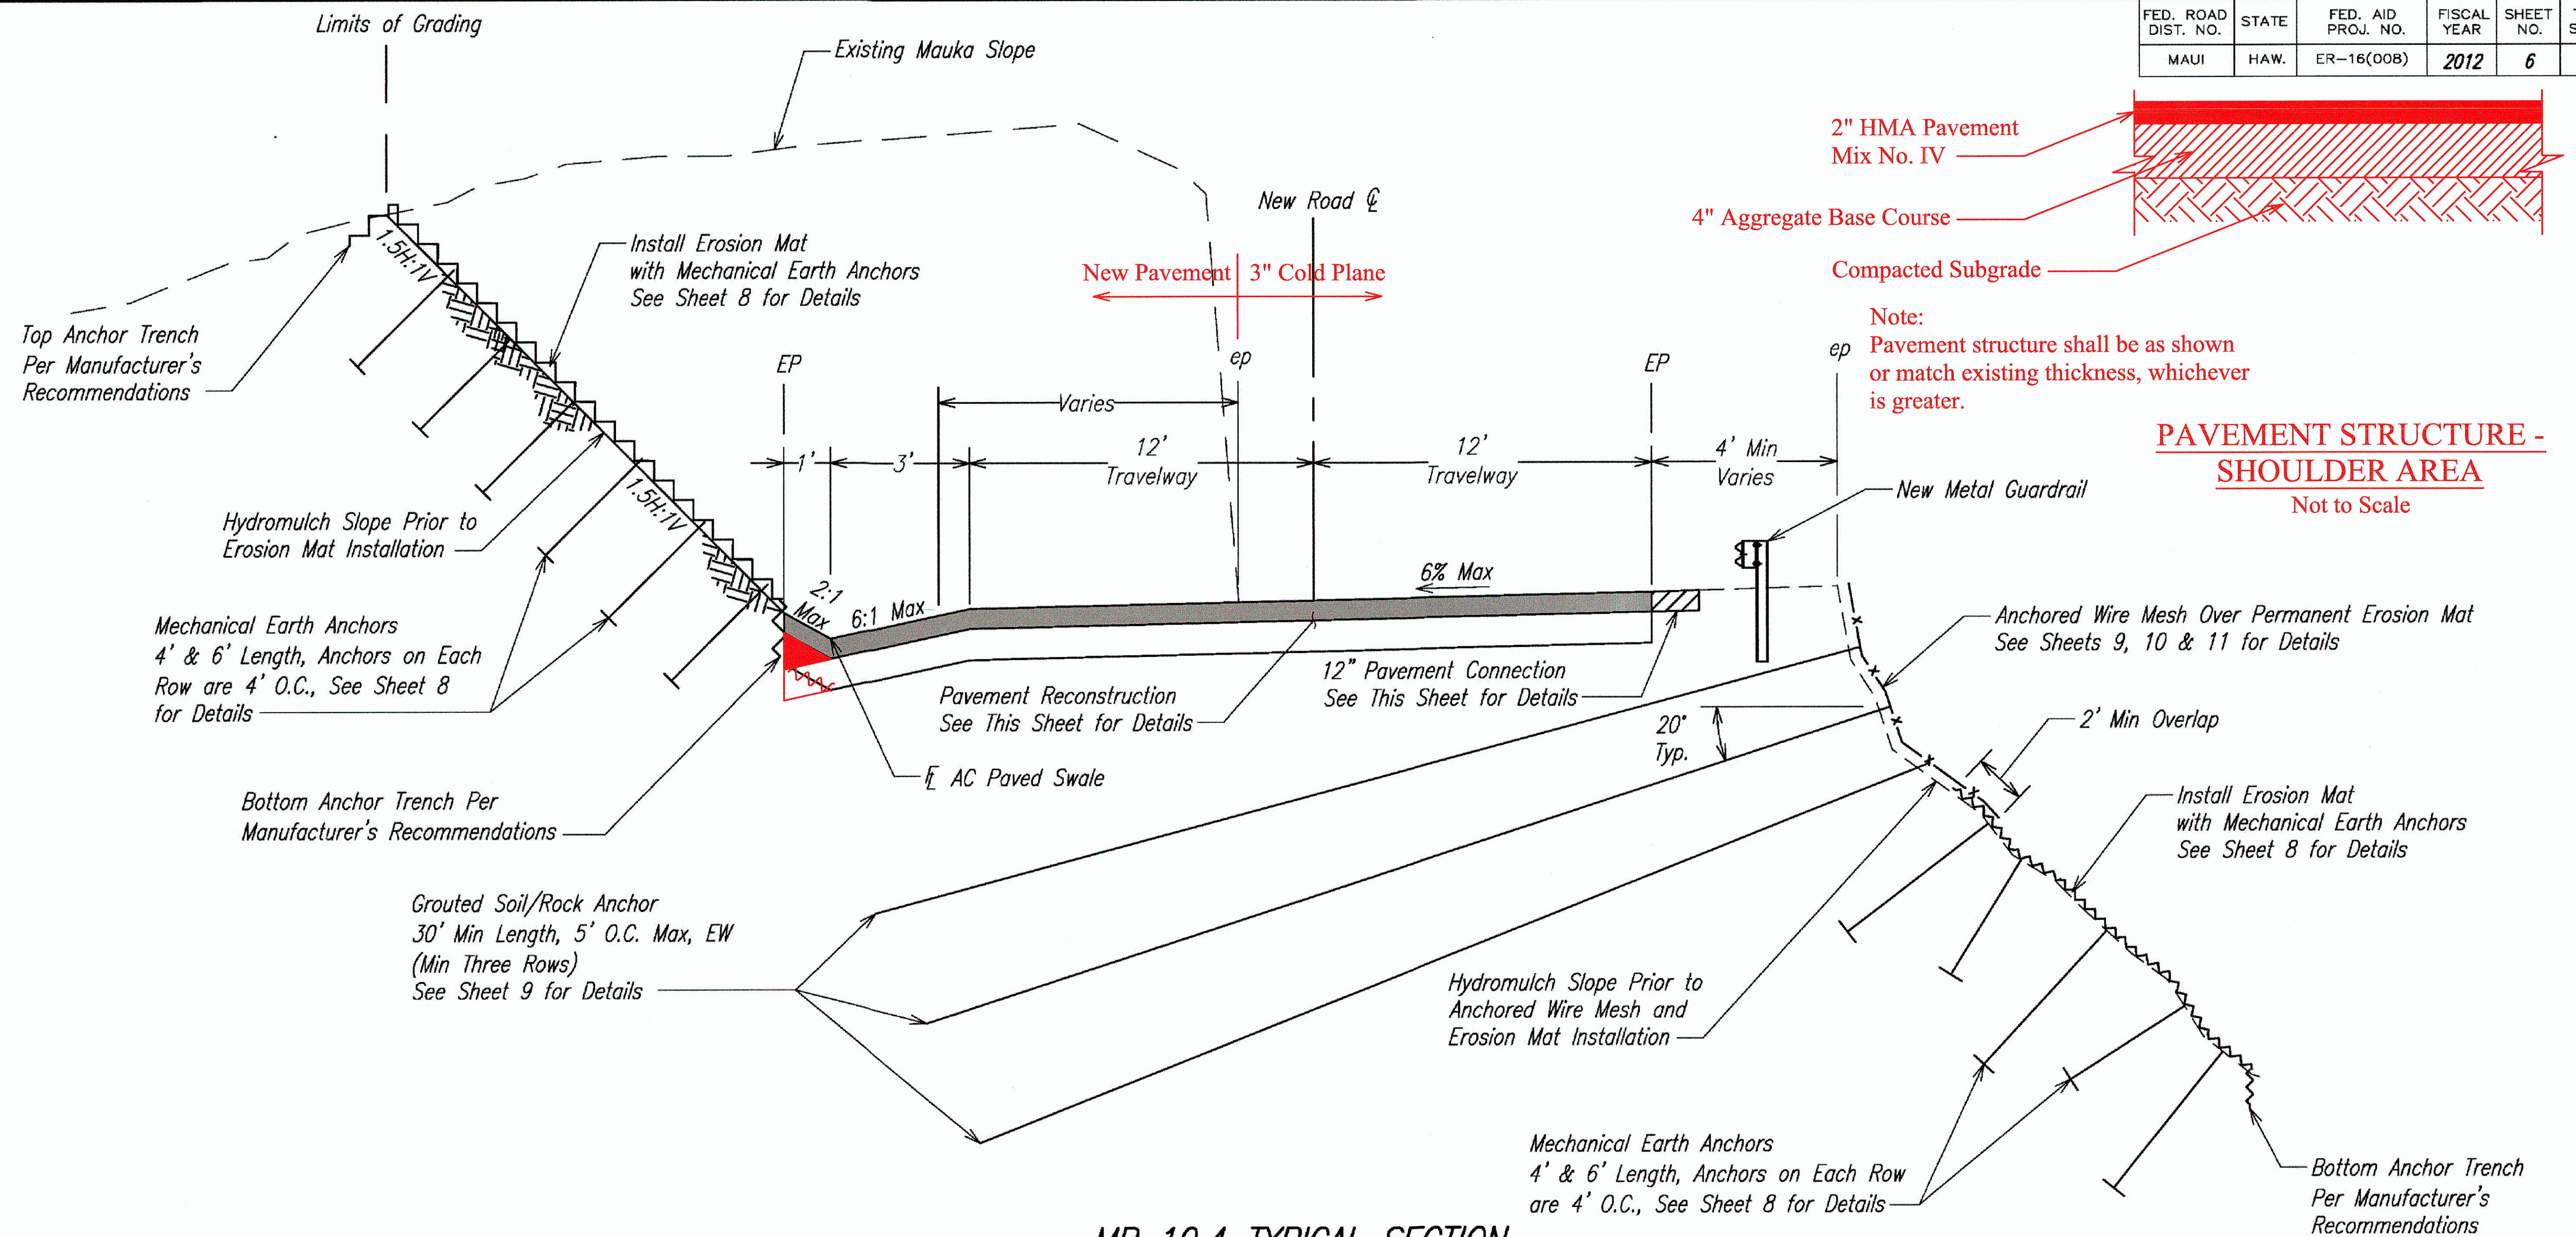

MP 10.4 TYPICAL SECTION
Not to Scale

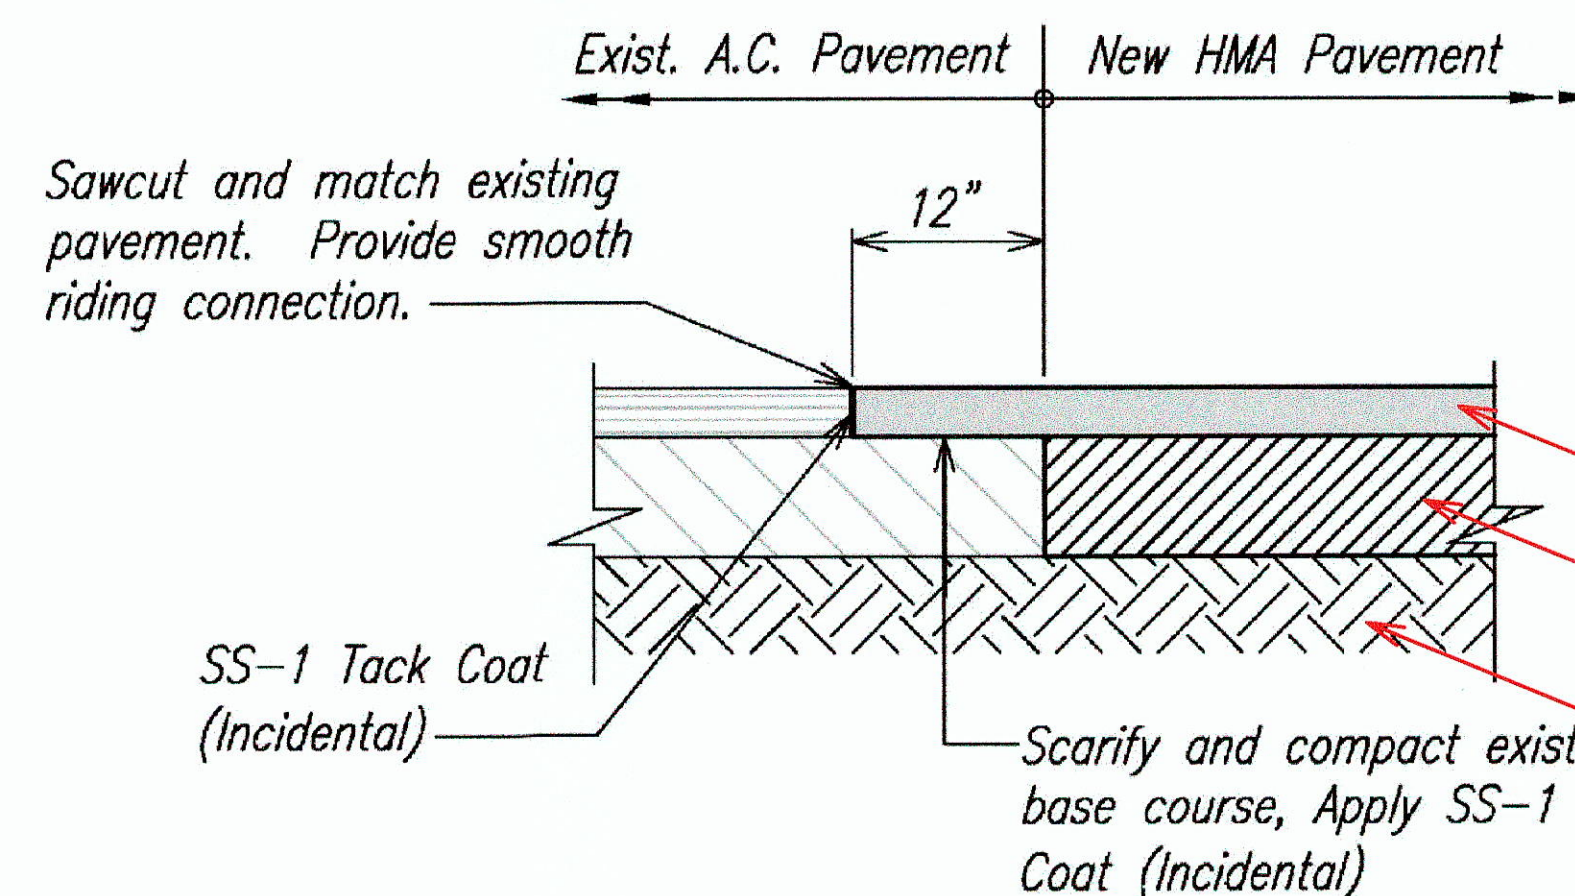

PAVEMENT CONNECTION DETAIL
Not To Scale

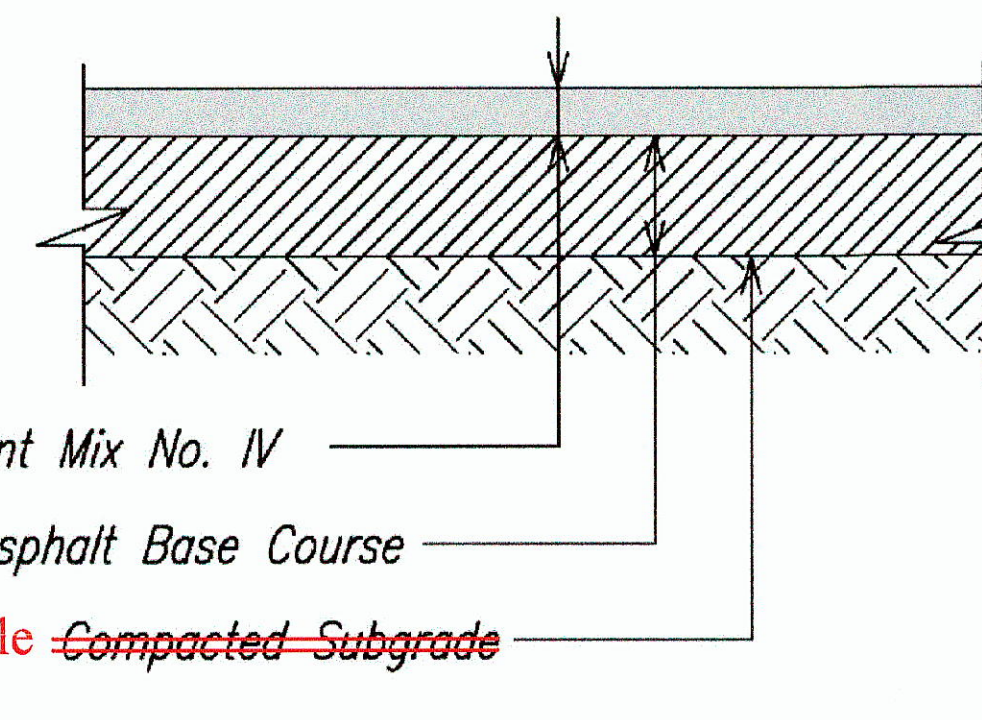


PAVEMENT STRUCTURE
Not To Scale

Note:

Pavement structure shall be as shown or match existing thickness, whichever is greater.

LEGEND FOR AS-BUILT POSTINGS
 Squiggly line for as-built deletion
 Double line for as-built deletion
 Text for as-built posting

AECOM

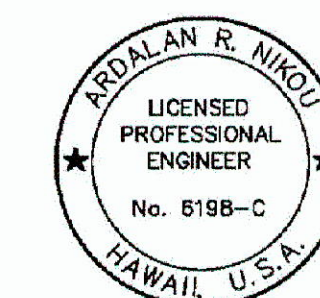

EXPIRATION DATE OF THE LICENSE: 4/30/2014
THIS WORK WAS PREPARED BY ME OR UNDER MY SUPERVISION.

STATE OF HAWAII
DEPARTMENT OF TRANSPORTATION
HIGHWAYS DIVISION

TYPICAL SECTION & PAVEMENT DETAILS
HANA HIGHWAY EMERGENCY REPAIRS
MILEPOST 10.4
FEDERAL-AID PROJECT NO. ER-16(008)
Scale: As Noted Date: July 10, 2012

SHEET No. 6 OF 14 SHEETS

"AS-BUILT"

