



FED. ROAD DIST. NO.	STATE	FED. AID PROJ. NO.	FISCAL YEAR	SHEET NO.	TOTAL SHEETS
MAUI	HAW.	ER-16(009)	2012	3	13

PRIN/TERMINAL: P:\PROJECTS\1008432-Hana Highway Repairs\Drawings\MP 14.0 Typical Section.dwg 10/10/2012 11:53 am PLOT DATE: 06-10-2012 09:16:28 pm


SURVEY PLOTTED BY	DATE
DESIGNED BY	
NOTED BY	
QUANTITIES BY	
CHECKED BY	
ORIGINAL PLAN	
NOTE BOOK	
No.	

LEGEND FOR AS-BUILT POSTINGS

 Squiggly line for as-built deletion


 Double line for as-built deletion

Roadway Text for as-built posting

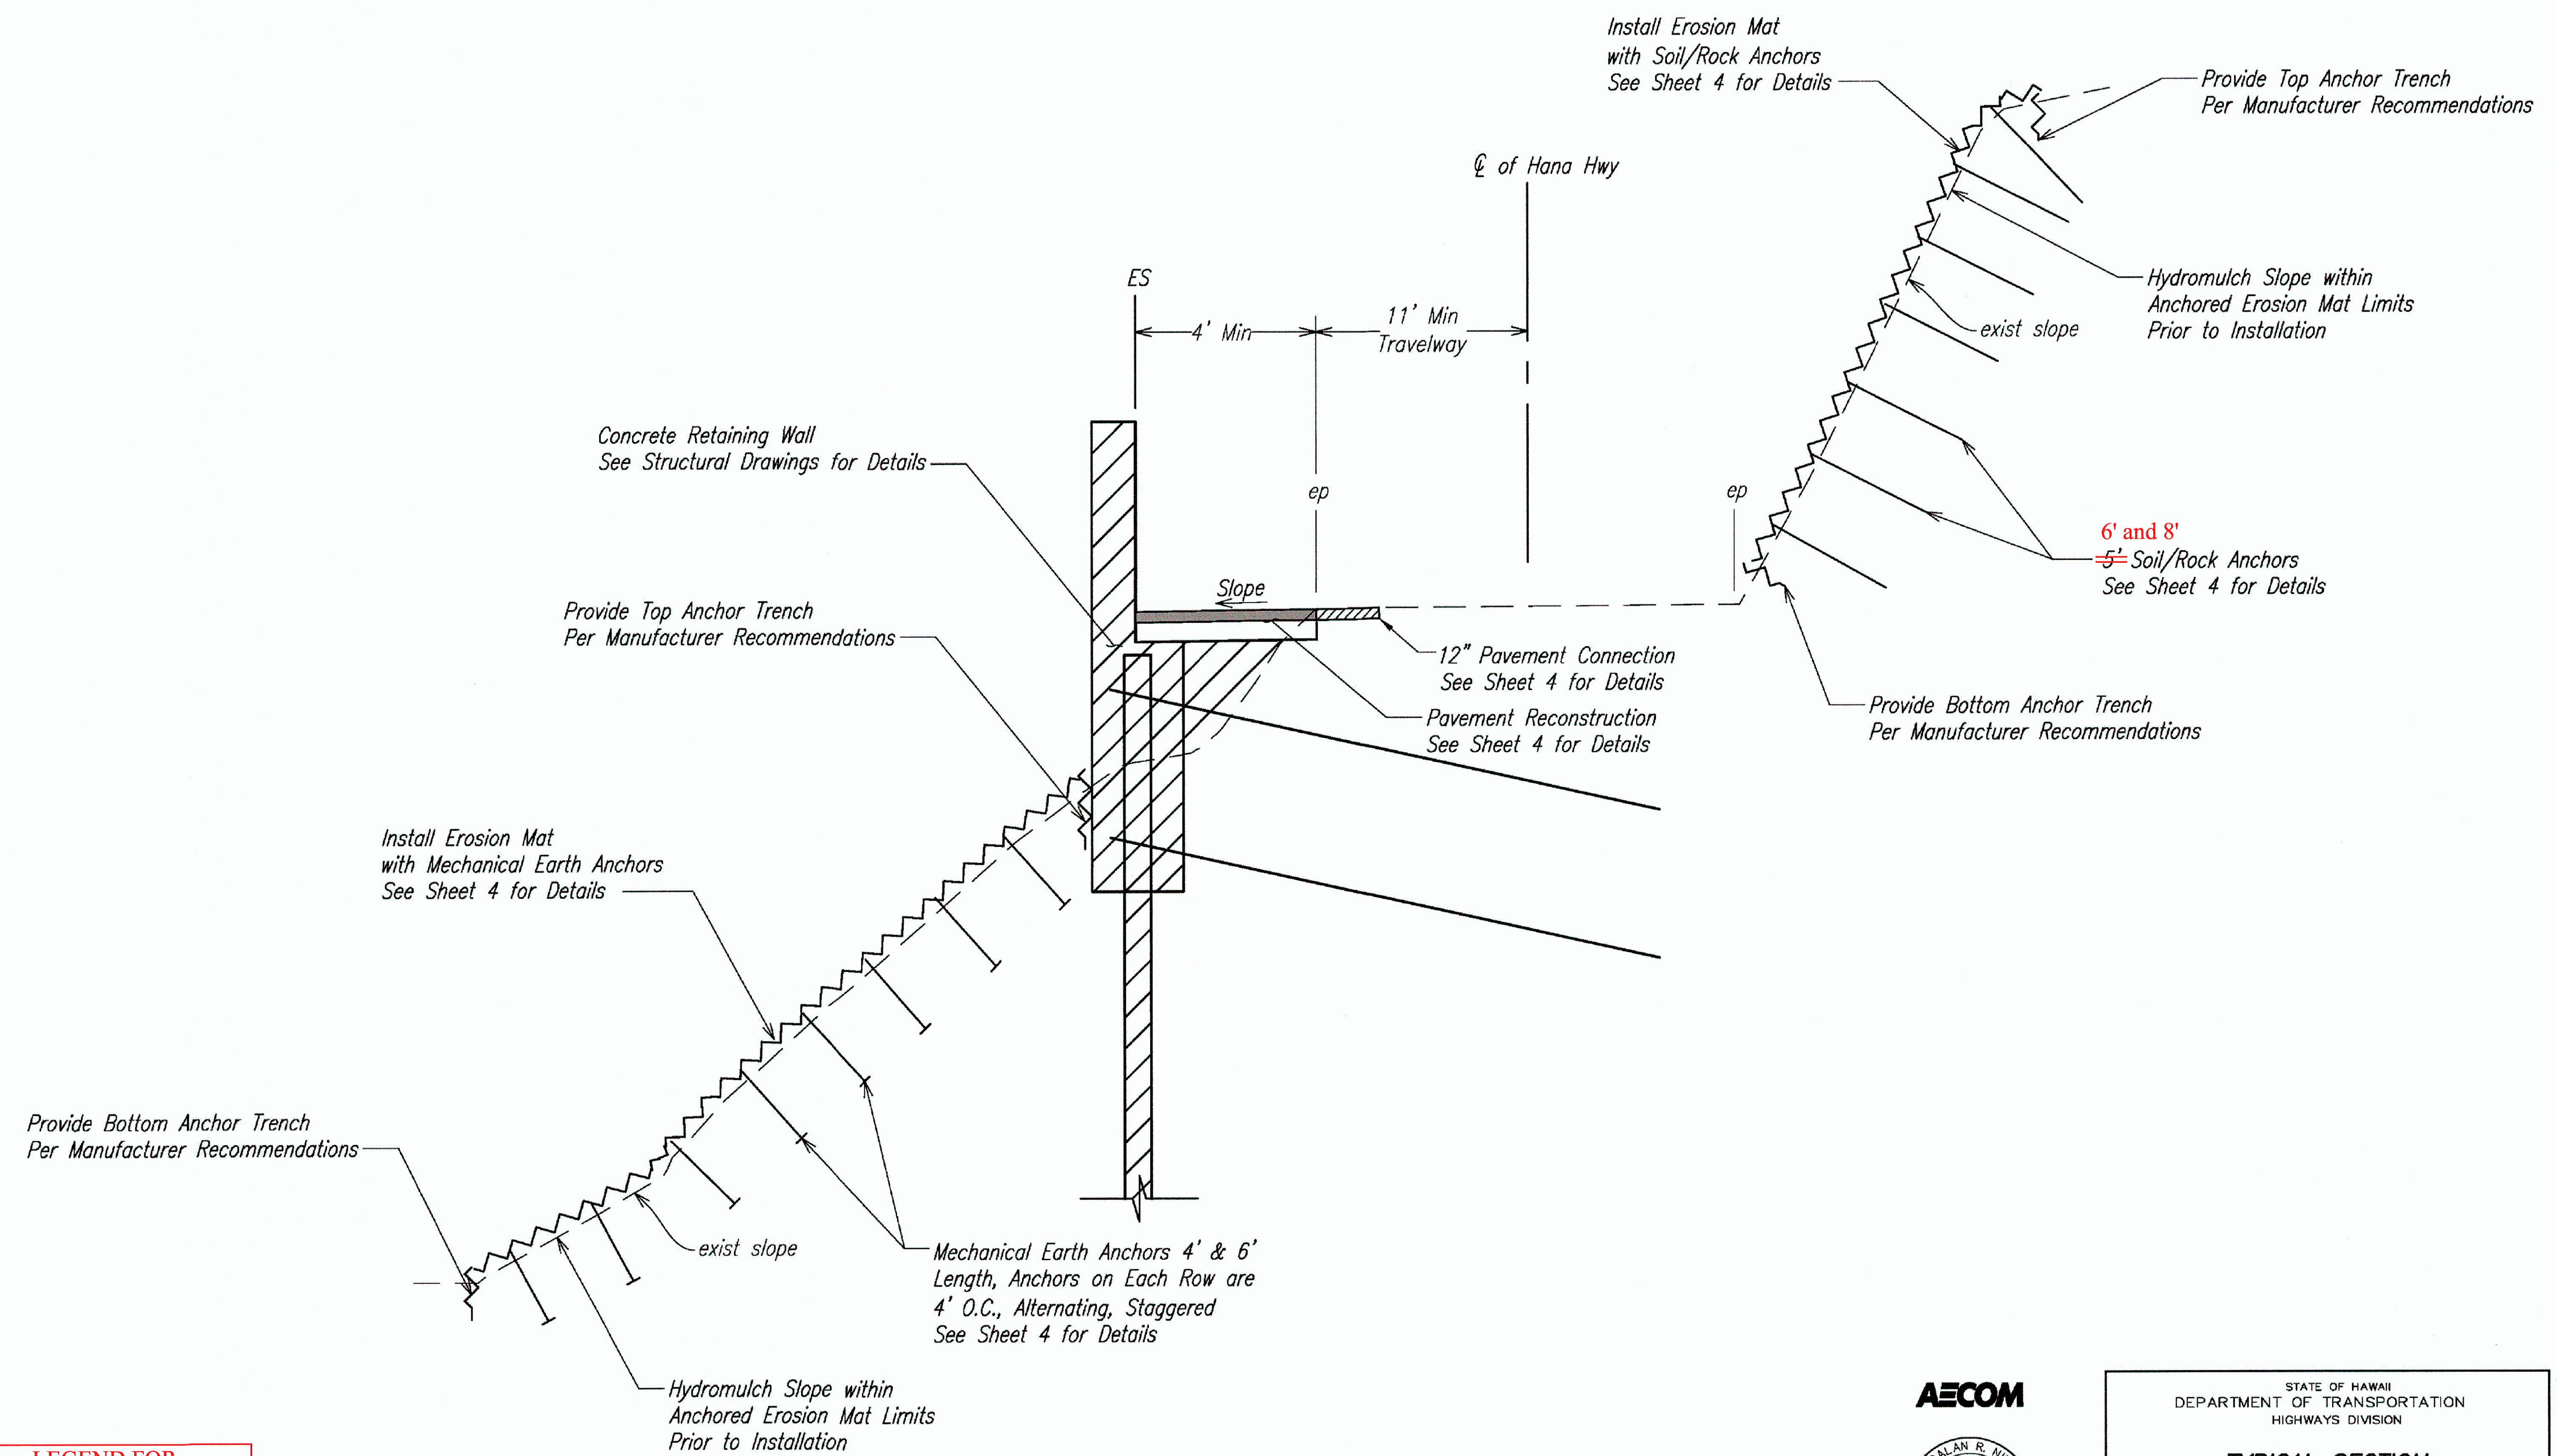

MP 14 TYPICAL SECTION
Not to Scale

AECOM

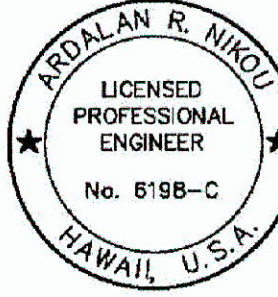

EXPIRATION DATE OF THE LICENSE: 4/30/2014
THIS WORK WAS PREPARED BY ME OR UNDER MY SUPERVISION.

STATE OF HAWAII
DEPARTMENT OF TRANSPORTATION
HIGHWAYS DIVISION

TYPICAL SECTION



HANA HIGHWAY EMERGENCY REPAIRS
MILEPOST 14.0

FEDERAL-AID PROJECT NO. ER-16(009)
Scale: As Noted Date: July 10, 2012

SHEET No. 3 OF 13 SHEETS

"AS-BUILT"


FED. ROAD DIST. NO.	STATE	FED. AID PROJ. NO.	FISCAL YEAR	SHEET NO.	TOTAL SHEETS
MAUI	HAW.	ER-16(009)	2012	C.O.3S-1	13

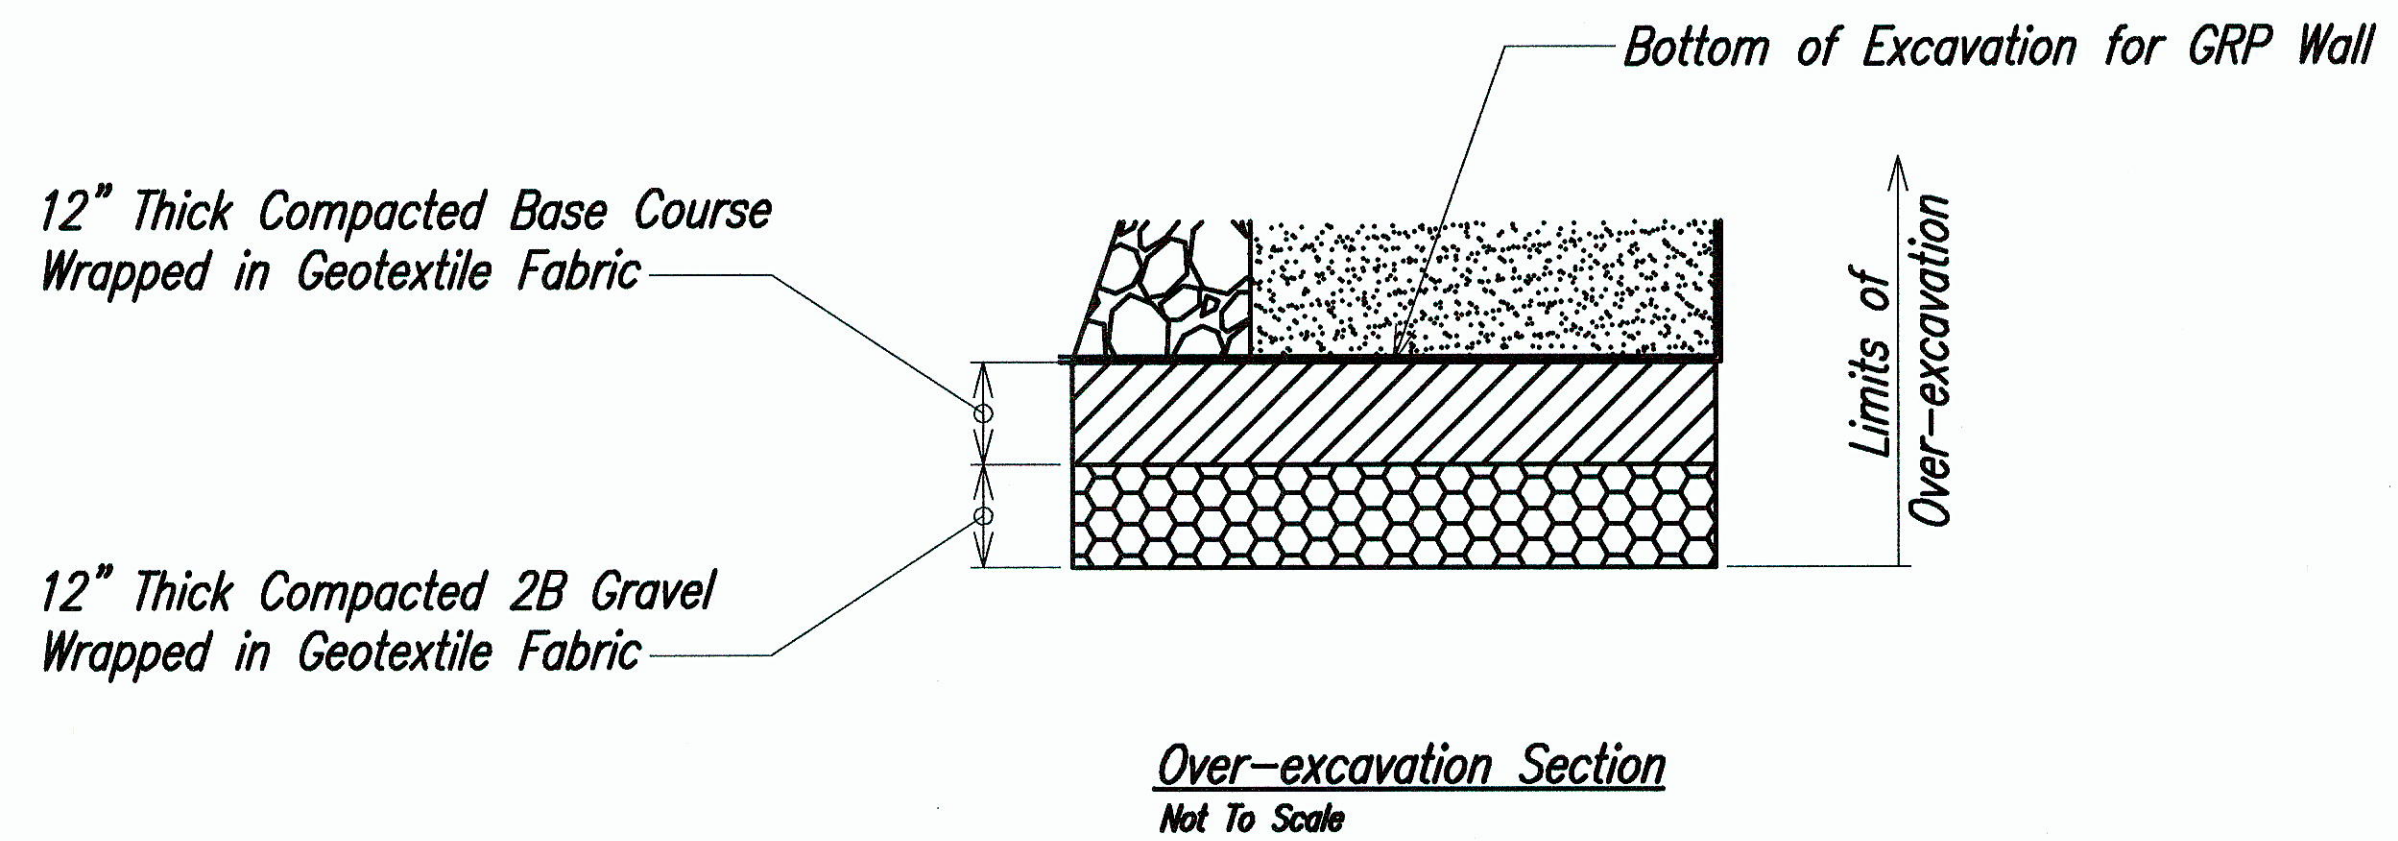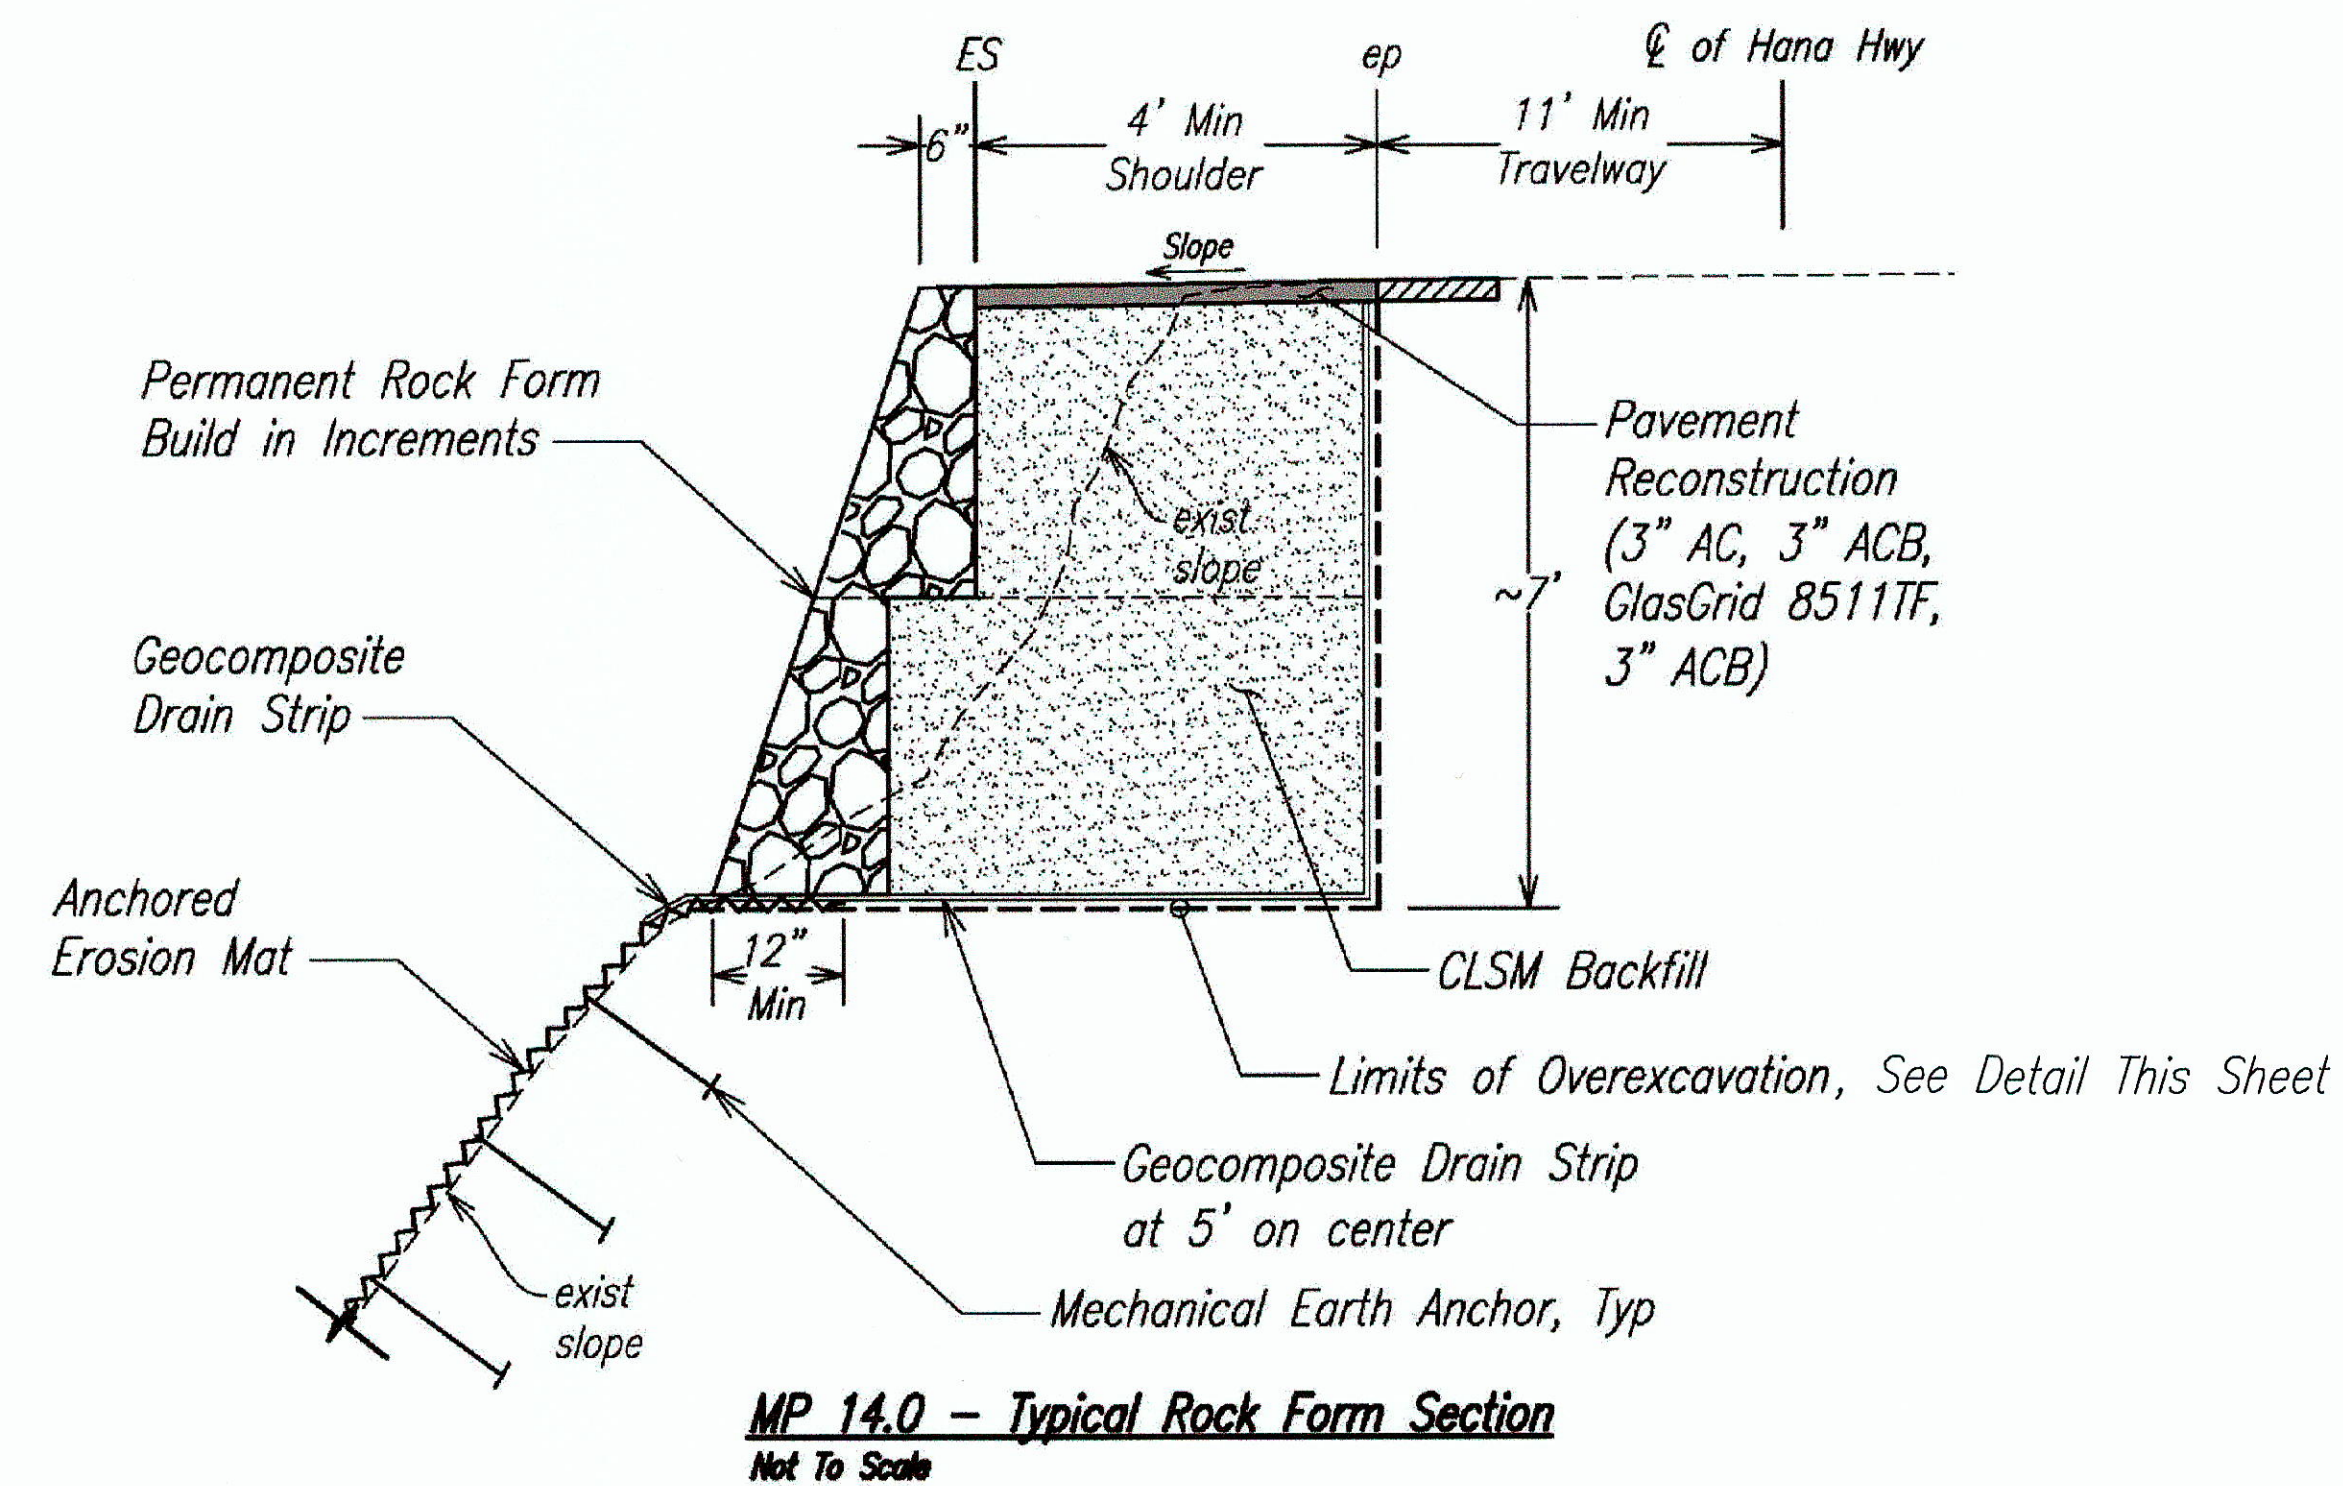

ORIGINAL PLAN	SURVEY PLOTTED BY	DATE
NOTE BOOK	DRAWN BY	
	DESIGNED BY	
	CHECKED BY	

LEGEND FOR AS-BUILT POSTINGS
~~~~~ Squiggly line for as-built deletion  
=00.00 Double line for as-built deletion  
Roadway Text for as-built posting

AECOM

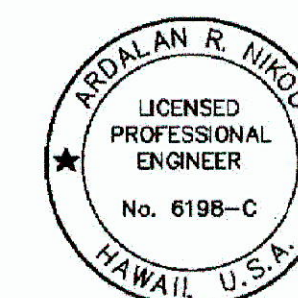

EXPIRATION DATE OF THE LICENSE: 4/30/2014  
THIS WORK WAS PREPARED BY ME OR UNDER MY SUPERVISION.

|                                                                      |
|----------------------------------------------------------------------|
| STATE OF HAWAII<br>DEPARTMENT OF TRANSPORTATION<br>HIGHWAYS DIVISION |
| <b>TYPICAL SECTION</b>                                               |
| <b>HANA HIGHWAY EMERGENCY REPAIRS</b>                                |
| <b>MILEPOST 14.0</b>                                                 |
| <b>FEDERAL-AID PROJECT NO. ER-16(009)</b>                            |
| Scale: As Noted Date: July 10, 2012                                  |
| SHEET No. OF SHEETS                                                  |

"AS-BUILT"

C.O.3S-1