



FED. ROAD DIST. NO.	STATE	FED. AID PROJ. NO.	FISCAL YEAR	SHEET NO.	TOTAL SHEETS
MAUI	HAW.	ER-16(010)	2012	4	9

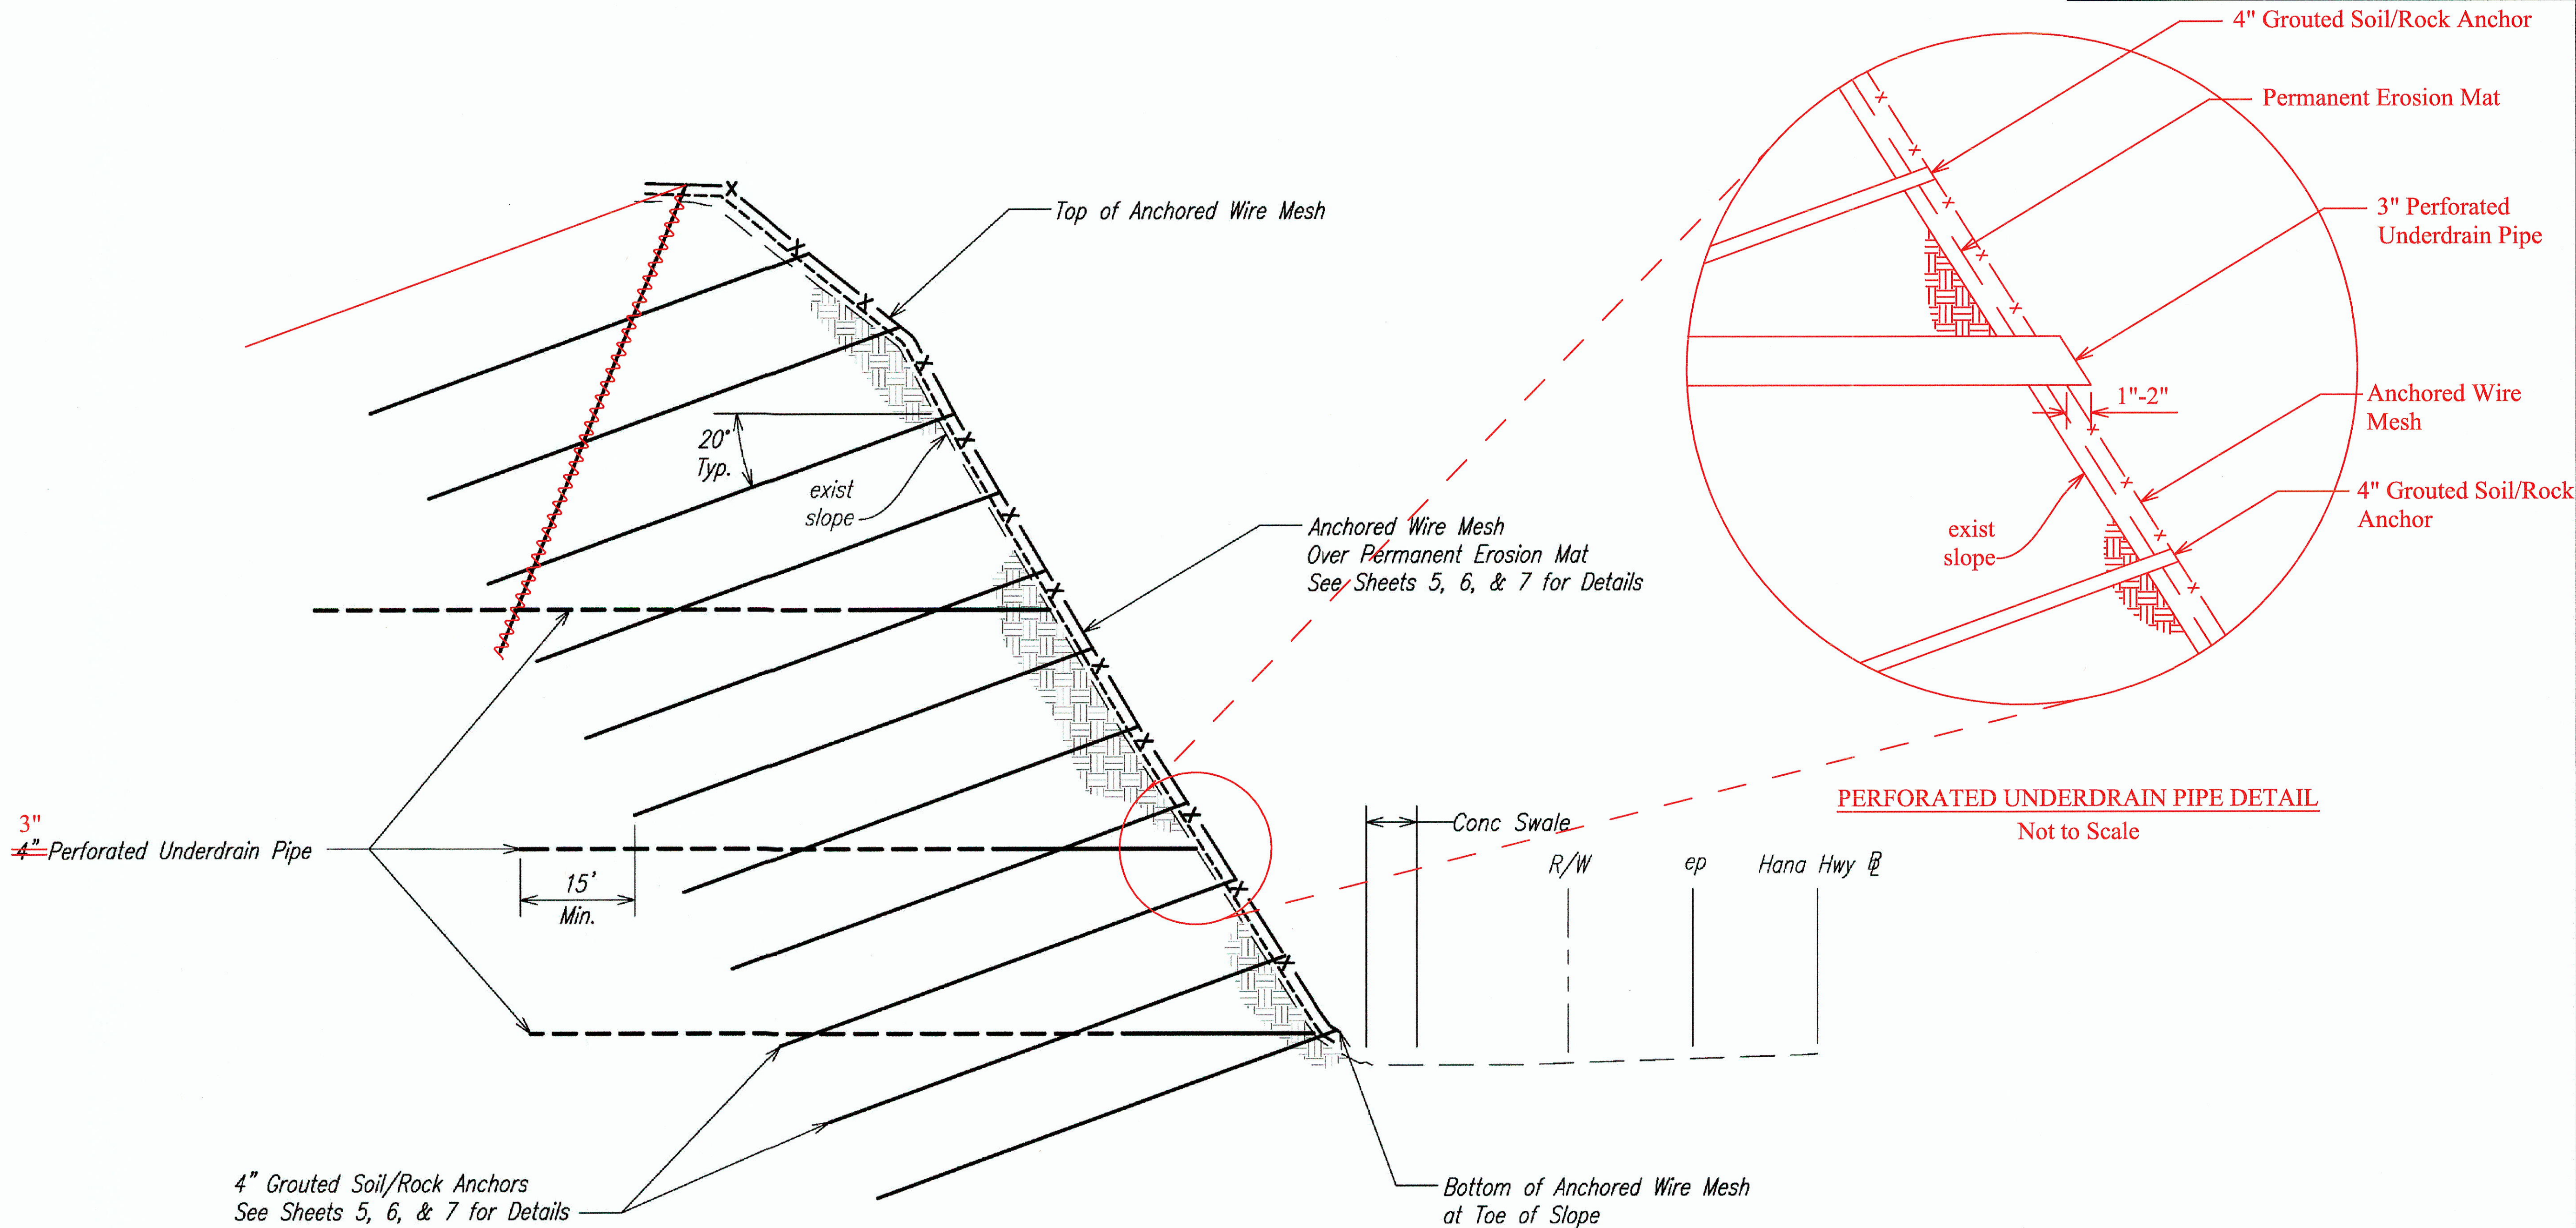

- LEGEND FOR AS-BUILT POSTINGS**
- Squiggly line for as-built deletion
  - Double line for as-built deletion
  - Roadway Text for as-built posting

**MP 16.0 TYPICAL SECTION**  
Not to Scale

**AECOM**

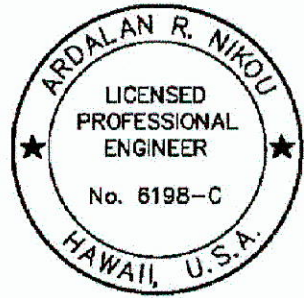

EXPIRATION DATE OF THE LICENSE: 4/30/2014  
THIS WORK WAS PREPARED BY ME OR UNDER MY SUPERVISION.

STATE OF HAWAII  
DEPARTMENT OF TRANSPORTATION  
HIGHWAYS DIVISION

**TYPICAL SECTION**

**HANA HIGHWAY EMERGENCY REPAIRS**  
**MILEPOST 16.0**  
**FEDERAL-AID PROJECT NO. ER-16(010)**  
Scale: As Noted Date: July 10, 2012

SHEET No. 4 OF 9 SHEETS

"AS-BUILT"