## WATER POLLUTION AND EROSION CONTROL NOTES:

- GENERAL:
- See Section 209 Temporary Water Pollution, Dust, and Erosion Control. Section 209 describes but is not limited to: submittal requirements; scheduling of a water pollution and erosion control conference with the Engineer; construction requirements; method of measurement; and basis of
- Effective October 1, 2008, follow the guidelines in the "Construction Best Management Practices Field Manual", dated January 2008 in developing, installing and maintaining the Best Management Practices (BMP) for the
- 3. Follow the guidelines in the Honolulu's City & County "Rules Relating to Soil Erosion Standards and Guidelines" along with applicable Soil Erosion Guidelines for projects on Maui, Molokai, Kauai, and Hawaii.
- 4. The Engineer may assess liquidated damages of up to \$27,500 for non-compliance of each BMP requirement and each requirement stated in Section 209, for every day of non-compliance. There is no maximum limit on the amount assessed per day.
- The Engineer will deduct the cost from the progress payment for all citations received by the Department for non-compliance, or the Contractor shall reimburse the State for the full amount of the outstanding cost incurred by the State.
- WASTE DISPOSAL:
- Waste Materials

Collect and store all waste materials in a securely lidded metal dumpster. The dumpster shall meet all local and State solid waste management regulations. Deposit all trash and construction debris from the site in the dumpster. Empty the dumpster a minimum of twice per week or as often as is deemed necessary. Do not bury construction waste materials onsite. The Contractor's supervisory personnel shall be instructed regarding the correct procedure for waste disposal. Post notices stating these practices in the office trailer and the Contractor shall be responsible for seeing that these procedures are followed.

Hazardous Waste

Dispose all hazardous waste materials in the manner specified by local or State regulations and by the manufacturer. The Contractor's site personnel shall be instructed in these practices and shall be responsible for seeing that these practices are followed.

Sanitary Waste

Survey Plotted By
Drawn By
Traced By
Designed By
Quantities By
Checked By

Collect all sanitary waste from the portable units a minimum of once per week, or as required.

- EROSION AND SEDIMENT CONTROL INSPECTION AND MAINTENANCE PRACTICES:
- Inspect all control measures at least once each week and within 24 hours of any rainfall event of 0.5 inches or greater within a 24 hour period.
- Maintain all measures in good working order. If repair is necessary, it shall be initiated within 24 hours after the inspection.
- Remove built-up sediment from silt fence when it has reached one-third the height of the fence.
- Inspect silt screen or fence for depth of sediment, tears, to verify that the fabric is securely attached to the fence posts or concrete slab, and to verify that the fence posts are firmly in the ground. Inspect and verify the bottom of the silt screen is buried a minimum of 6 inches below the existing
- Inspect temporary and permanent seeding and planting for bare spots, washouts, and healthy growth.
- Make a maintenance inspection report promptly after each inspection. Submit a copy to the Engineer no later than one week from the date of the inspection.

- Provide a stabilized construction entrance to reduce vehicle tracking of sediments. Include stabilized construction entrance in the Water Pollution, Dust, and Erosion Control submittals. Minimum length should be 50 feet. Minimum width should be 30 feet. Minimum depth should be 12 inches or as recommended by the soils engineer and underlain with geo-textile fabric. Clean the paved street adjacent to the site entrance daily or as required to remove any excess mud, cold planed materials, dirt, or rock tracked from the site. Cover dump trucks hauling material from the construction site with a tarpaulin.
- Include designated Concrete Washout Area(s) in the Water Pollution, Dust, and Erosion Control submittals.
- Submit the name of a specific individual designated responsible for inspections, maintenance and repair activities and filling out the inspection and maintenance report.
- Personnel selected for the inspection and maintenance responsibilities shall receive training from the Contractor. They shall be trained in all the inspection and maintenance practices necessary for keeping the erosion and sediment controls used onsite in good working order.
- 11. Contain, remove, and dispose slurry generated from saw cutting of pavement in accordance with approved BMP practices. Payment for confinement, removal, and disposal of slurry shall be considered incidental to the various contract items.
- GOOD HOUSEKEEPING BEST MANAGEMENT PRACTICES:
- Materials Pollution Prevention Plan
- a. Applicable materials or substances listed below are expected to be present onsite during construction. Other materials and substances not listed below shall be added to the inventory.

Concrete Detergents Fertilizers

Petroleum Based Products Cleaning Solvents

Paints (enamel and latex) Metal Studs

Wood

Masonry Block

- Use Material Management Practices to reduce the risk of spills or other accidental exposure of materials and substances to storm water runoff. Make an effort to store only enough product as is required to do the job.
- c. Store all materials stored onsite in a neat, orderly manner in their appropriate containers and if possible under a roof or other enclosure.
- d. Keep products in their original containers with the original manufacturer's label.
- e. Do not mix substances with one another unless recommended by the manufacturer.
- Whenever possible, use a product up completely before disposing of the container.
- Follow manufacturer's recommendations for proper use and disposal.
- Conduct a daily inspection to ensure proper use and disposal of materials onsite.
- Hazardous Material Pollution Prevention Plan:
  - Keep products in original containers unless they are not resealable.
  - Retain original labels and material safety data sheets (MSDS).
- Dispose of surplus products according to manufacturer's instructions and local and State regulations.

3. Onsite and Offsite Product Specific Plan

The following product specific practices shall be followed onsite:

a. Petroleum Based Products:

Monitor all onsite vehicles for leaks and perform regular preventive maintenance to reduce the chance of leakage. Store petroleum products in tightly sealed containers which are clearly labeled. Apply asphalt substances used onsite according to the manufacturer's recommendation.

FED. ROAD STATE

HAW.

FISCAL SHEET YEAR NO.

2012

FED. AID PROJ. NO.

ER-16(009)

Fertilizers:

Apply fertilizers used only in the minimum amounts recommended by the manufacturer. Once applied, work fertilizer into the soil to limit exposure to storm water. Storage shall be in a covered shed. Transfer the contents of any partially used bags of fertilizer to a sealable plastic bin to avoid spills.

c. Paints:

Seal and store all containers when not required for use. Do not discharge excess paint to the highway drainage system. Dispose properly according to manufacturer's instructions or State and local regulations.


d. Concrete Trucks:

Wash out or discharge concrete truck drum wash water only at a designated site. Do not discharge water in the highway drainage system or waters of the United States. Contact Drinking Water Branch, Department of Health at 586-4258 to receive permission to designate a disposal site. Clean disposal site as required or as requested by the Owner's representative.

Spill Control Plan

- a. Post a spill prevention plan to include measures to prevent and clean up each spill.
- b. The Contractor shall be the spill prevention and cleanup coordinator. Designate at least three site personnel who shall receive spill prevention and cleanup training. These individuals shall each become responsible for a particular phase of prevention and cleanup. Post the names of responsible spill personnel in the material storage area and in the office trailer onsite.
- c. Clearly post manufacturers' recommended methods for spill cleanup. Make site personnel aware of the procedures and the location of the information and cleanup supplies.
- Keep materials and equipment necessary for spill cleanup in the material storage area onsite.
- Clean up all spills immediately after discovery.
- Keep the spill area well ventilated. Personnel shall wear appropriate protective clothing to prevent injury from contact with a hazardous substance.
- Report spills of toxic hazardous material to the appropriate State or local government agency, regardless of the size.

## AECOM

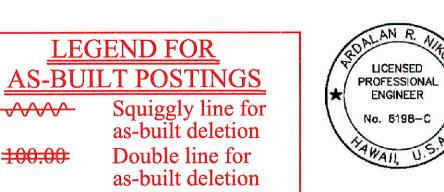

EXPIRATION DATE OF THE LICENSE 4/30/2014 THIS WORK WAS PREPARED BY ME OR UNDER MY SUPERVISION

STATE OF HAWAII DEPARTMENT OF TRANSPORTATION HIGHWAYS DIVISION

WATER POLLUTION AND EROSION CONTROL NOTES HANA HIGHWAY EMERGENCY REPAIRS MILEPOST 14.0

FEDERAL-AID PROJECT NO. ER-16(009) Date: July 10, 2012 Scale: As Noted

SHEET No. 11 OF 13 SHEETS

"AS-BUILT"

Roadway Text for as-built

posting