

STATE OF HAWAII

DEPARTMENT OF TRANSPORTATION

HIGHWAYS DIVISION

HONOLULU, HAWAII

"AS-BUILT"

PLANS FOR



PAVEMENT MARKING AND STRIPING

AT VARIOUS LOCATIONS, MAUI

PROJECT NO. HWY-M-04-97M

DISTRICTS OF LAHAINA AND WAILUKU

ISLAND OF MAUI

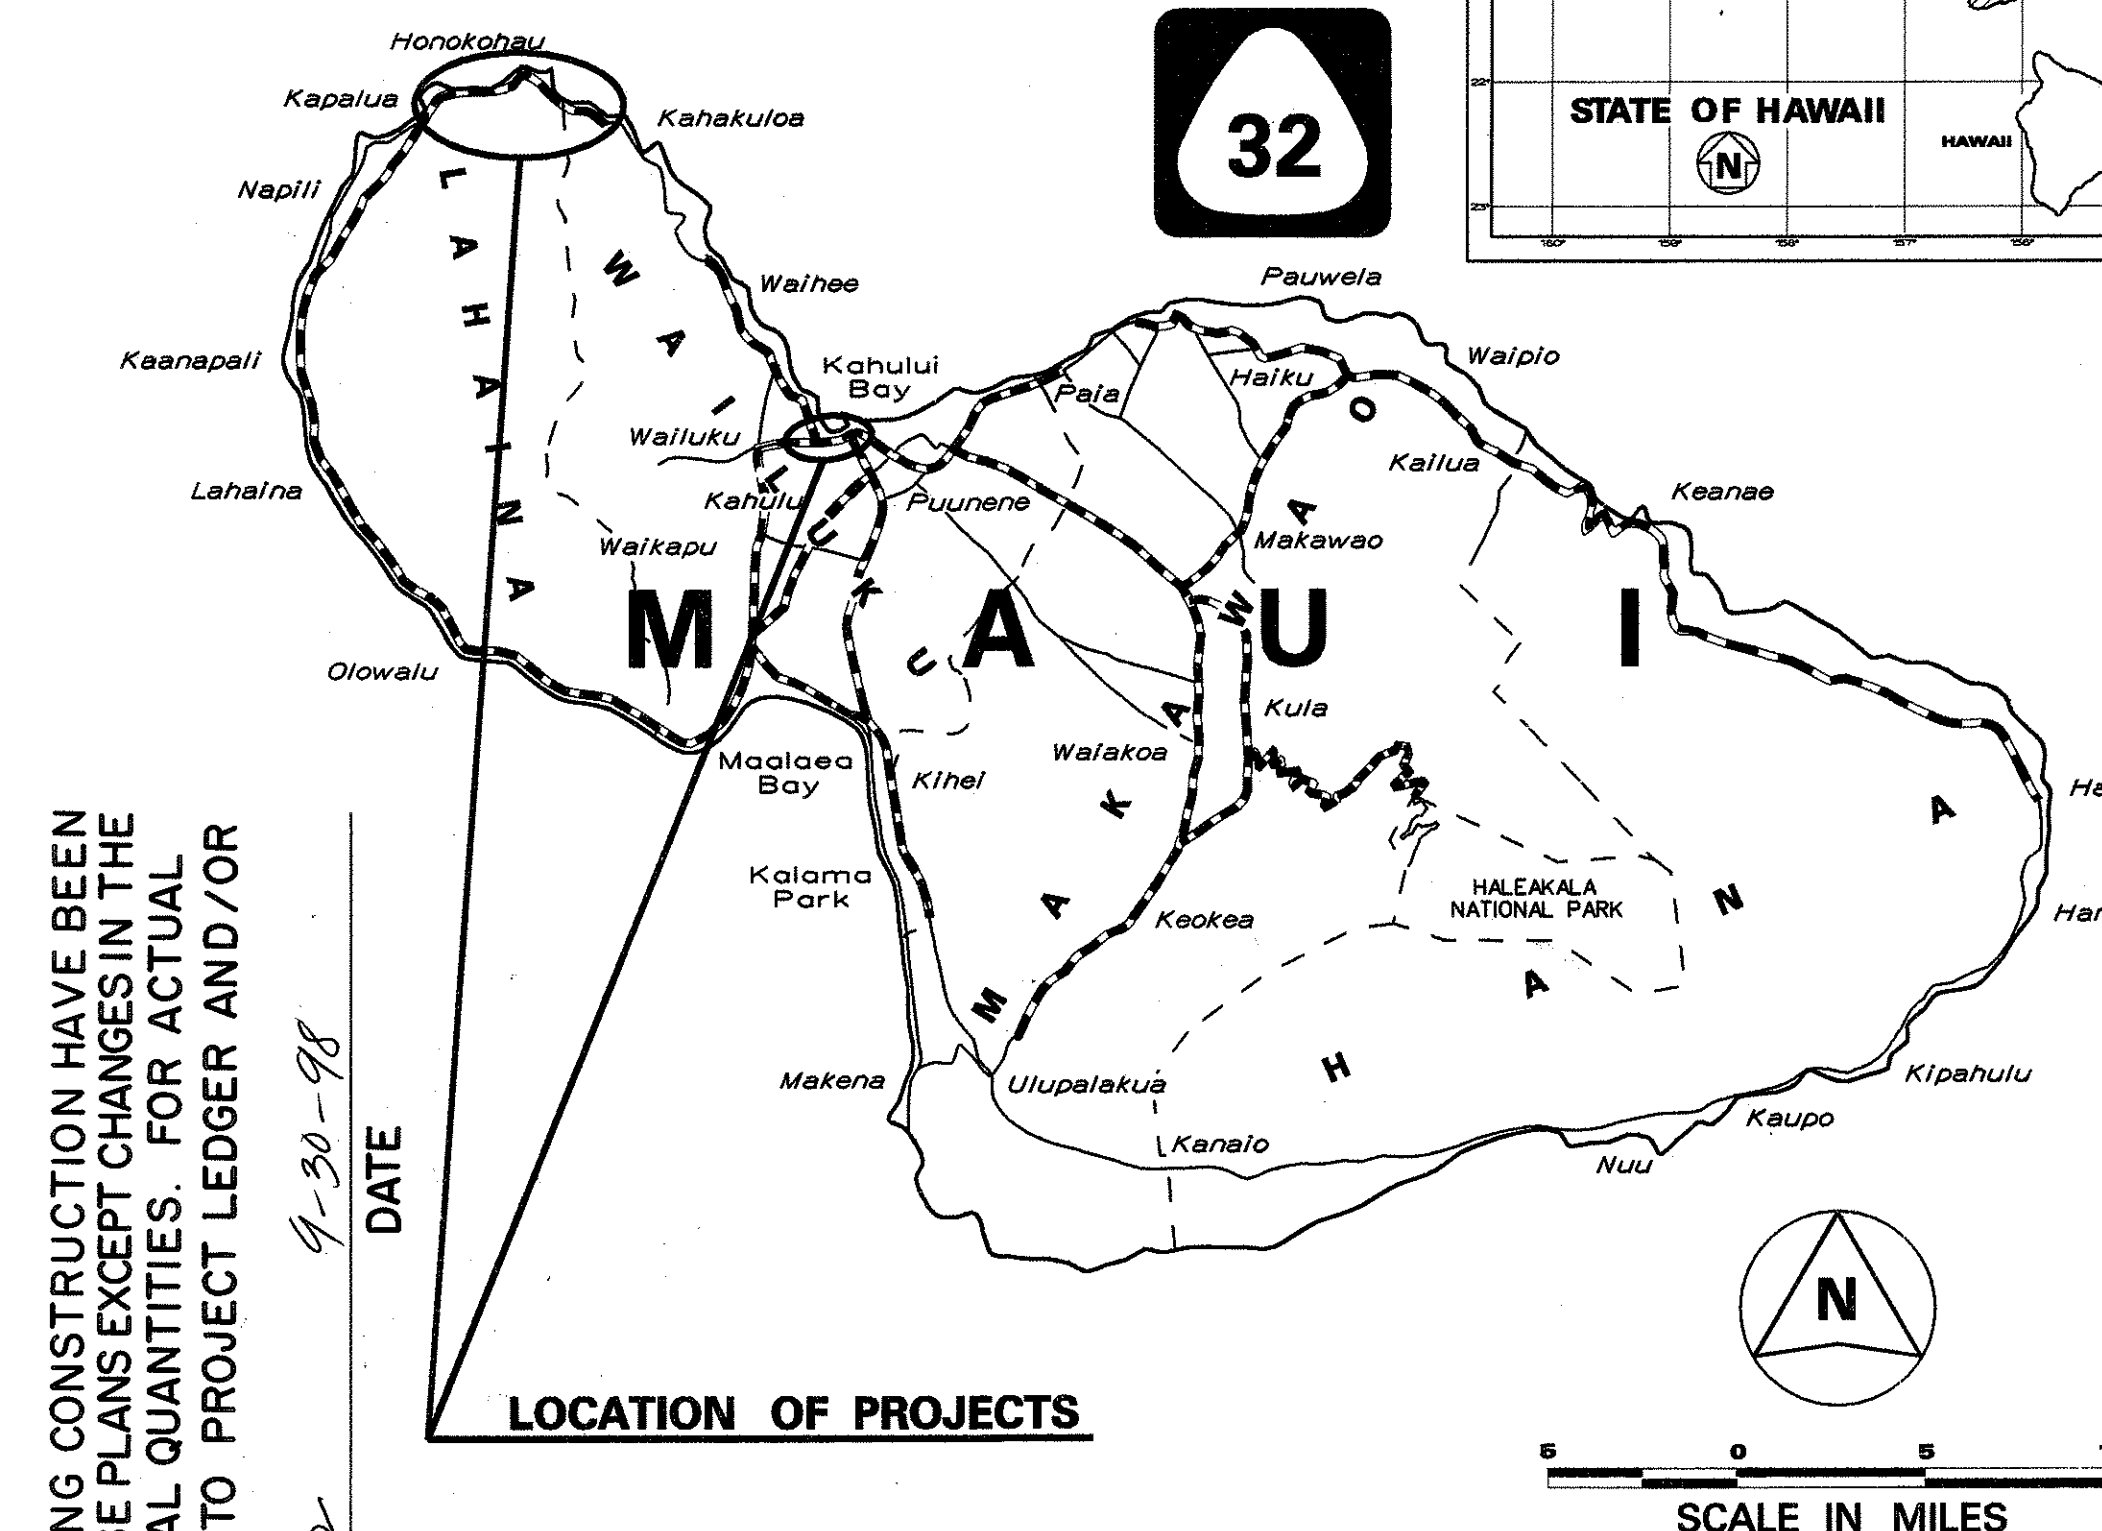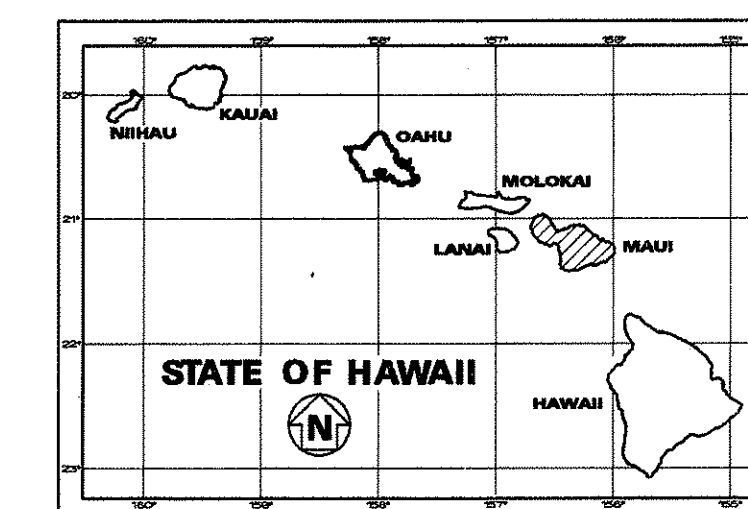



CHANGES MADE DURING CONSTRUCTION HAVE BEEN INCORPORATED ON THESE PLANS EXCEPT CHANGES IN THE ORIGINAL THEORETICAL QUANTITIES. FOR ACTUAL QUANTITIES, REFER TO PROJECT LEDGER AND/OR COMPILATION BOOK

COMPUTATION BOOK. *Doyle D. Law* 4-30-98
RESIDENT ENGINEER DATE

 FEDERAL AID PROJECTS PREVIOUSLY CONSTRUCTED
OR UNDER CONSTRUCTION

WORK AREA **1**: MILE POST 0.62 TO MILE POST 2.84

WORK AREA 2: MILE POST 31.19 TO MILE POST 41.67

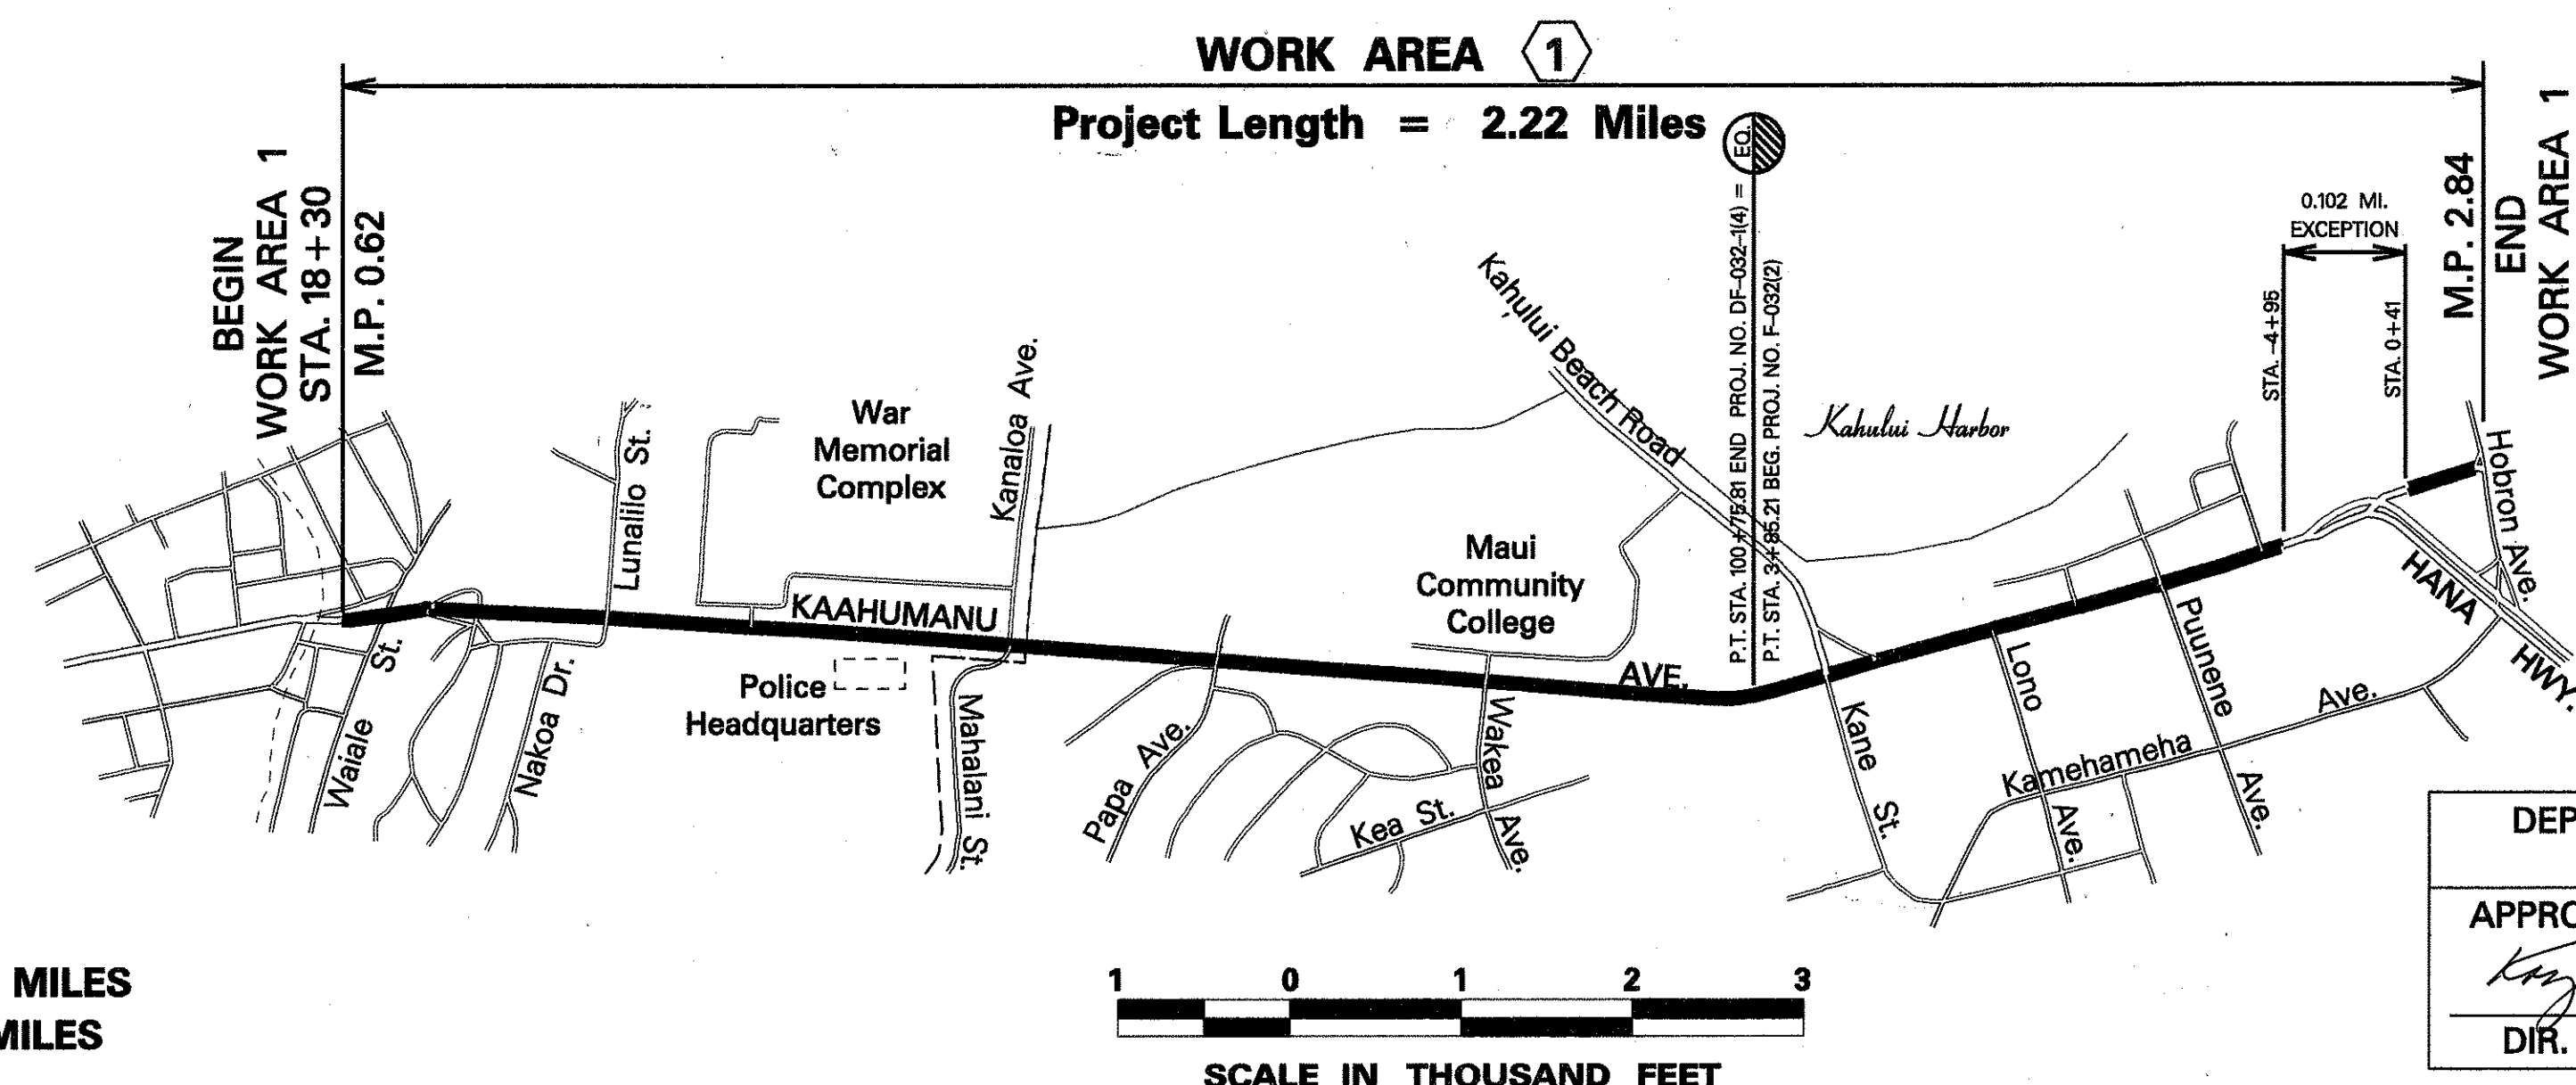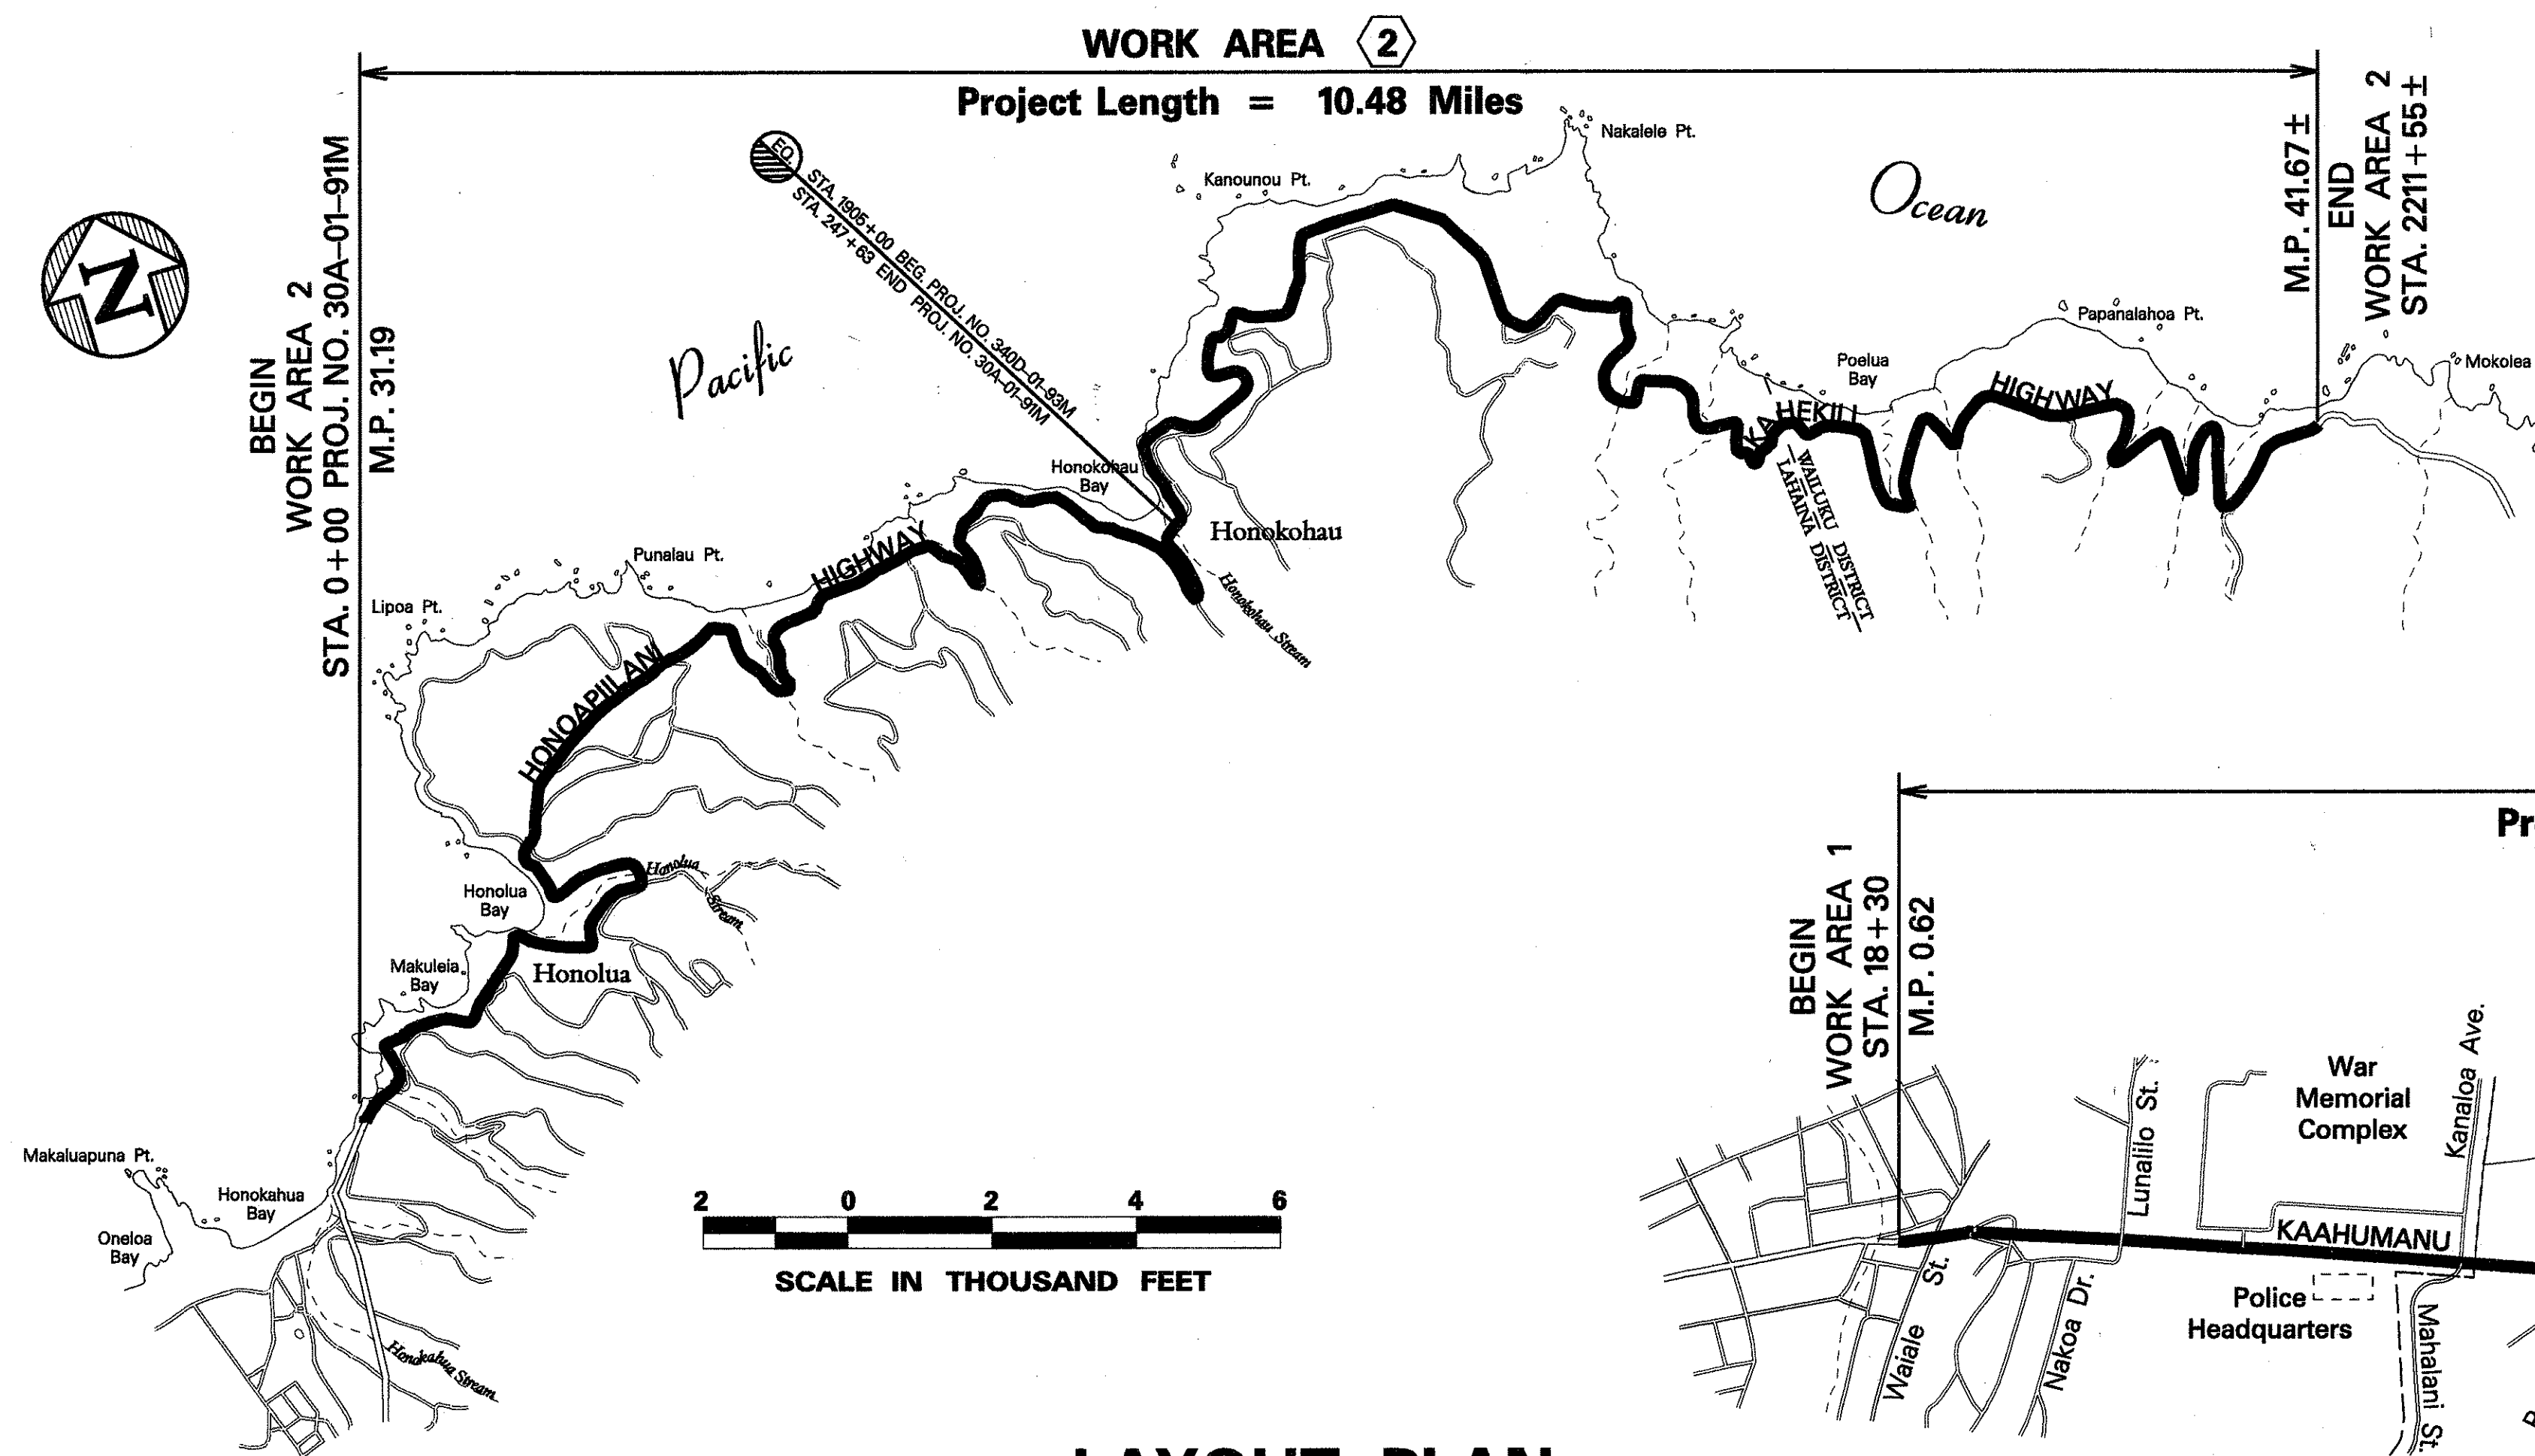

DEPARTMENT OF TRANSPORTATION
STATE OF HAWAII

APPROVED: *Kayn Uyachika* 4/10/19

DIR. OF TRANSPORTATION DATE