

FED. ROAD DIST. NO.	STATE	PROJ. NO.	FISCAL YEAR	SHEET NO.	TOTAL SHEETS
HAWAII	HAW.	HWY-M-06-98	2000	#	14






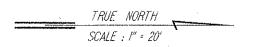

- 7 Riser up pole per MECo requirements. See B/E-12 for Typical Pole Riser Detail.
- 2 Sawcut existing asphalt pavement as required to install ductline. Repair to match existing condition.

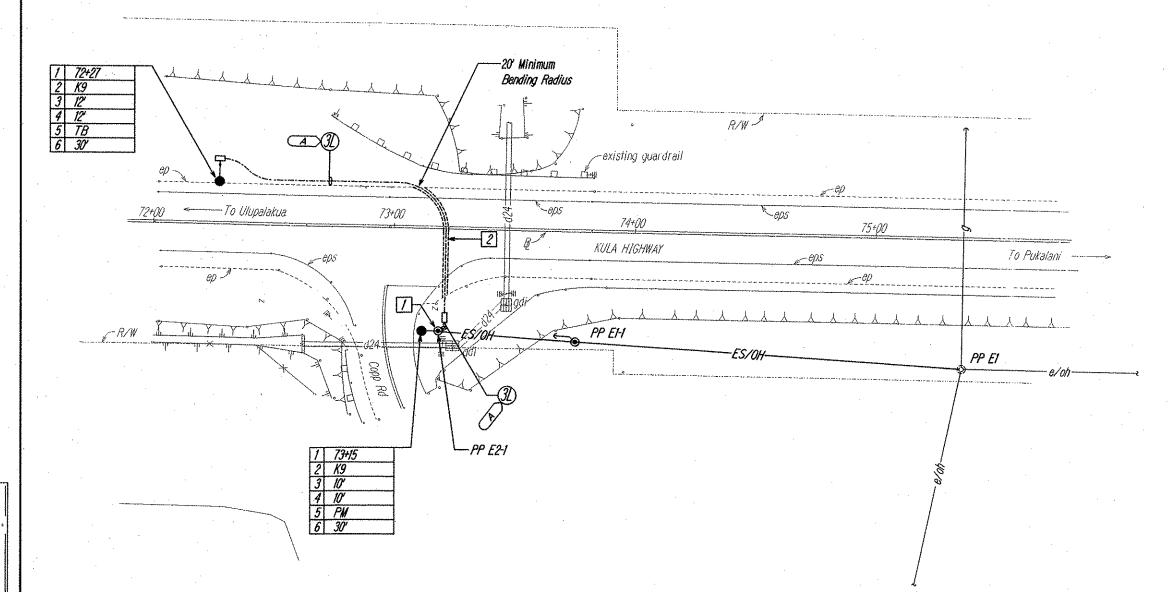

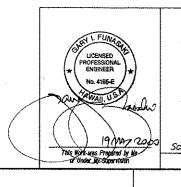

STATE OF HAWAII
DEPARTMENT OF TRANSPORTATION
HIGHWAYS DIVISION

<u>KULA HWY @ COPP RD</u> <u>LIGHTING PLAN</u>

<u>Street Lights at</u> <u>Various Highway Locations, Maui</u> <u>Project No. HWY-M-06-98</u>

Dete: APRIL, 2000

SHEET No. E4 OF 12 SHEETS