

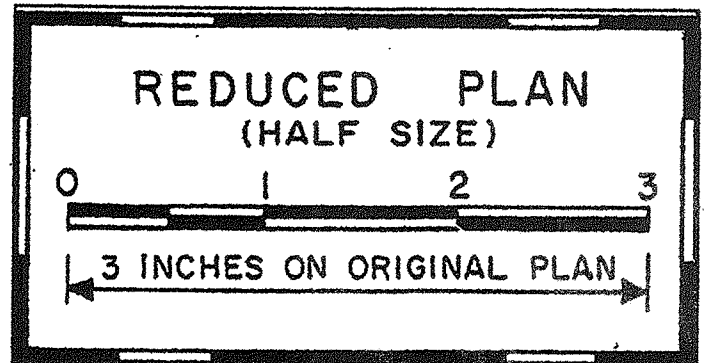
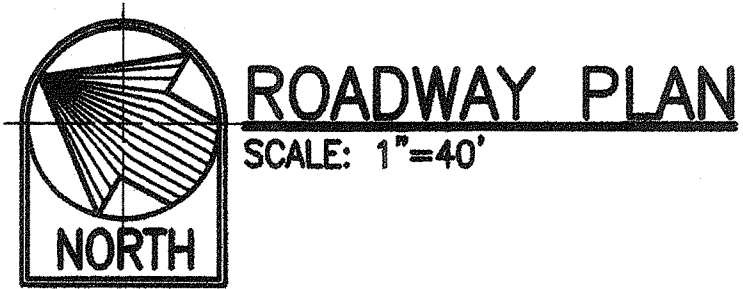


FED. ROAD DIST. NO.	STATE	PROJ. NO.	FISCAL YEAR	SHEET NO.	TOTAL SHEETS
HAWAII	HAW.	HWY-M-04-00	2002	37	63

1	BL CURVE DATA	2	BL CURVE DATA
Δ	11°59'40"	Δ	23°00'20"
$\Delta/2$		$\Delta/2$	
R=	5,729.58'	R=	2,546.48'
T=	601.92'	T=	518.22'
Ch=	1,197.26'	Ch=	1,1015.61'
Lc=	1,199.44'	Lc=	1,022.47'
SE=	0.02 ft/ft	SE=	0.02 ft/ft

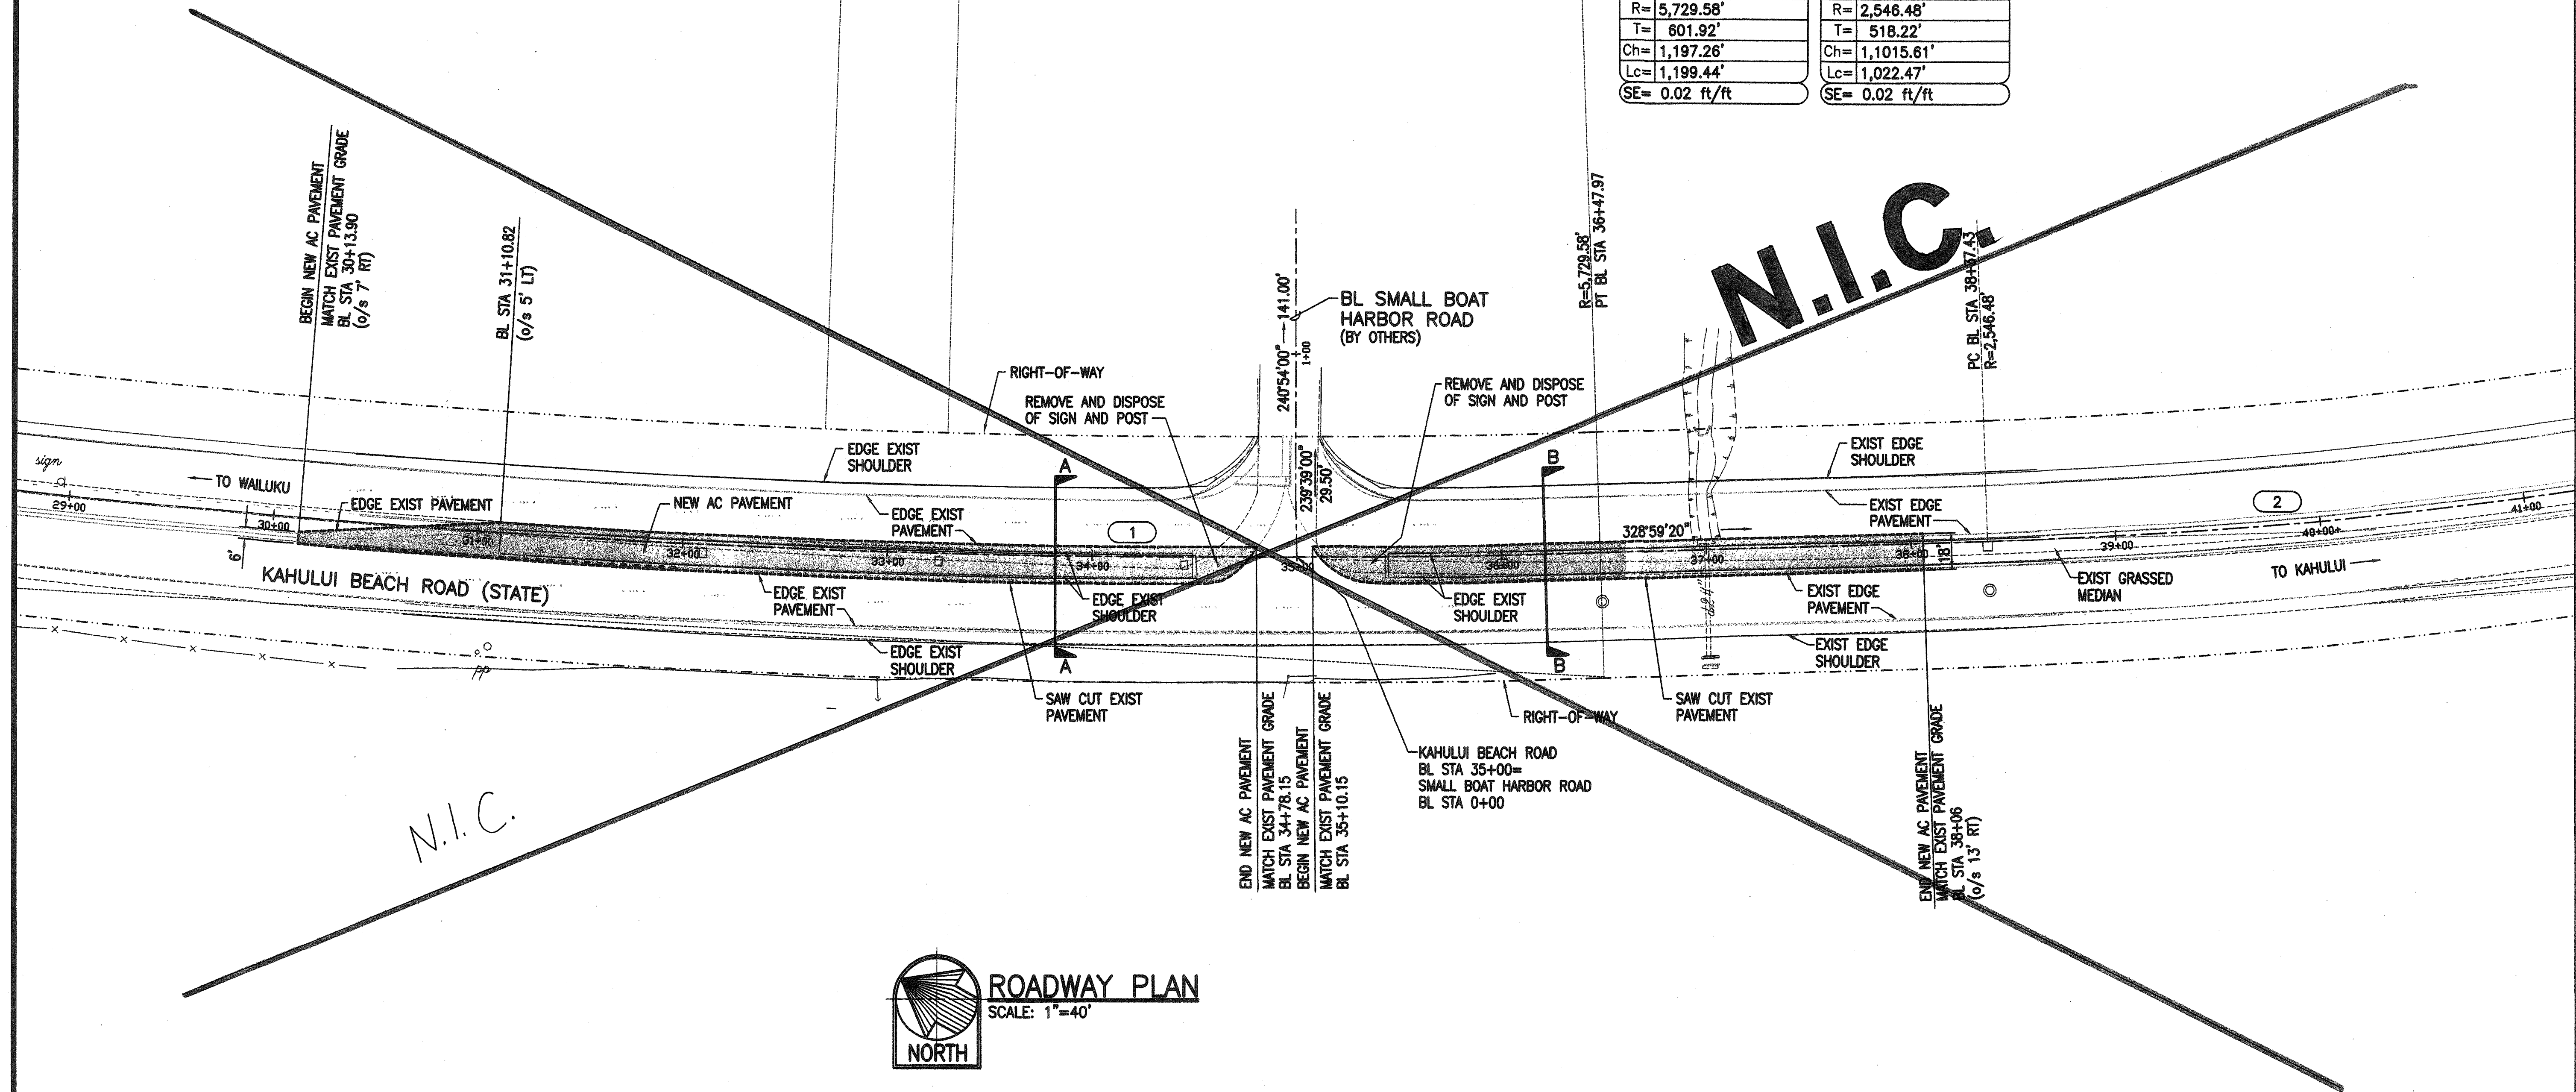

ORIGINAL PLAN	SURVEY PLOTTED BY	DATE
DESIGNED BY	DESIGNED BY	
CHECKED BY	CHECKED BY	
No.		

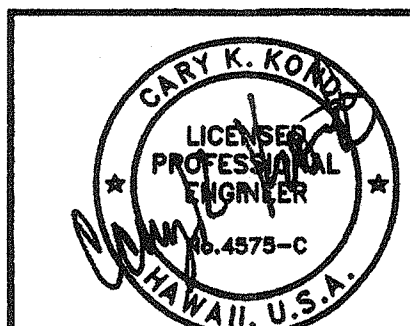

STATE OF HAWAII
DEPARTMENT OF TRANSPORTATION
HIGHWAYS DIVISION

ROADWAY PLAN

TRAFFIC OPERATIONAL IMPROVEMENTS
AT VARIOUS LOCATIONS
KAHULUI BEACH ROAD
AT SMALL BOAT HARBOR ROAD

Project No. HWY-M-04-00




Scale: AS NOTED Date: Apr. 2002

SHEET No. 1 OF 2 SHEETS




"AS BUILT"

FED. ROAD DIST. NO.	STATE	PROJ. NO.	FISCAL YEAR	SHEET NO.	TOTAL SHEETS
HAWAII	HAW.	HWY-M-04-00	2002	38	63

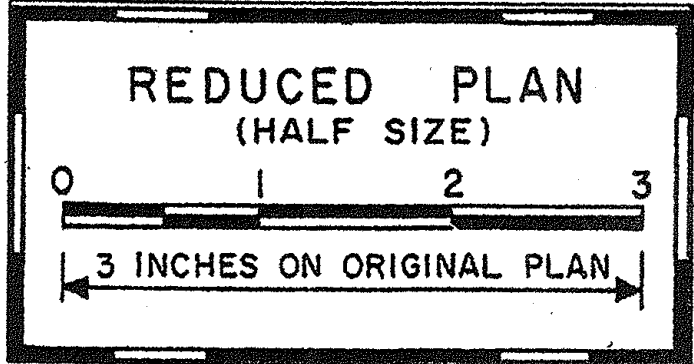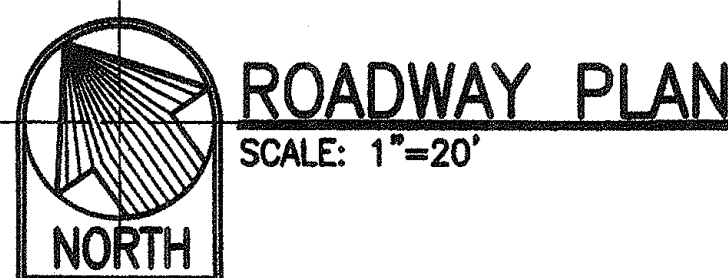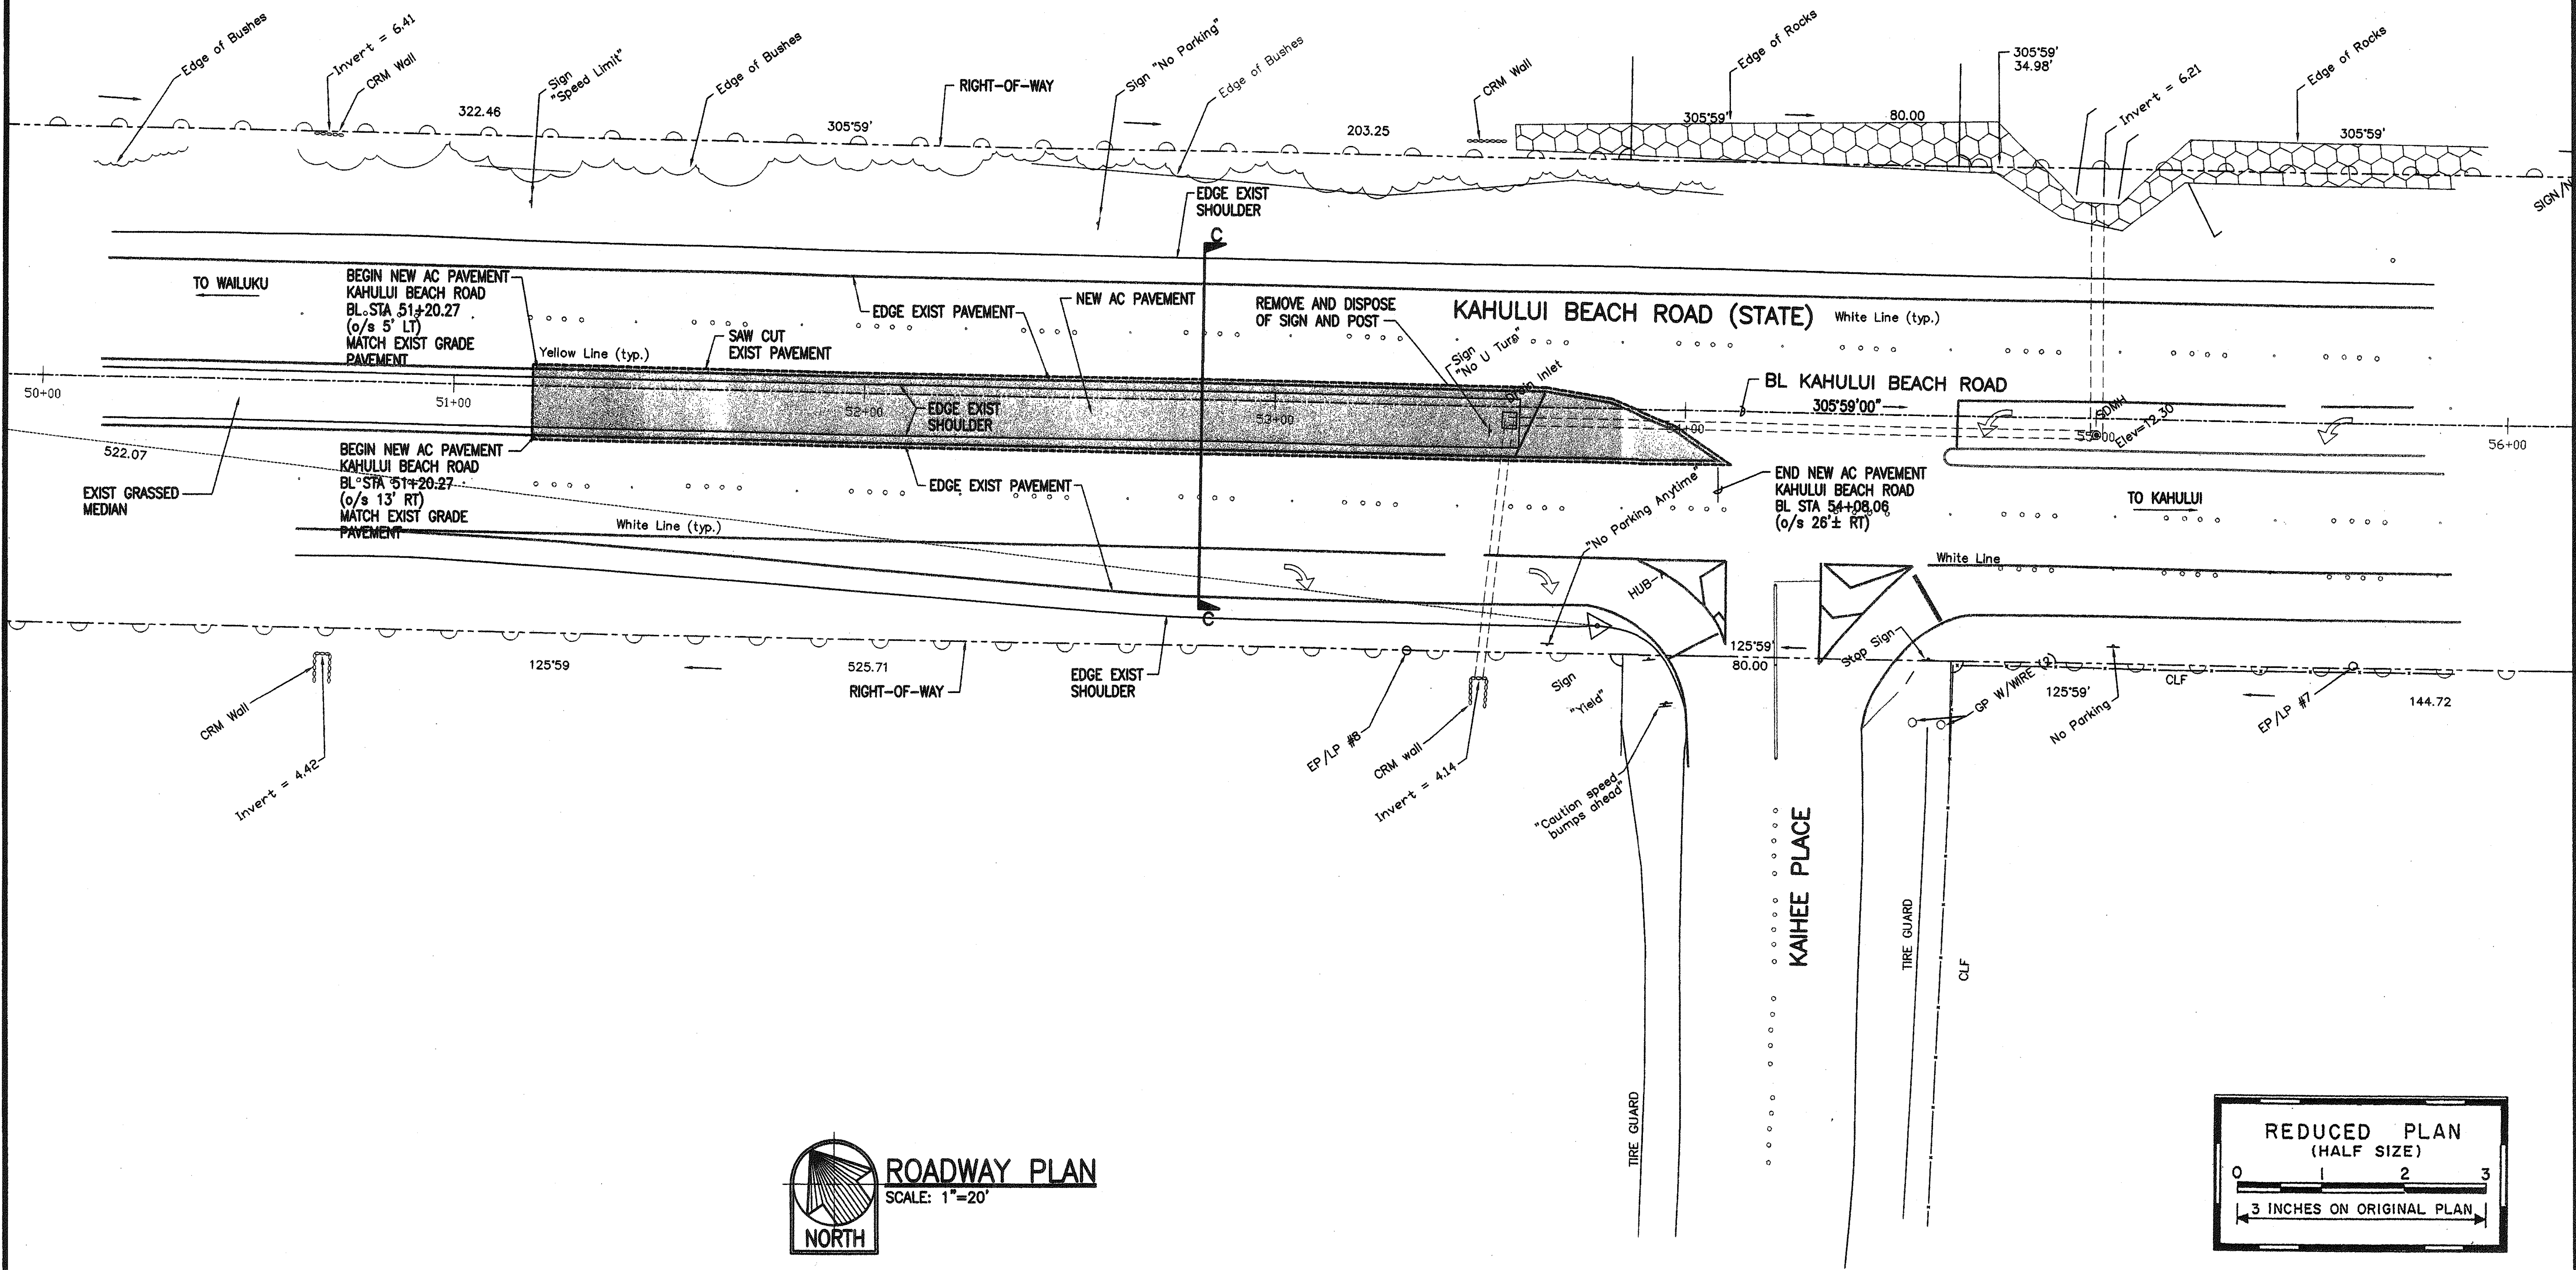

DATE	_____
SURVEY PLOTTED BY	_____
DRAWN BY	_____
DESIGNED BY	_____
QUANTITIES BY	_____
CHECKED BY	_____
NOTE BOOK	_____
No.	_____

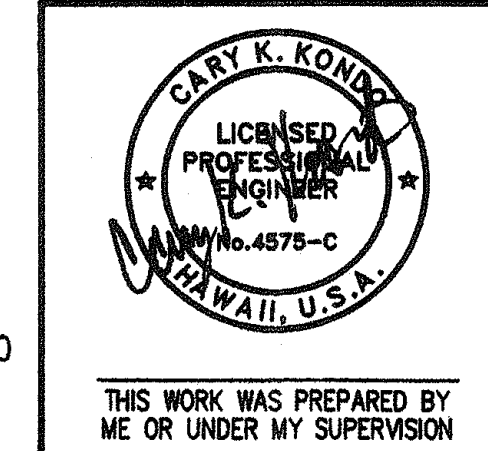

STATE OF HAWAII
DEPARTMENT OF TRANSPORTATION
HIGHWAYS DIVISION

ROADWAY PLAN

TRAFFIC OPERATIONAL IMPROVEMENTS
AT VARIOUS LOCATIONS
KAHULUI BEACH ROAD
AT KAIHEE PLACE

Project No. HWY-M-04-00

Scale: AS NOTED Date: Apr. 2002

SHEET No. 2 OF 2 SHEETS

