


INDEX TO DRAWINGS	
SHEET NO.	DESCRIPTION
32	TITLE SHEET
33	STANDARD PLANS SUMMARY
34	CONSTRUCTION NOTES
35	WATER POLLUTION & EROSION CONTROL NOTES
36	TYPICAL SECTIONS & DETAILS
37-38	ROADWAY PLAN KAHULUI BEACH ROAD
39-40	GRADING PLAN KAHULUI BEACH ROAD
41-42	SIGNING & STRIPING PLAN KAHULUI BEACH ROAD
43-44	TRAFFIC CONTROL PLAN KAHULUI BEACH ROAD
45-47	DRAINAGE DETAILS

STATE OF HAWAII
DEPARTMENT OF TRANSPORTATION
HIGHWAYS DIVISION
HONOLULU, HAWAII

FED. ROAD DIST. NO.	STATE	PROJ. NO.	FISCAL YEAR	SHEET NO.	TOTAL SHEETS
HAWAII	HAW.	HWY-M-04-00	2002	32	63



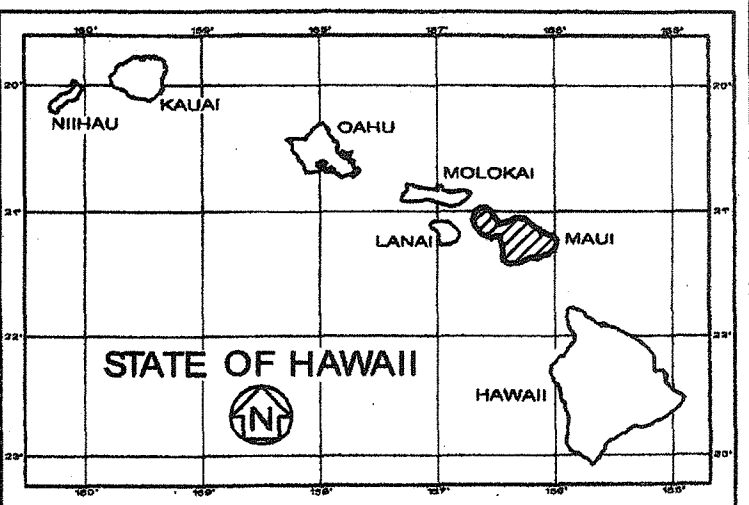


"AS-BUILT"
PLANS FOR:
**TRAFFIC OPERATIONAL IMPROVEMENTS
AT VARIOUS LOCATIONS**

KAHULUI BEACH ROAD
AT SMALL BOAT HARBOR ROAD AND KAIHEE PLACE

PROJECT NO. HWY-M-04-00



DISTRICT OF WAILUKU
ISLAND OF MAUI

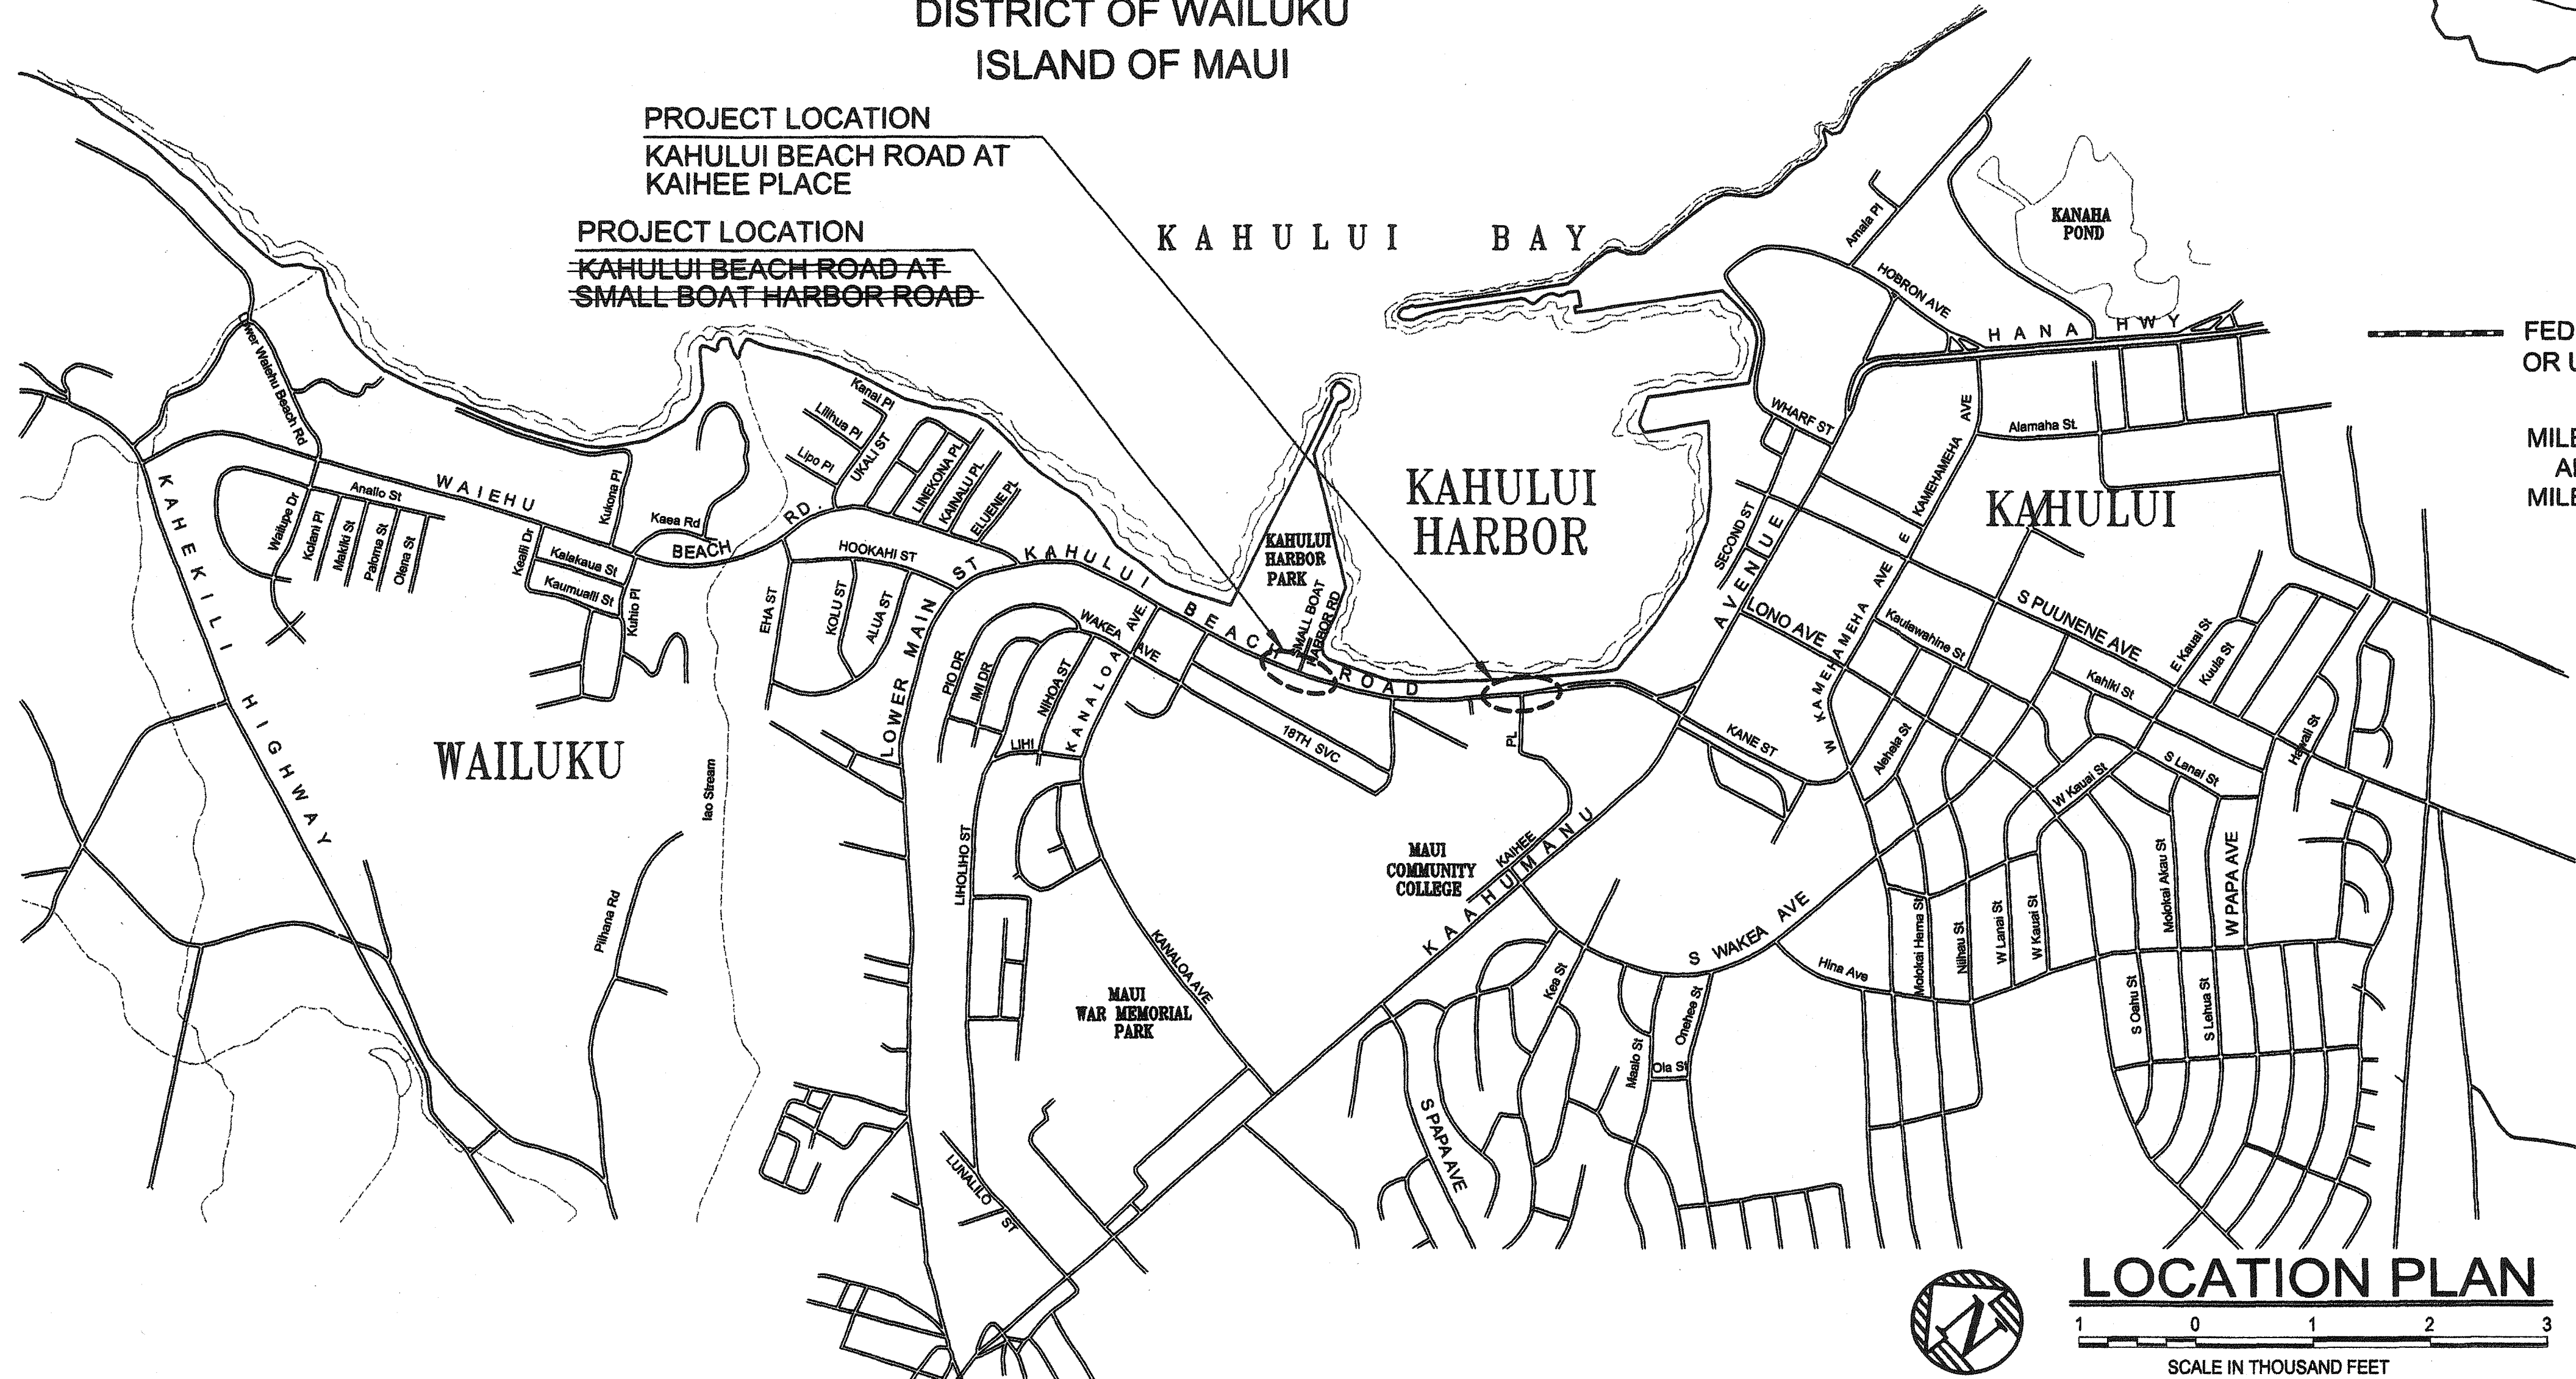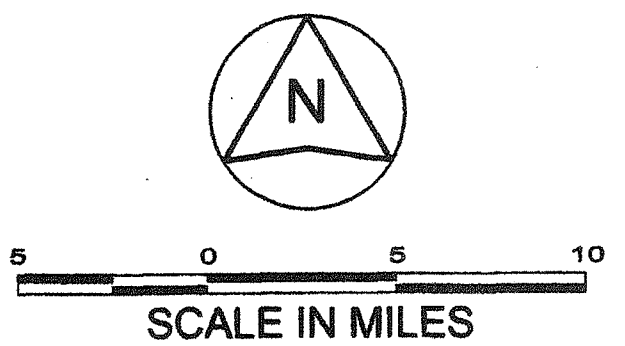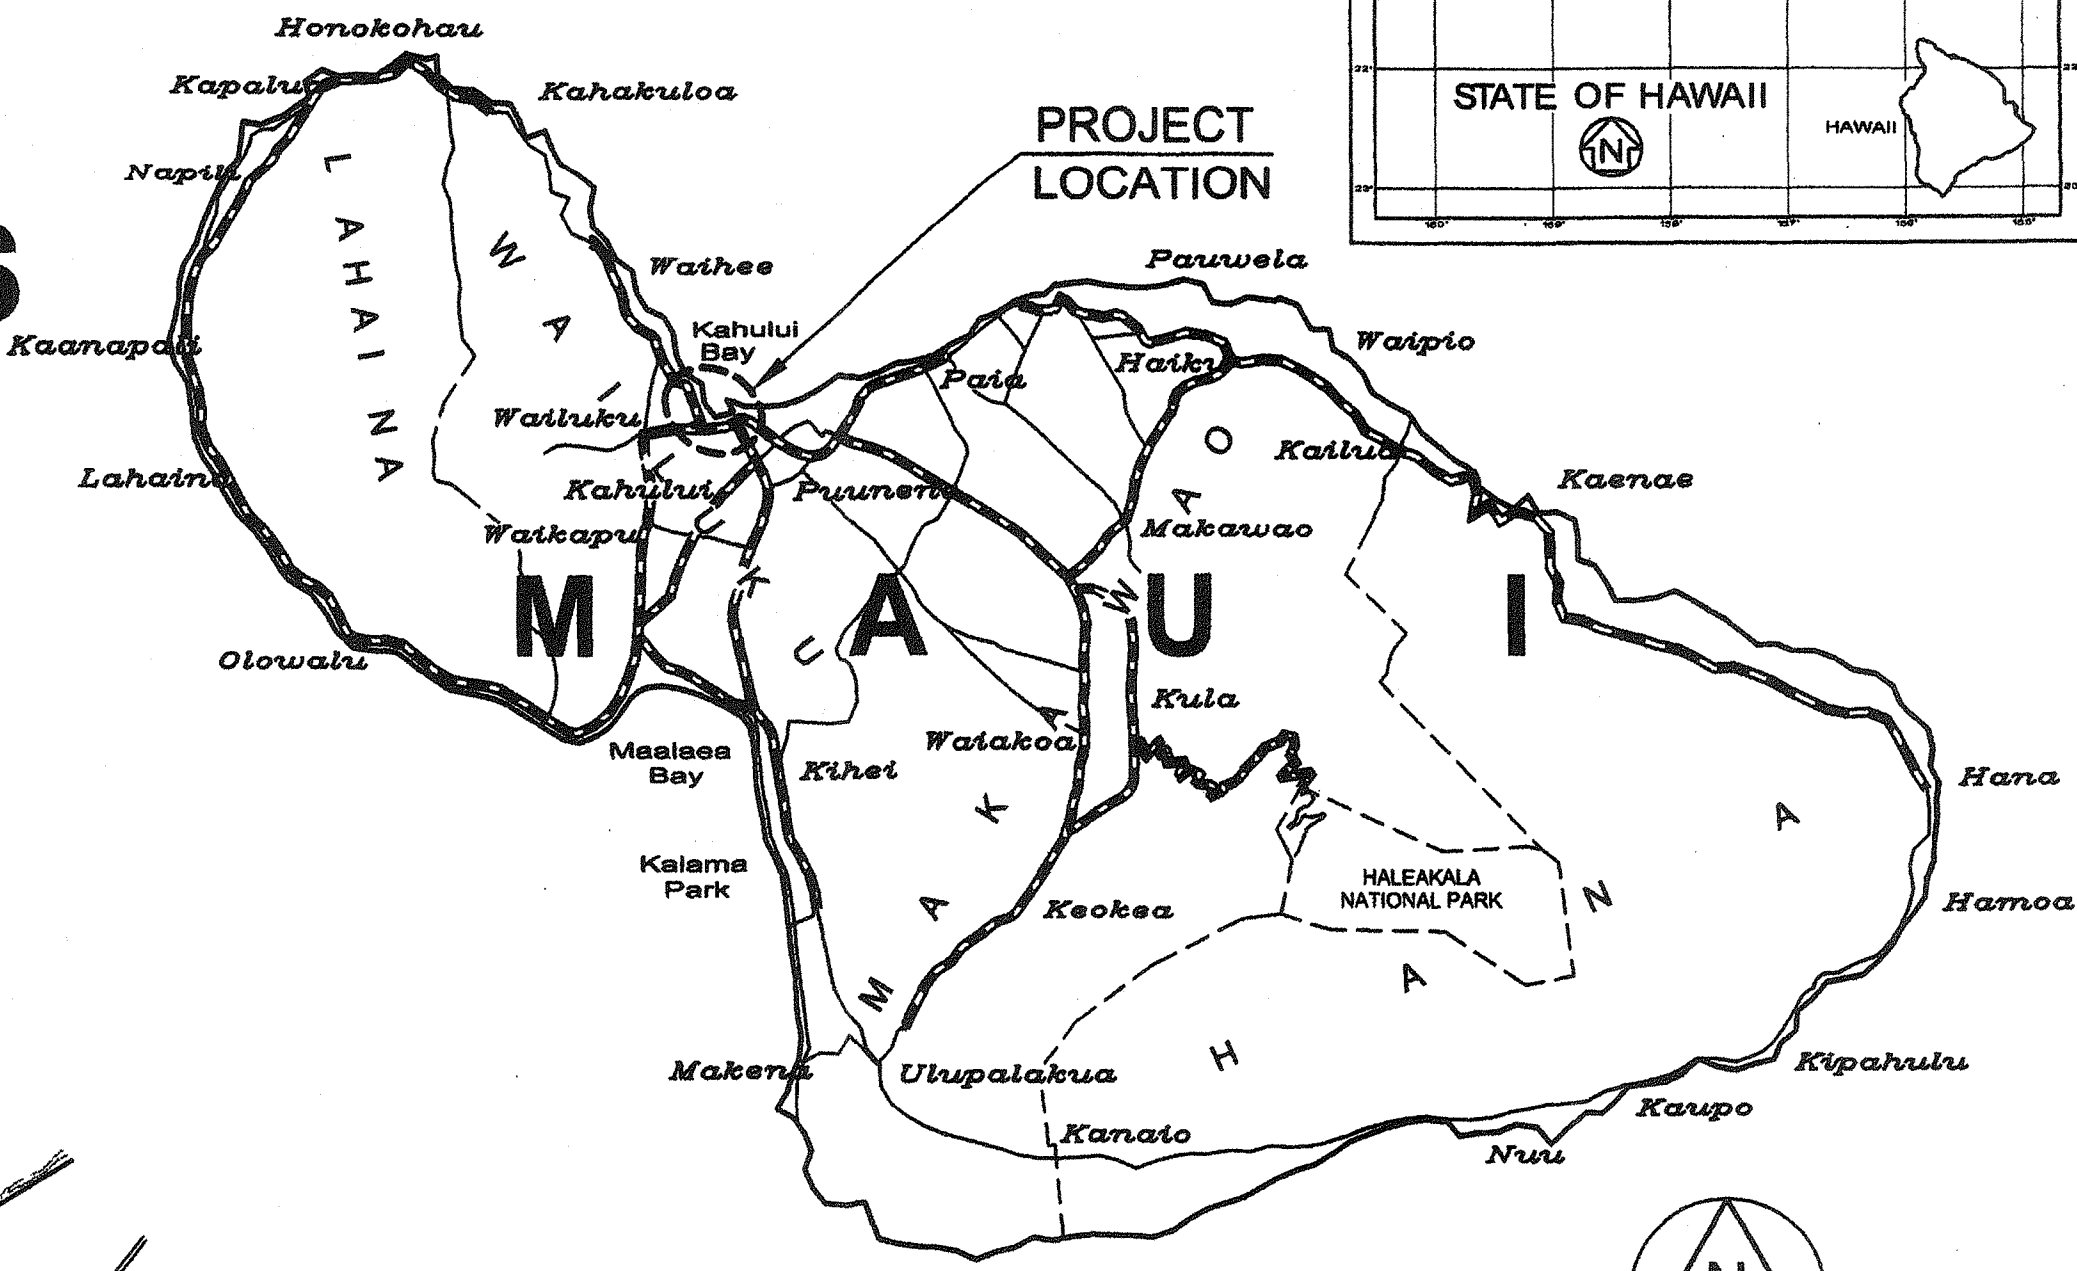

FEDERAL AID PROJECTS PREVIOUSLY CONSTRUCTED OR UNDER CONSTRUCTION

MILE POST 0.18 TO MILE POST 0.33
AND
MILE POST 0.57 TO MILE POST 0.65

LOCATION PLAN

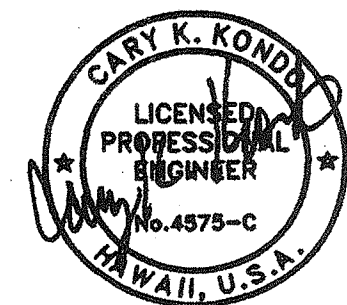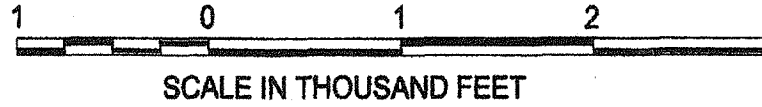

THIS WORK WAS PREPARED BY ME OR UNDER MY SUPERVISION

BELT COLLINS HAWAII LTD. DESIGNED BY
KARL KUNISHIGE
692-7679
APR 2002
DATE

"AS BUILT"