



FED. ROAD DIST. NO.	STATE	PROJ. NO.	FISCAL YEAR	SHEET NO.	TOTAL SHEETS
HAWAII	HAW.	HWY-M-04-00	2002	43	63

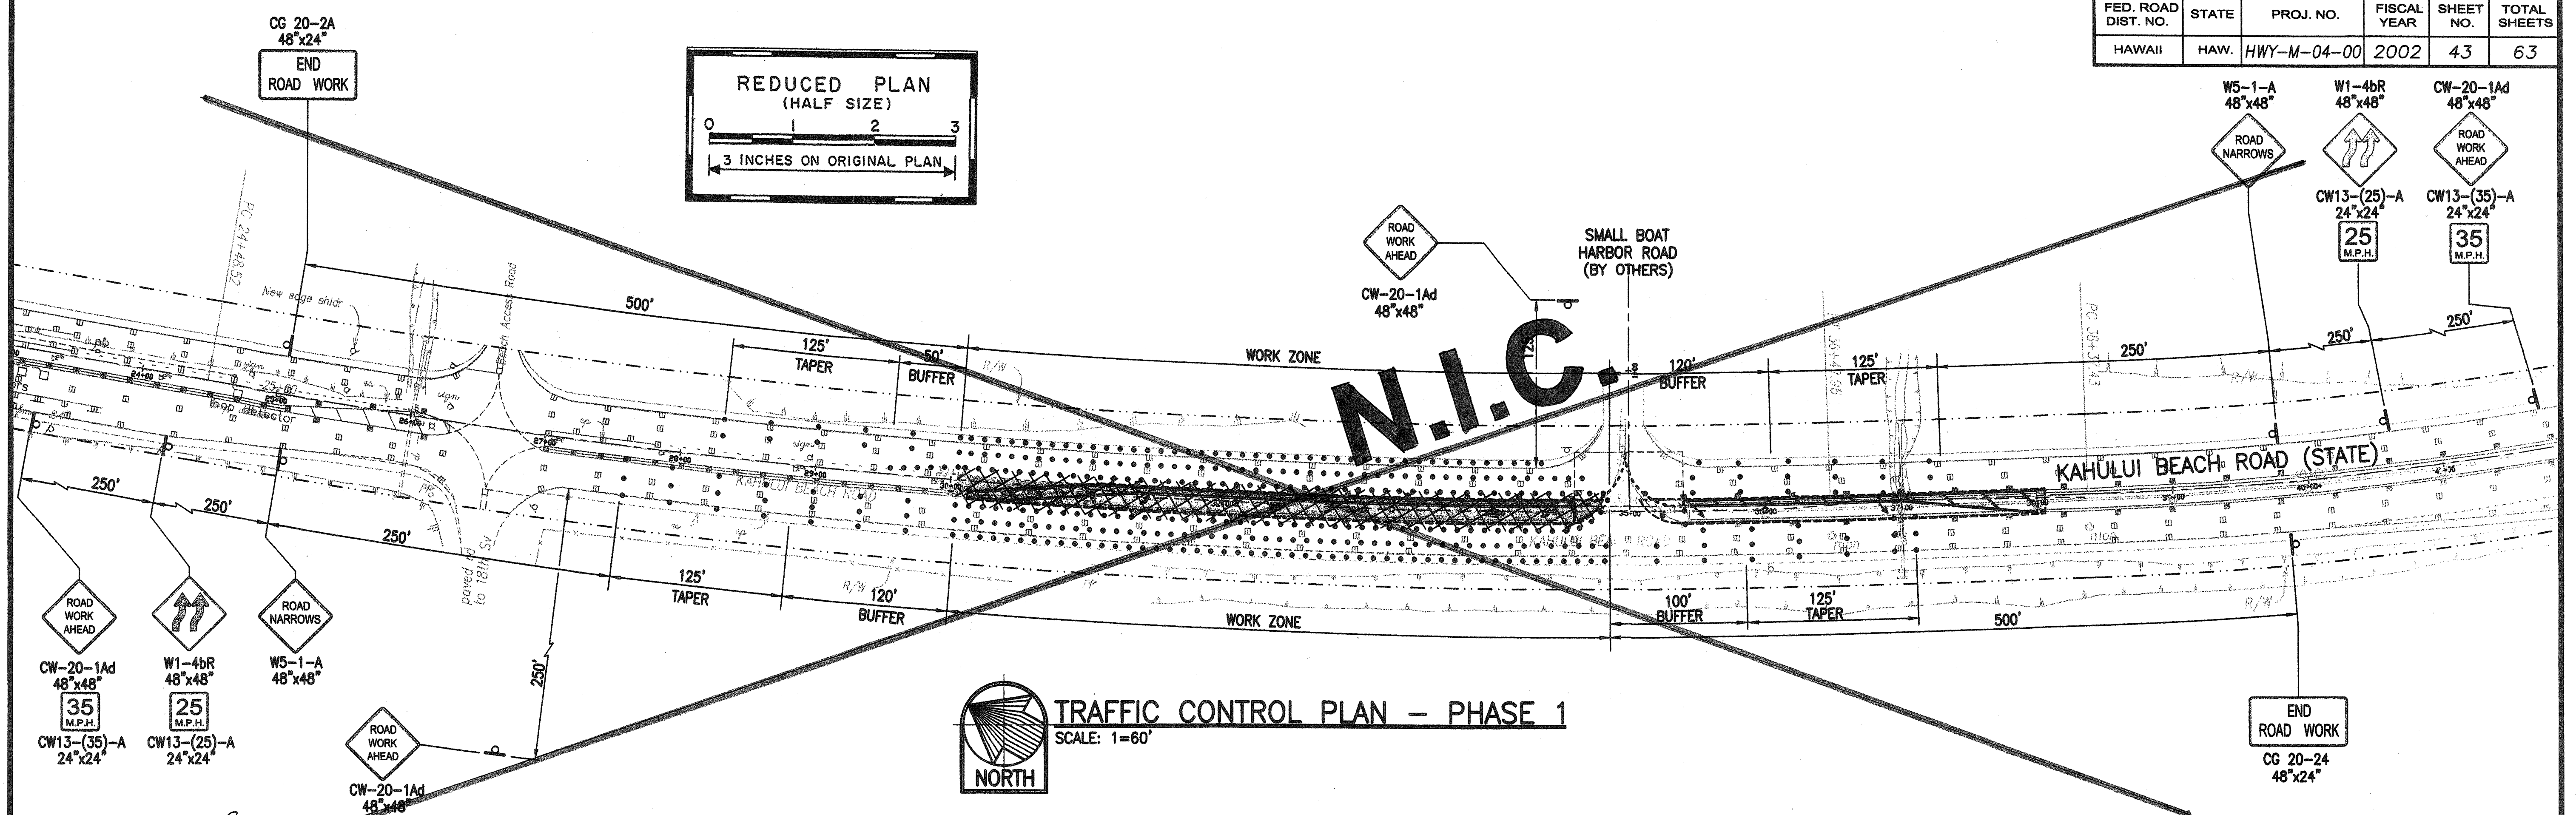


TRAFFIC CONTROL PLAN - PHASE 1
SCALE: 1=60'

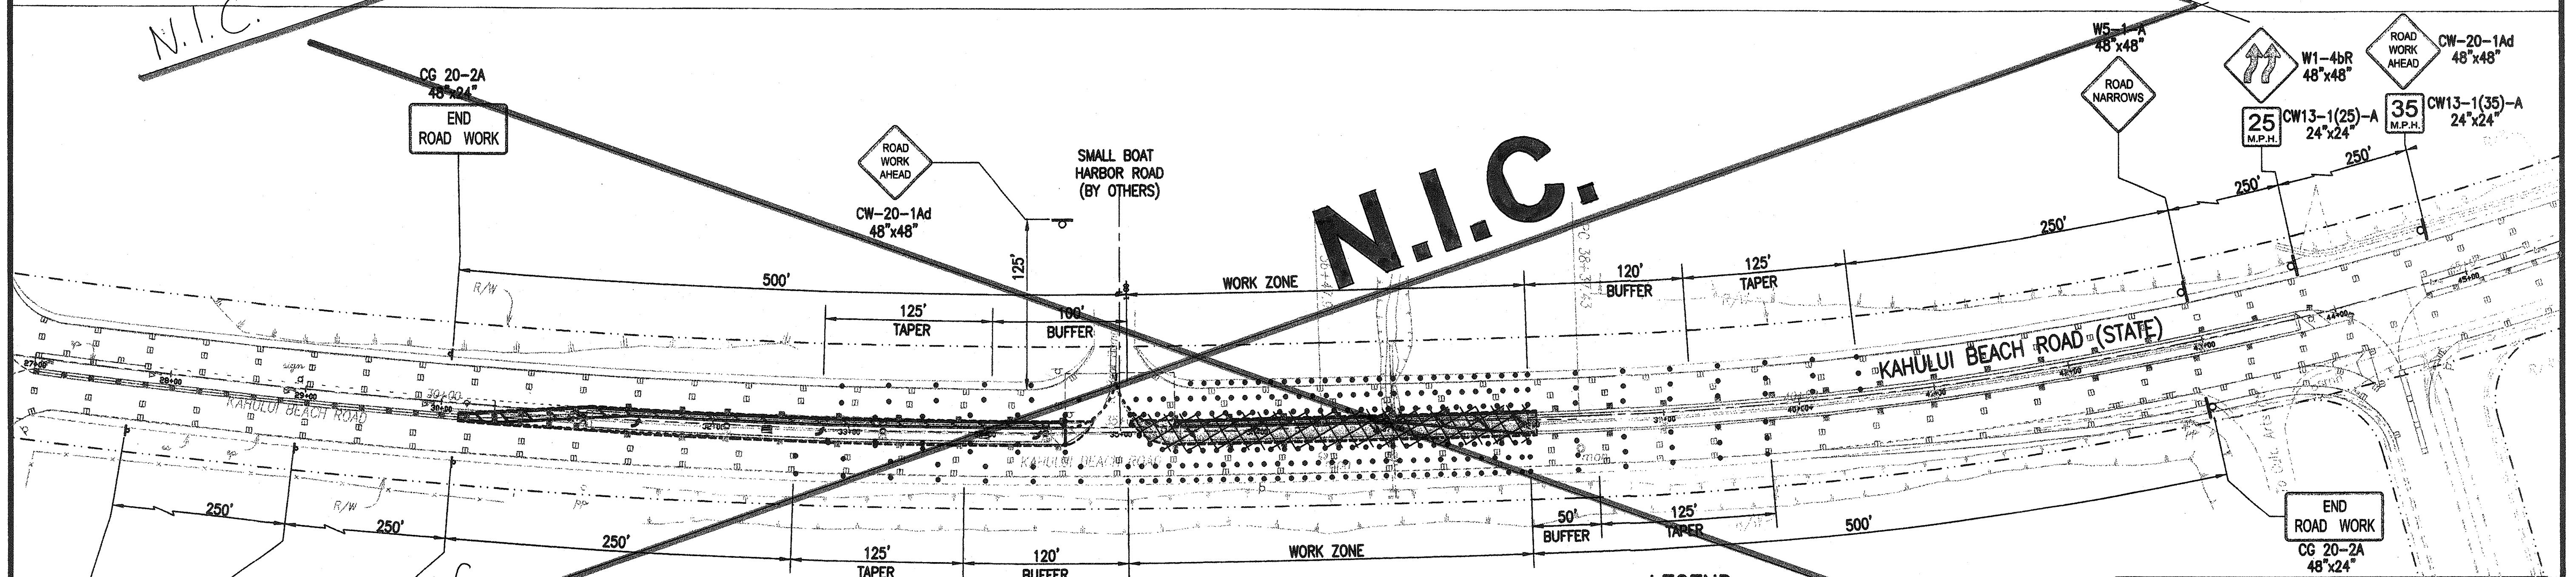

TRAFFIC CONTROL PLAN - PHASE 2
SCALE: 1=60'

NOTE:
DURING NON WORKING HOURS, TYPE II BARRICADE WITH STEADY BURN LIGHTS SHALL BE INSTALLED ALONG EDGE OF EXISTING PAVEMENTS EXPOSED BY ADJACENT EXCAVATION FOR NEW PAVEMENTS. BARRICADES SHALL BE INSTALLED WITH SANDBAGS TO PREVENT MOVEMENTS DUE TO PASSING VEHICLES.

LEGEND:
• CONE DELINEATOR
SPACING IS AS FOLLOWS:
WORK ZONE = 10' O.C.
BUFFER = 35' O.C.
TAPER = 35' O.C.

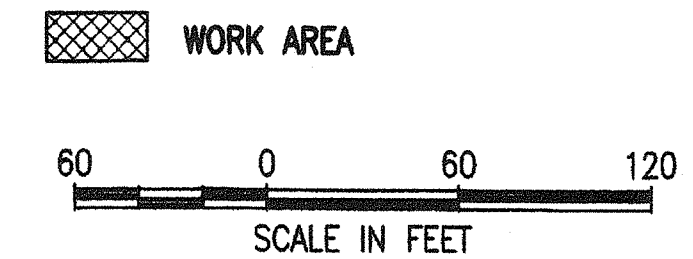

CARY K. KONO
LICENSED PROFESSIONAL ENGINEER
No. 4575-C
HAWAII, U.S.A.
THIS WORK WAS PREPARED BY ME OR UNDER MY SUPERVISION

STATE OF HAWAII
DEPARTMENT OF TRANSPORTATION
HIGHWAYS DIVISION

TRAFFIC CONTROL PLAN


TRAFFIC OPERATIONAL IMPROVEMENTS
AT VARIOUS LOCATIONS
KAHULUI BEACH ROAD
AT SMALL BOAT HARBOR ROAD
Project No. HWY-M-04-00
Scale: AS NOTED Date: Apr. 2002
SHEET No. 1 OF 2 SHEETS

DATE: _____
SURVEY PLOTTED BY: _____
DRAWN BY: _____
NOTE BOOK DESIGNED BY: _____
QUANTITIES BY: _____
CHECKED BY: _____

"AS BUILT"


FED. ROAD DIST. NO.	STATE	PROJ. NO.	FISCAL YEAR	SHEET NO.	TOTAL SHEETS
HAWAII	HAW.	HWY-M-04-00	2002	44	63

NOTE:
DURING NON WORKING HOURS, TYPE II BARRICADES WITH STEADYBURN LIGHTS SHALL BE INSTALLED ALONG EDGE OF EXISTING PAVEMENTS EXPOSED BY ADJACENT EXCAVATION FOR NEW PAVEMENTS. BARRICADES SHALL BE INSTALLED WITH SANDBAGS TO PREVENT MOVEMENTS DUE TO PASSING VEHICLES.

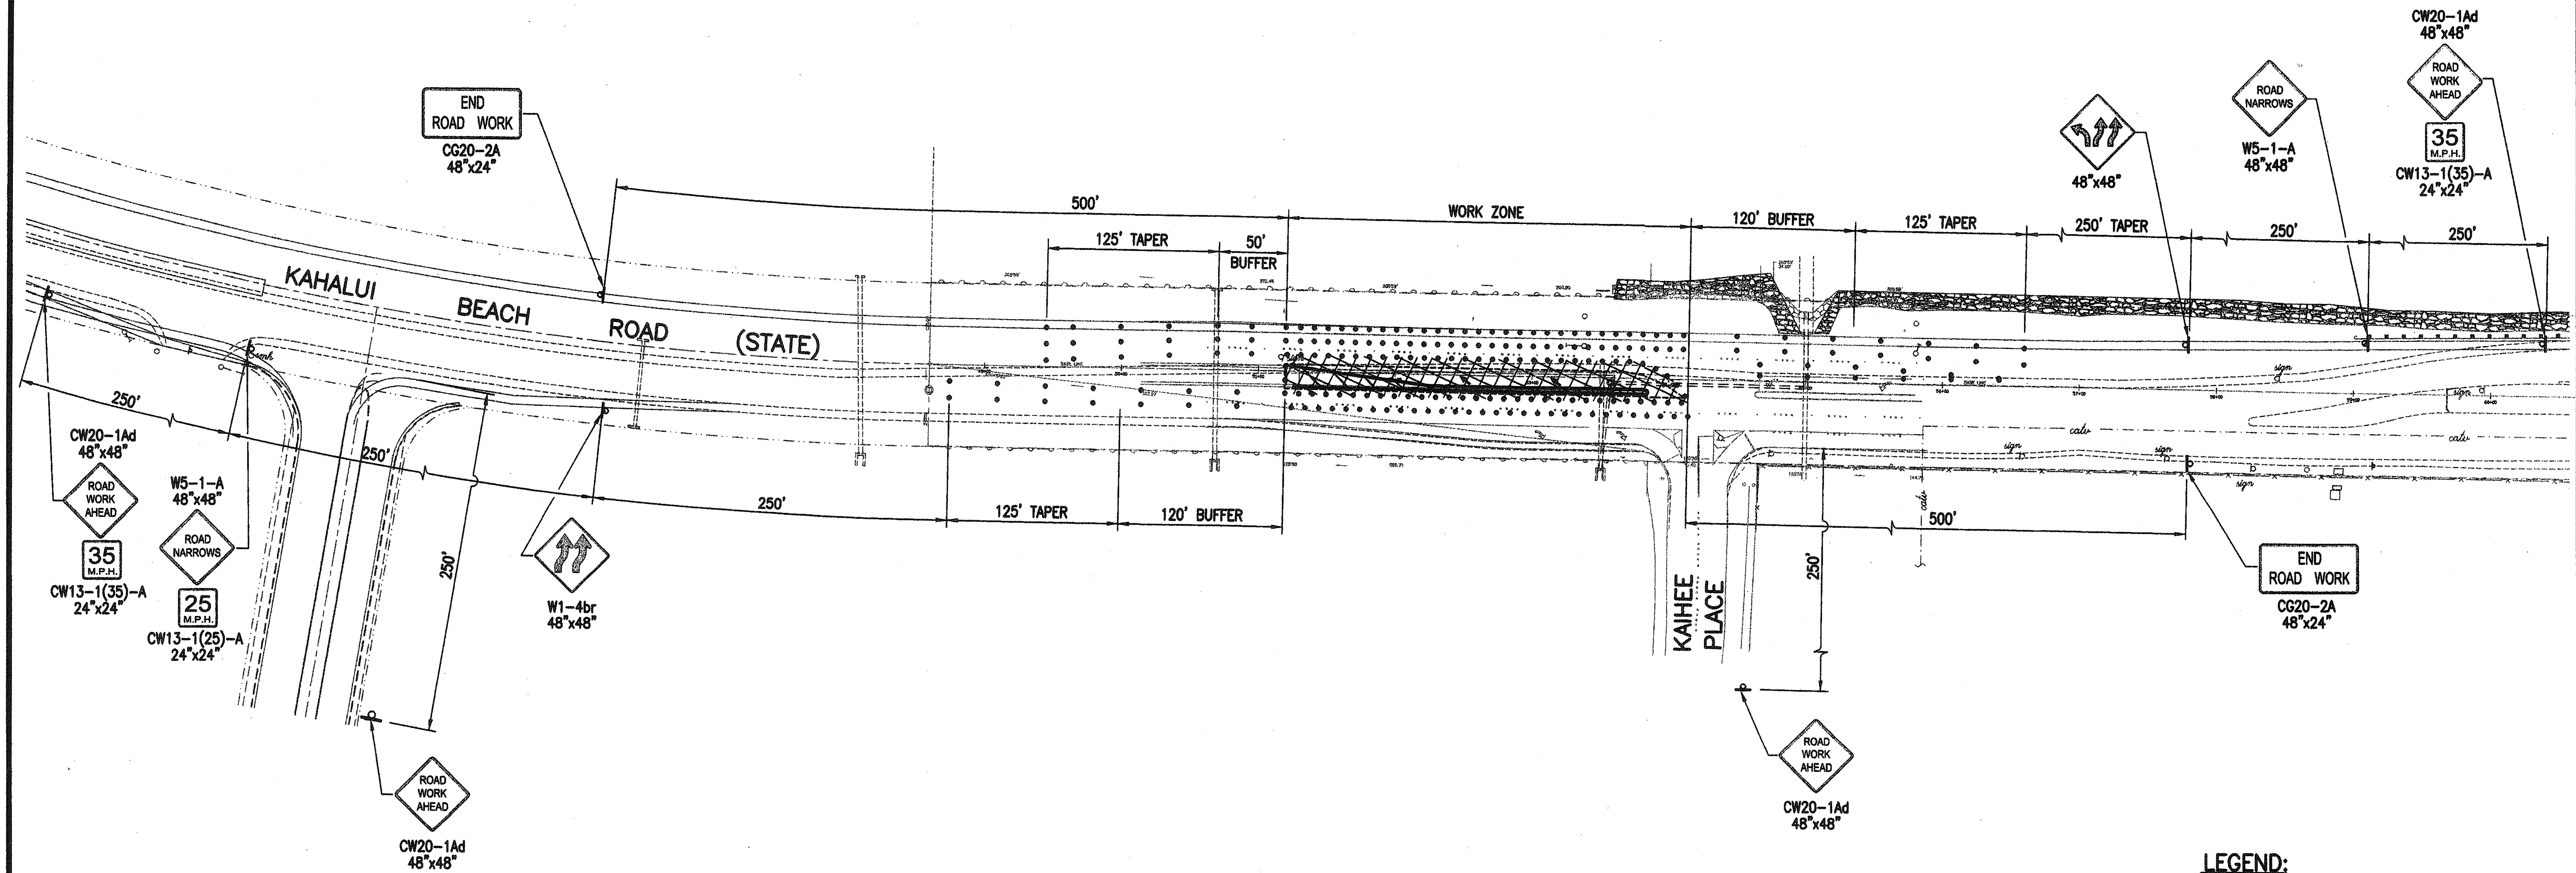

LEGEND:
• CONE DELINEATOR
SPACING IS AS FOLLOWS:
WORK ZONE = 10' O.C.
BUFFER = 35' O.C.
TAPER = 35' O.C.
[Hatched Box] WORK AREA

DATE	_____
SURVEY PLOTTED BY	_____
DRAWN BY	_____
DESIGNED BY	_____
QUANTITIES BY	_____
CHECKED BY	_____
ORIGINAL PLAN	_____
NOTE BOOK	_____
No.	_____

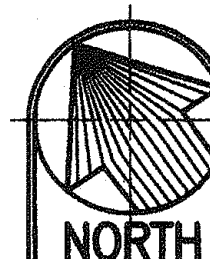

TRAFFIC CONTROL PLAN
SCALE: 1"=60'


REDUCED PLAN
(HALF SIZE)



3 INCHES ON ORIGINAL PLAN



SCALE IN FEET

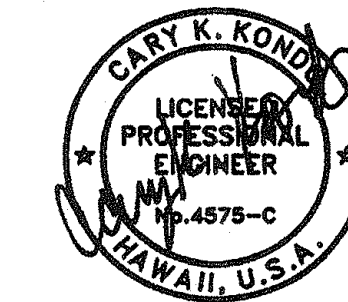

THIS WORK WAS PREPARED BY
ME OR UNDER MY SUPERVISION

STATE OF HAWAII
DEPARTMENT OF TRANSPORTATION
HIGHWAYS DIVISION

TRAFFIC CONTROL PLAN

TRAFFIC OPERATIONAL IMPROVEMENTS
AT VARIOUS LOCATIONS
KAHALUI BEACH ROAD
AT KAIHEE PLACE

Project No. HWY-M-04-00

Scale: AS NOTED Date: Apr. 2002

SHEET No. 2 OF 2 SHEETS