

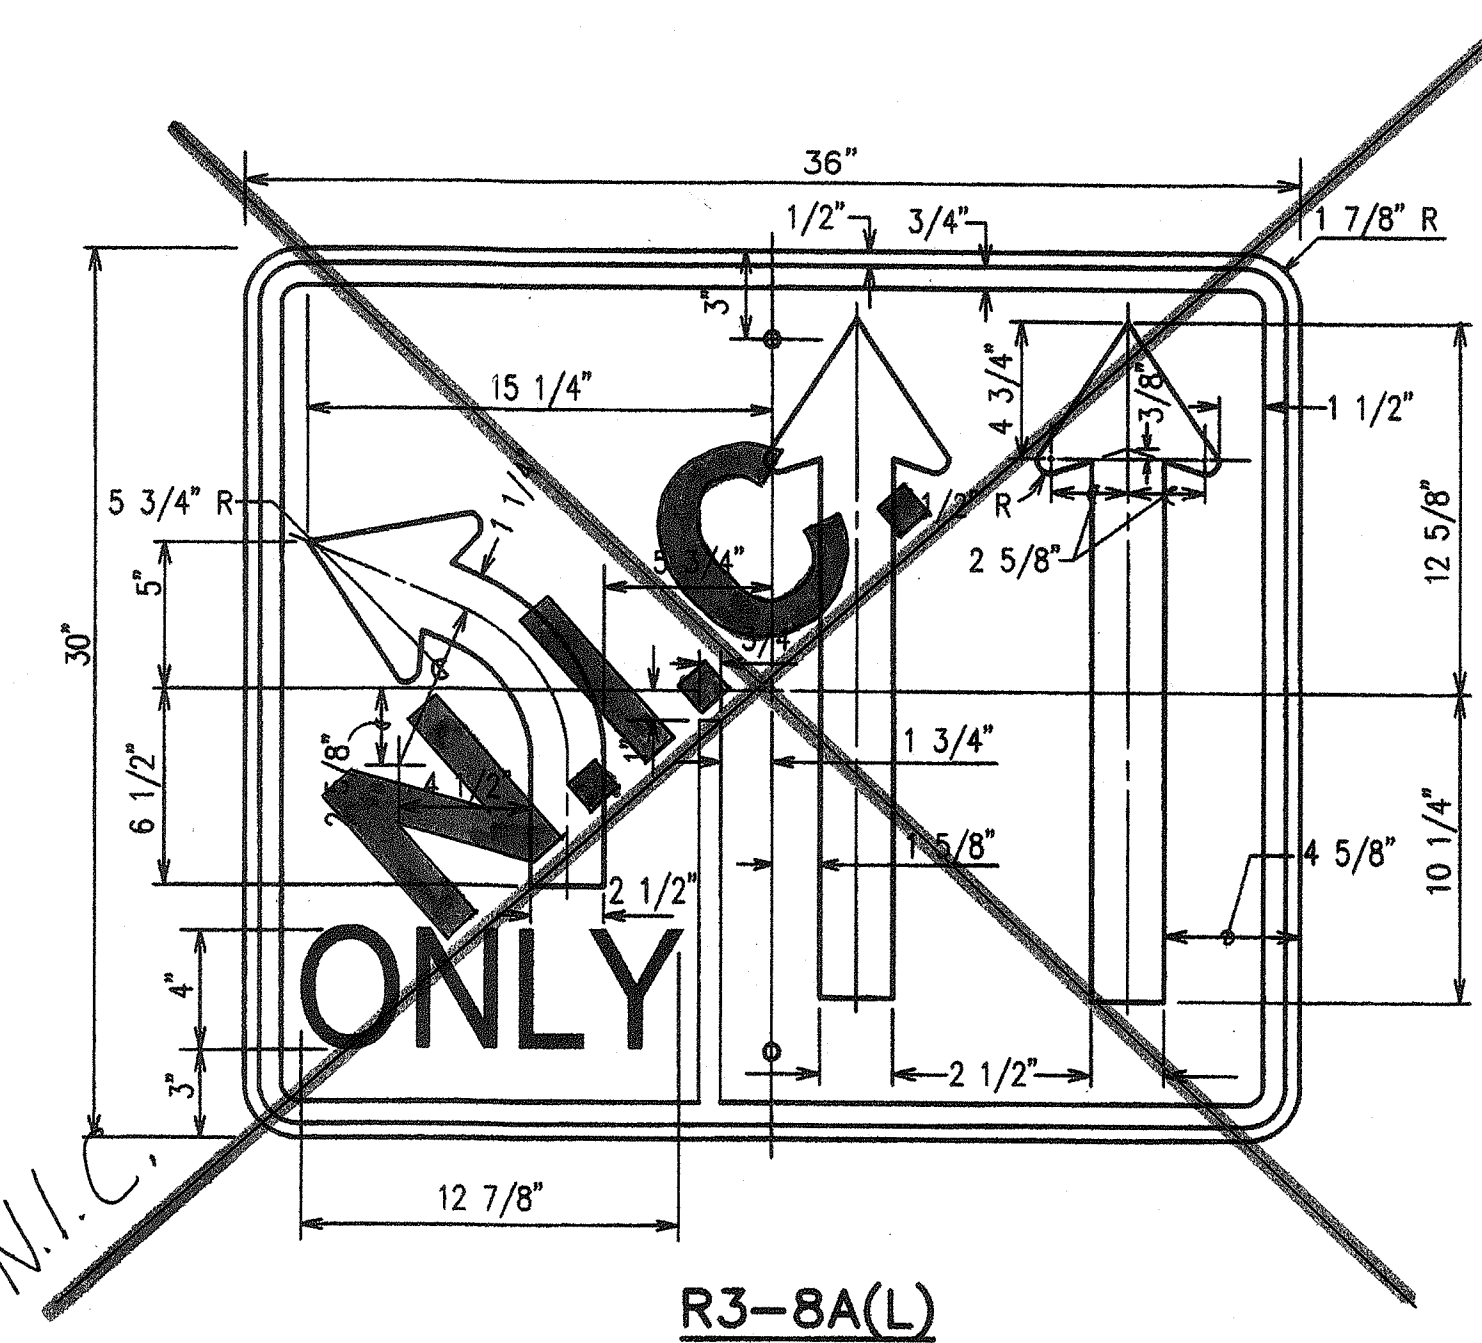
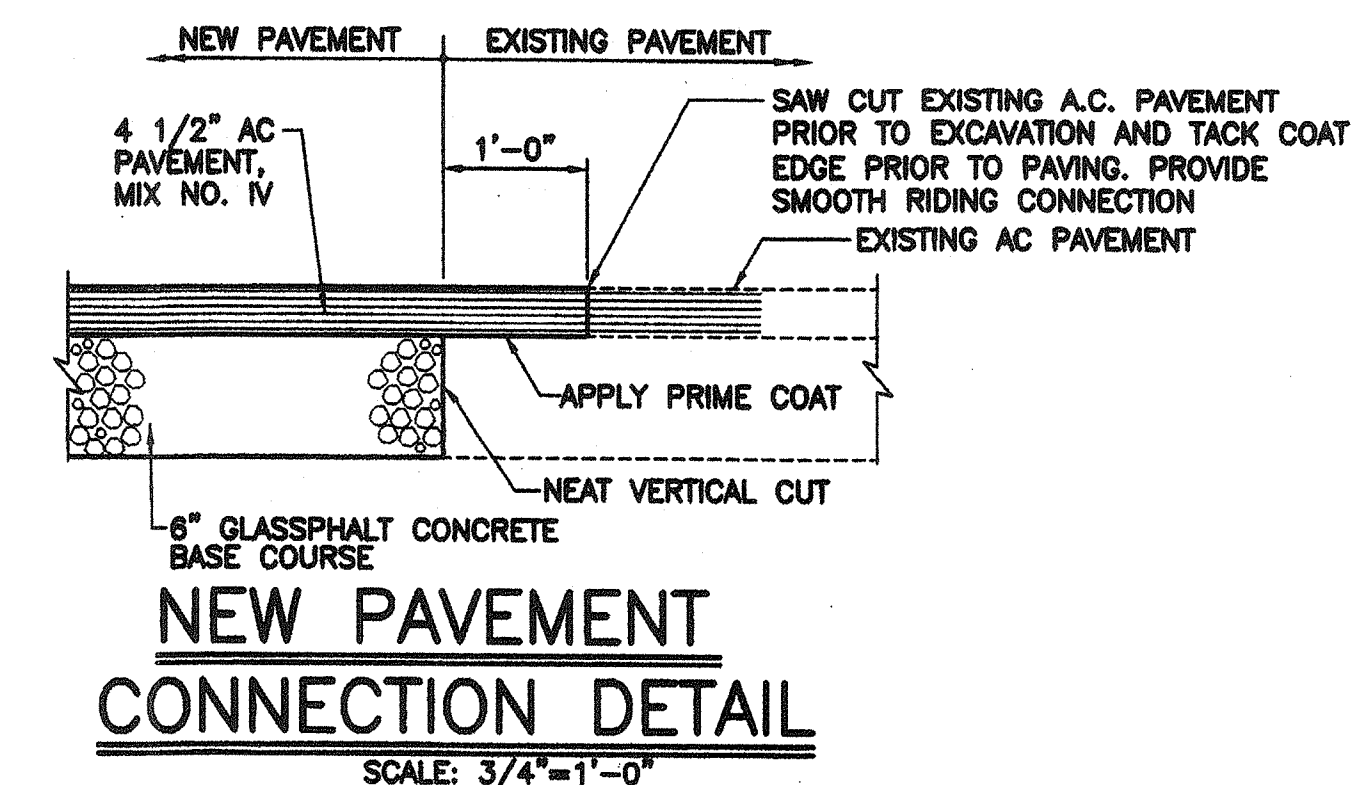
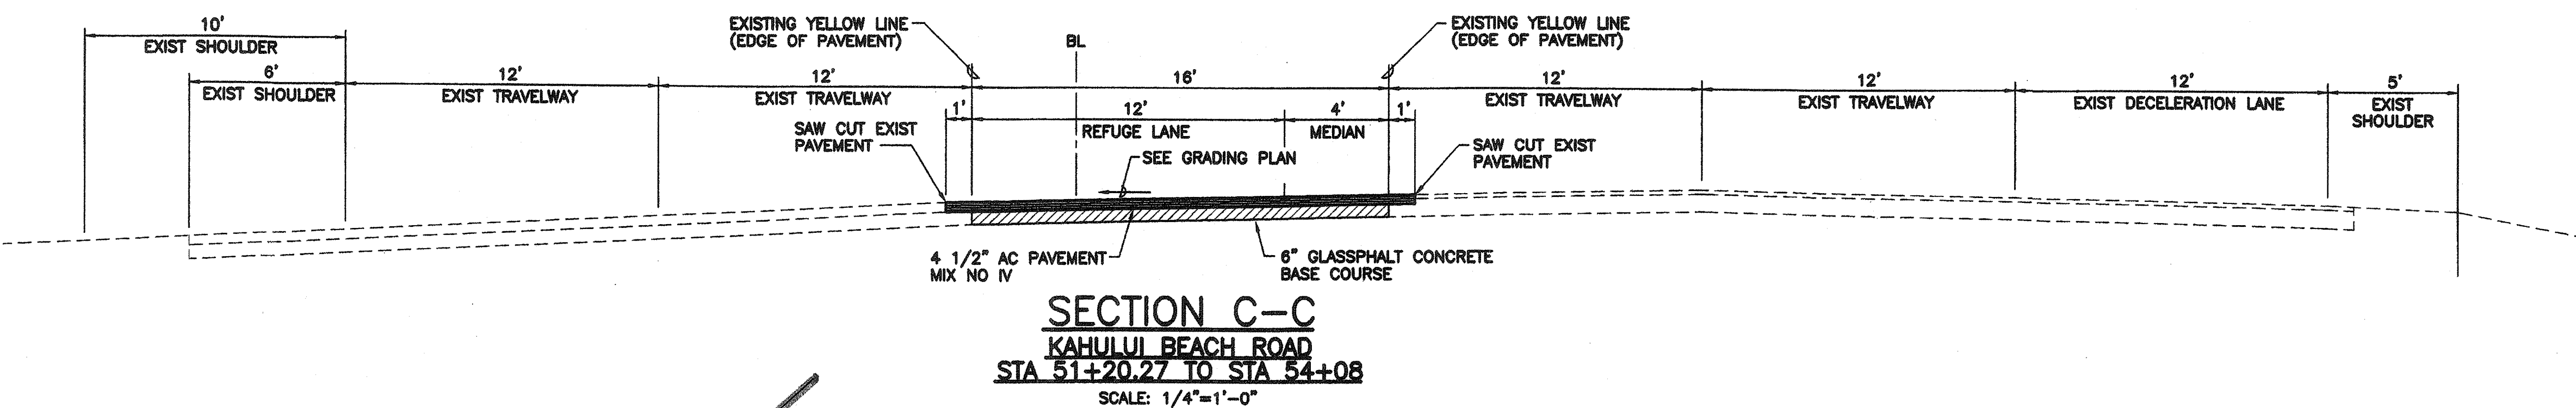
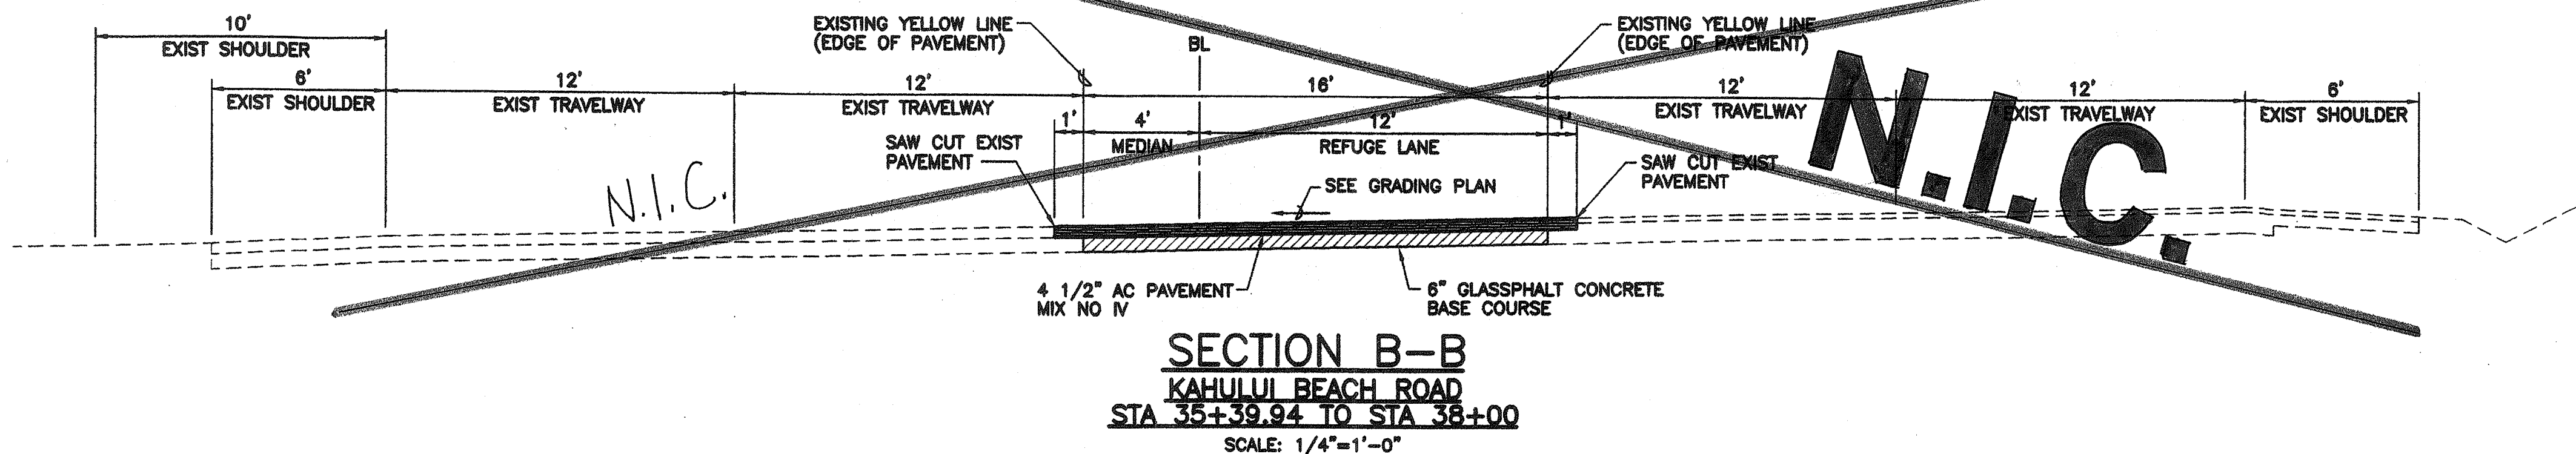
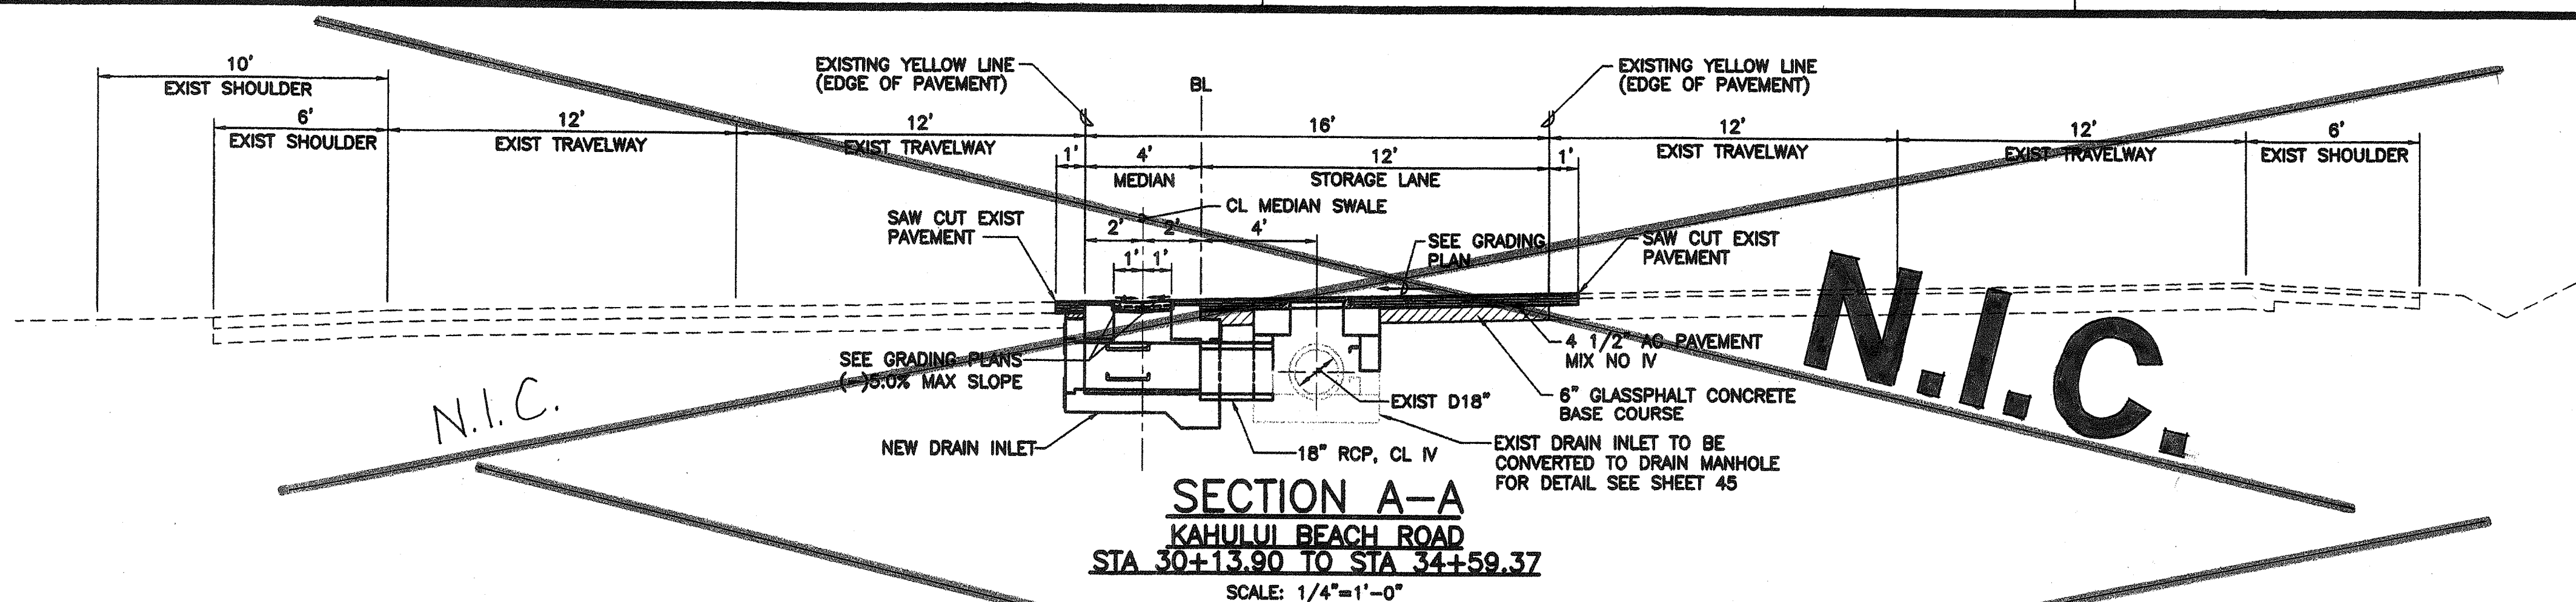
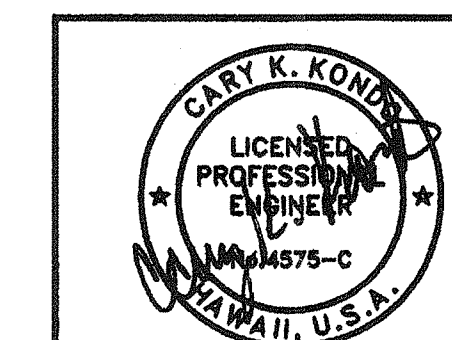


FED. ROAD DIST. NO.	STATE	PROJ. NO.	FISCAL YEAR	SHEET NO.	TOTAL SHEETS
HAWAII	HAW.	HWY-M-04-00	2002	36	63

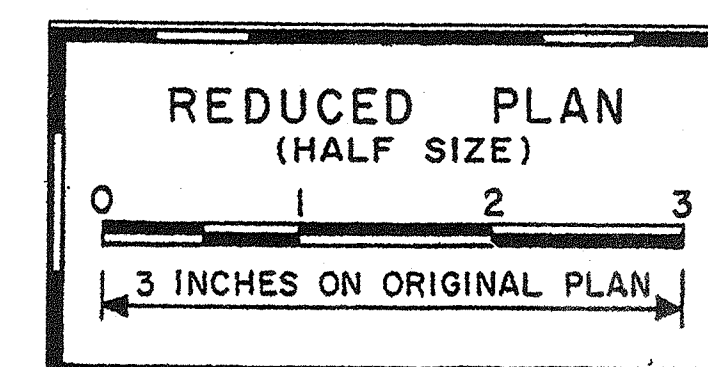

NOTE:
TYPE "H" (REFLECTIVE SURFACE FACING ONCOMING TRAFFIC)

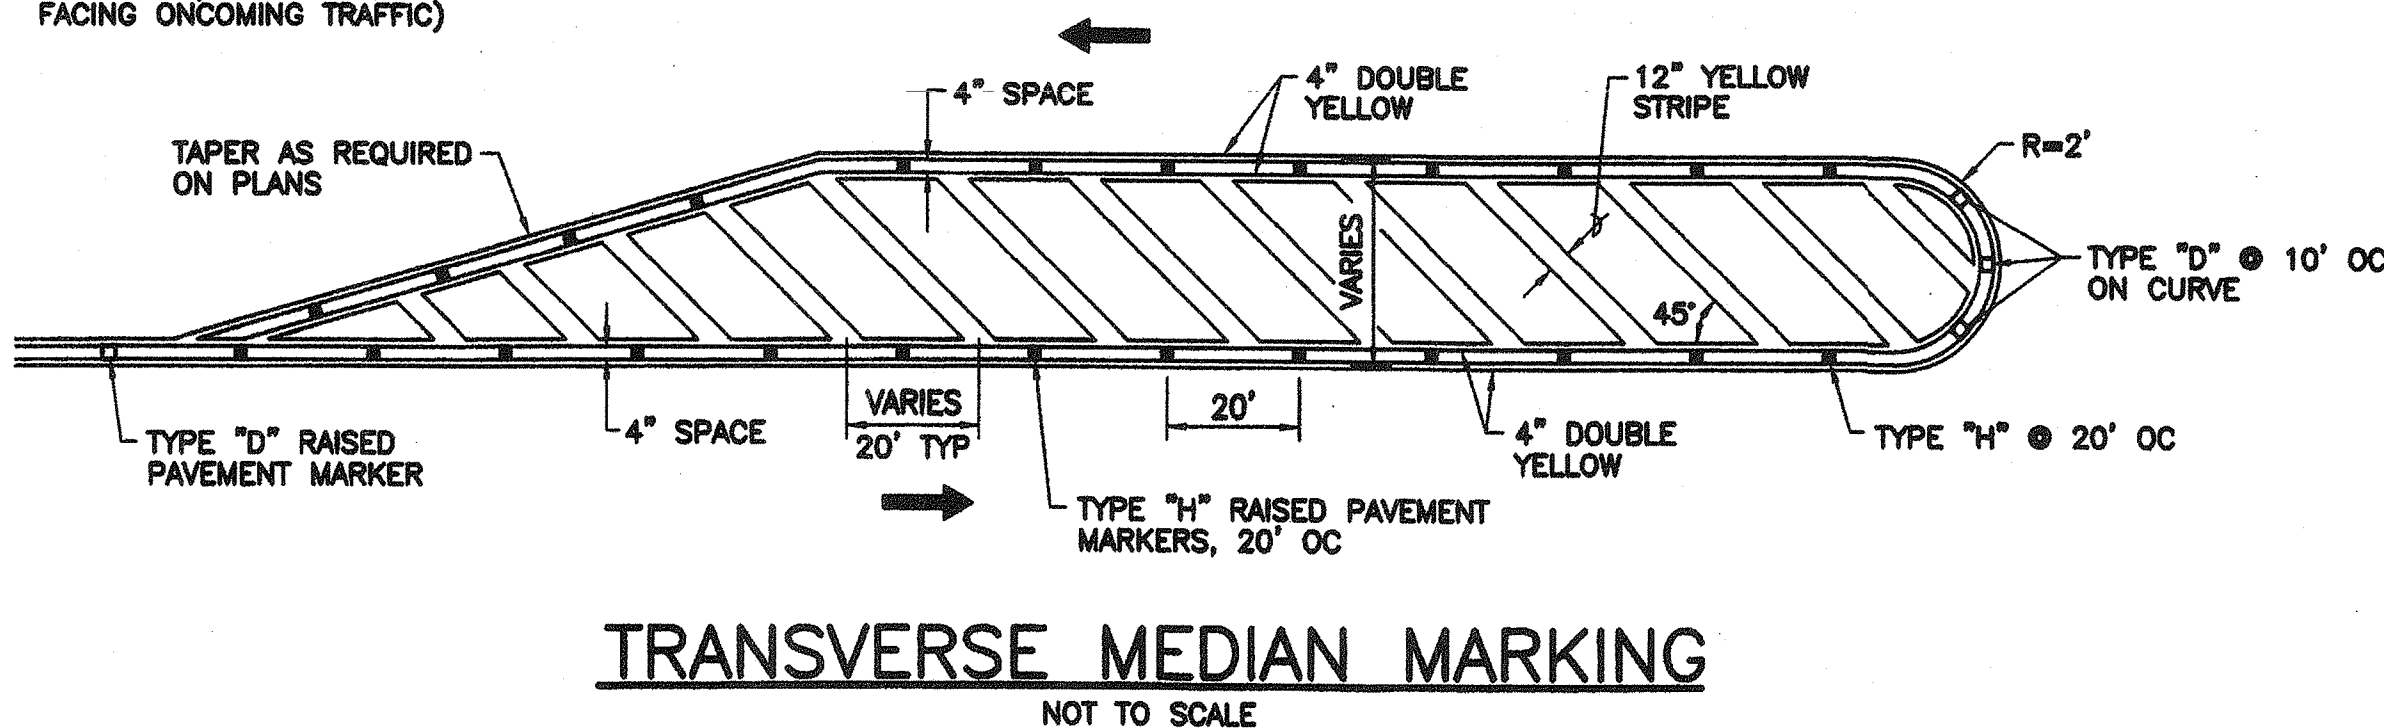

STATE OF HAWAII
DEPARTMENT OF TRANSPORTATION
HIGHWAYS DIVISION

TYPICAL SECTIONS AND DETAILS
TRAFFIC OPERATIONAL IMPROVEMENTS
AT VARIOUS LOCATIONS
KAHULUI BEACH ROAD
AT SMALL BOAT HARBOR ROAD AND KAIHEE PLACE
Project No. HWY-M-04-00
Scale: AS NOTED Date: Apr. 2002
SHEET No. 1 OF 1 SHEETS

"AS BUILT"