

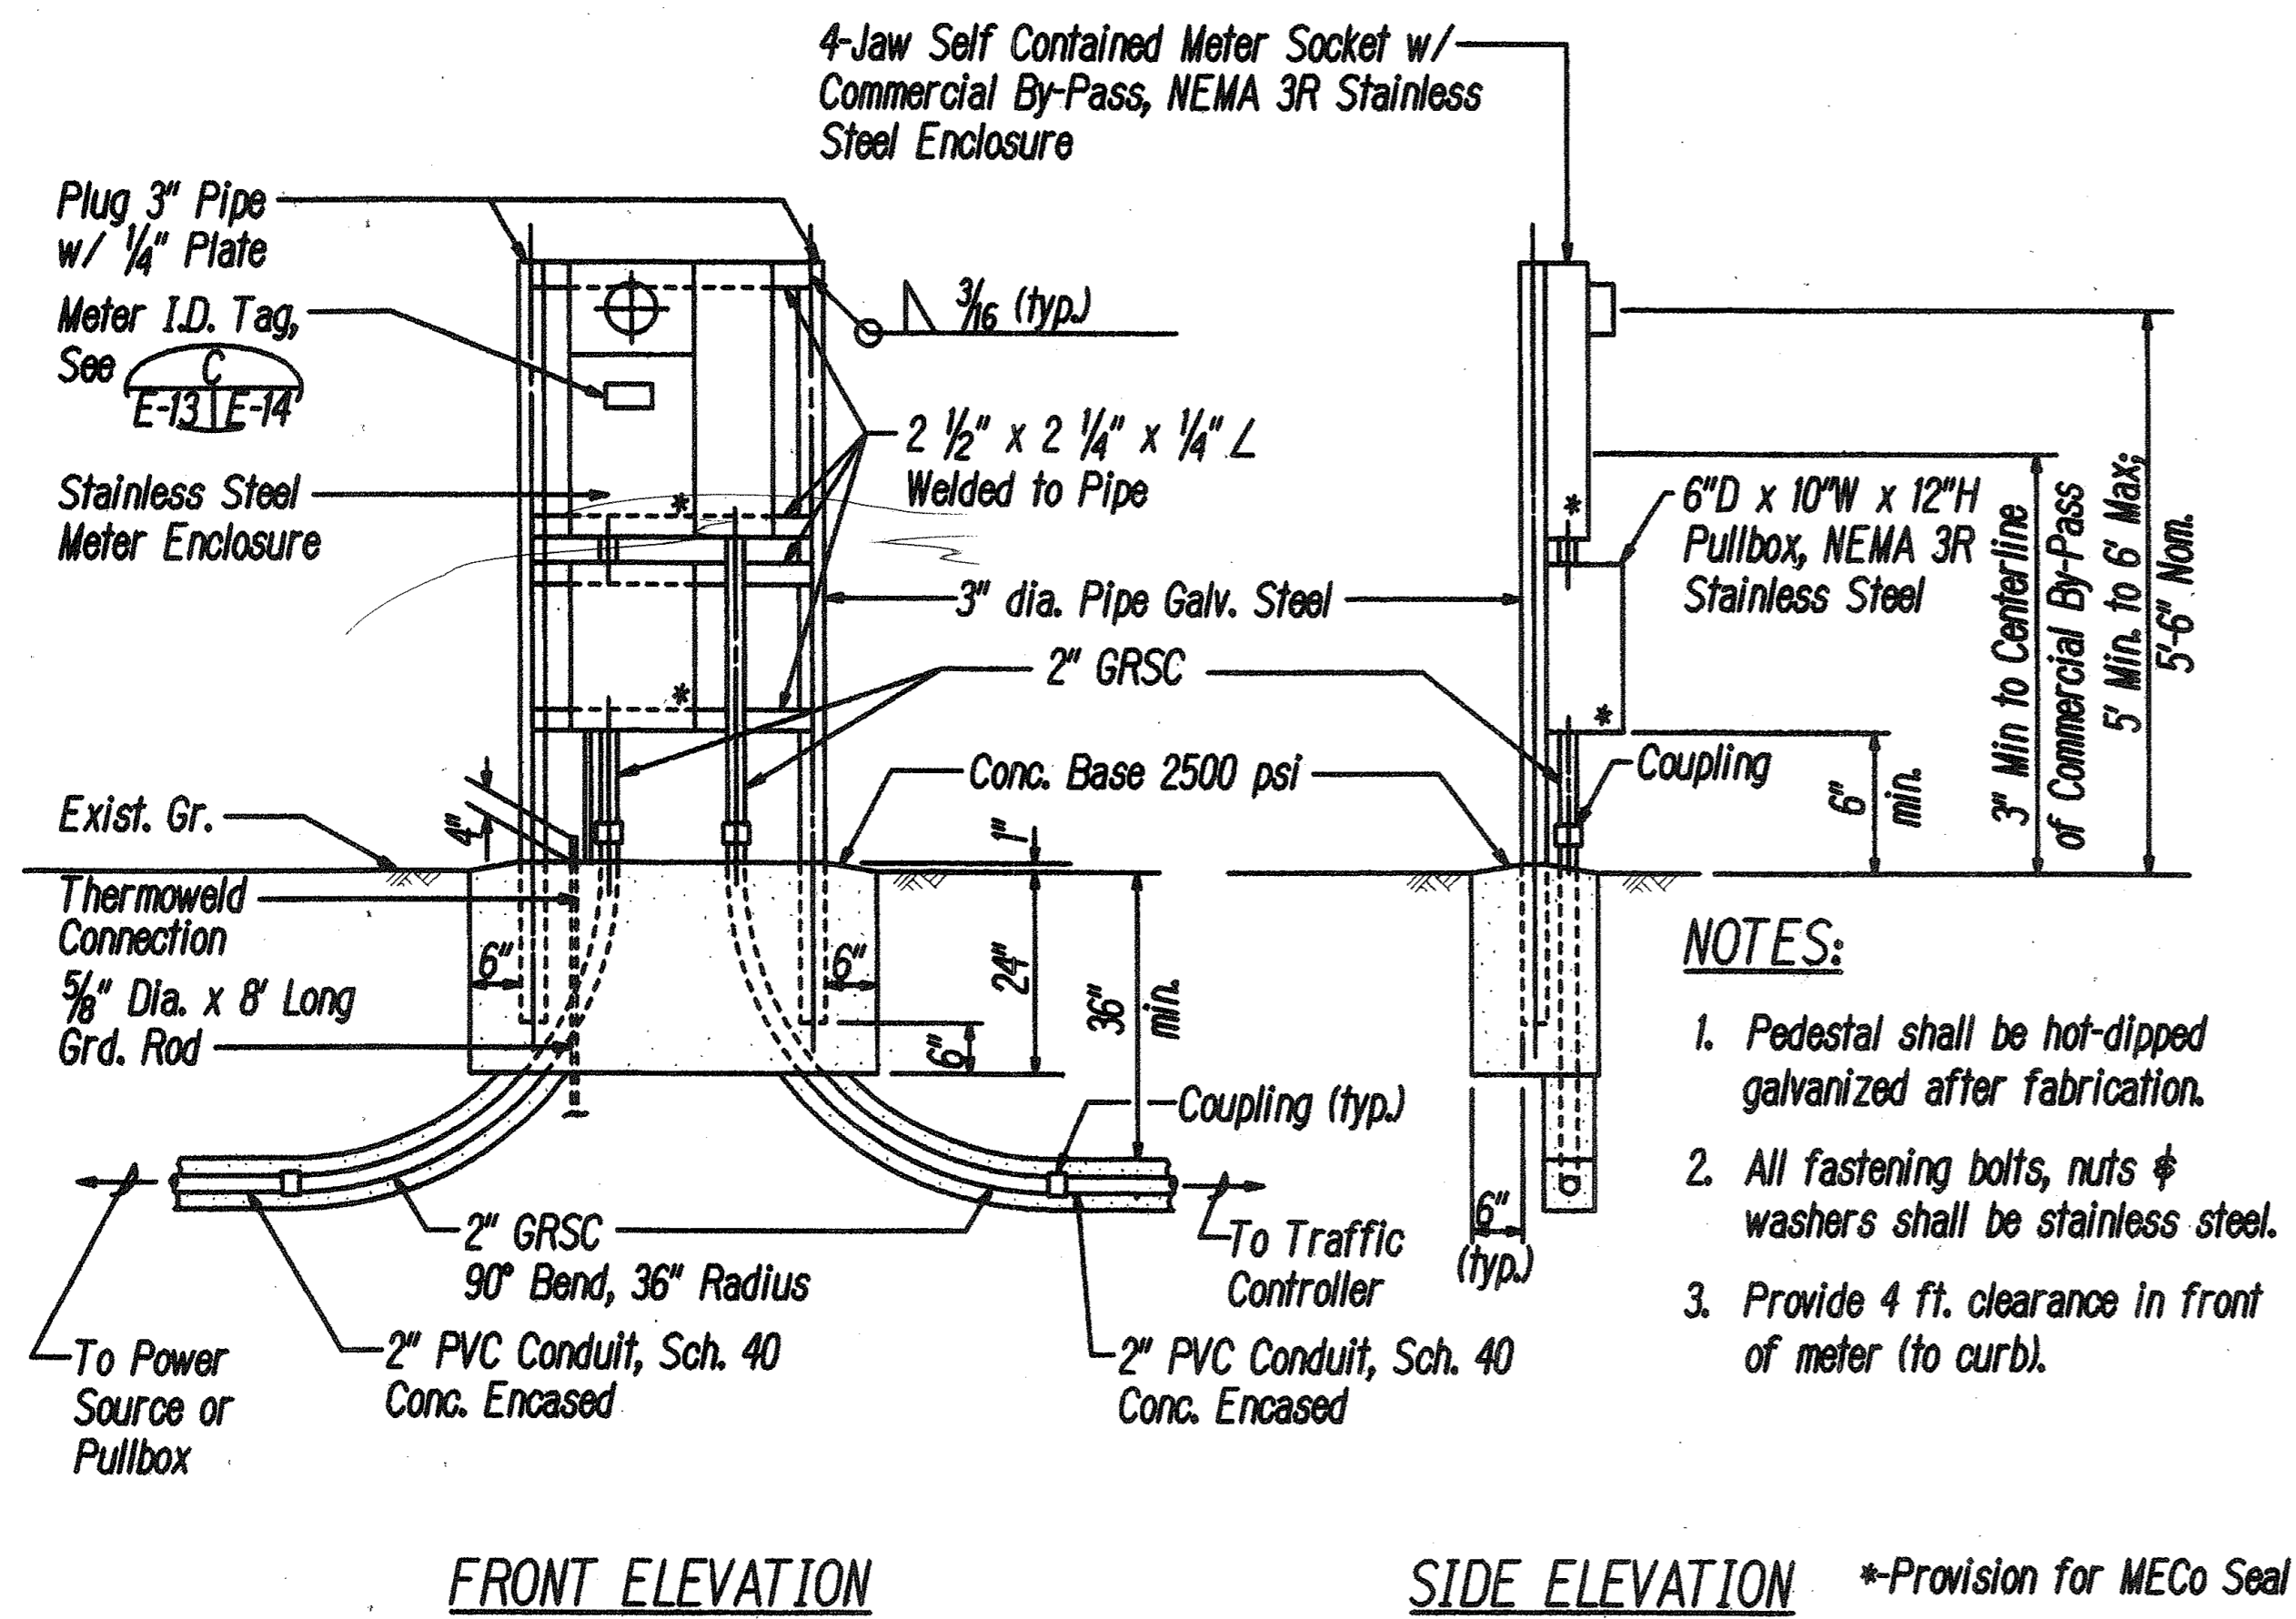
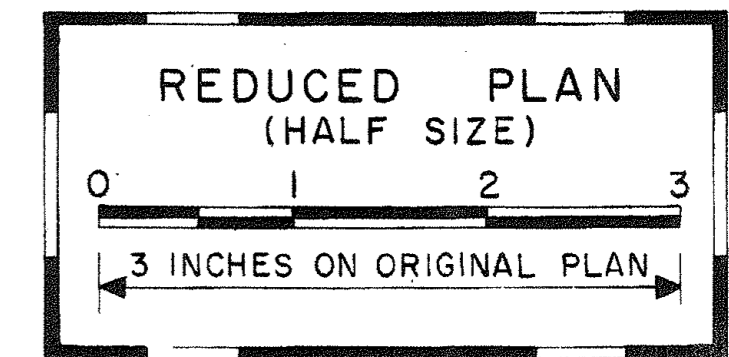
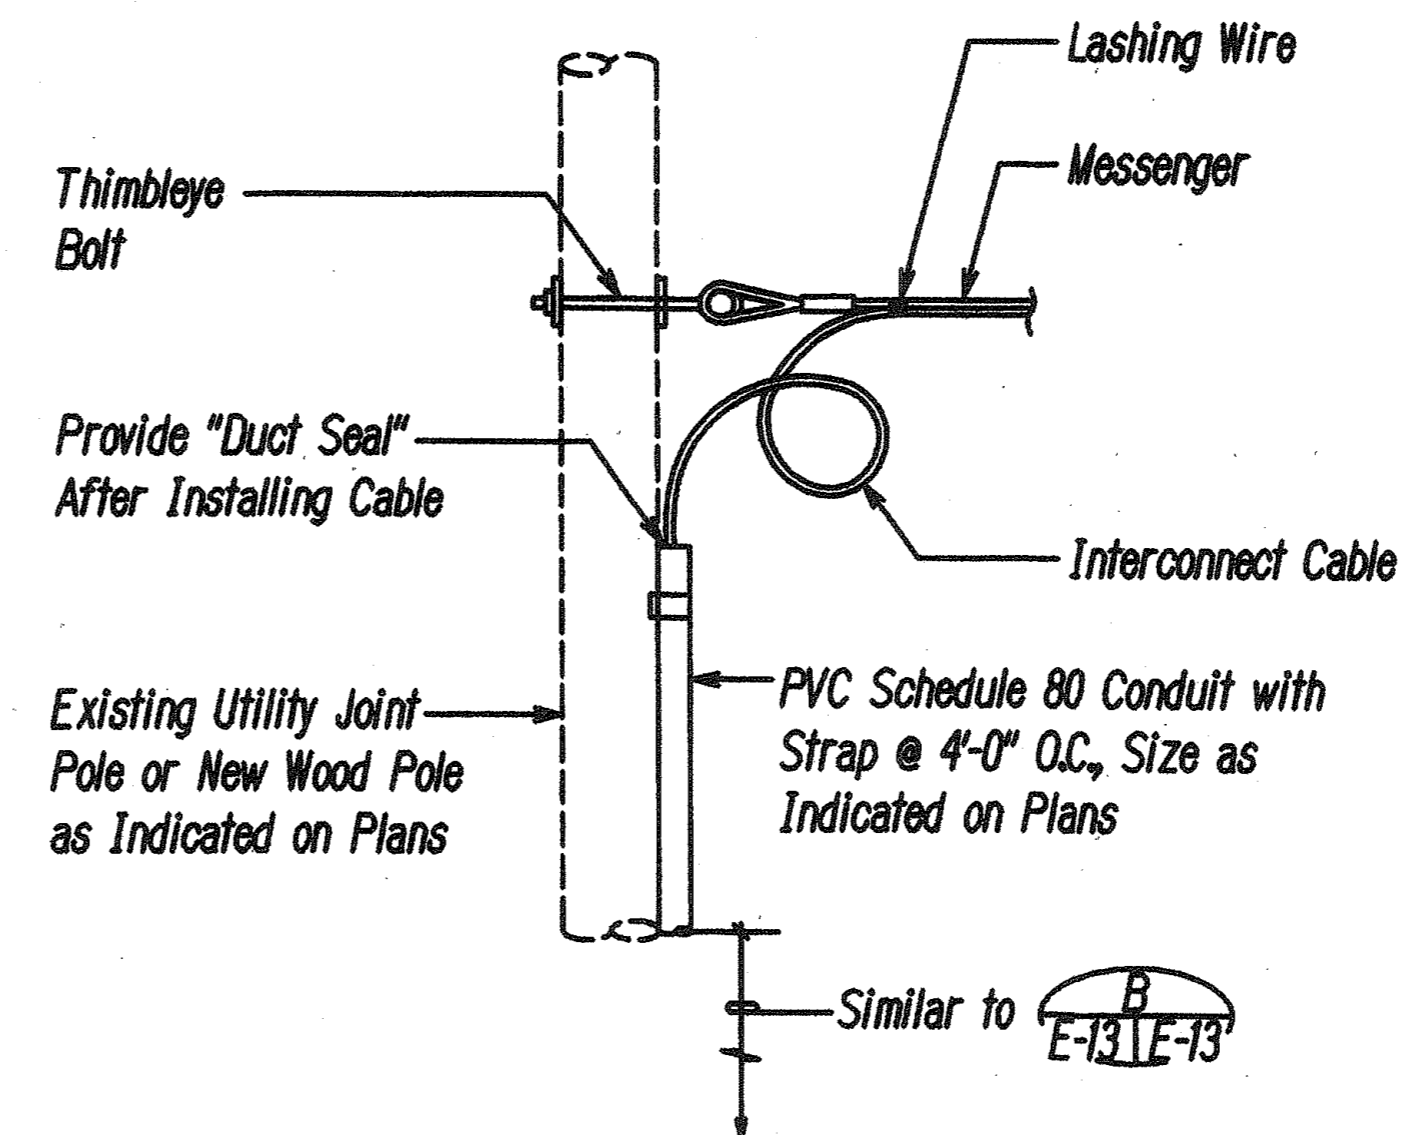
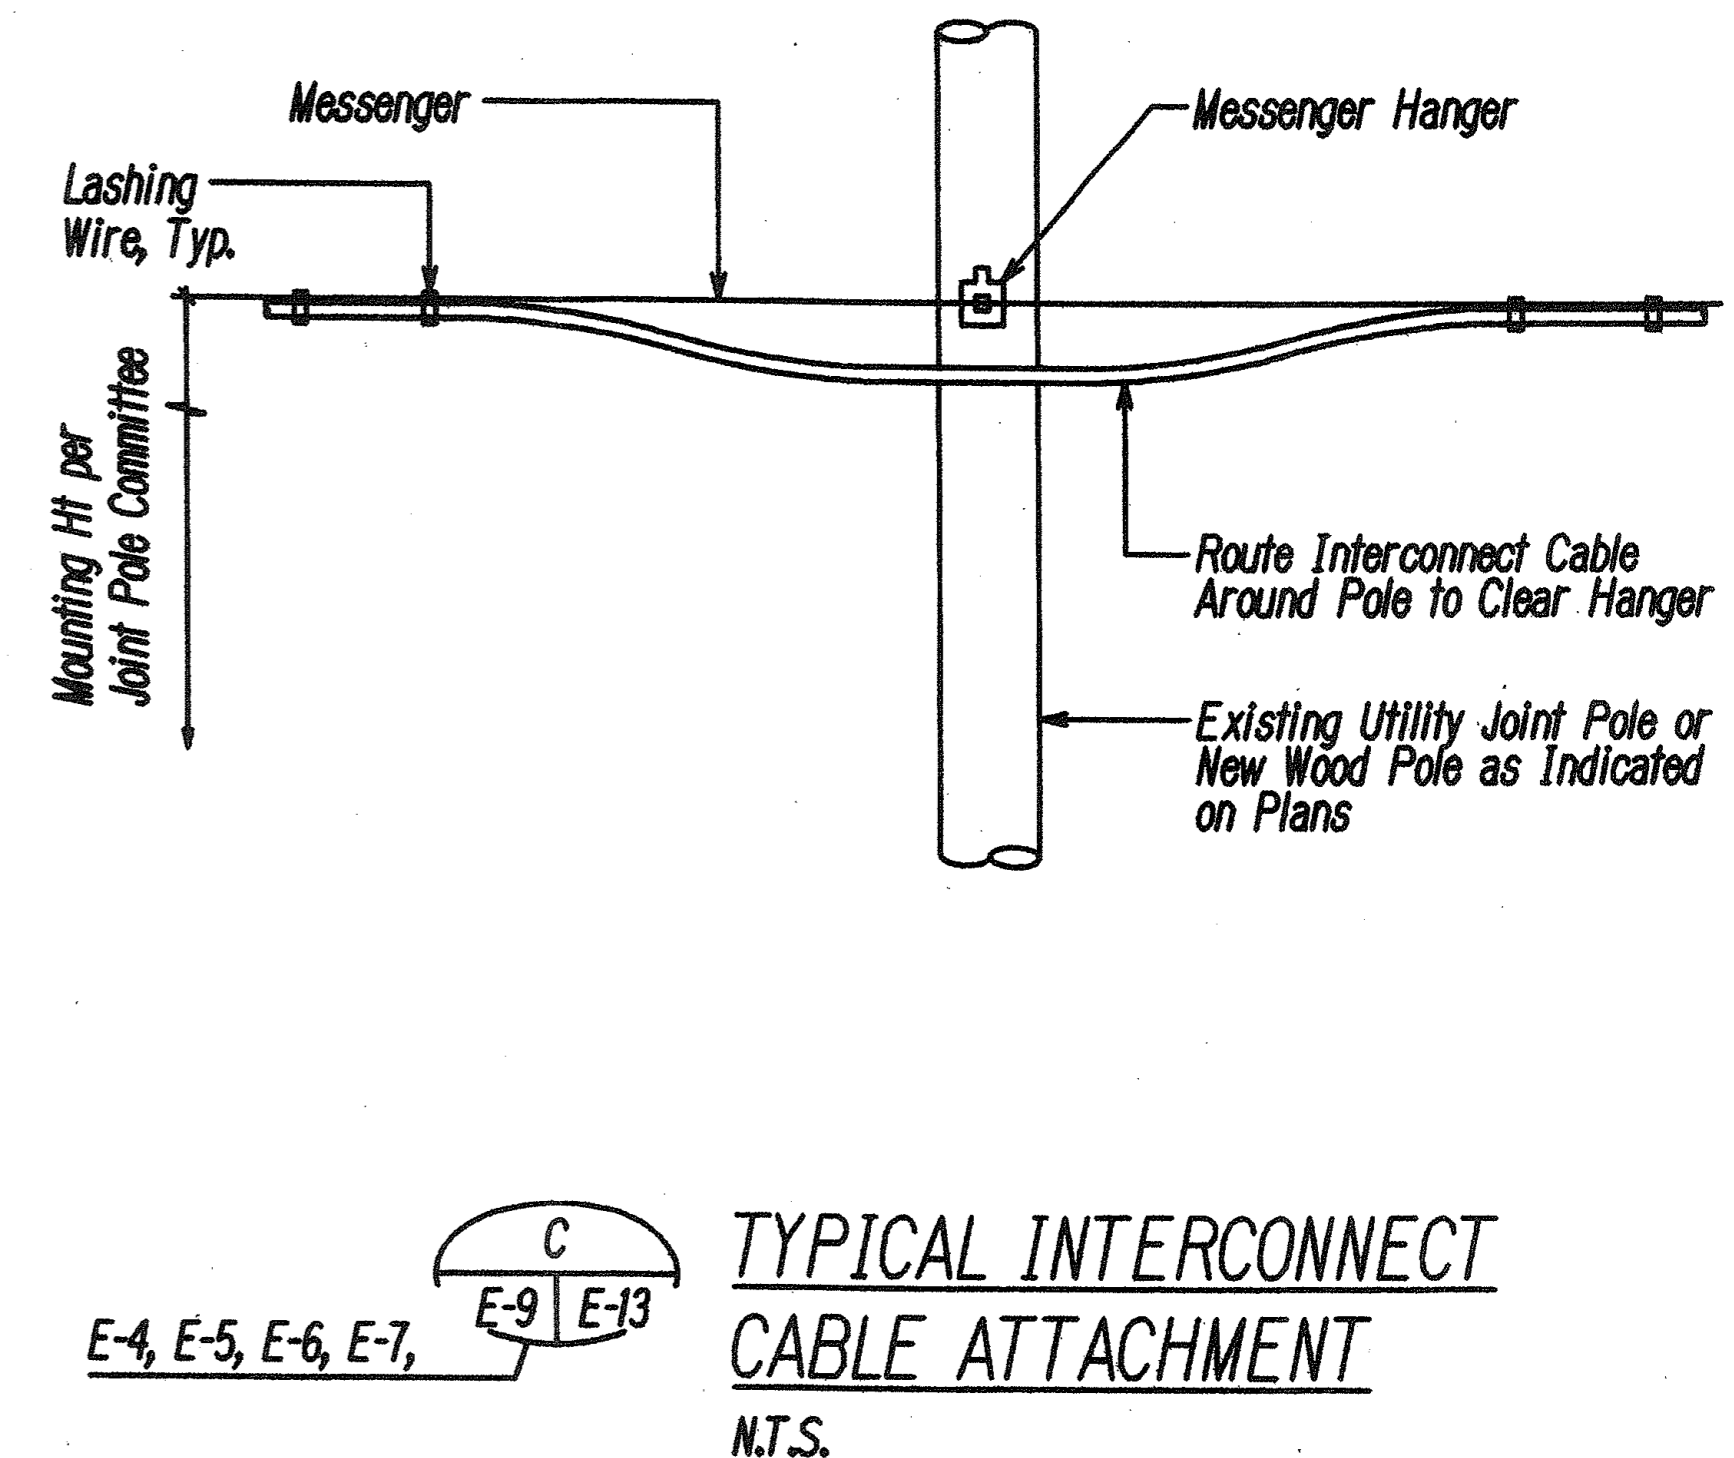



FED. ROAD DIST. NO.	STATE	PROJ. NO.	FISCAL YEAR	SHEET NO.	TOTAL SHEETS
HAWAII	HAW.	HWY-M-04-00	2002	22	63

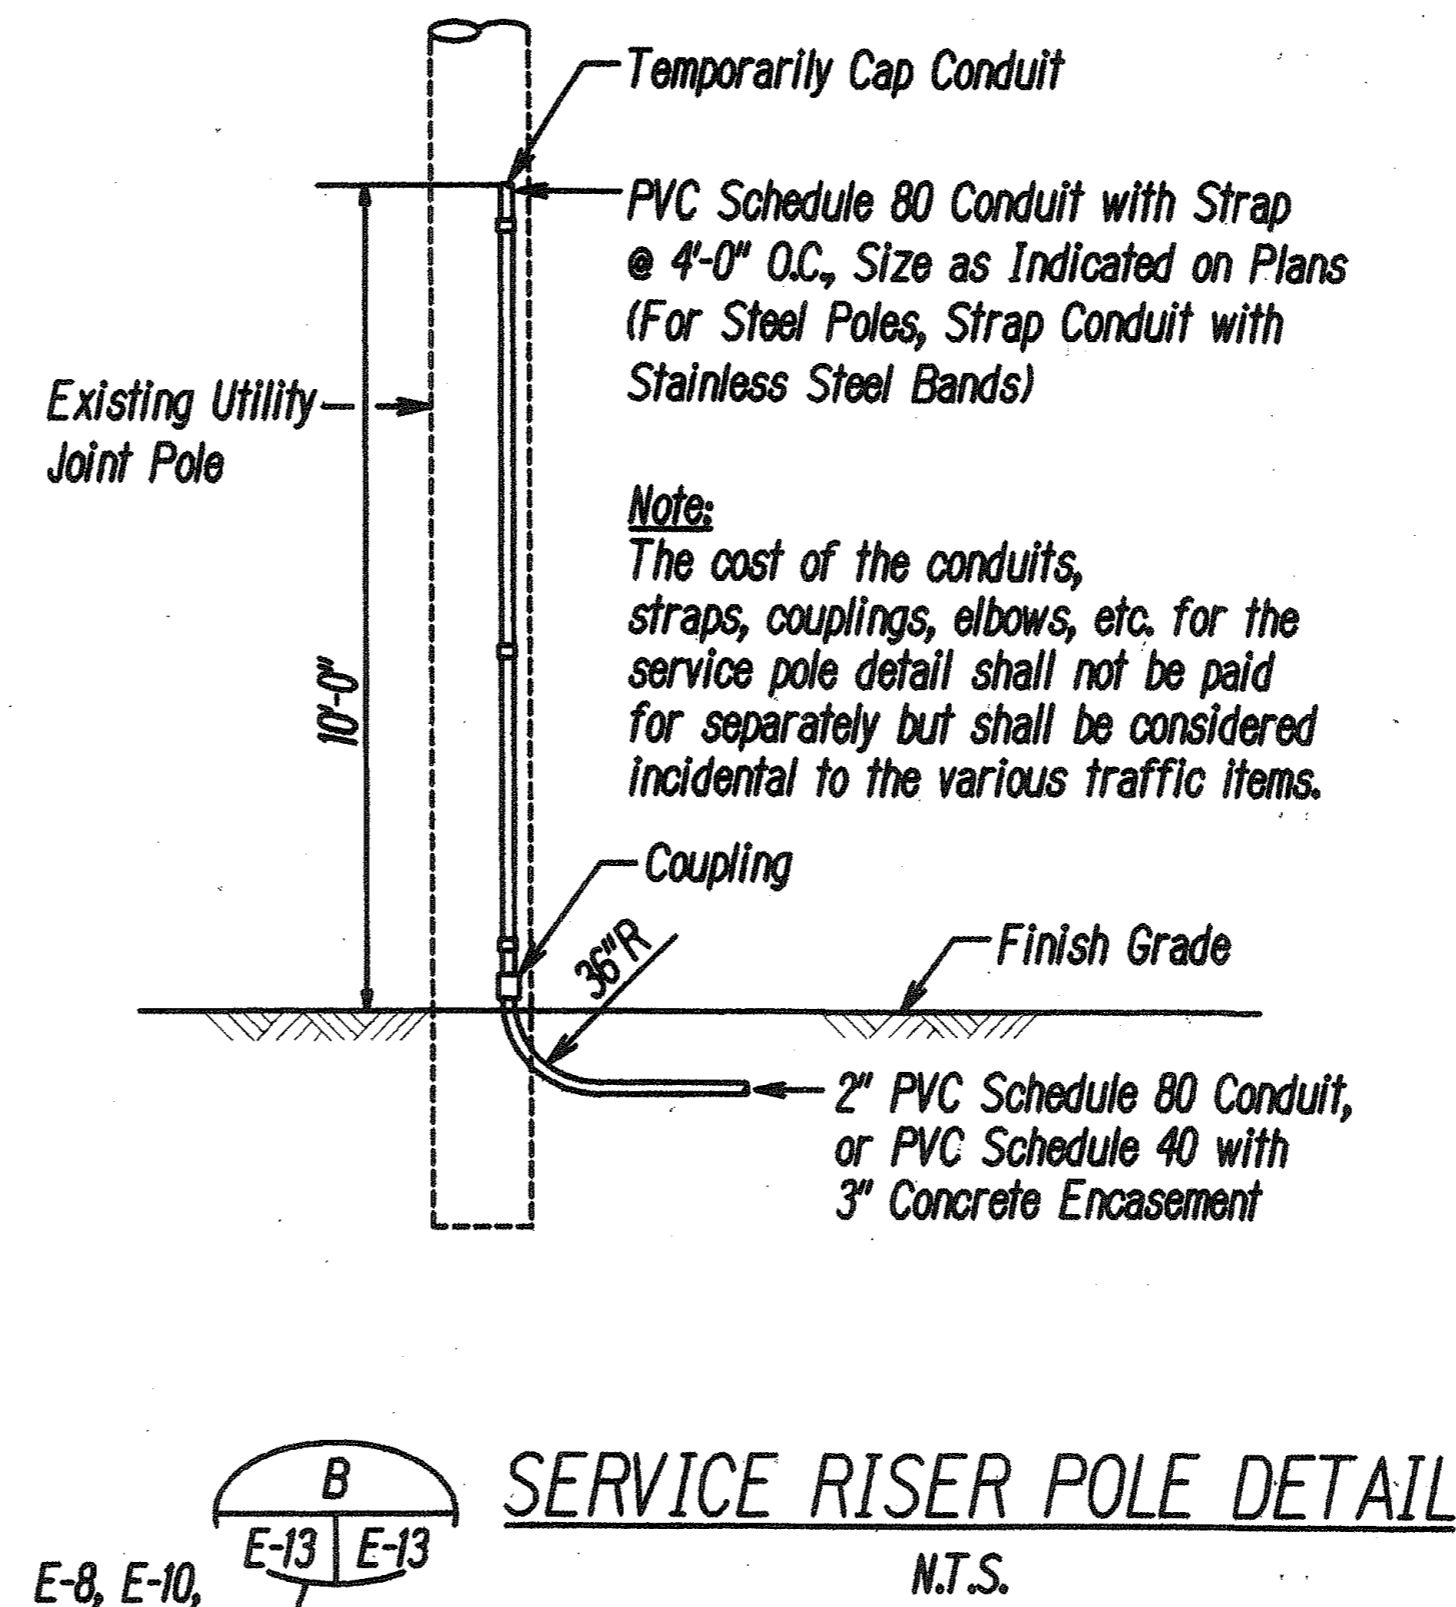

**METER PEDESTAL FOR UNDERGROUND SERVICE**  
N.T.S.

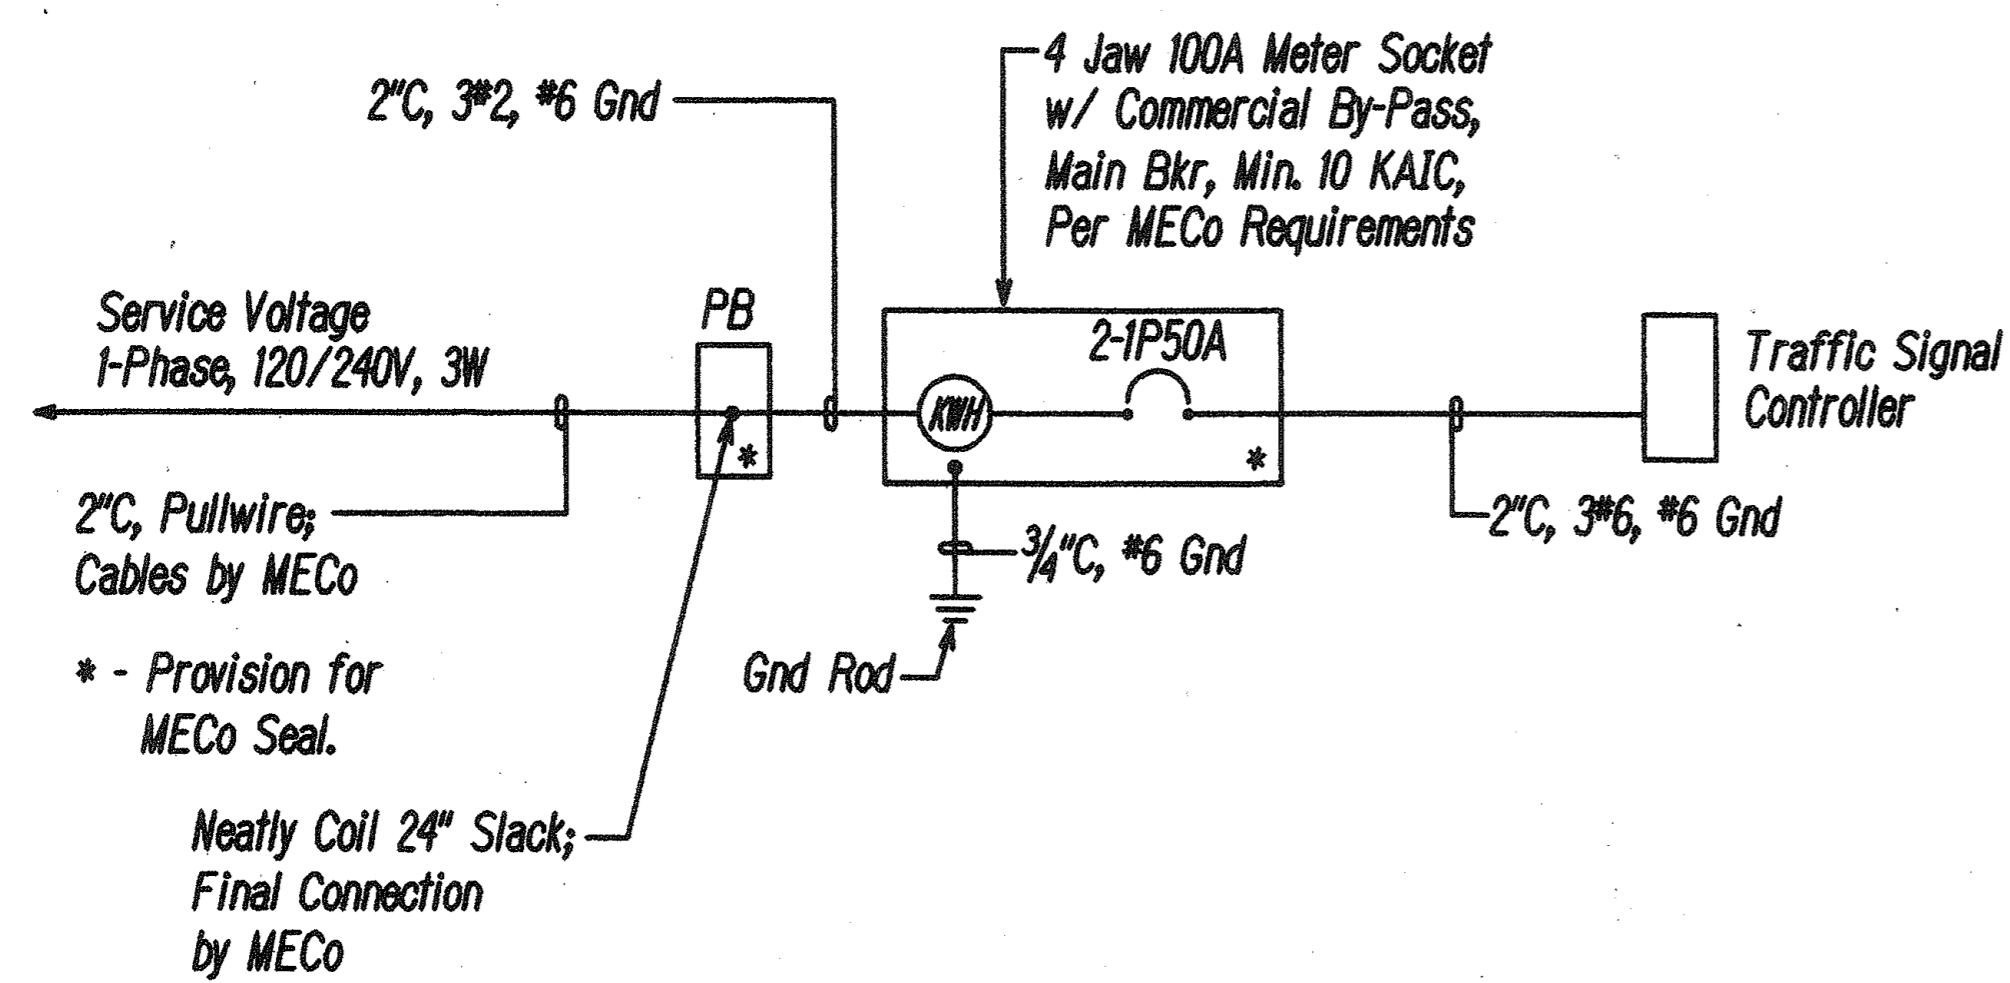


6/12/02	REVISED DETAIL	
DATE	DESCRIPTION	
STATE OF HAWAII DEPARTMENT OF TRANSPORTATION HIGHWAYS DIVISION		
<u>TRAFFIC SIGNAL DETAILS I</u>		
<u>TRAFFIC OPERATIONAL IMPROVEMENTS</u> <u>AT VARIOUS LOCATIONS</u> <u>PUUNENE AVENUE AND</u> <u>KAAHUMANU AVENUE</u>		
Scale: AS NOTED	Date: April 2002	
SHEET No. E-13 OF 22 SHEETS		

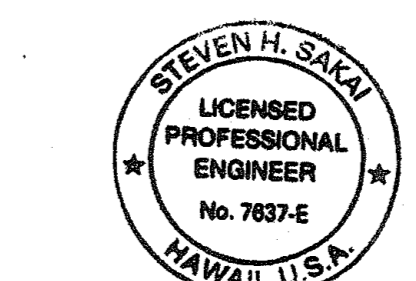



THIS WORK WAS PREPARED BY ME  
OR UNDER MY SUPERVISION  
*Steven H. Sakai*

DESIGNED BY	DATE
DRAWN BY	
CHECKED BY	
IN CHARGE	
NOTED BY	
APPROVED BY	
DATE	

10 JUN 02 11:50:51 LA 22 kscdhpj01dts21143dgm211dsc00a.dgn

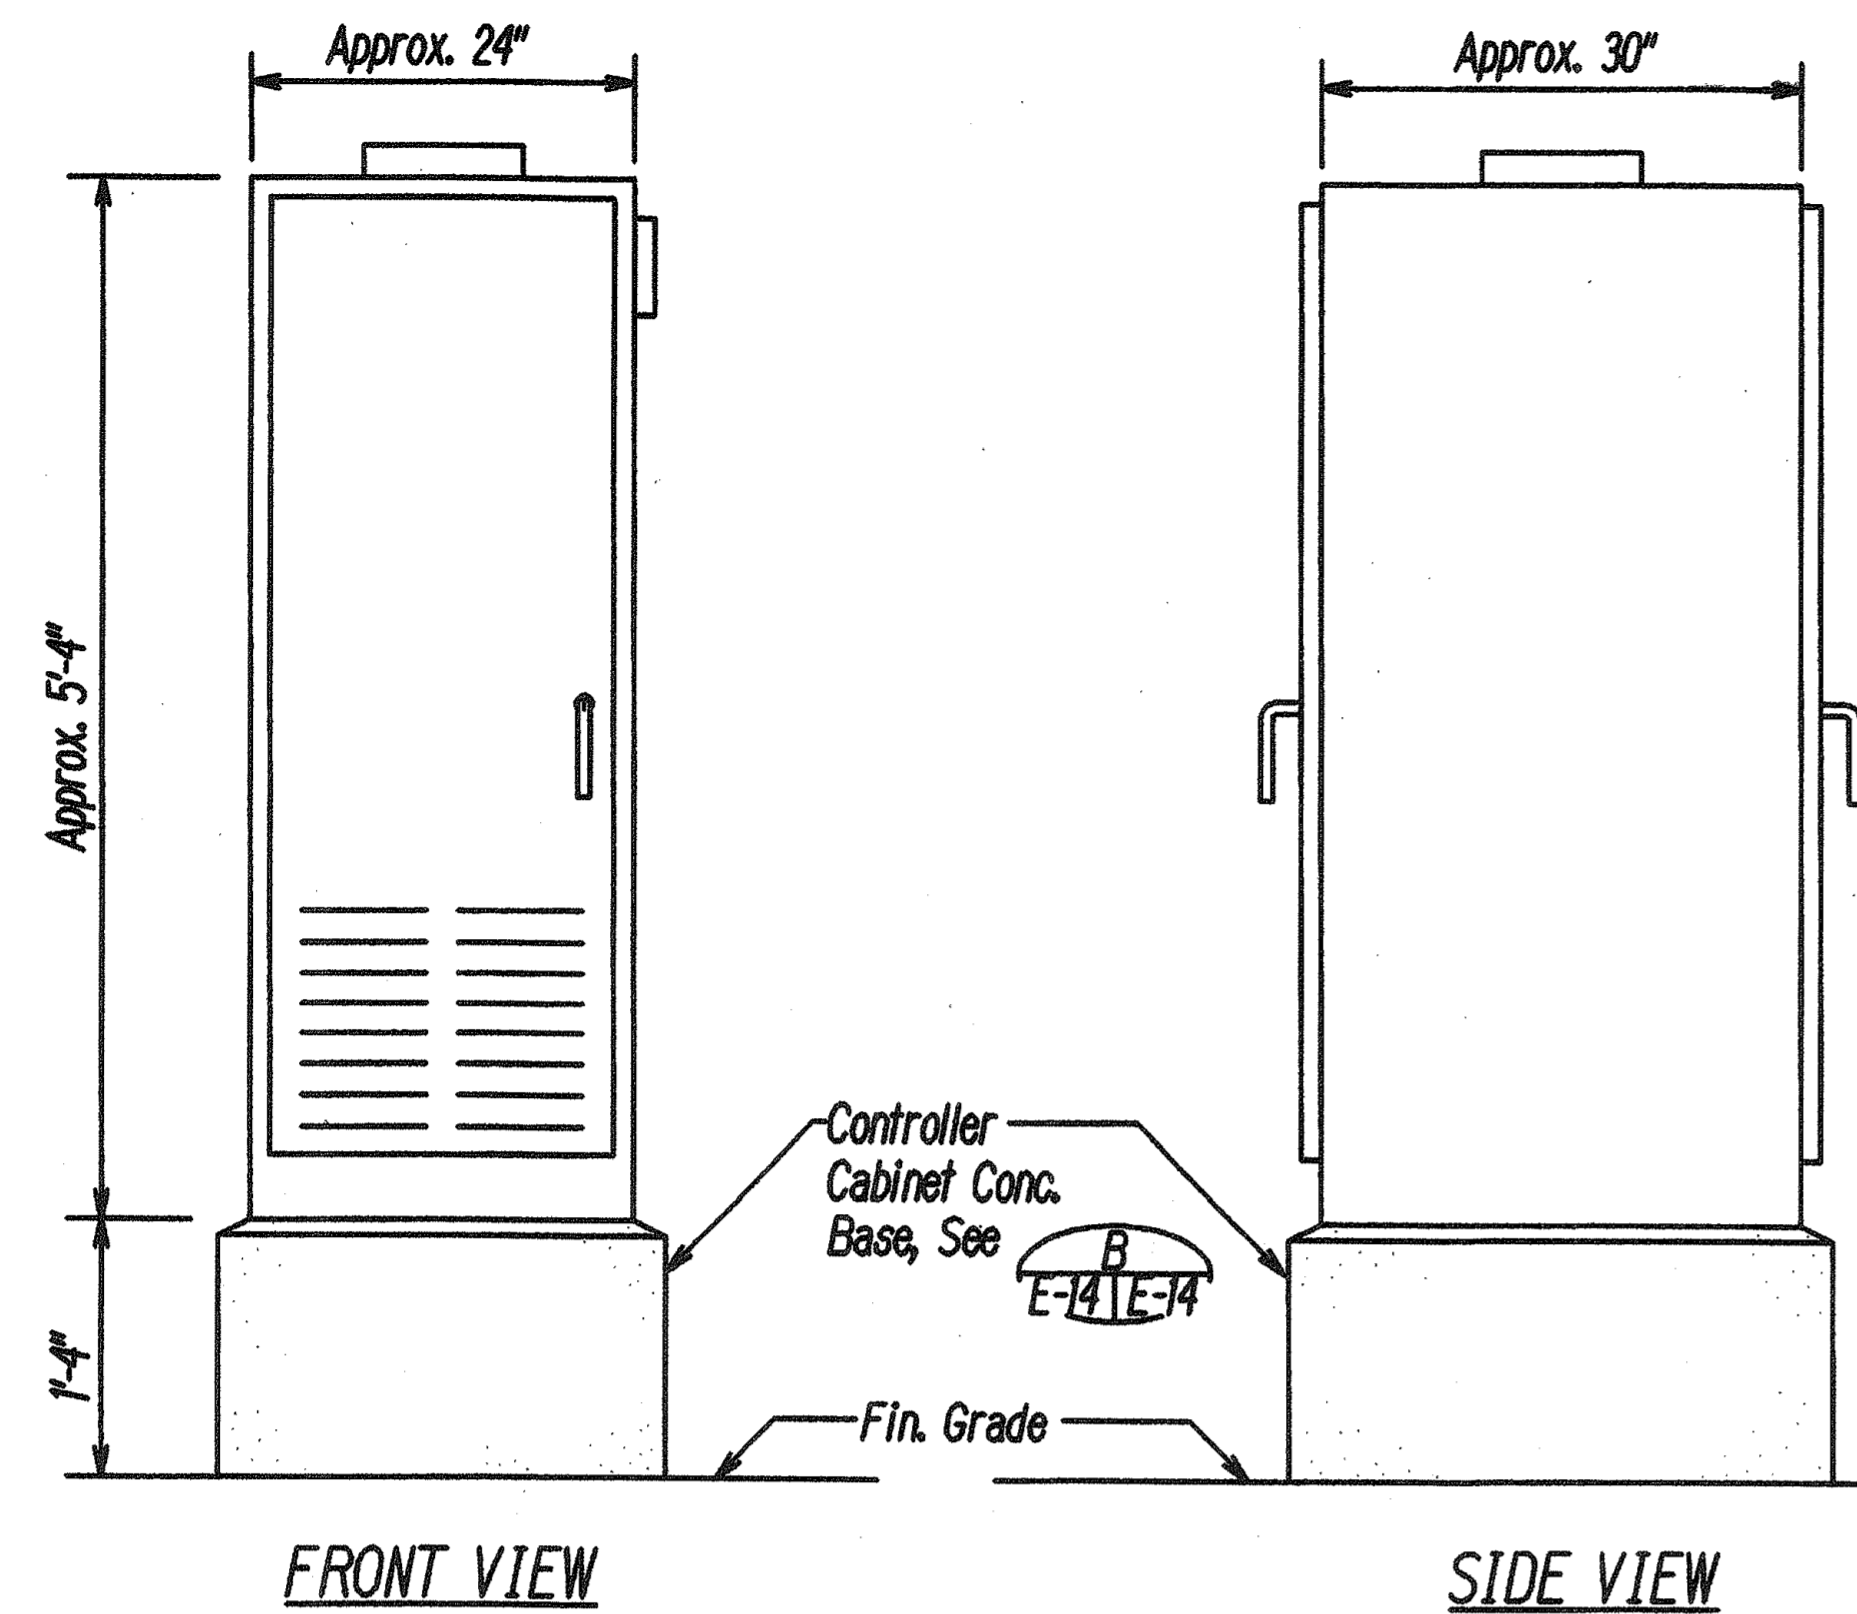


**A**  
E-14E-14  
**TYPE 332A TRAFFIC SIGNAL CONTROLLER CABINET DETAIL**  
N.T.S.

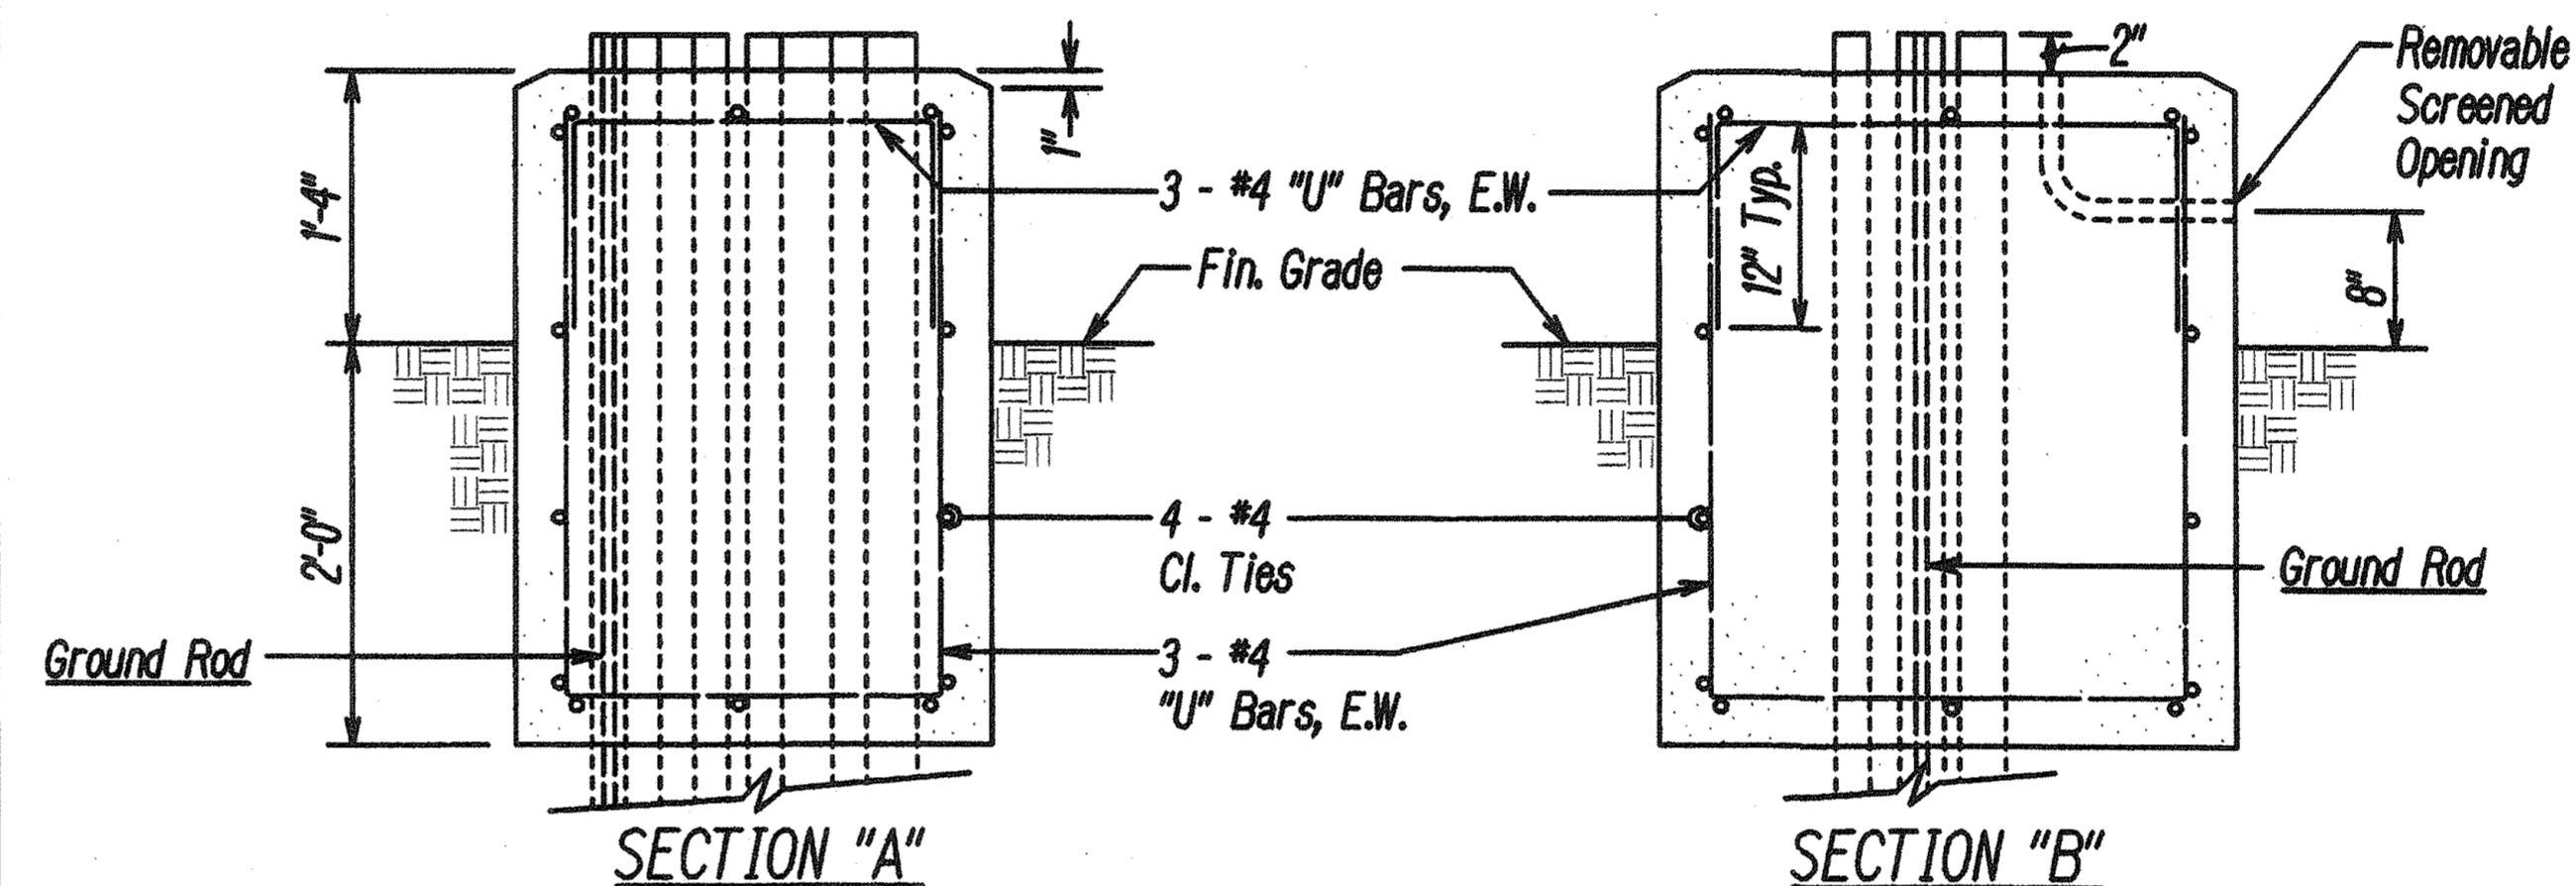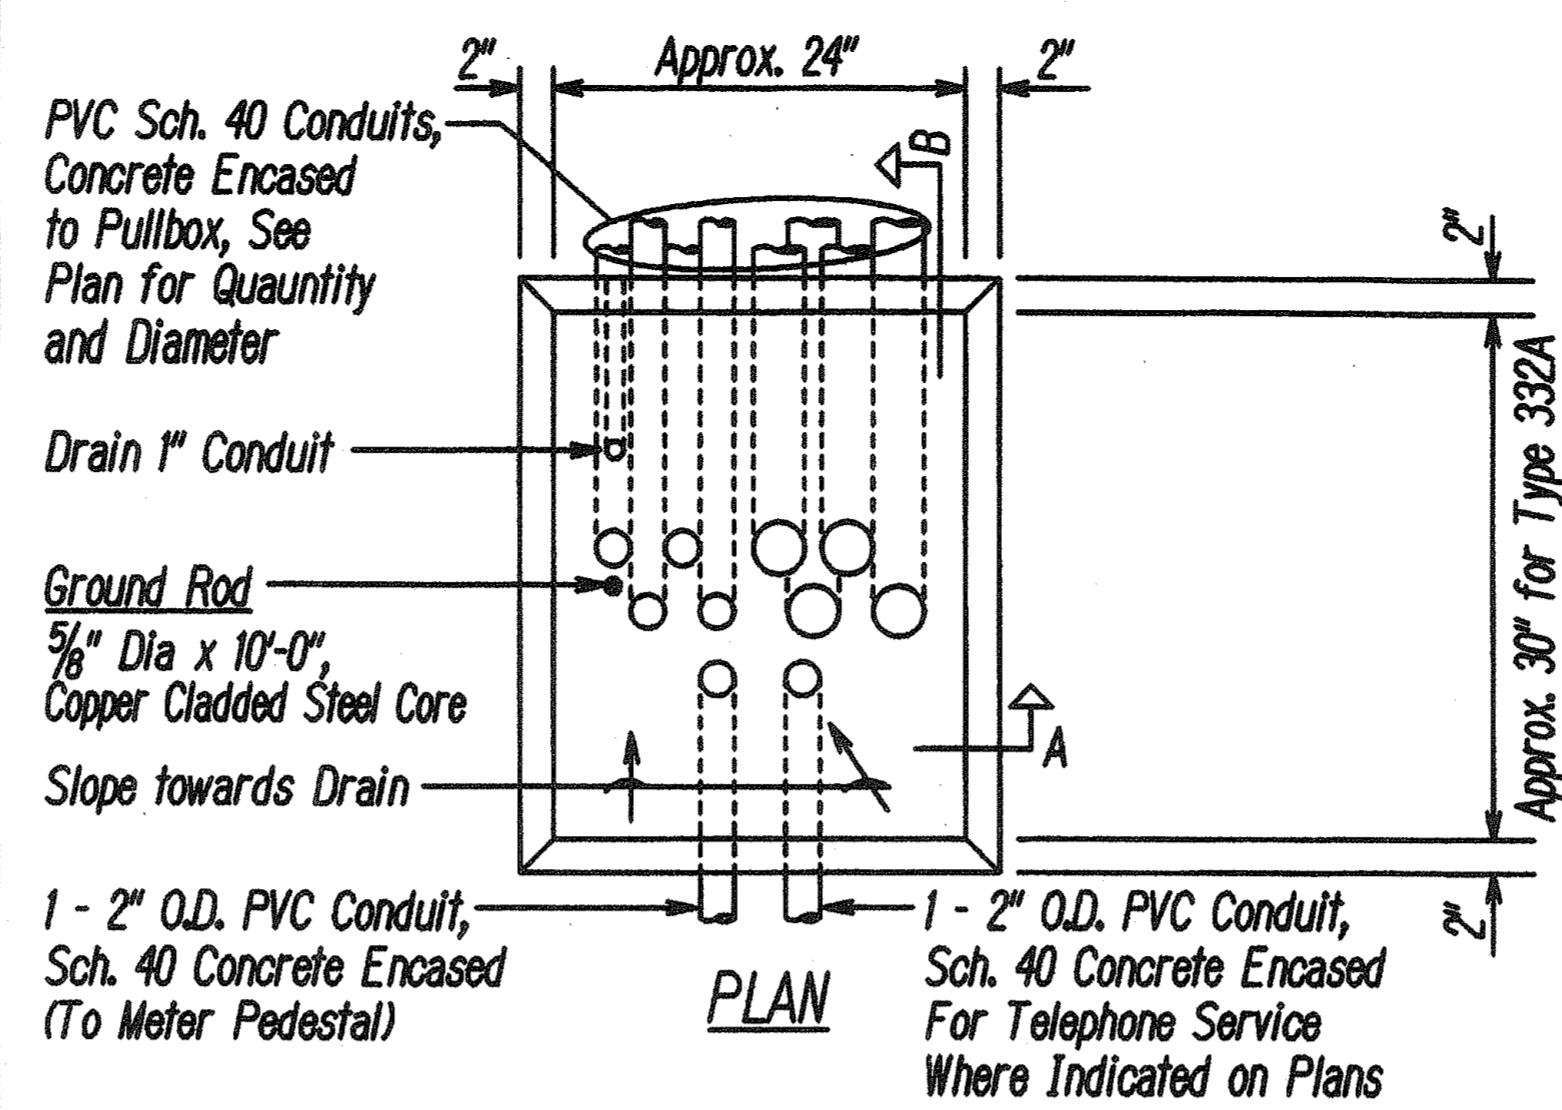

**B**  
E-14E-14  
**CONTROLLER CABINET CONCRETE BASE**  
N.T.S.

**NOTES:**


- Concrete shall be Class "B".
- Dimensions shall be Altered to Suit Controller Cabinet Actually Furnished.
- Conduit Bends and Drain are Incidental to Concrete Base.
- Refer to Cabinet Manufacturer's Specifications for Details of Anchor Bolts and Base Setting.
- All Exposed Surfaces of Concrete Base shall be Given a Class 2, Rubbed Finish.

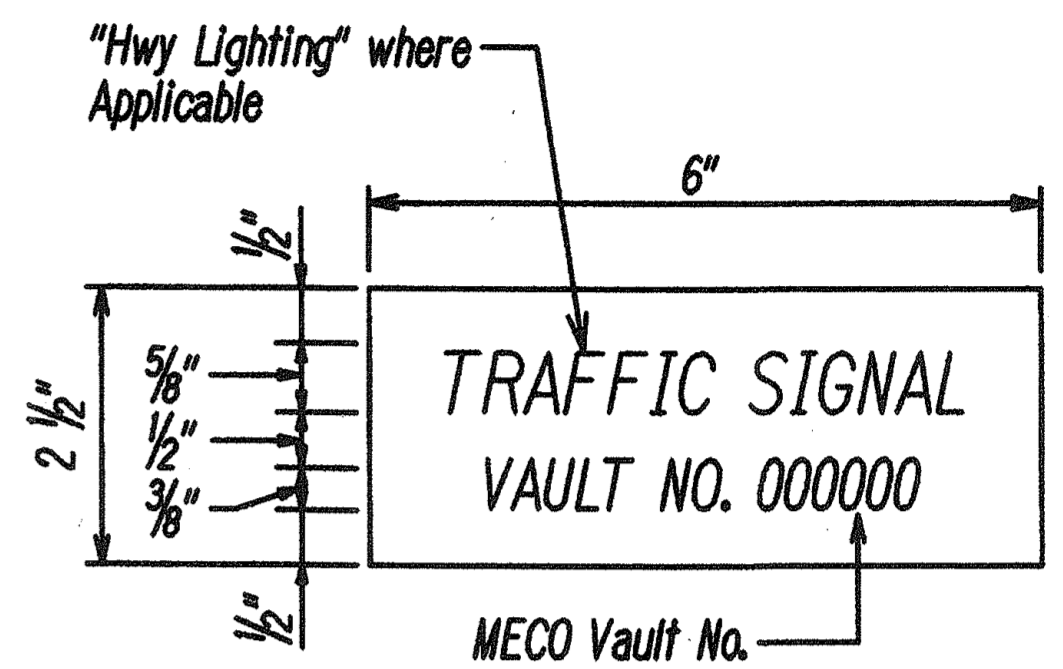

**NOTES:**

- Use 3-Ply Laminated Flexible Plastic, Black-White-Black Thickness: Black Cap Sheet - 0.010", White Base Sheet - 0.052", Black Base Sheet - 0.010".
- Attach to Meter Socket Using Scotch 3M Brand Very High Bond (VHB) Double Coated Acrylic Foam Tape or Equivalent.
- Letters/Numbers shall be 1/16" Stroke, (White in Color).
- Letters/Numbers Area Inscribed by Cutting Through "Black Cap Sheet" to Expose White Letters/Numbers.

**C**  
E-13E-14  
**METER I.D. TAG DETAIL**  
N.T.S.

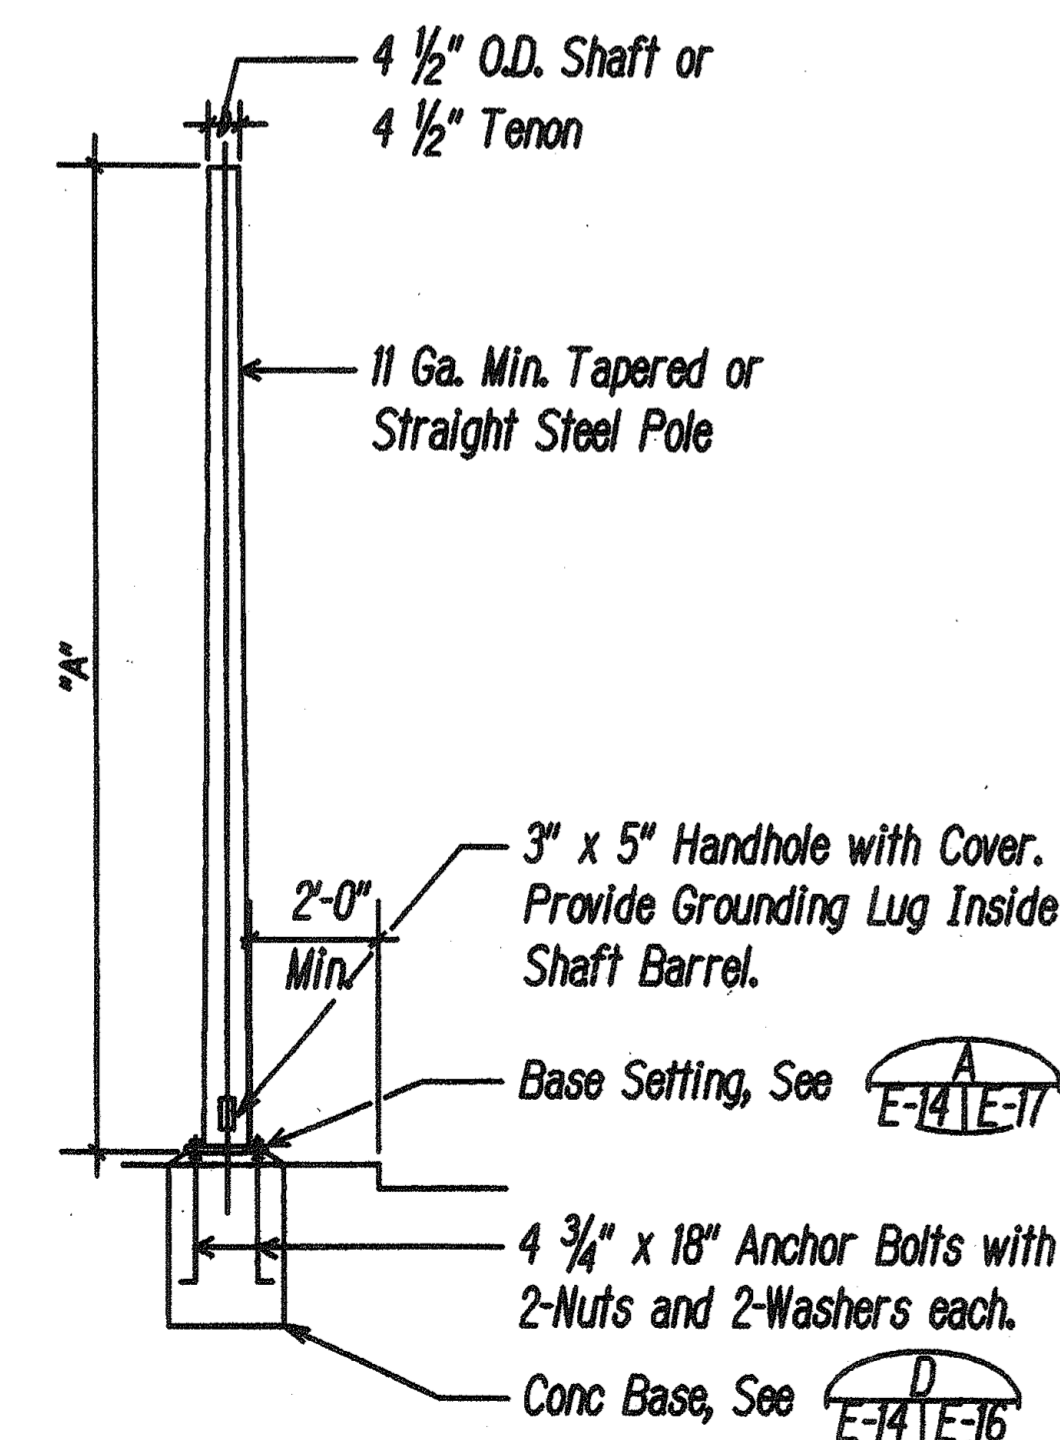



**D**  
E-1E-14  
**TYPE I STANDARD AND PEDESTAL INSTALLATION**  
N.T.S.

**Notes:**

- Standard shall be Designed in Accordance with AASHTO "Standard Specification for Structural Supports for Highway Signs, Luminaires and Traffic Signals", Dated 2001. Traffic Signal Standard and Arm Assembly shall Withstand 105 M.P.H. Sustained Winds with 1.3 Gust Factor without Permanent Deformation.
- Submit Shop Drawings for Approval.

TYPE OF STANDARD	"A"
TYPE I-13	13
TYPE I-10	10
TYPE I-8	8
TYPE I-3	3

Type  
Typical Designation: I-7  
Height "A"

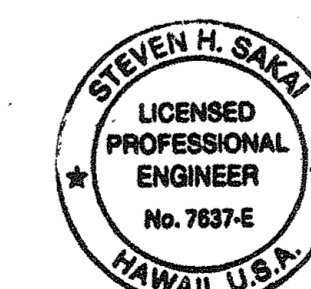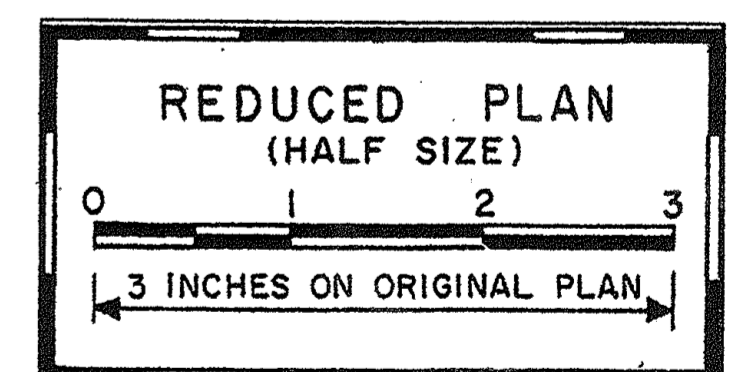


THIS WORK WAS PREPARED BY ME  
OR UNDER MY SUPERVISION  
*Steven H. Sakai*

STATE OF HAWAII  
DEPARTMENT OF TRANSPORTATION  
HIGHWAYS DIVISION  
**TRAFFIC SIGNAL DETAILS II**

TRAFFIC OPERATIONAL IMPROVEMENTS  
AT VARIOUS LOCATIONS  
PUUNENE AVENUE AND  
KAAHUMANU AVENUE


Scale: AS NOTED Date: April 2002  
SHEET No. E-14 OF 22 SHEETS

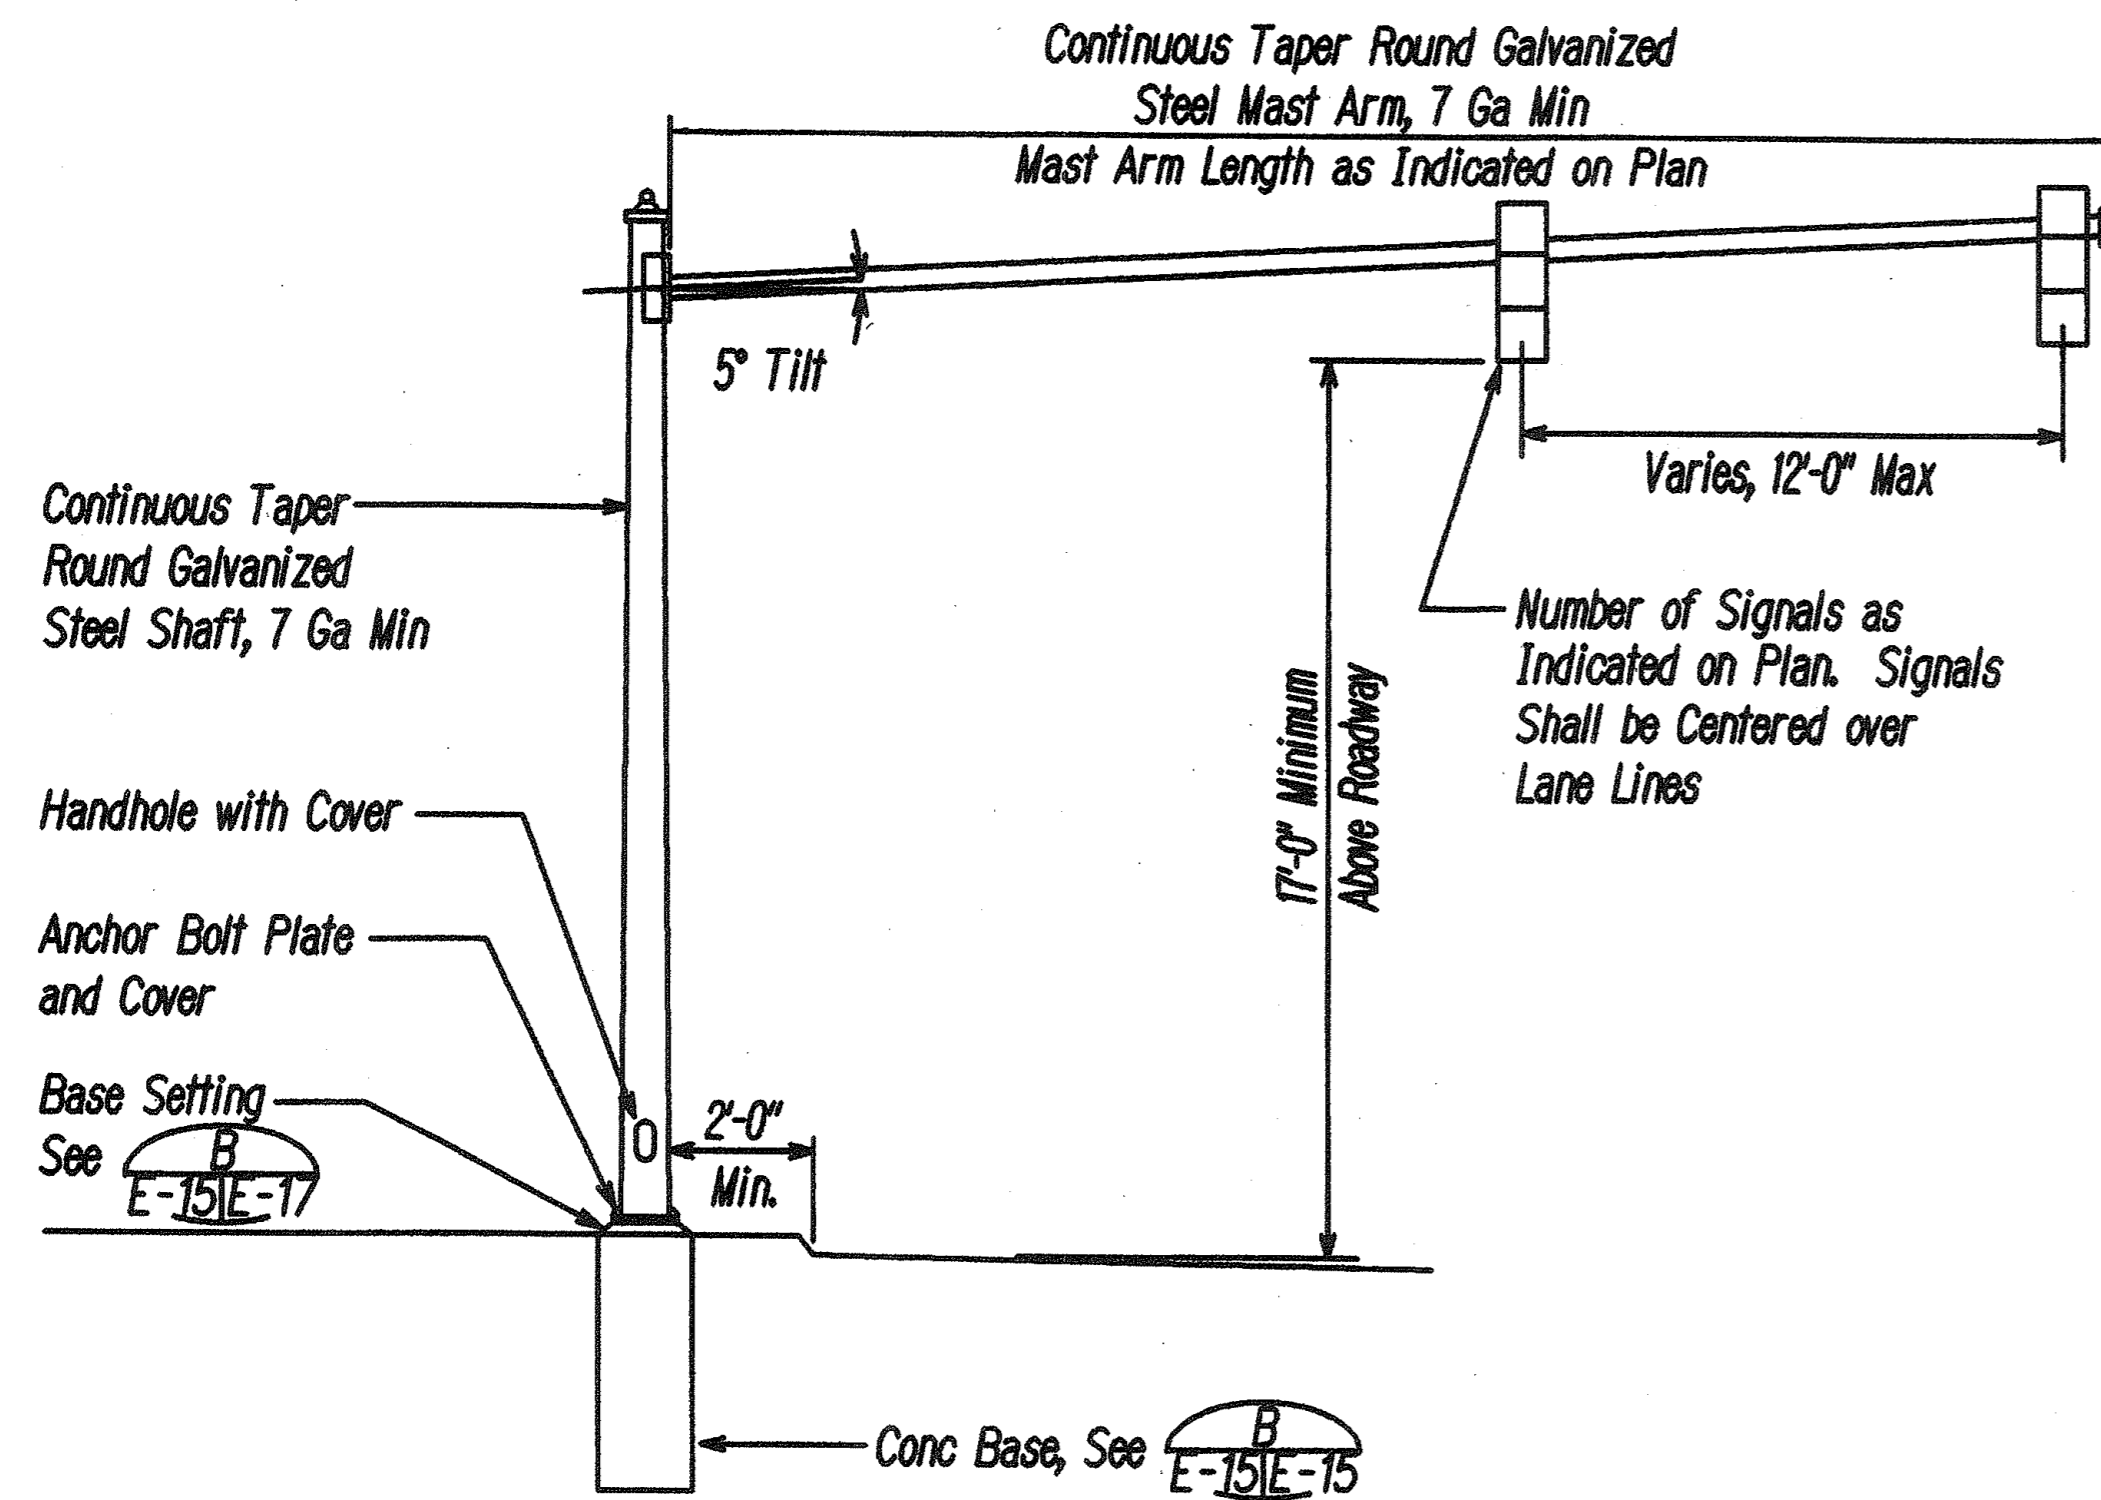


ELEVATION

Notes:


- Standard shall be Designed in Accordance with AASHTO "Standard Specifications for Structural Supports for Highway Signs, Luminaires and Traffic Signals", Dated 2001. Traffic Signal Standard and Arm Assembly shall Withstand 105 M.P.H. Sustained Winds with 1.3 Gust Factor without Permanent Deformation.
- Size, Length and Diameter of Anchor Bolts shall be as Recommended by the Manufacturer. Contractor shall Submit Catalog Cuts to the Engineer for Approval.
- Handhole shall be Opposite of Traffic Flow.

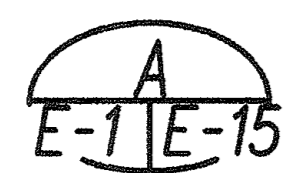


TRAFFIC SIGNAL TYPE II STANDARD  
NOT TO SCALE

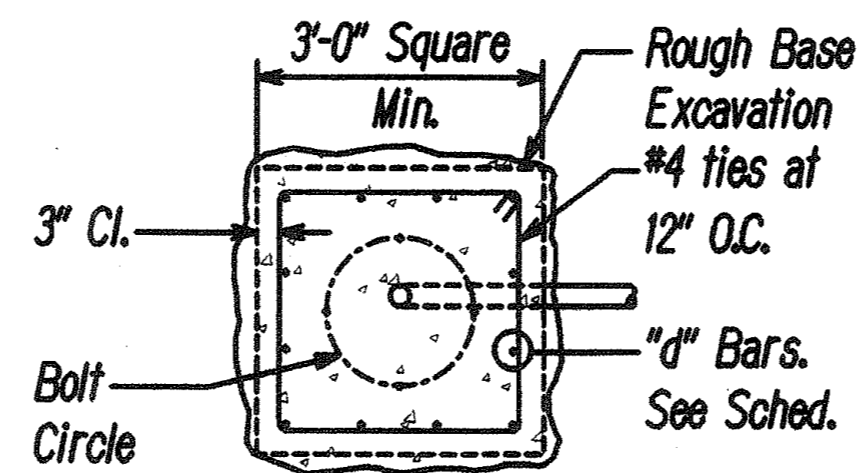

PLAN - SECTION

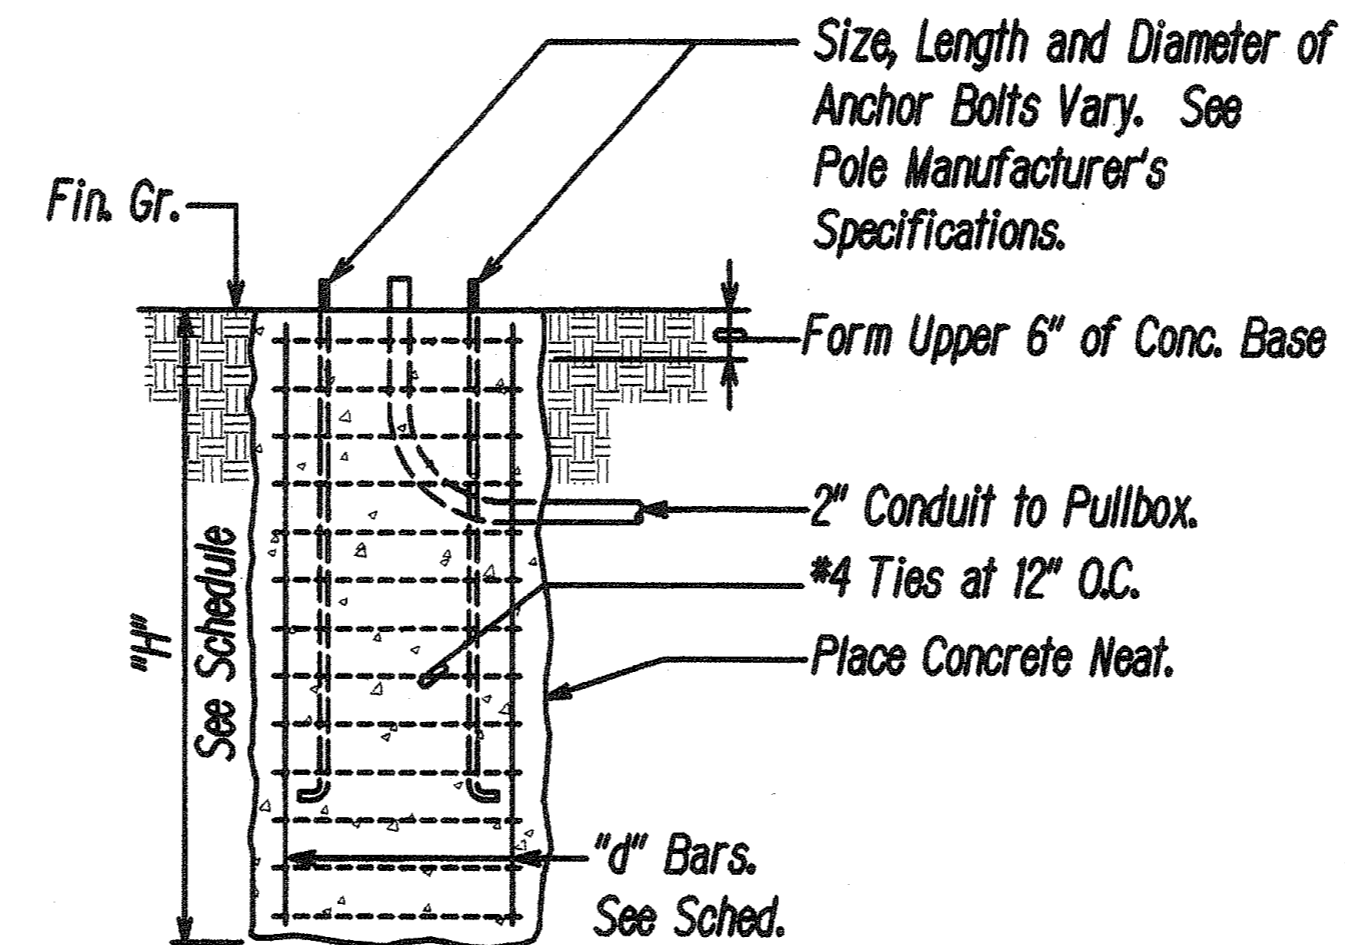



VERTICAL SECTION  
Type C

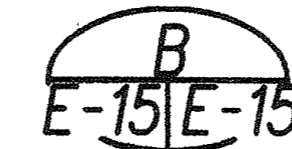

CONCRETE BASE DETAILS  
NOT TO SCALE

CONCRETE BASE SCHEDULE

TYPE OF STANDARD	TYPE OF BASE	"H"	"d" BARS
II - 18	C	5' - 0"	12 - #6
II - 20	C	5' - 6"	12 - #6
II - 25	C	6' - 0"	12 - #6
II - 30	C	6' - 6"	12 - #8
II - 35	C	7' - 0"	12 - #8
II - 40	C	8' - 0"	12 - #8

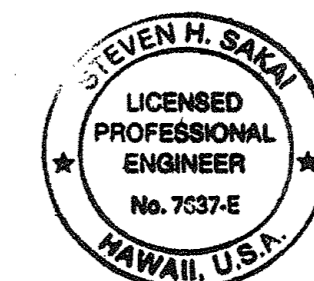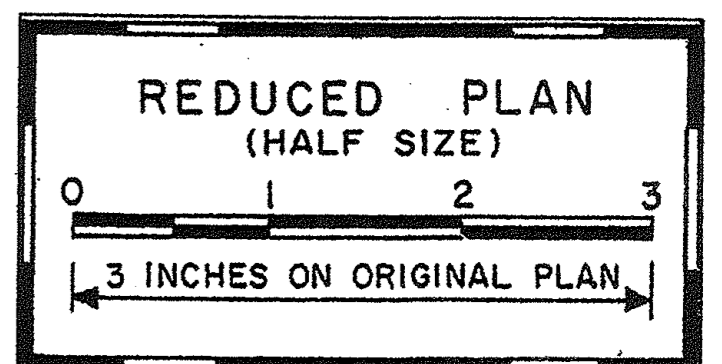

THIS WORK WAS PREPARED BY ME  
OR UNDER MY SUPERVISION  
*Steven H. Sakai*

STATE OF HAWAII  
DEPARTMENT OF TRANSPORTATION  
HIGHWAYS DIVISION  
**TRAFFIC SIGNAL DETAILS III**

TRAFFIC OPERATIONAL IMPROVEMENTS  
AT VARIOUS LOCATIONS  
PUUNENE AVENUE AND  
KAAHUMANU AVENUE

Scale: AS NOTED Date: April 2002  
SHEET No. E-15 OF 22 SHEETS

15'-0"

250W HPS Cutoff Luminaire Furnished by MECO, Installed by Contractor. Pickup Luminaire at MECO Baseyard. Coordinate with MECO

Continuous Taper Round Galvanized Steel Shaft

Mast Arm Length as Indicated on Plan

5° Tilt

30'-0" Nom.

17'-0" Minimum Above Roadway

Varies, 12'-0" Max

Number of Signals as Indicated on Plan. Signals Shall be Centered over Lane Lines

1" Galvanized Steel Conduit or Traffic Signal Cables. Install Inside Type III Standard Shaft and Tackweld Top and Bottom Securely.

Handhole with Cover

Anchor Bolt Plate and Cover


2'-0" Min.

Base Setting, See E-16 E-17


Conc Base, See E-16 E-17

TRAFFIC SIGNAL TYPE III STANDARD  
NOT TO SCALE



 CONCRETE BASE PLAN  
NOT TO SCALE

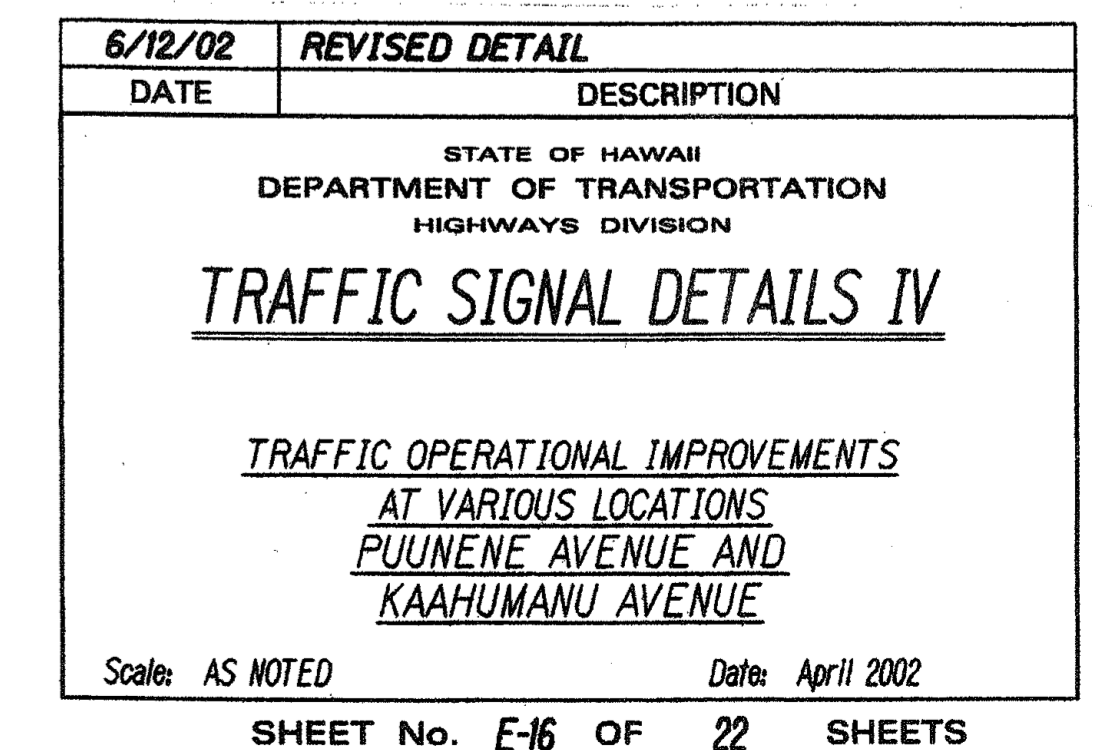

FED. ROAD DIST. NO.	STATE	PROJ. NO.	FISCAL YEAR	SHEET NO.	TOTAL SHEETS
HAWAII	HAW.	HWY-M-04-00	2002	26	63


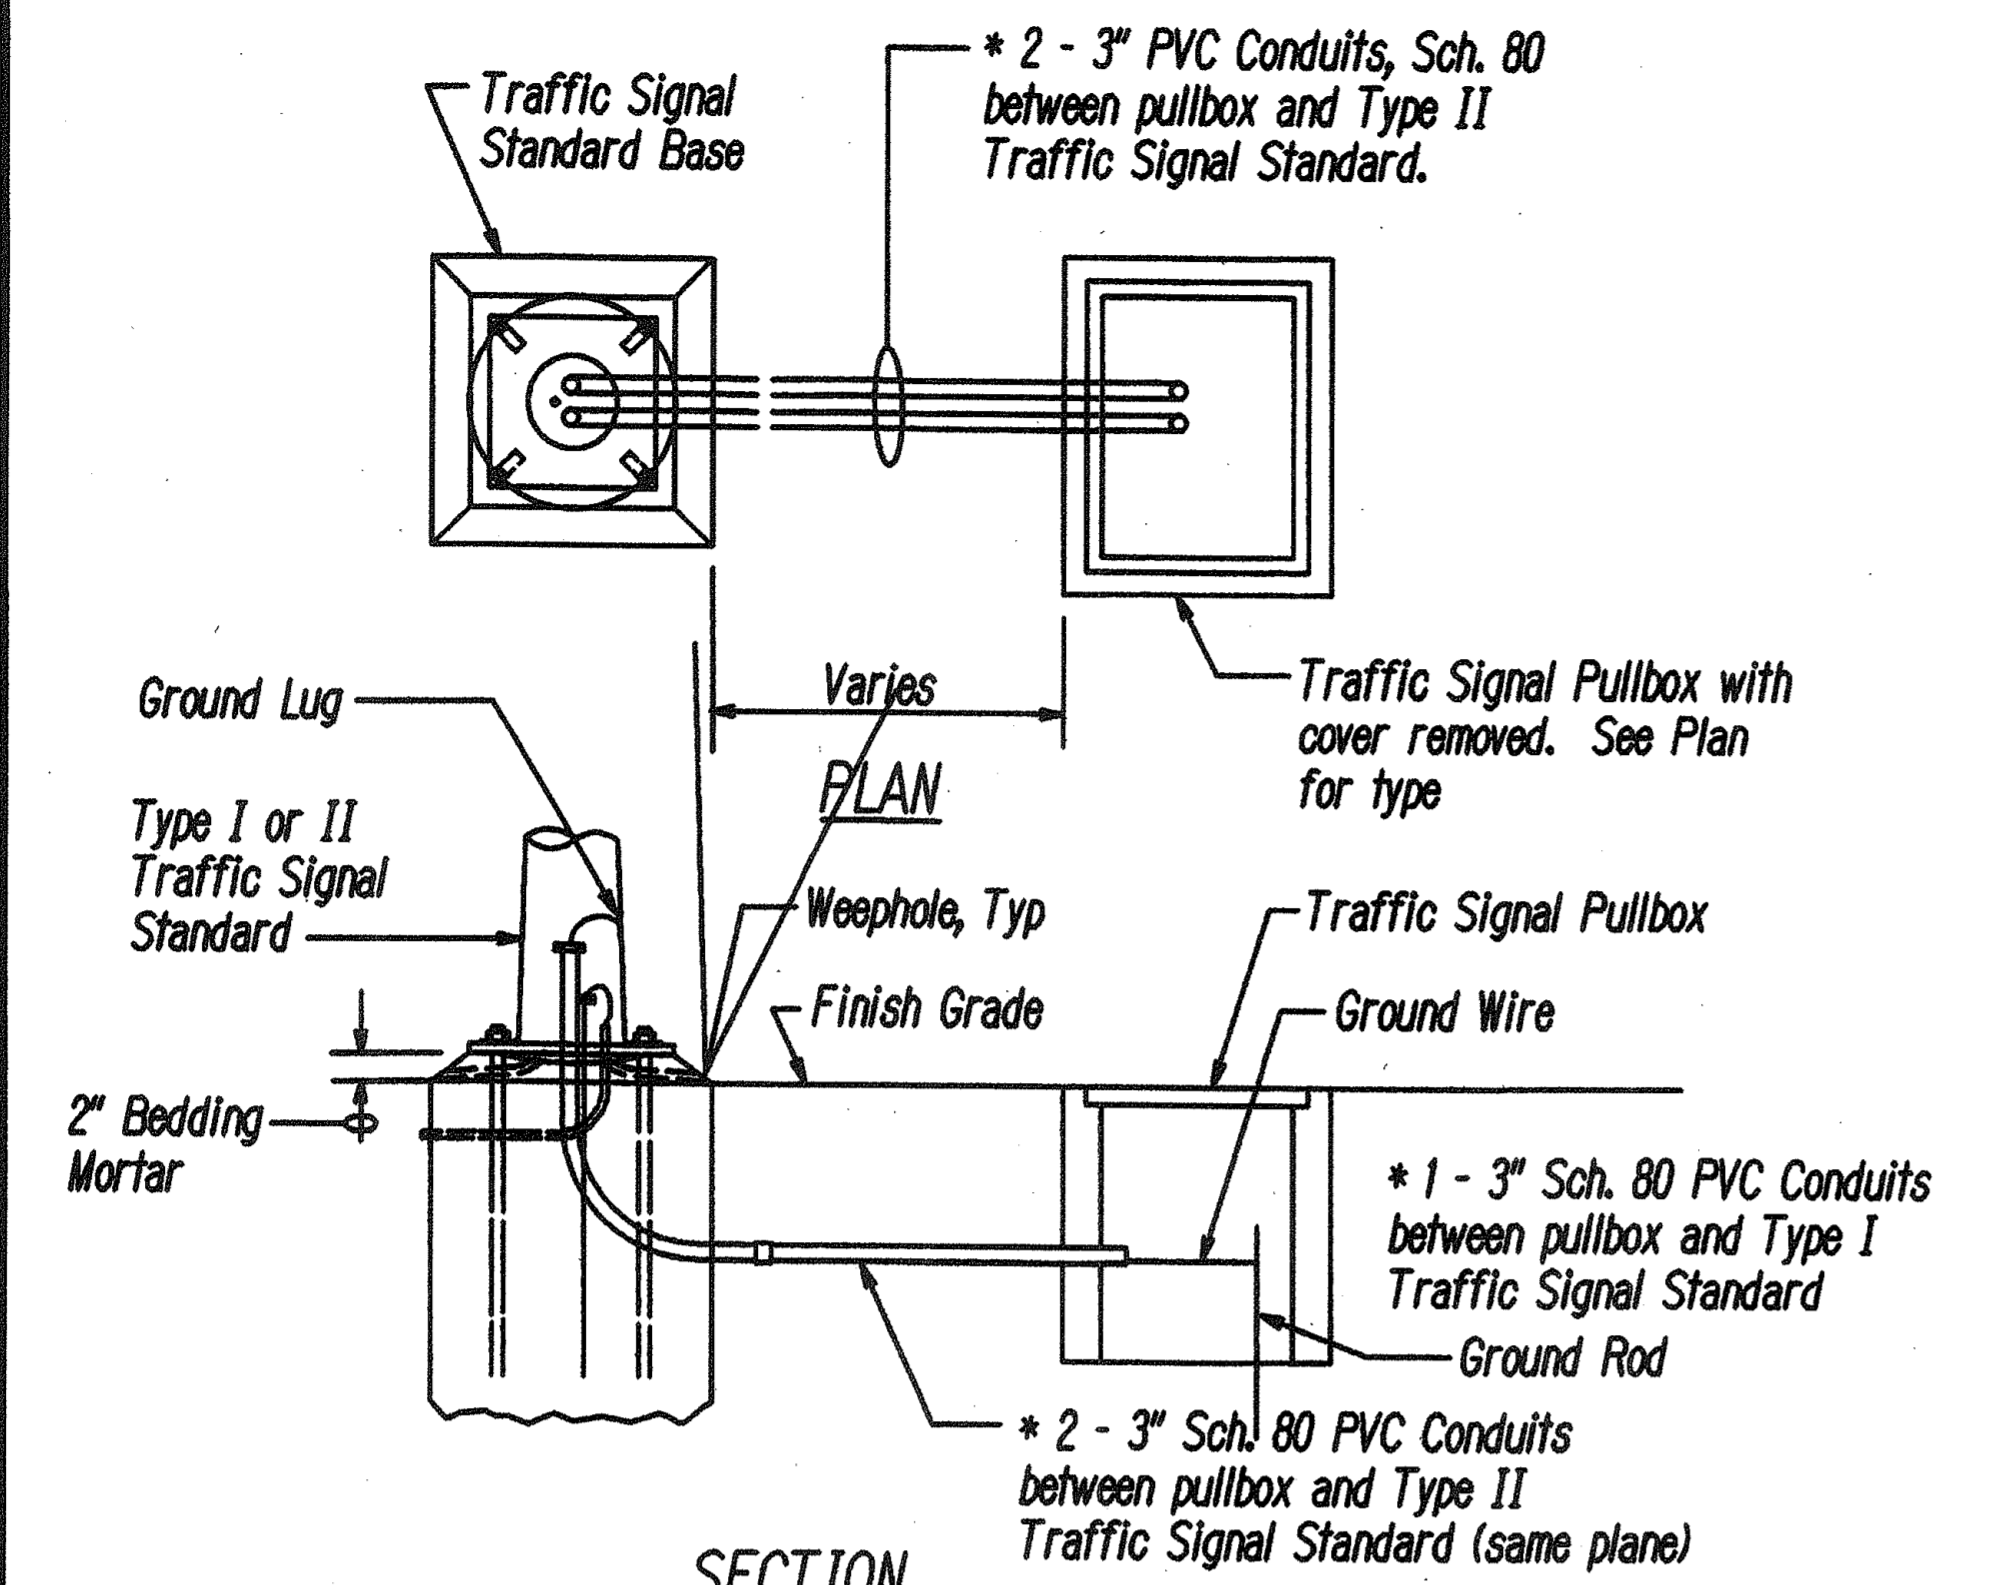


SECTION  
CONDUIT FOR TYPE I OR II TRAFFIC SIGNAL STD.

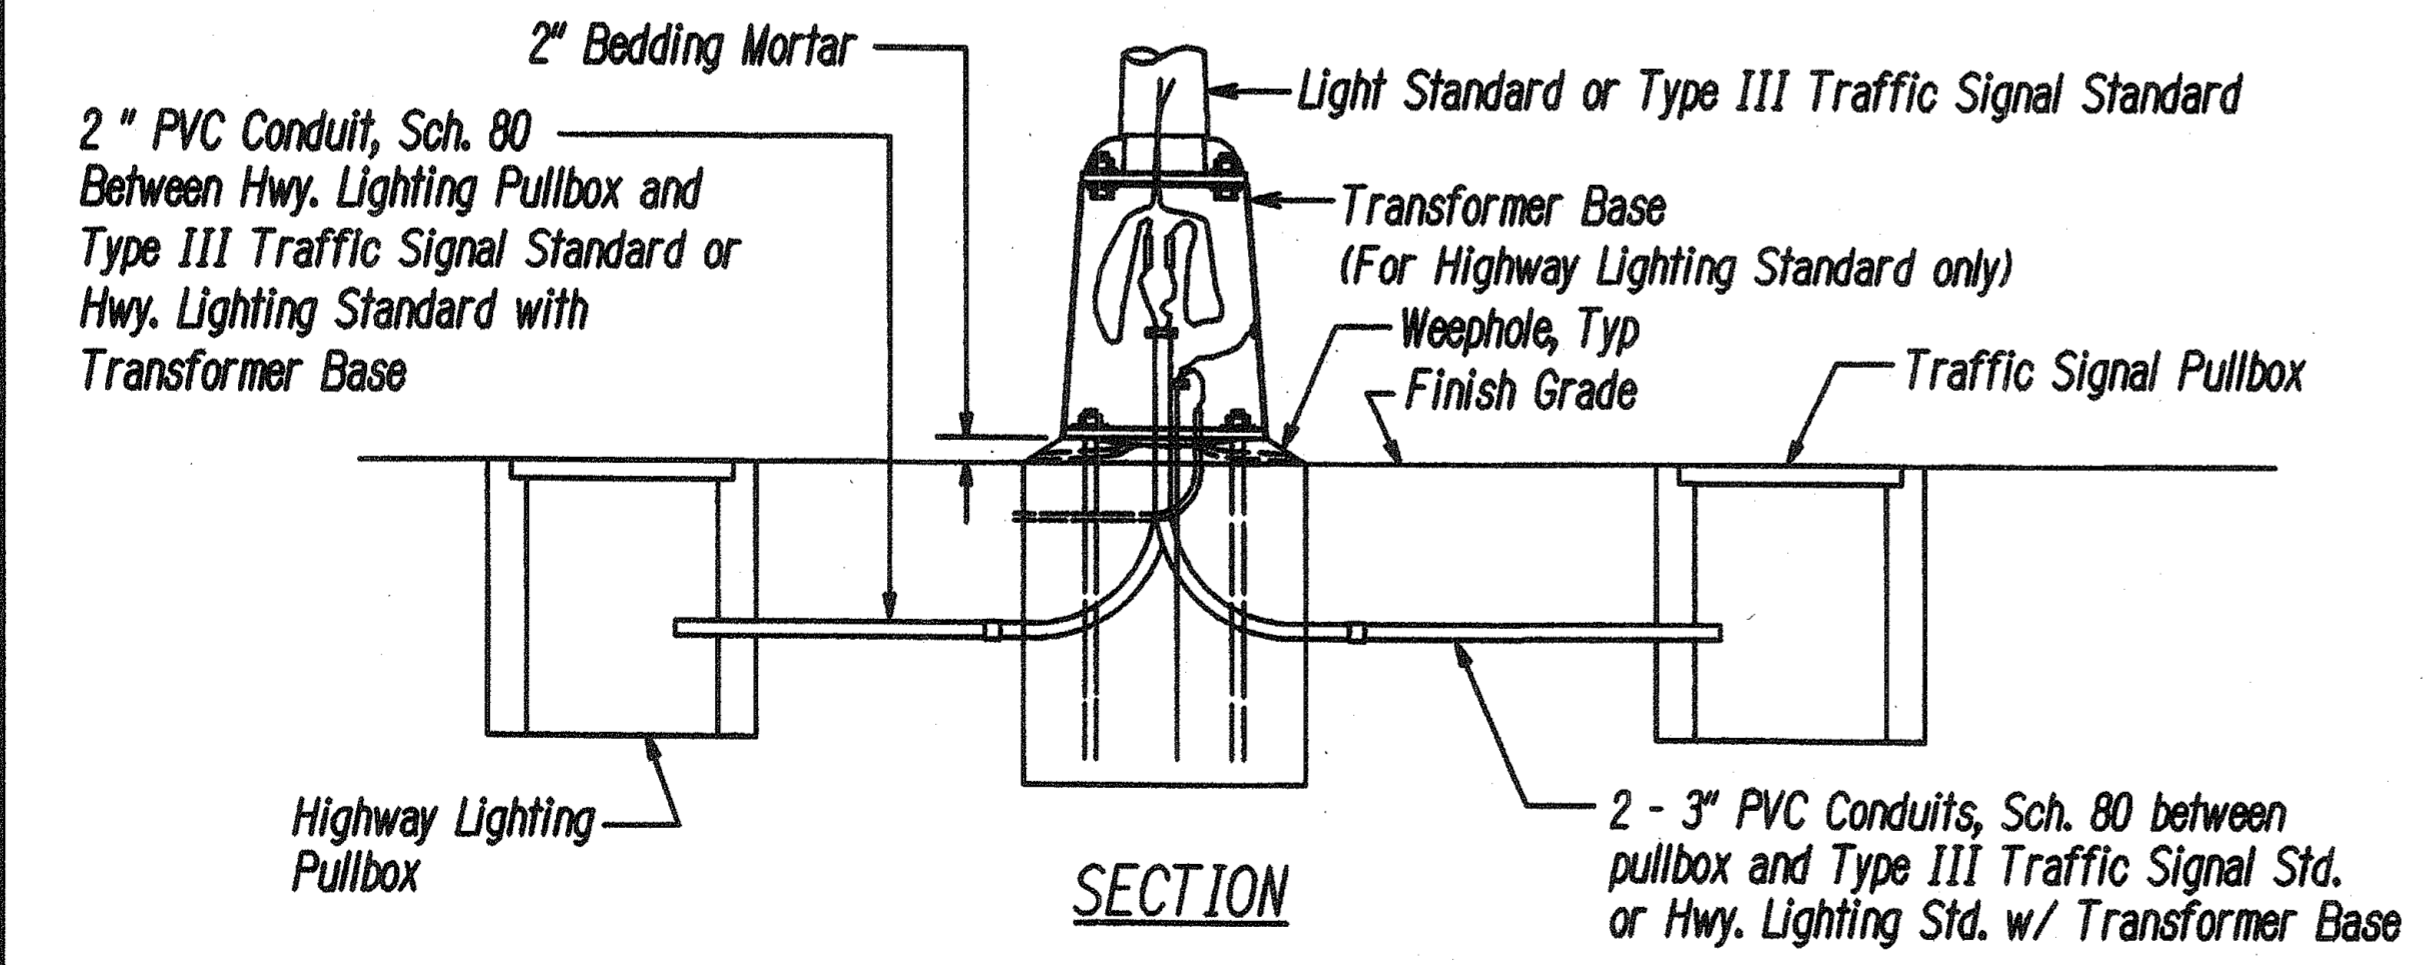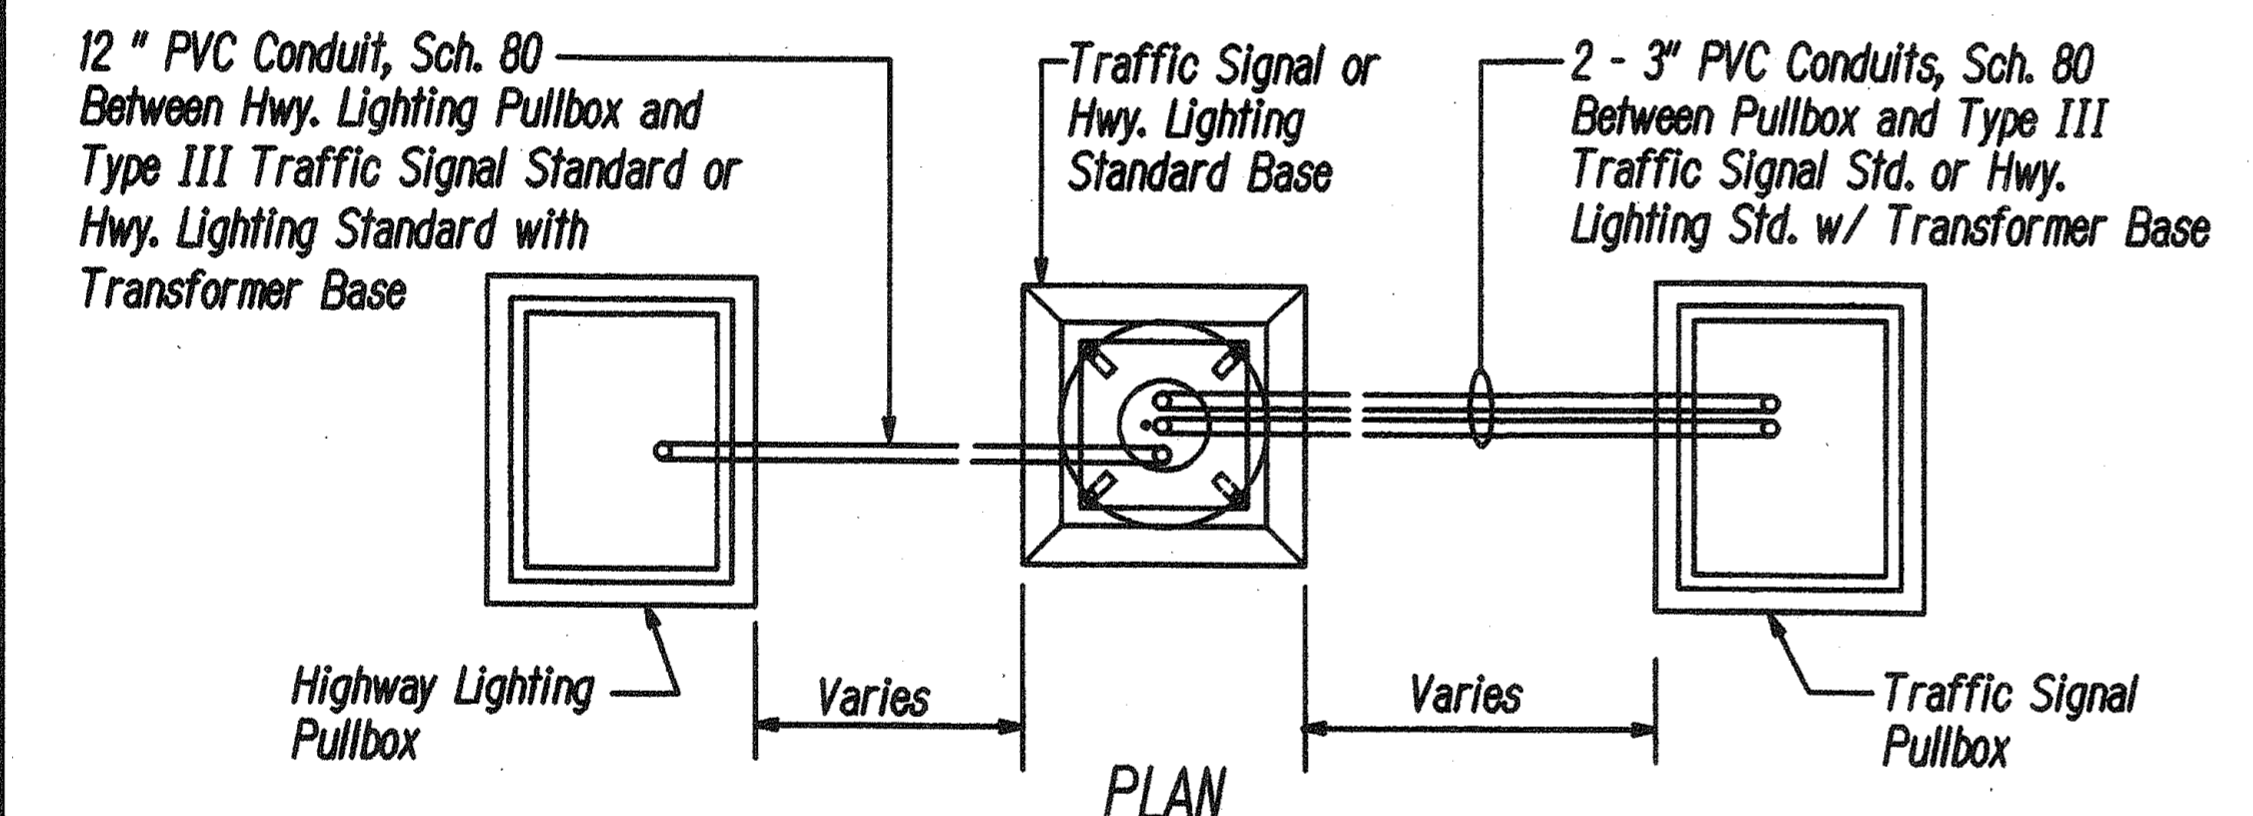


SECTION  
CONDUIT DETAILS FOR TRAFFIC SIGNAL/HWY. LIGHTING STANDARD

E-14, E-15 E-16 E-17 Not to Scale

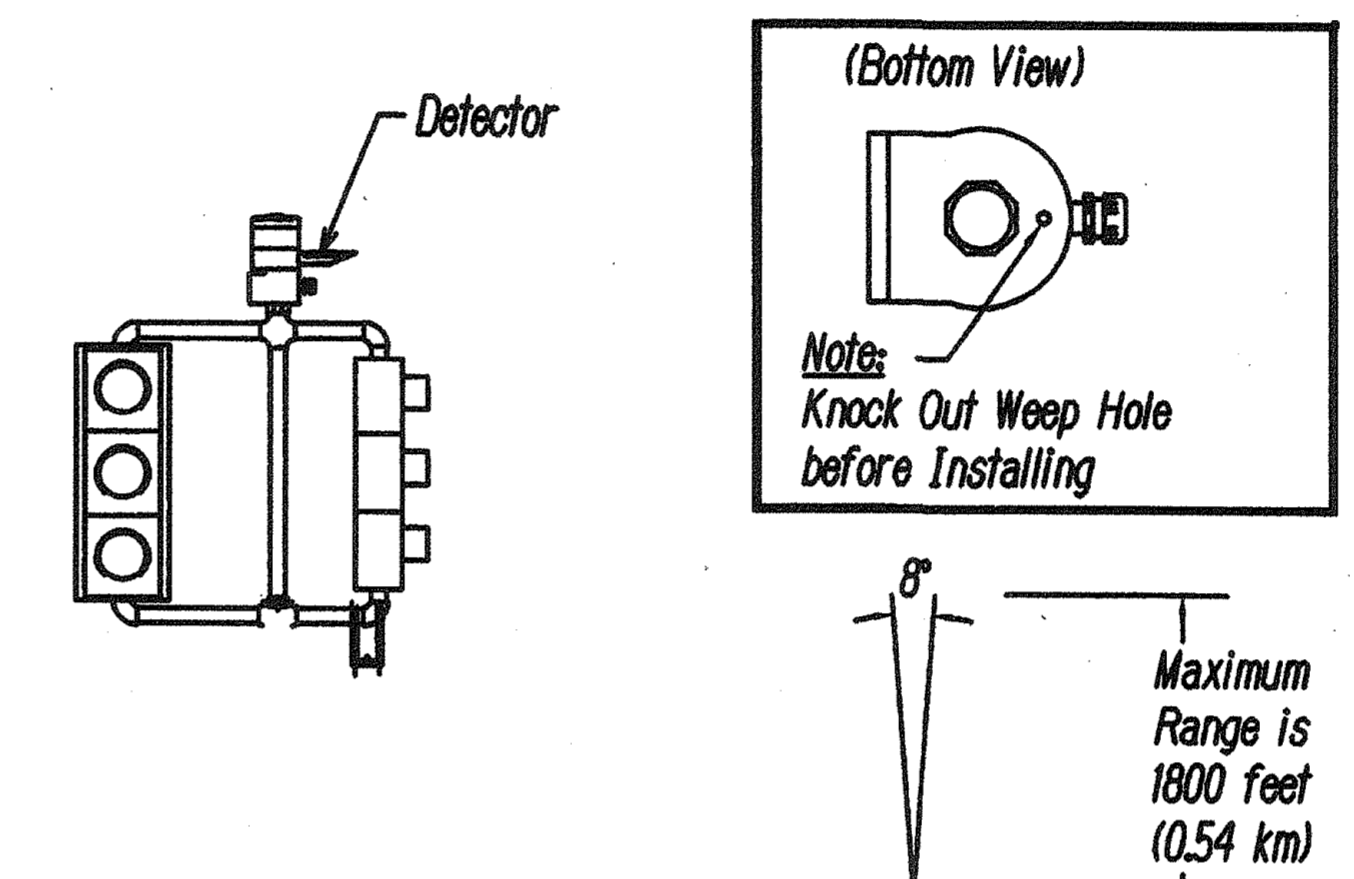
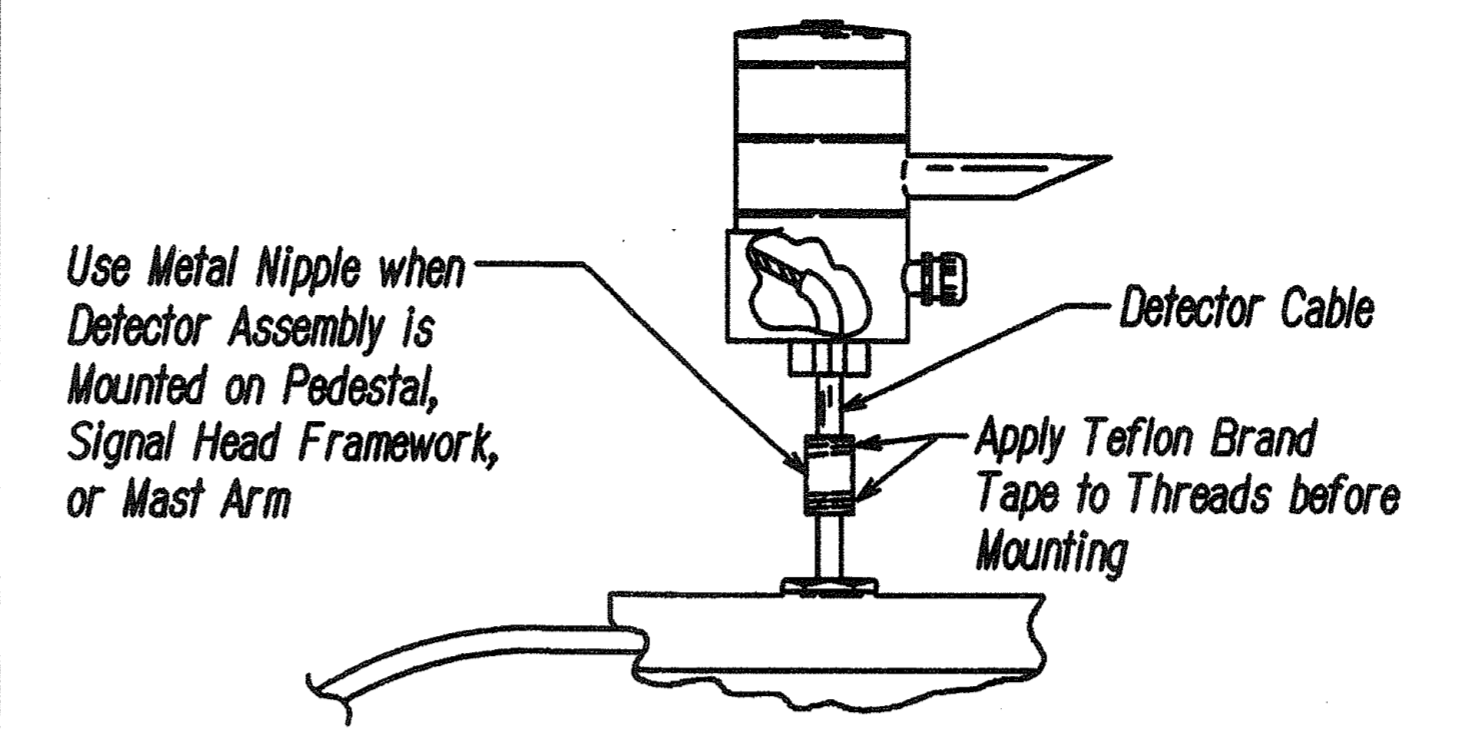


TYPICAL PEDESTAL/TYPE T.S.S. MOUNTING OF EVP DETECTOR

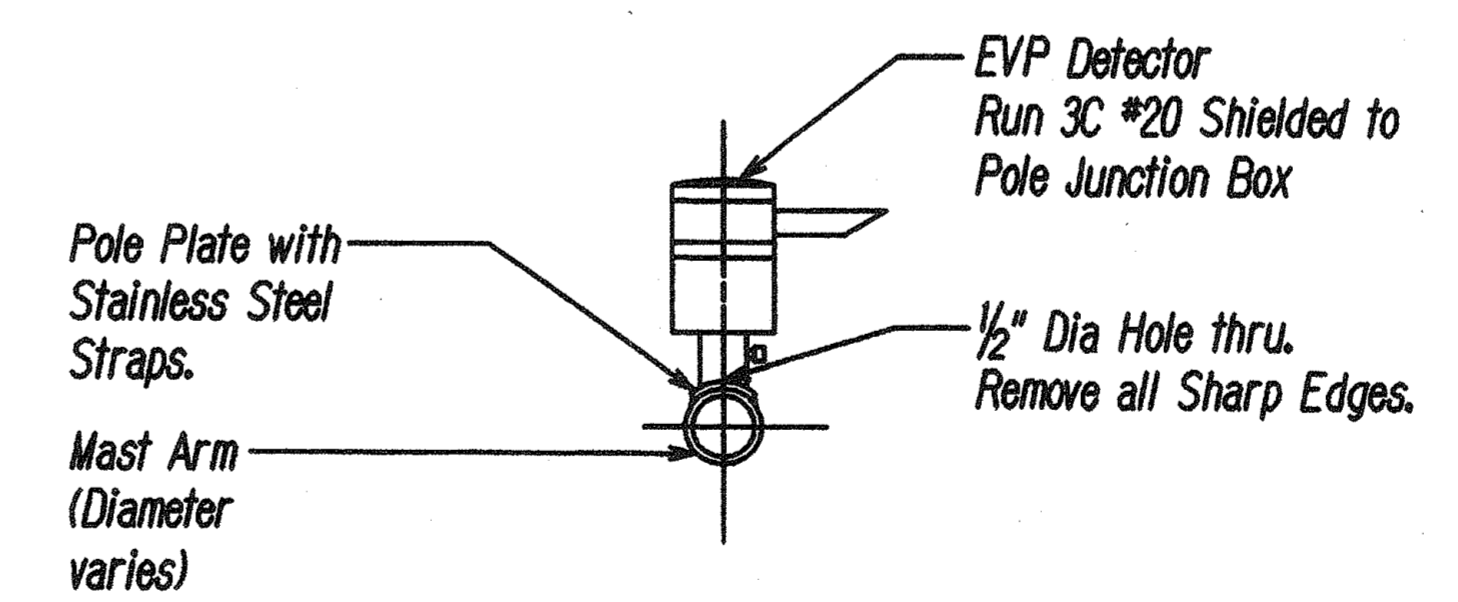

TYPICAL MAST ARM MOUNTING OF EVP DETECTOR

B  
E-1 E-17 EVP DETECTOR MOUNTING  
Not to Scale

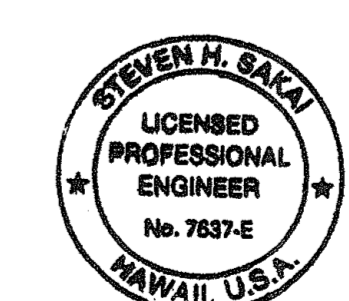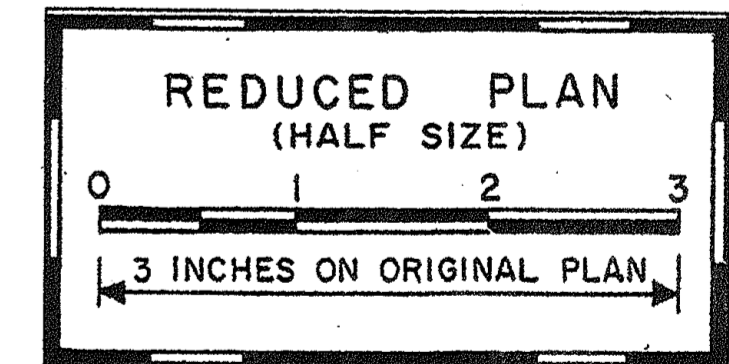

THIS WORK WAS PREPARED BY ME  
OR UNDER MY SUPERVISION  
Date: April 2002

STATE OF HAWAII  
DEPARTMENT OF TRANSPORTATION  
HIGHWAYS DIVISION

**TRAFFIC SIGNAL DETAILS V**

TRAFFIC OPERATIONAL IMPROVEMENTS  
AT VARIOUS LOCATIONS  
PUUNENE AVENUE AND  
KAAHUMANU AVENUE


Scale: AS NOTED Date: April 2002  
SHEET No. E-17 OF 22 SHEETS






*Termi-Mesh is a Physical Barrier System that Prevents Ground Termites from Attacking Wood Poles Below Grade. Careful Installation is Essential to Insure Effective Termite Protection.*

*Termi-Mesh is a Preformed Stainless Steel Mesh Sock that is Installed Over the Butt of the Pole. The Sock is Tightly Secured to the Pole with all Excess Mesh Folded Over to Prevent Termites from Penetrating Through Voids or Checks in the Wood. The Sock Covers The Butt of the Pole up to 6 Inches Above Grade to Prevent Termites From Forming Mud Tunnels Over The Barrier.*

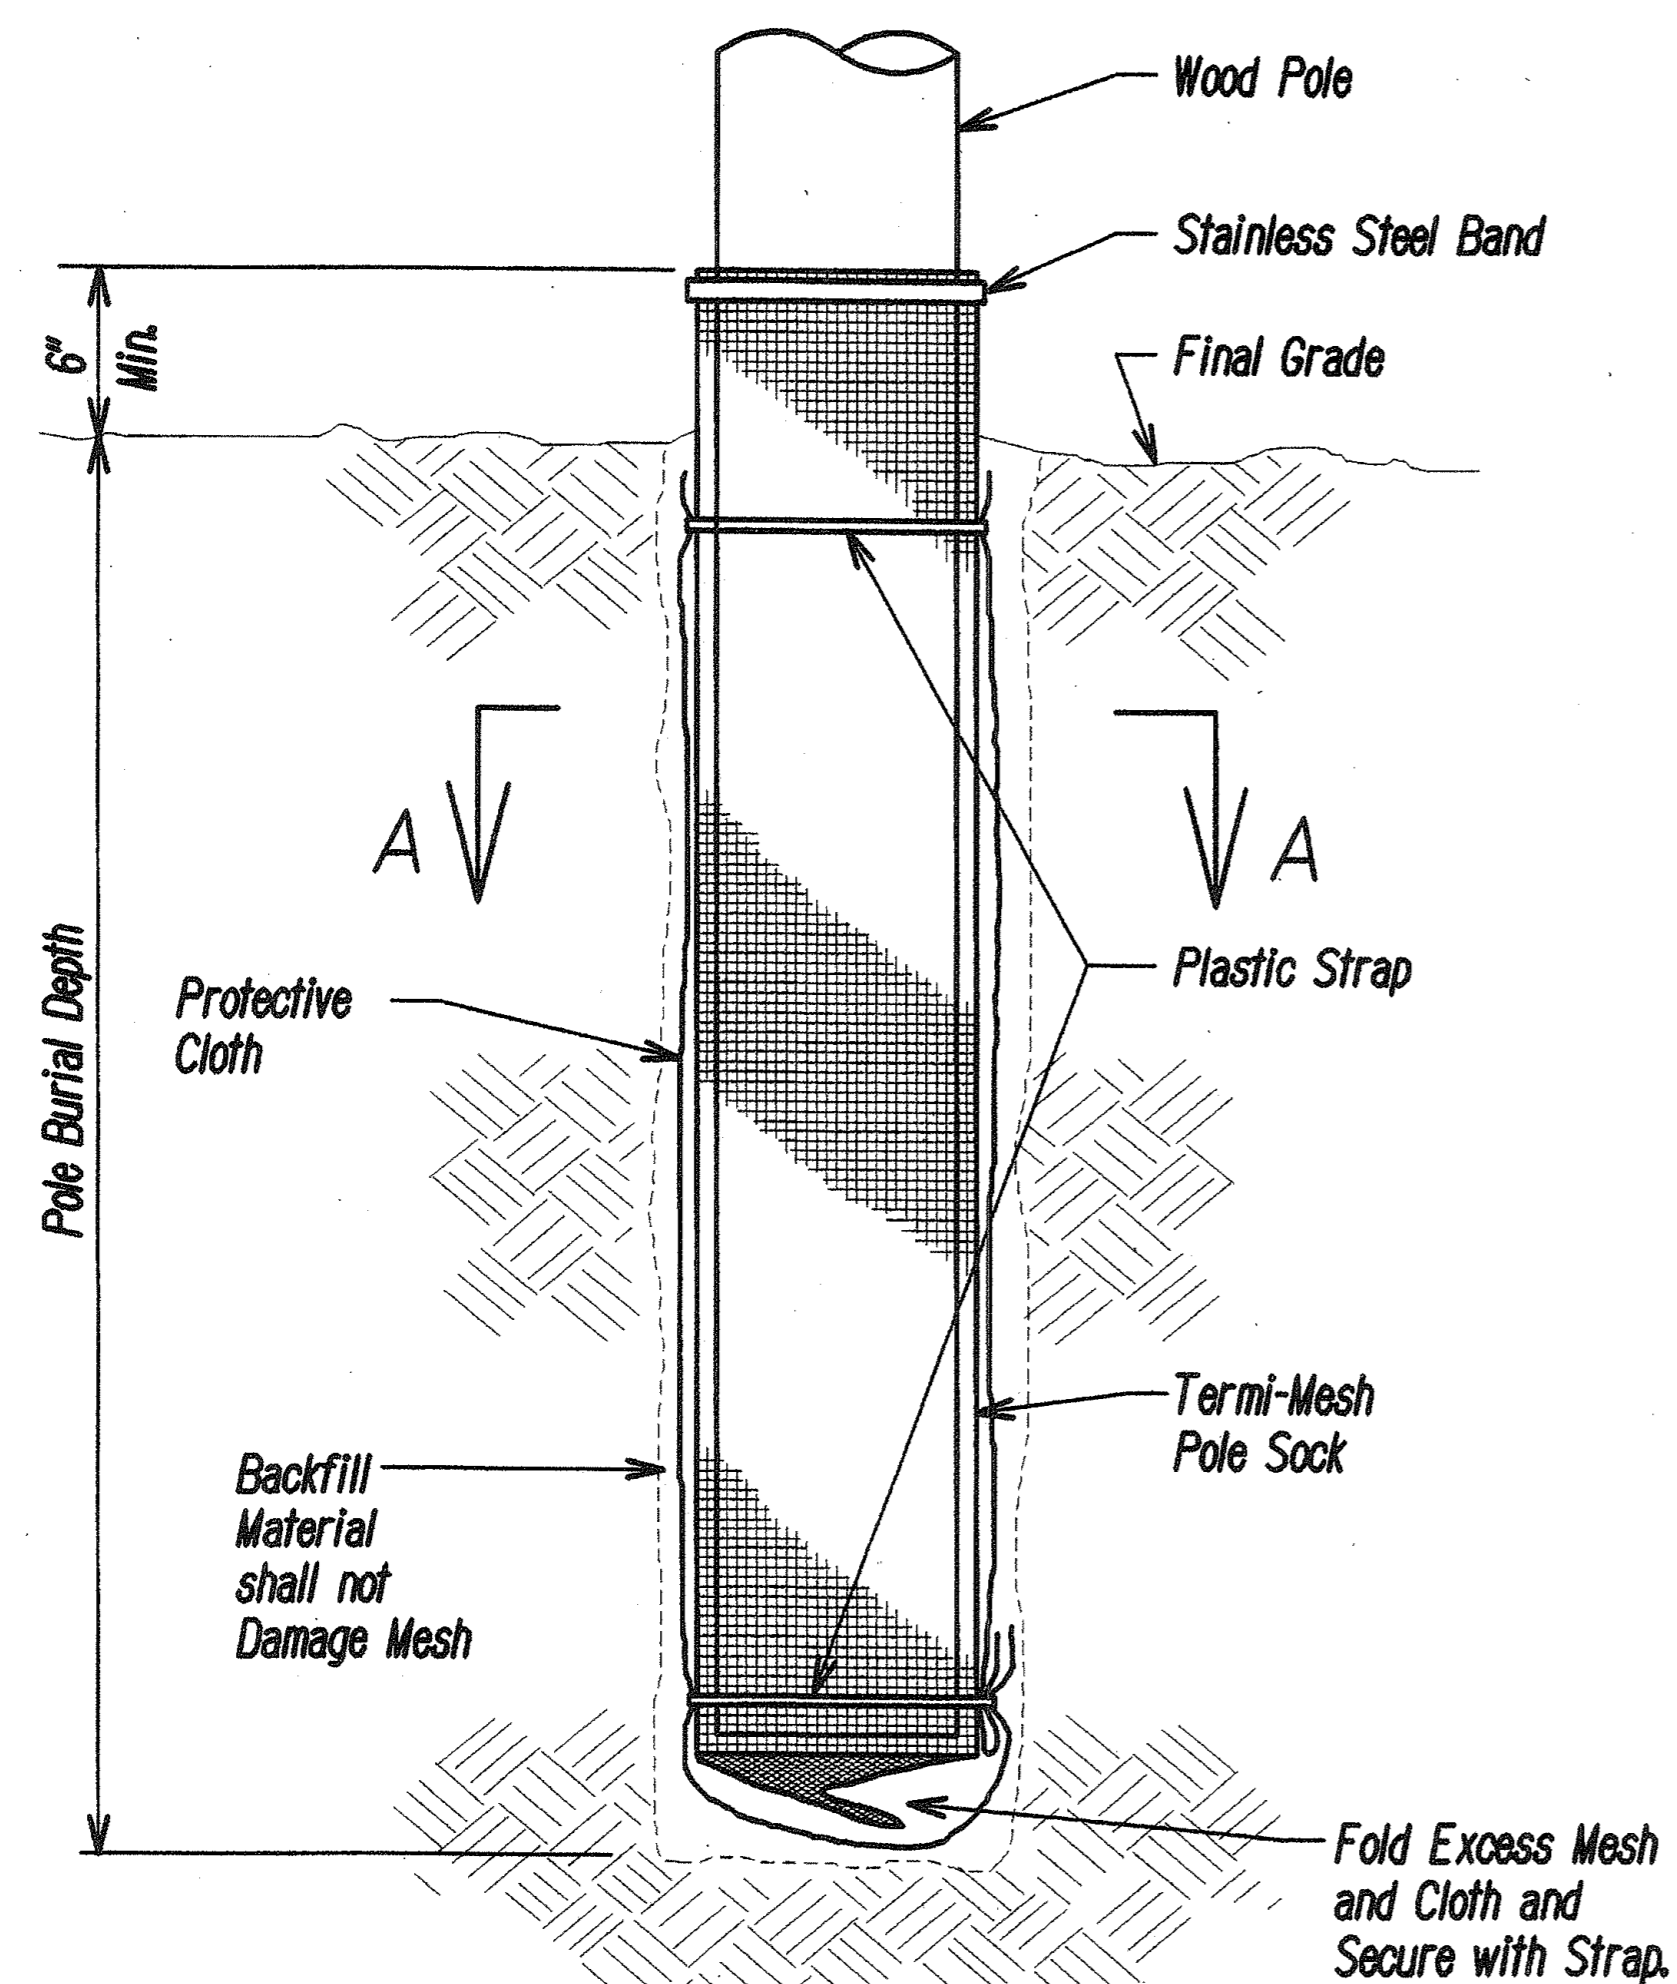


ELEVATION

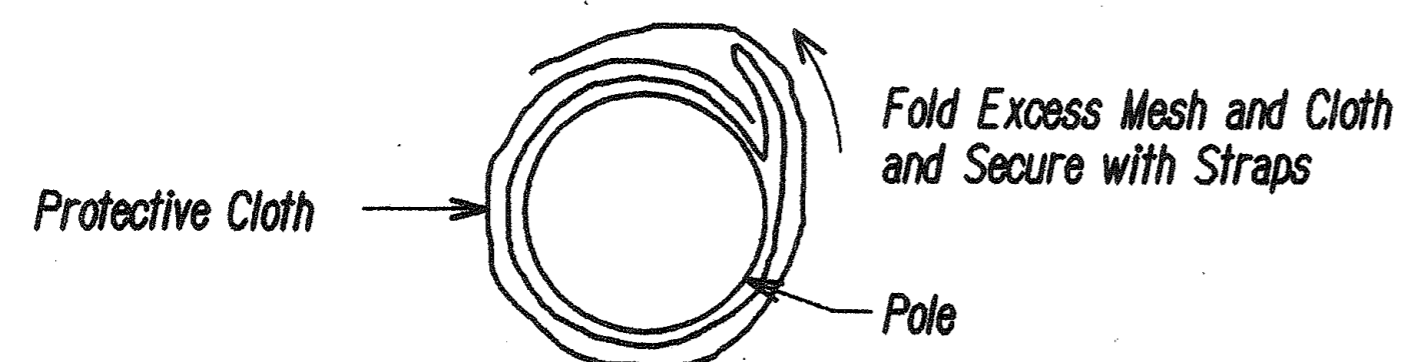


SECTION A-A


 TYPICAL BARRIER INSTALLATION  
E-20|E-20 N.T.S.

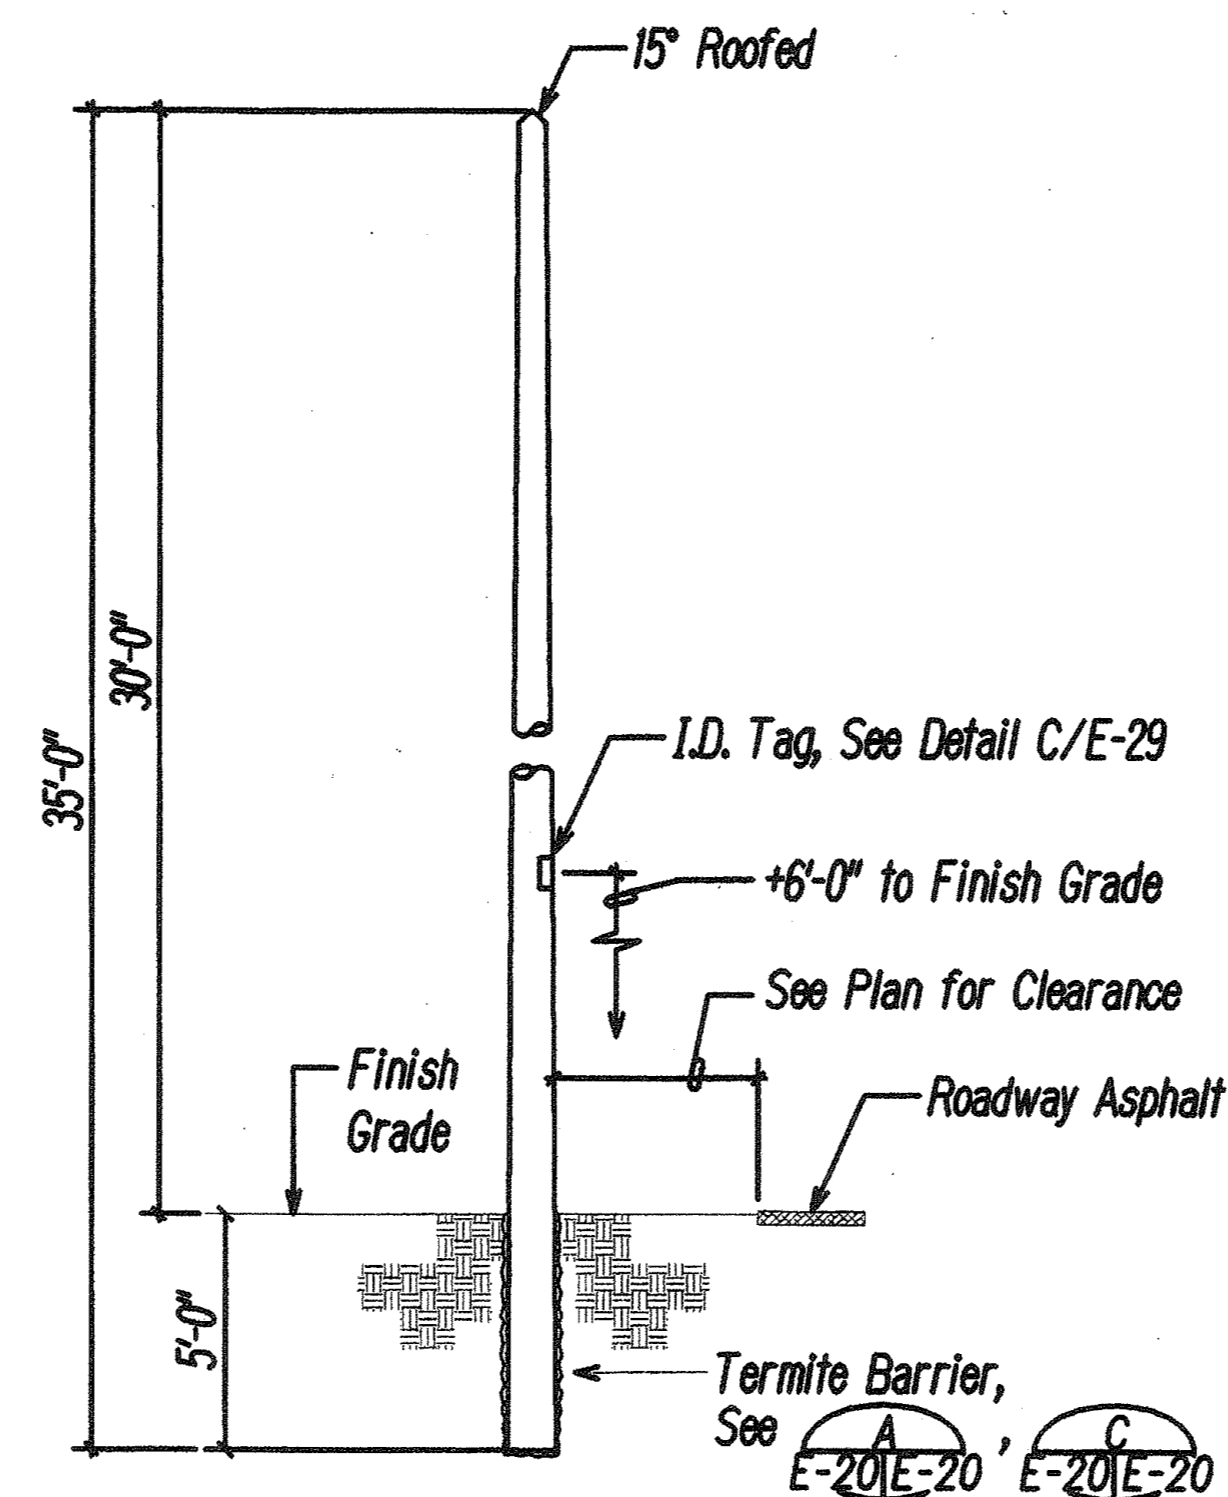

**NOTE:**


1. Wood Pole Class III
2. Pole shall be Treated with Pentachlorophenol Using the "Celon" Process by Licensed Termite Treatment Company. The Cost for Termite Treatment shall not be Paid for Separately, but shall be Considered Incidental to the Wood Pole.

 TYPICAL WOOD POLE DETAILS  
N.T.S.

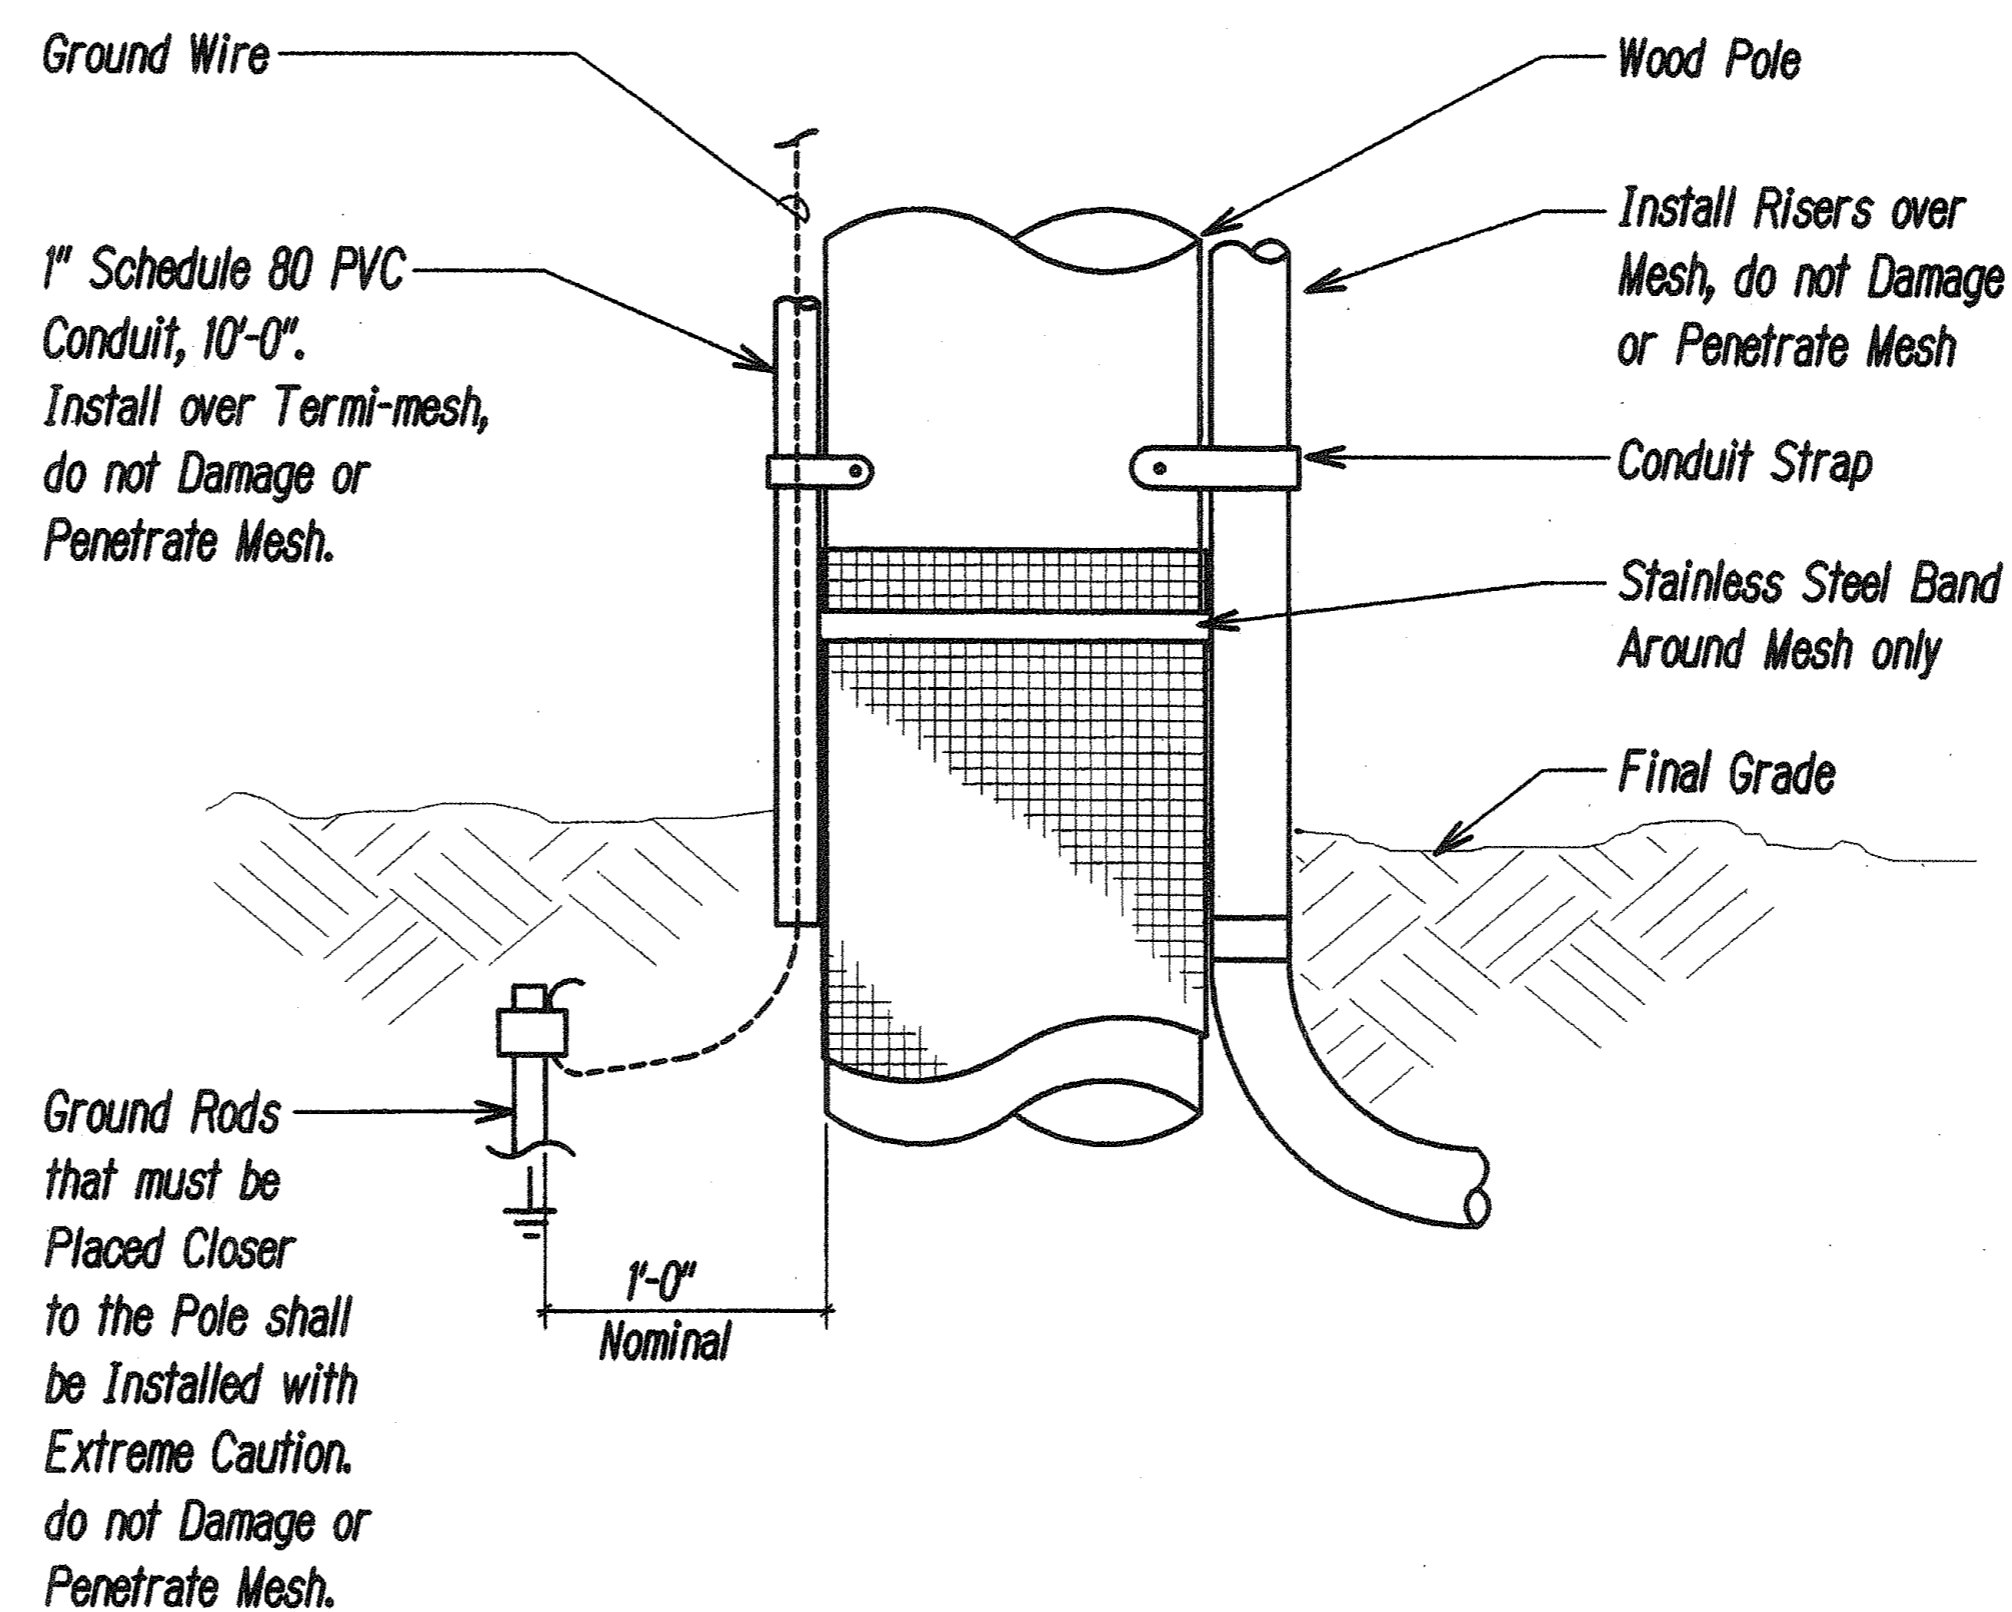

 TYPICAL GROUND WIRE/RISER DETAIL  
N.T.S.

FED. ROAD DIST. NO.	STATE	PROJ. NO.	FISCAL YEAR	SHEET NO.	TOTAL SHEETS
HAWAII	HAW.	HWY-M-04-00	2002	29	63

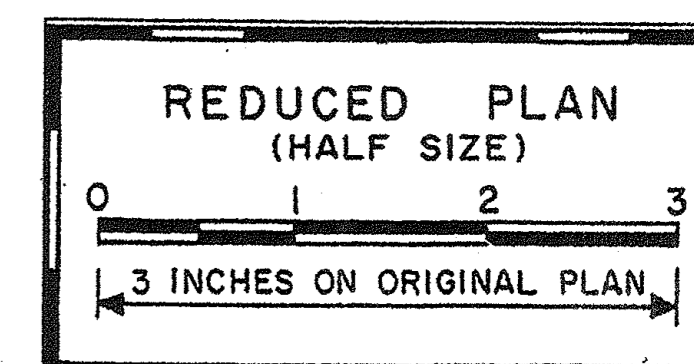


STATE OF HAWAII  
DEPARTMENT OF TRANSPORTATION  
HIGHWAYS DIVISION  
TRAFFIC SIGNAL DETAILS VIII



TRAFFIC OPERATIONAL IMPROVEMENTS  
AT VARIOUS LOCATIONS  
PUUNENE AVENUE AND  
KAAHUMANU AVENUE

Scale: AS NOTED Date: April 2002



SHEET No. F-20 OF 22 SHEETS




THIS WORK WAS PREPARED BY  
OR UNDER MY SUPERVISION.  
*Steven H. Galt*

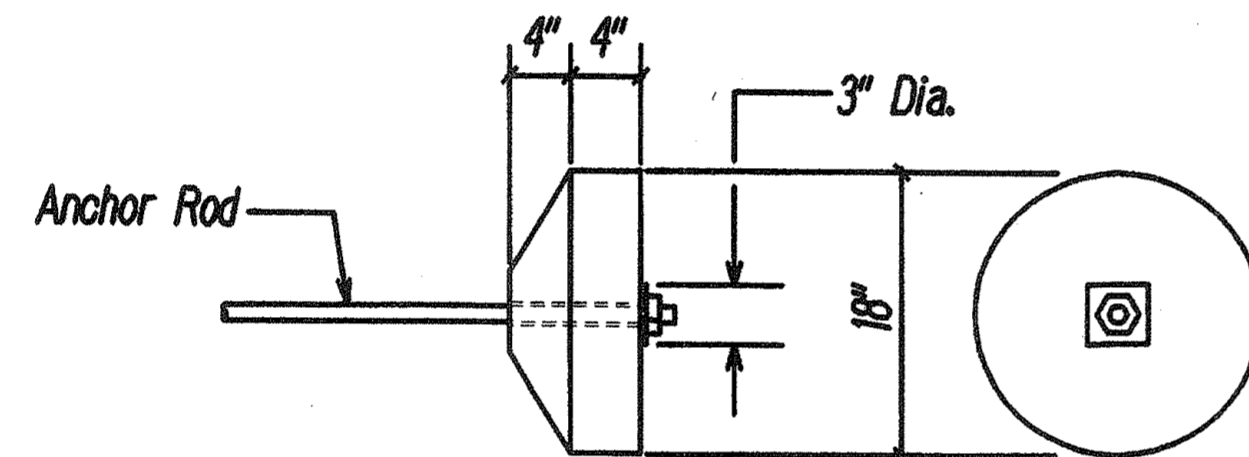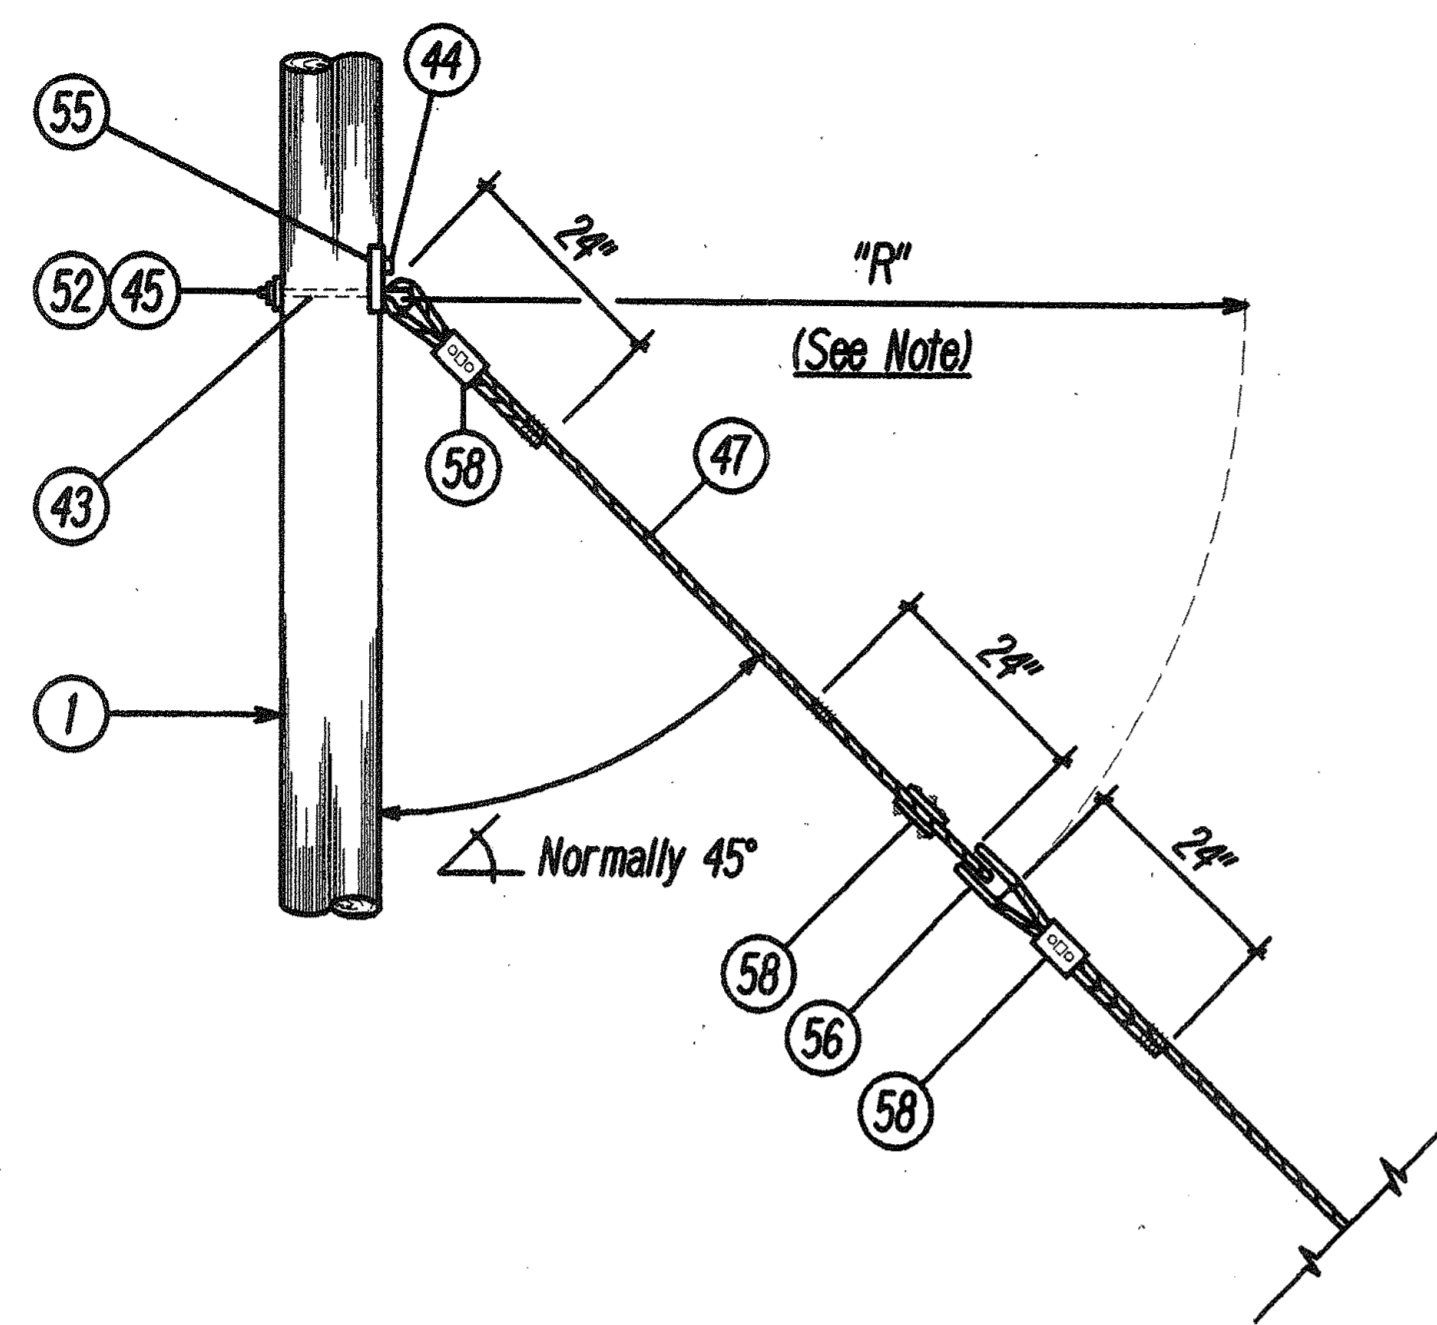

CONCRETE ANCHOR

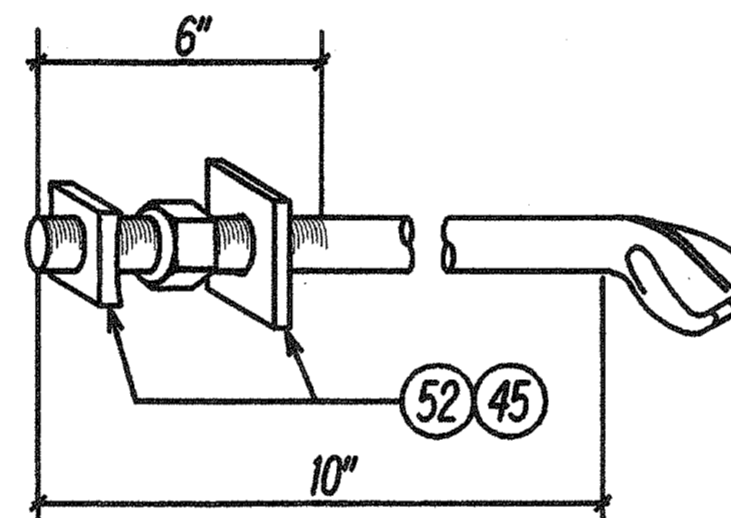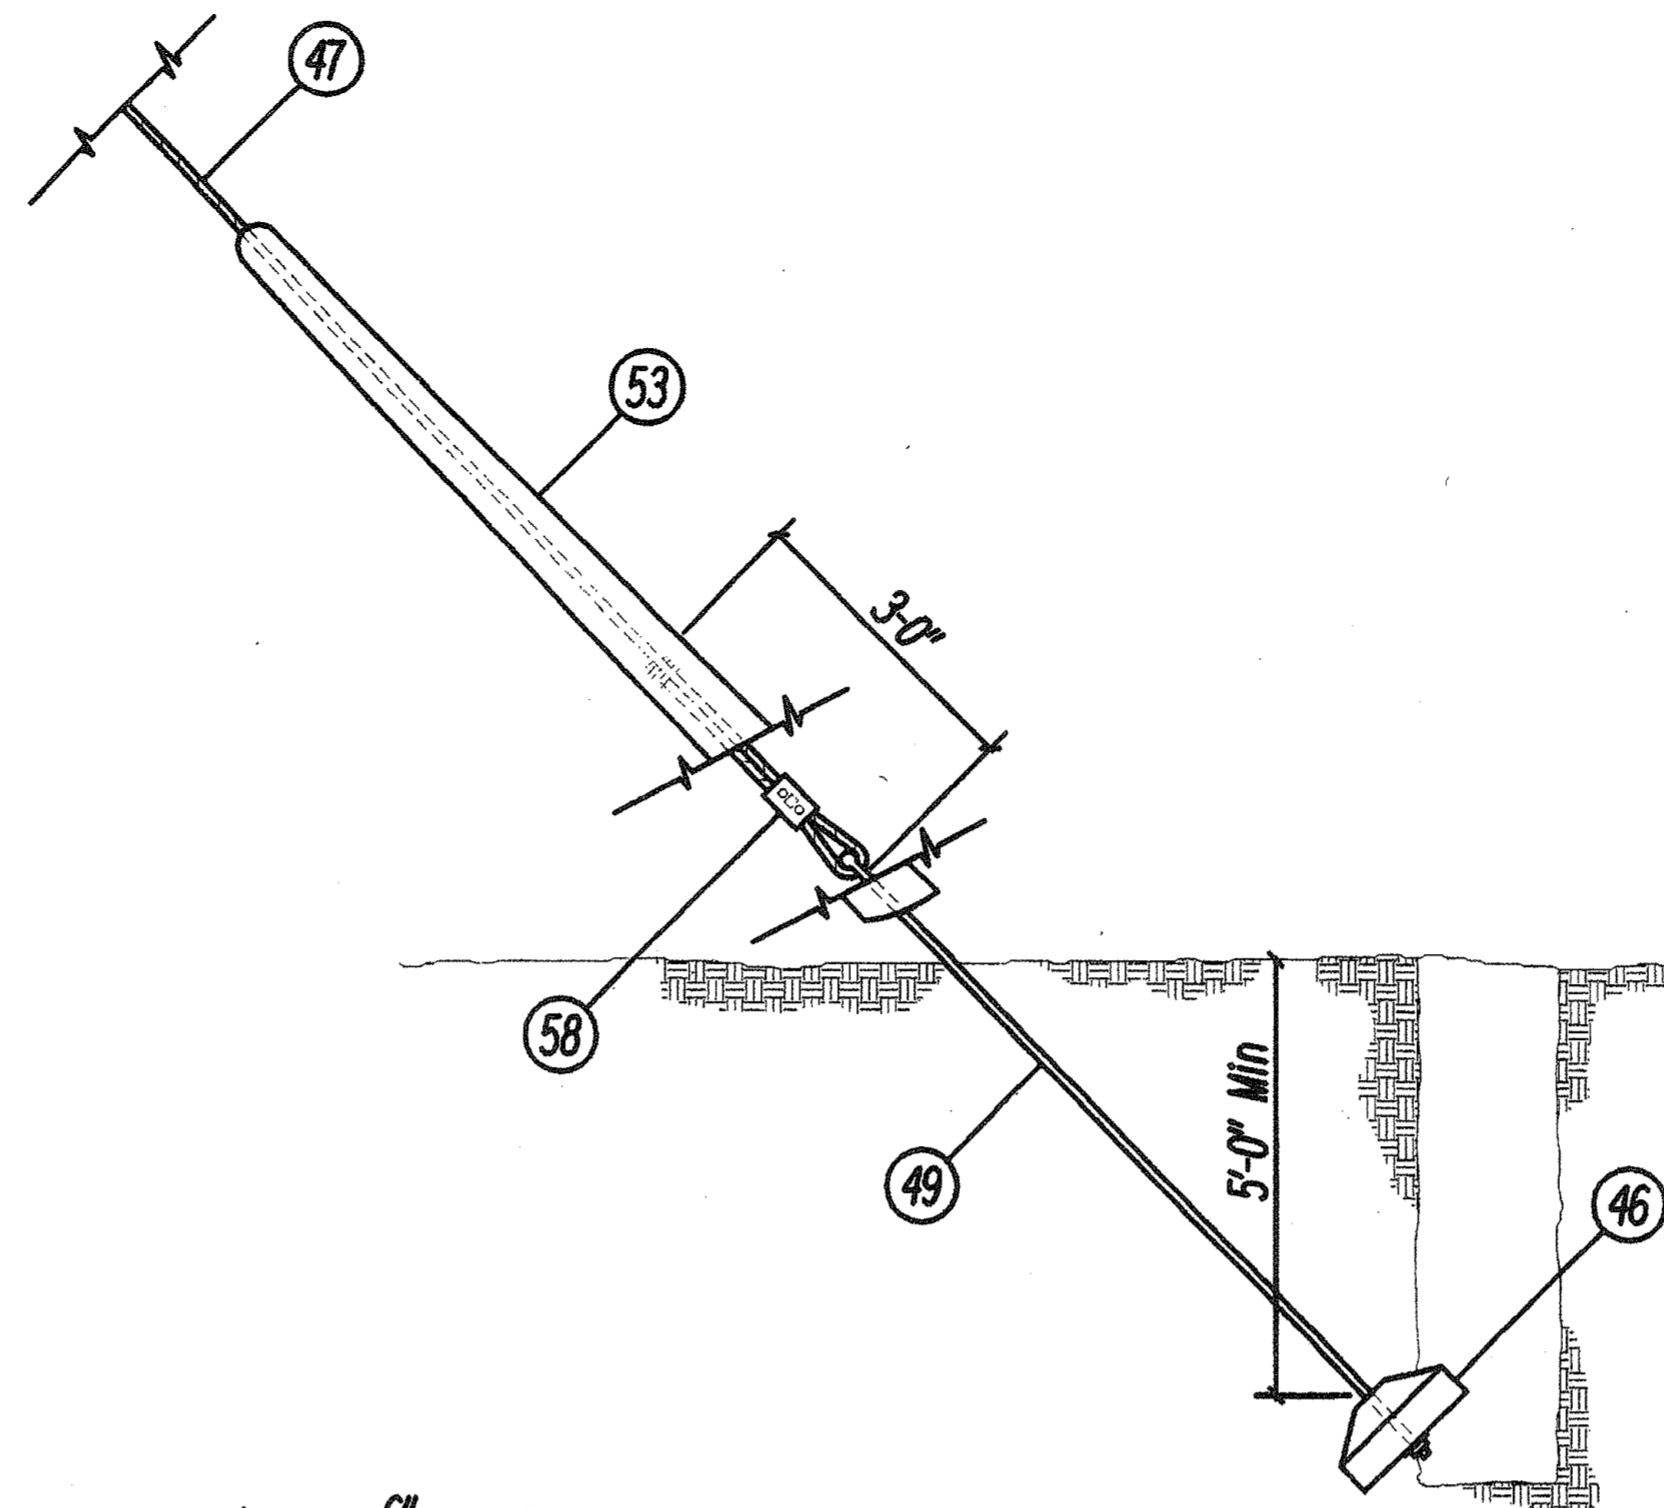

PART NO. 43

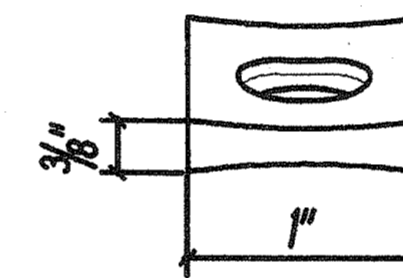

PART NO. 52

LIST OF MATERIALS	
Part No.	Description
1	Wood Pole, Class II, 40'-0" Unless Otherwise Indicated
43	Thimbleye Bolt, 5/8" X 10"
44	Lag Screw, 1/2" X 4" (Fetter Drive)
45	Washers, Square, 2 1/4" X 2 1/4" X 3/16", 1/16" Dia. Hole
46	Concrete Anchor
47	Galvanized Guy Wire, 7 Strand Utilities, Grade, 7/16" Size.
49	Anchor Rod, Threaded Thimbleye 5/8" X 8'-0", Twineye 3/4" X 8'-0"
52	Square M-F Locknut, for 5/8" Dia. Bolt
53	Guy Protector, Round, 8 Feet, Yellow Color PVC Material
55	Lift Plate, 3-Hole, 1/4" Steel Plate
56	Guy Strain Insulator
58	Guy Clamp, 6" 3-Bolt, 5/8" Bolt



Notes:

- All Hardware shall be Galvanized in Conformance with ASTM Designation A-153.
- Radius "R" shall be Length Required to Locate Guy Insulator Four Feet Below Communication Conductor Level; Minimum "R" Equal to Six Feet.
- Required Bolt Lengths Indicated are Approximate. Modify to Suit Pole Diameter.
- Provide Drilling as Required.

**A**  
**E-7/E-21** TYPICAL GUY AND ANCHOR ASSEMBLY DETAIL  
N.T.S.

ORIGINAL PLAN	DATE
DESIGNED BY	DATE
DRAWN BY	DATE
CHECKED BY	DATE
NOTED BY	DATE
NO. 1000	

23 APR 102 10:06:41 LA Z:\scod\hrc\c152\1143\guy21.dgn

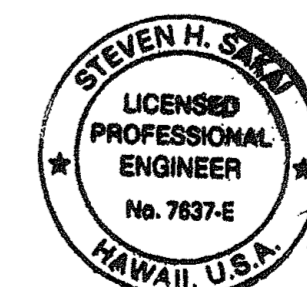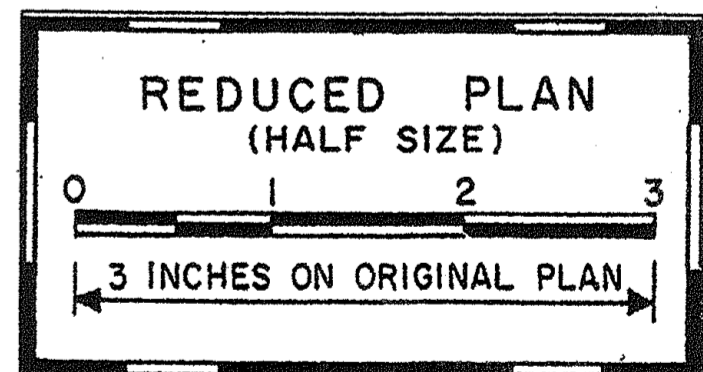

THIS WORK WAS PREPARED BY ME  
OR UNDER MY SUPERVISION  
*Steven H. Saka*

STATE OF HAWAII  
DEPARTMENT OF TRANSPORTATION  
HIGHWAYS DIVISION  
**TRAFFIC SIGNAL DETAILS IX**  
TRAFFIC OPERATIONAL IMPROVEMENTS  
AT VARIOUS LOCATIONS  
PUUNENE AVENUE AND  
KAAHUMANU AVENUE  
Scale: AS NOTED Date: April 2002  
SHEET No. E-21 OF 22 SHEETS