

INDEX TO DRAWINGS	
SHEET NO.	DESCRIPTION
1	TITLE SHEET
2-31	PUUNENE AVENUE AND KAAHUMANU AVENUE
32-47	KAHULUI BEACH ROAD
48-63	HONOAPIILANI HIGHWAY

FED. ROAD DIST. NO.	STATE	PROJ. NO.	FISCAL YEAR	SHEET NO.	TOTAL SHEETS
HAWAII	HAW.	HWY-M-04-00	2002	1	63

STATE OF HAWAII

DEPARTMENT OF TRANSPORTATION

HIGHWAYS DIVISION

HONOLULU, HAWAII

"AS-BUILT"

PLANS FOR:

TRAFFIC OPERATIONAL IMPROVEMENTS

AT VARIOUS LOCATIONS

PUUNENE AVENUE

KAAHUMANU AVENUE TO KUIHELANI HIGHWAY

KAAHUMANU AVENUE

AT LUNALILO STREET

KAHULUI BEACH ROAD

AT SMALL BOAT HARBOR ROAD AND KAIHEE PLACE


HONOAPIILANI HIGHWAY

AT WAIKO ROAD

PROJECT NO. HWY-M-04-00

DISTRICT OF WAILUKU

ISLAND OF MAUI

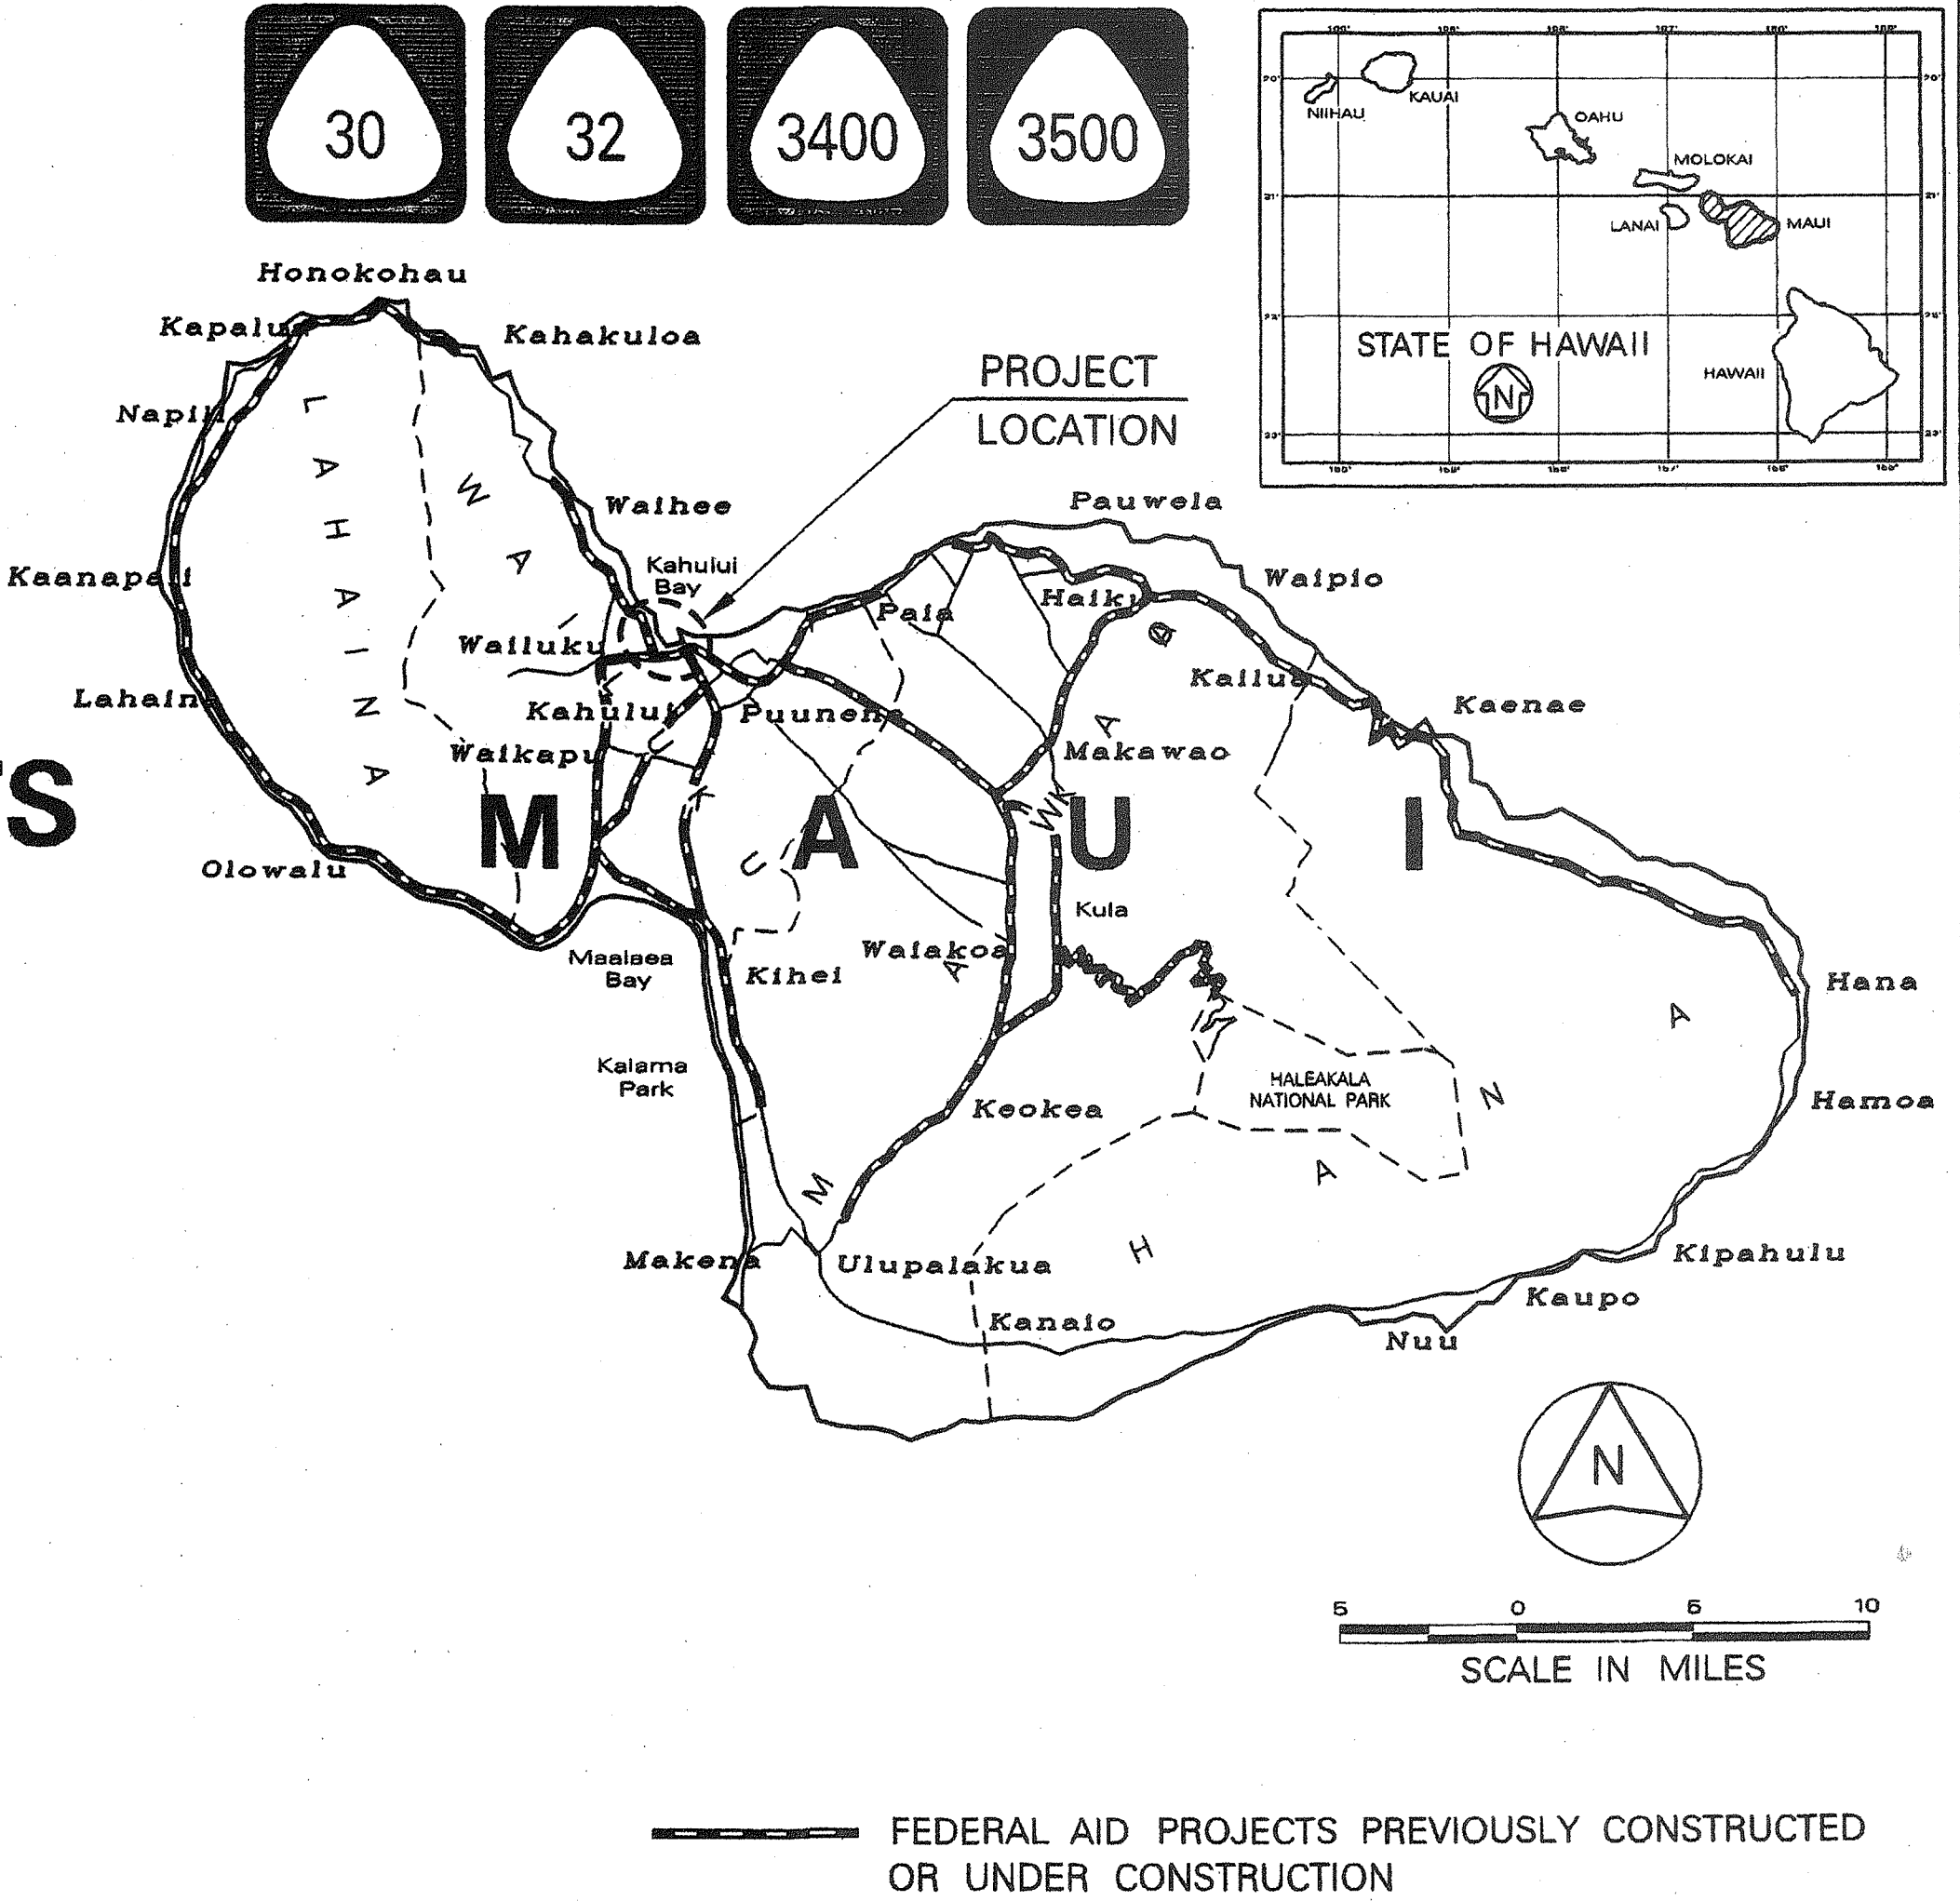

DESIGNED BY

KARL KUNISHIGE

P. S. & E. BY

692-7679

PHONE

APR. 2002

DATE

DEPARTMENT OF TRANSPORTATION

STATE OF HAWAII

APPROVED:

[Signature]

5-13-02

for DIR. OF TRANSPORTATION

DATE