INDEX TO DRAWINGS	
SHEET NO.	DESCRIPTION
1	TITLE SHEET
2	LAYOUT PLANS
3	STANDARD PLANS SUMMARY
4	TYPICAL ACCELERATION AND DECELERATION LANE MARKINGS
5	PAVEMENT MARKING LEGEND, DETAILS AND GENERAL NOTES

Sheet No.C.O. 55-1 through C.O. 55-13 are supplementary sheets to this project. Total sheet count after "As-Built" posting is 18 sheets.

OF HAWAII STATE

TRANSPORTATION DEPARTMENT OF


DIVISION HIGHWAYS HONOLULU, HAWAII

PLANS FOR

FISCAL SHEET YEAR NO. HAW. HWY-M-04-06M 2006





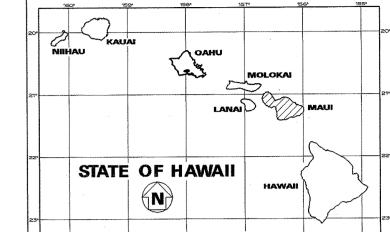

4-20.06

PAVEMENT MARKING AND STRIPING

AT VARIOUS LOCATIONS, MAUI PROJECT NO. HWY-M-04-06M

DISTRICTS OF HANA, MAKAWAO AND LAHAINA ISLAND OF MAUI

