



FED. ROAD DIST. NO.	STATE	PROJ. NO.	FISCAL YEAR	SHEET NO.	TOTAL SHEETS
HAWAII	HAW.	HWY-M-07-07M	2007	8	20

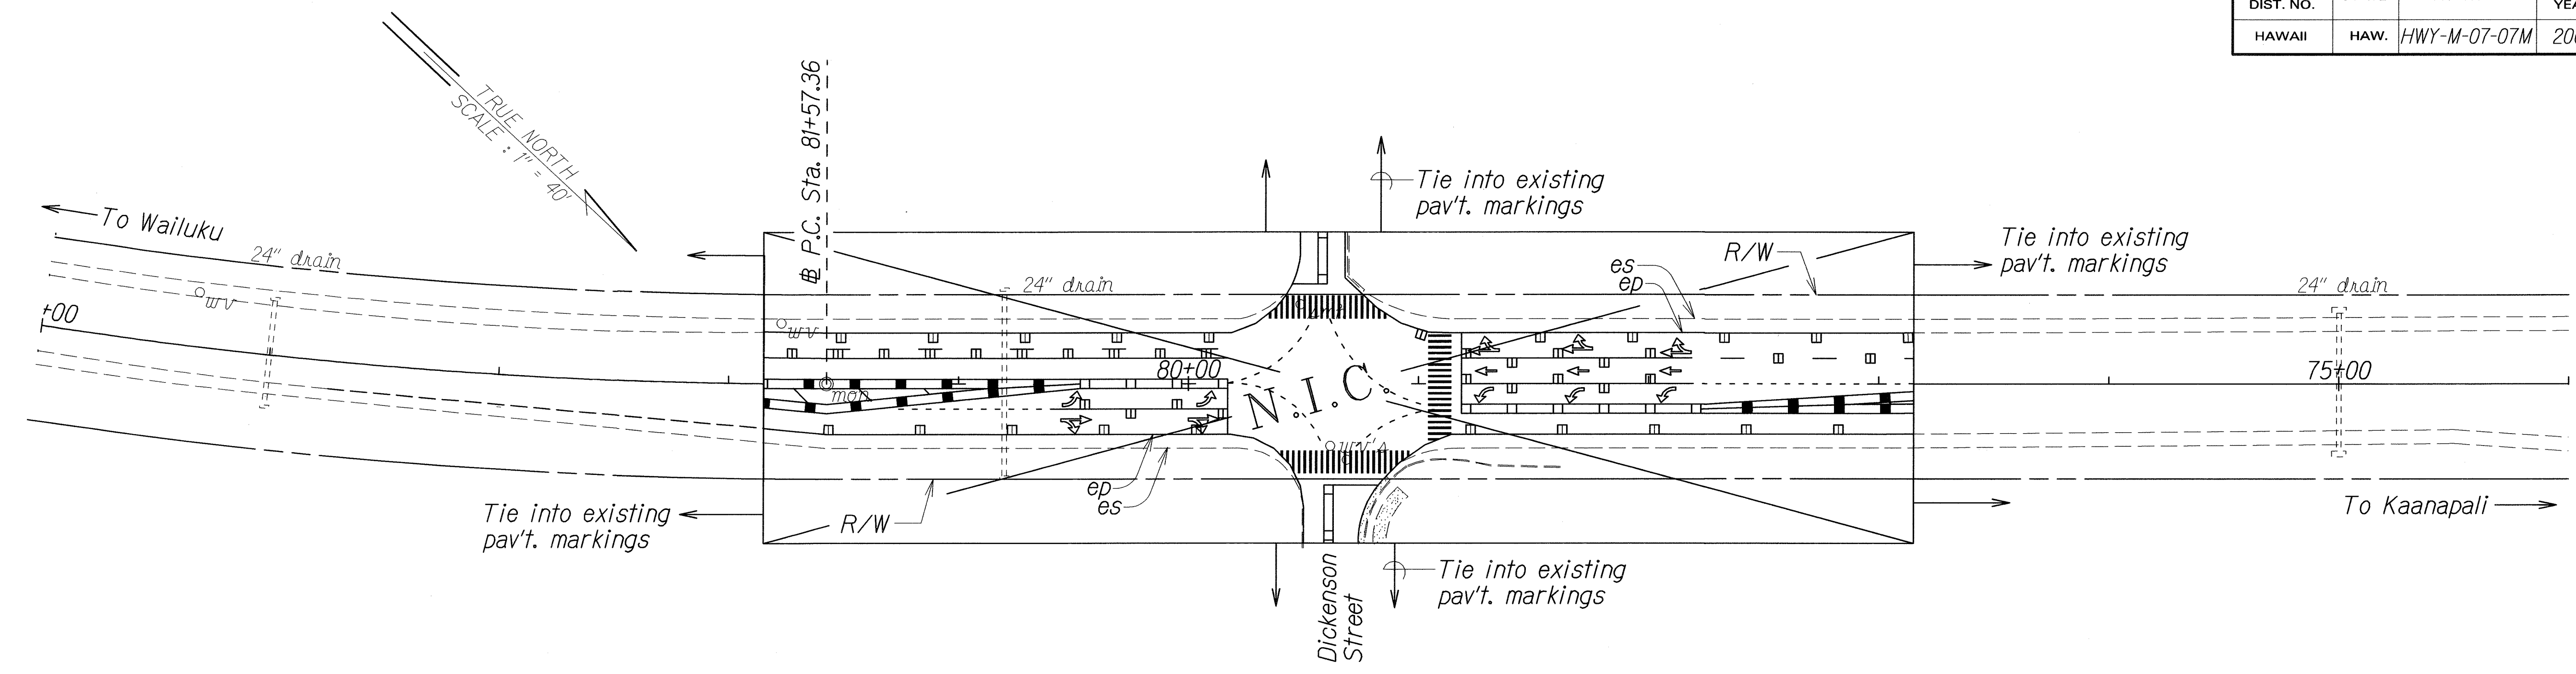

WORK AREA #3
INTERSECTION AT DICKENSON ST. & HONOAPIILANI HIGHWAY
Scale: 1" = 40'

LEGEND FOR AS-BUILT POSTINGS	
	Squiggly line for as-built deletion
	Double line for as-built deletion
Roadway	Text for as-built posting

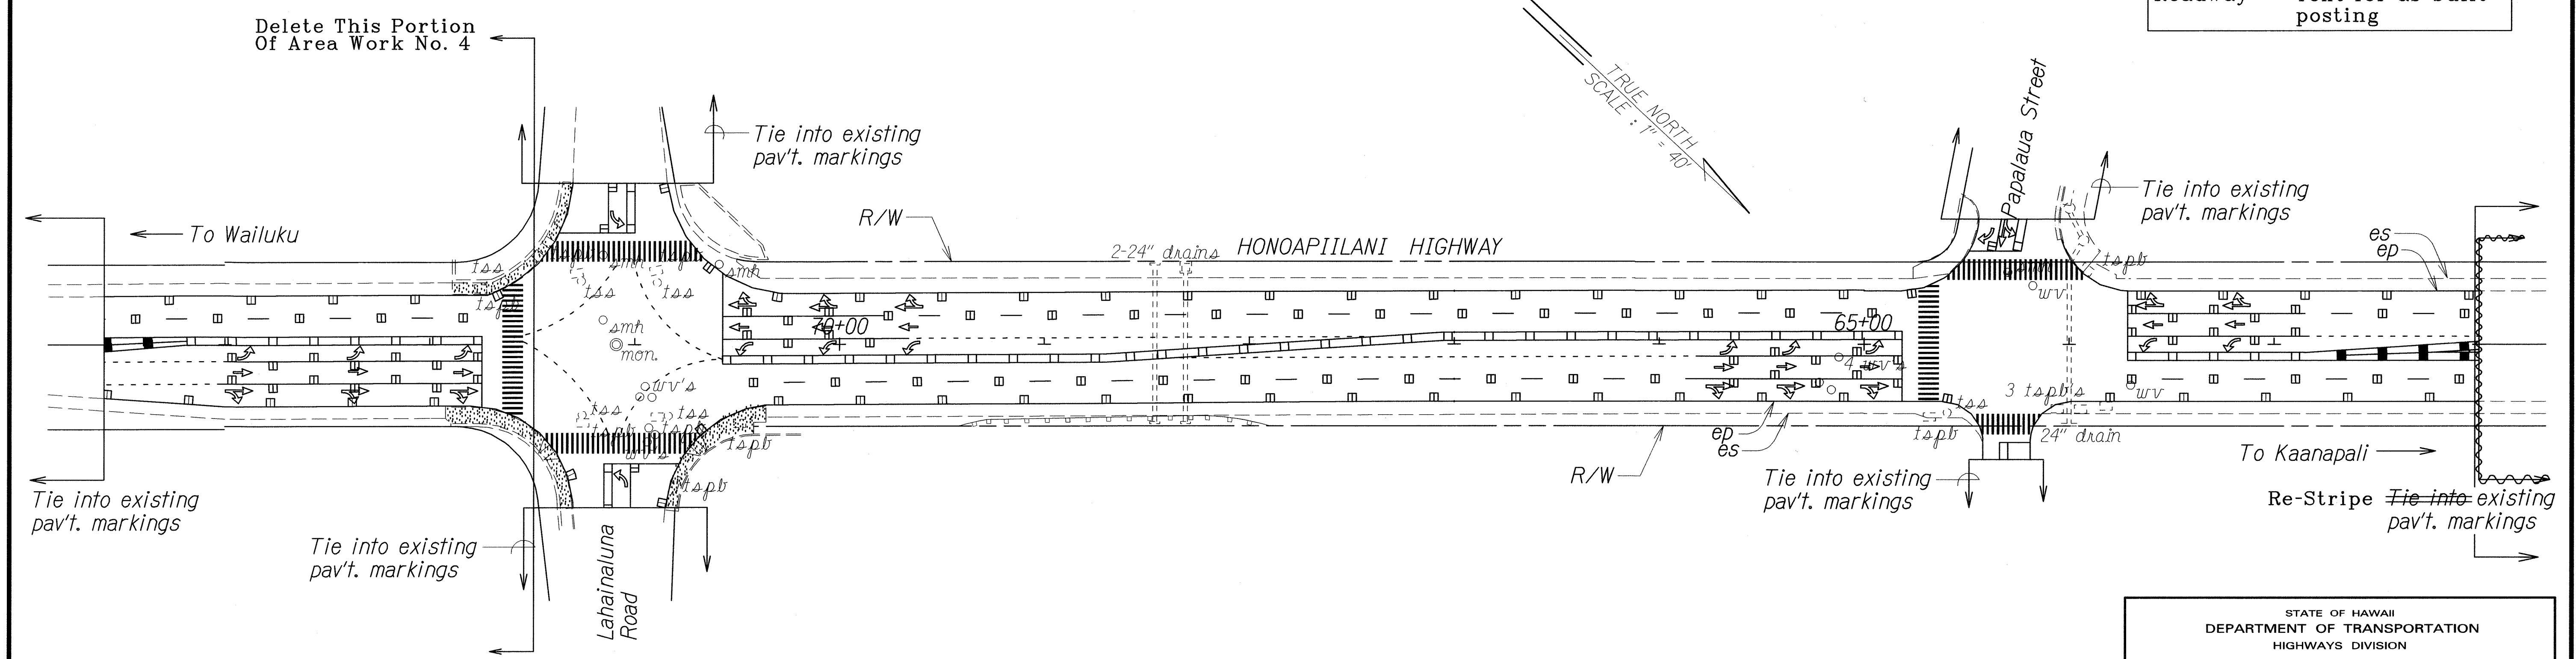

WORK AREA #4
INTERSECTION AT LAHAINALUNA RD. & PAPALAUA ST. & HONOAPIILANI HIGHWAY
Scale: 1" = 40'

STATE OF HAWAII
DEPARTMENT OF TRANSPORTATION
HIGHWAYS DIVISION

PAVEMENT MARKING PLAN

PAVEMENT MARKING AND STRIPING

At Various Locations, Maui


Project No. HWY-M-07-07M

Scale: 1" = 40' Date: April, 2007

SHEET No. 2 OF 14 SHEETS


DATE	4/07
SURVEY PLOTTED BY	...
DRAWN BY	...
CHECKED BY	...
NOTE BOOK	...
QUANTITIES BY	...
CHECKED BY	...

FED. ROAD DIST. NO.	STATE	PROJ. NO.	FISCAL YEAR	SHEET NO.	TOTAL SHEETS
HAWAII	HAW.	HWY-M-07-07M	2007	9	20

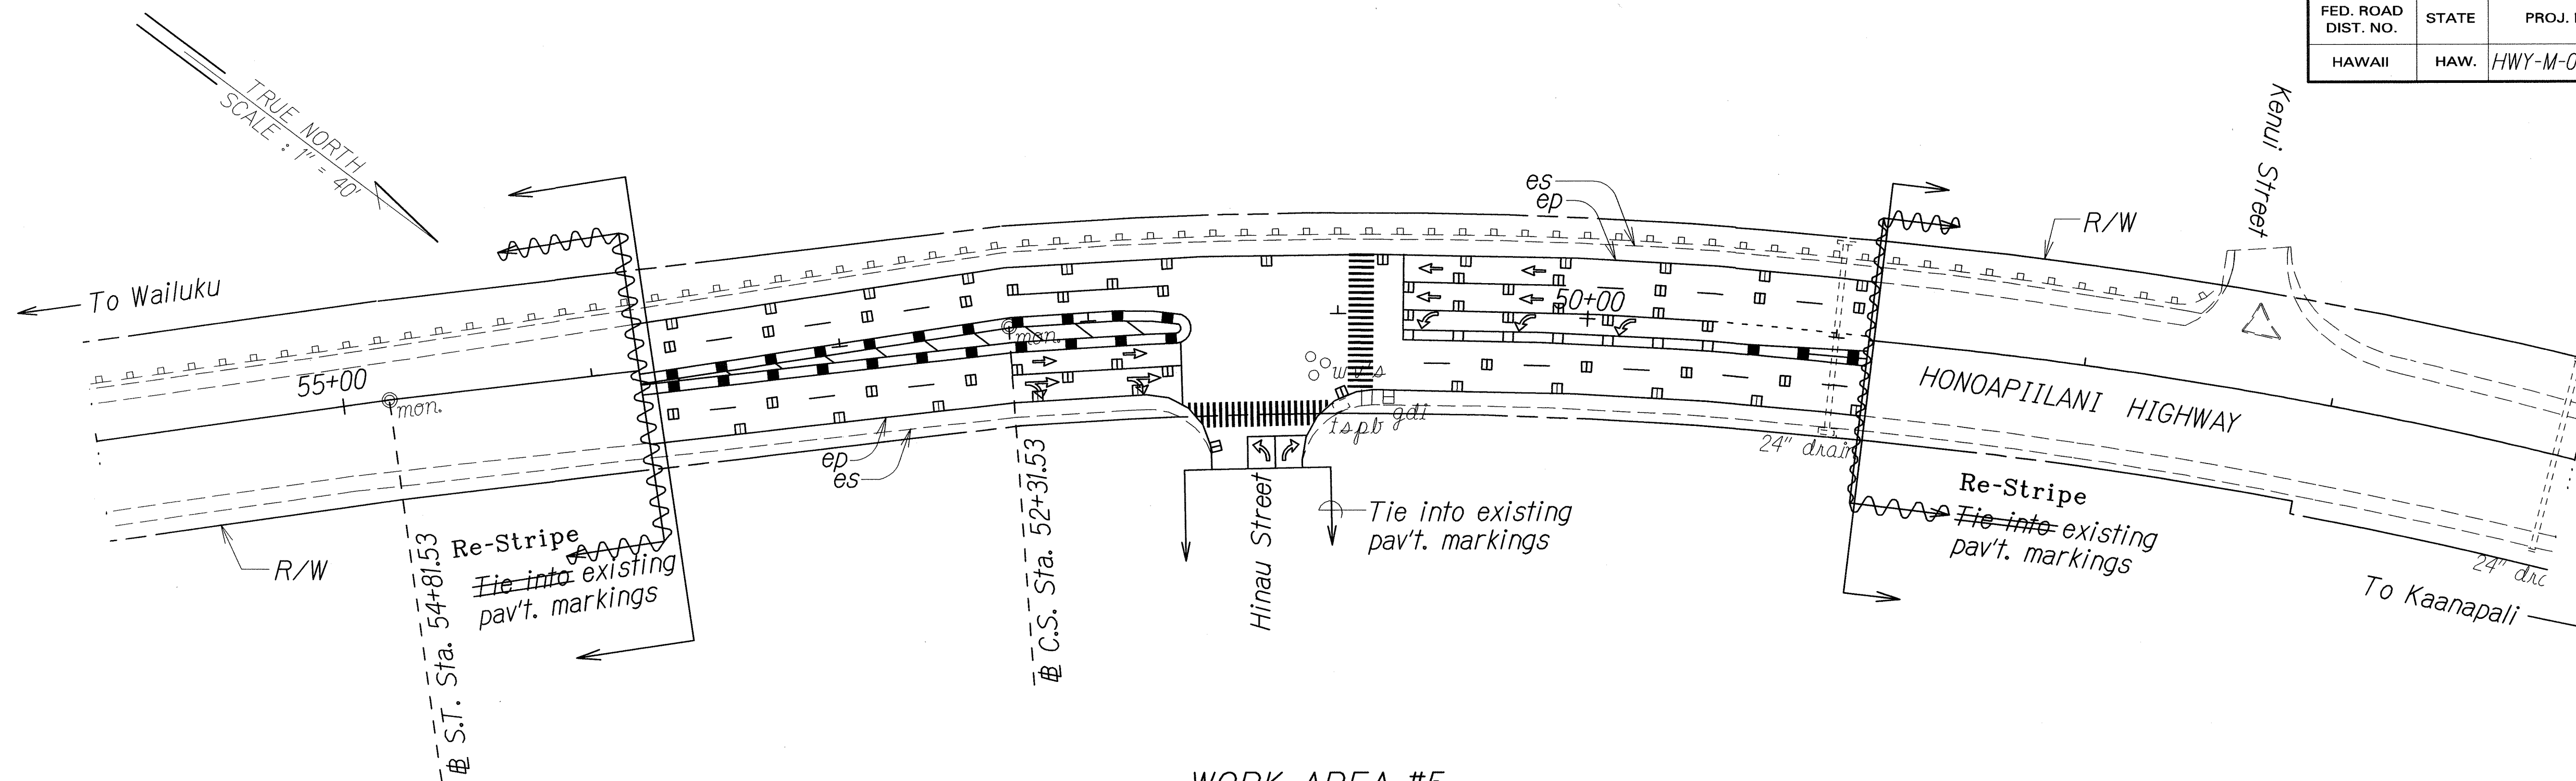

WORK AREA #5
INTERSECTION AT HINAU ST. & HONOAPIILANI HIGHWAY
 Scale: 1" = 40'

LEGEND FOR AS-BUILT POSTINGS	
	Squiggly line for as-built deletion
	Double line for as-built deletion
Roadway	Text for as-built posting

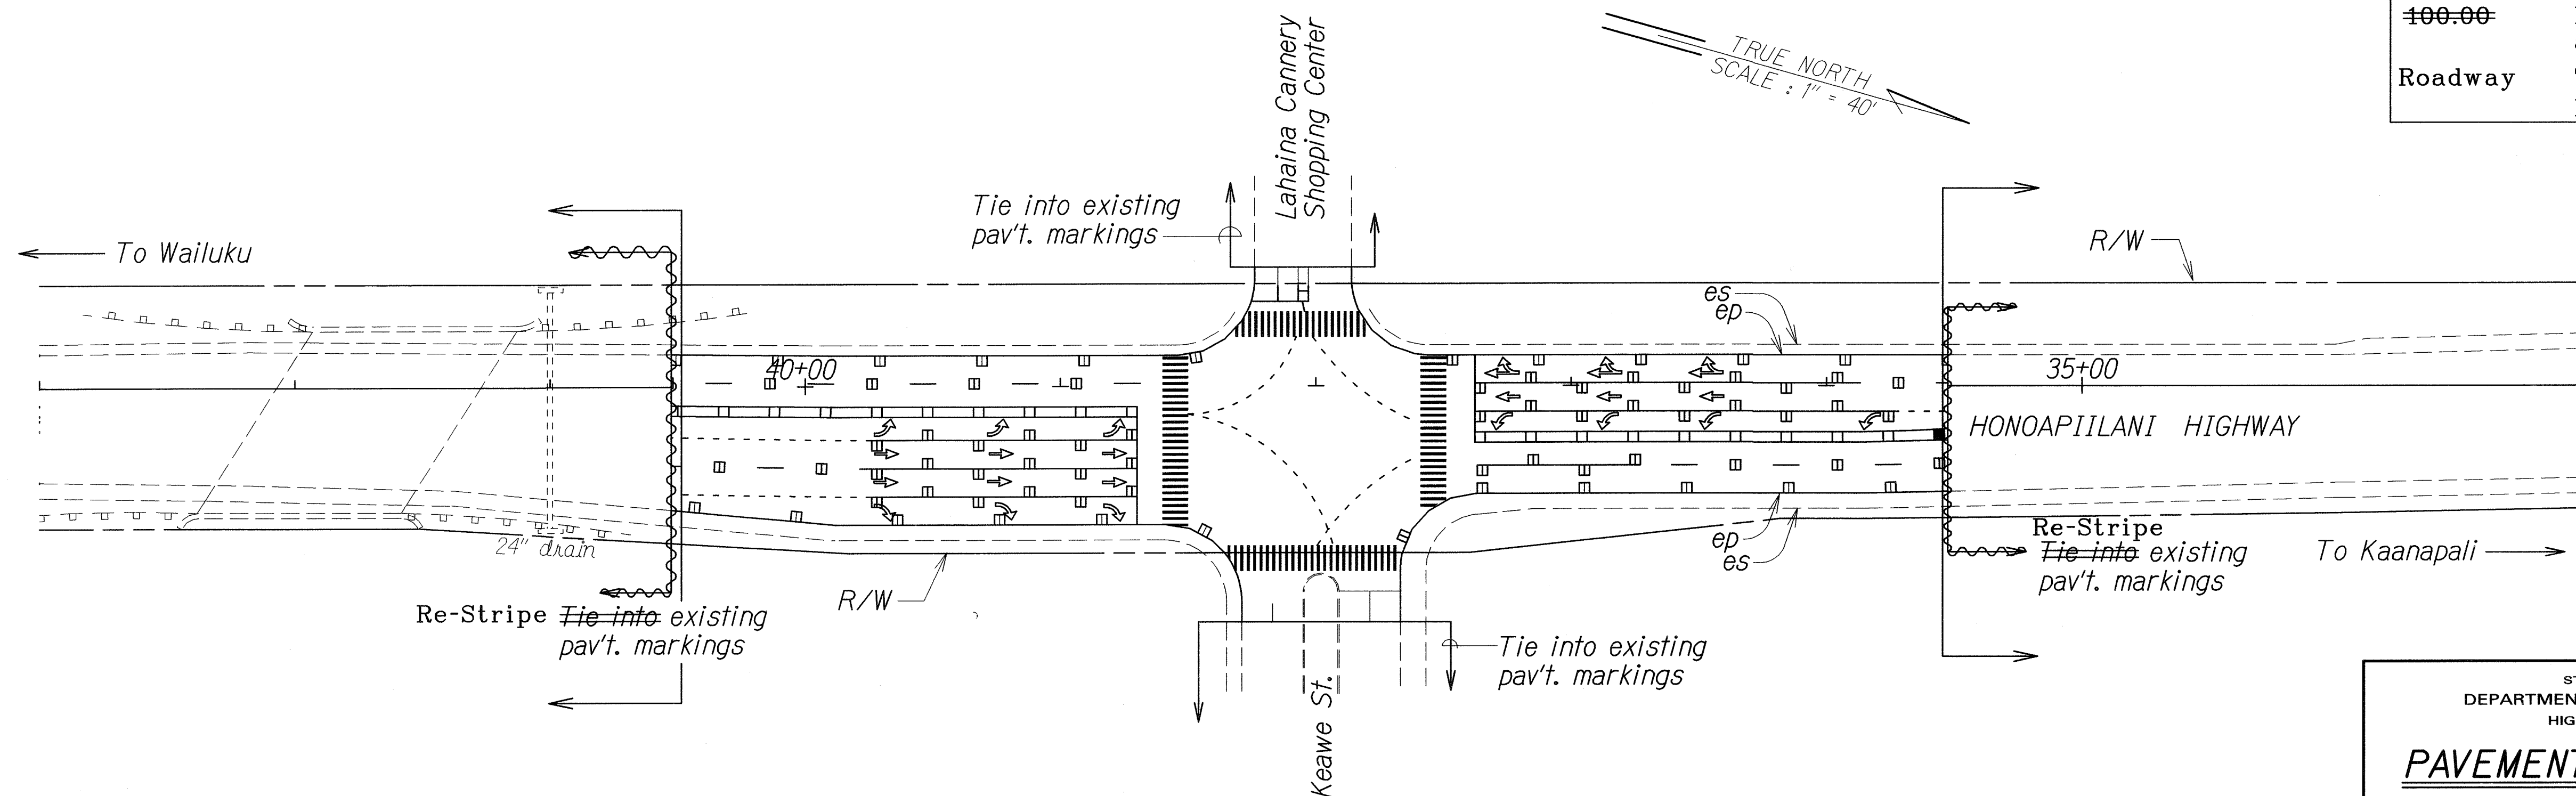


WORK AREA #6
INTERSECTION AT LAHAINA CANNERY & KEAWE ST. & HONOAPIILANI HIGHWAY
 Scale: 1" = 40'

ORIGINAL PLAN	SURVEY PLOTTED BY	DATE
NOTE BOOK	DRAWN BY	4/07
DESIGNED BY	DESIGNED BY	
QUANTITIES BY	QUANTITIES BY	
CHECKED BY	CHECKED BY	

STATE OF HAWAII DEPARTMENT OF TRANSPORTATION HIGHWAYS DIVISION	
PAVEMENT MARKING PLAN	
PAVEMENT MARKING AND STRIPING	
<i>At Various Locations, Maui</i>	
<i>Project No. HWY-M-07-07M</i>	
Scale: 1" = 40'	Date: April, 2007
SHEET No. 3 OF 14 SHEETS	


"AS-BUILT"

FED. ROAD DIST. NO.	STATE	PROJ. NO.	FISCAL YEAR	SHEET NO.	TOTAL SHEETS
HAWAII	HAW.	HWY-M-07-07M	2007	10	20

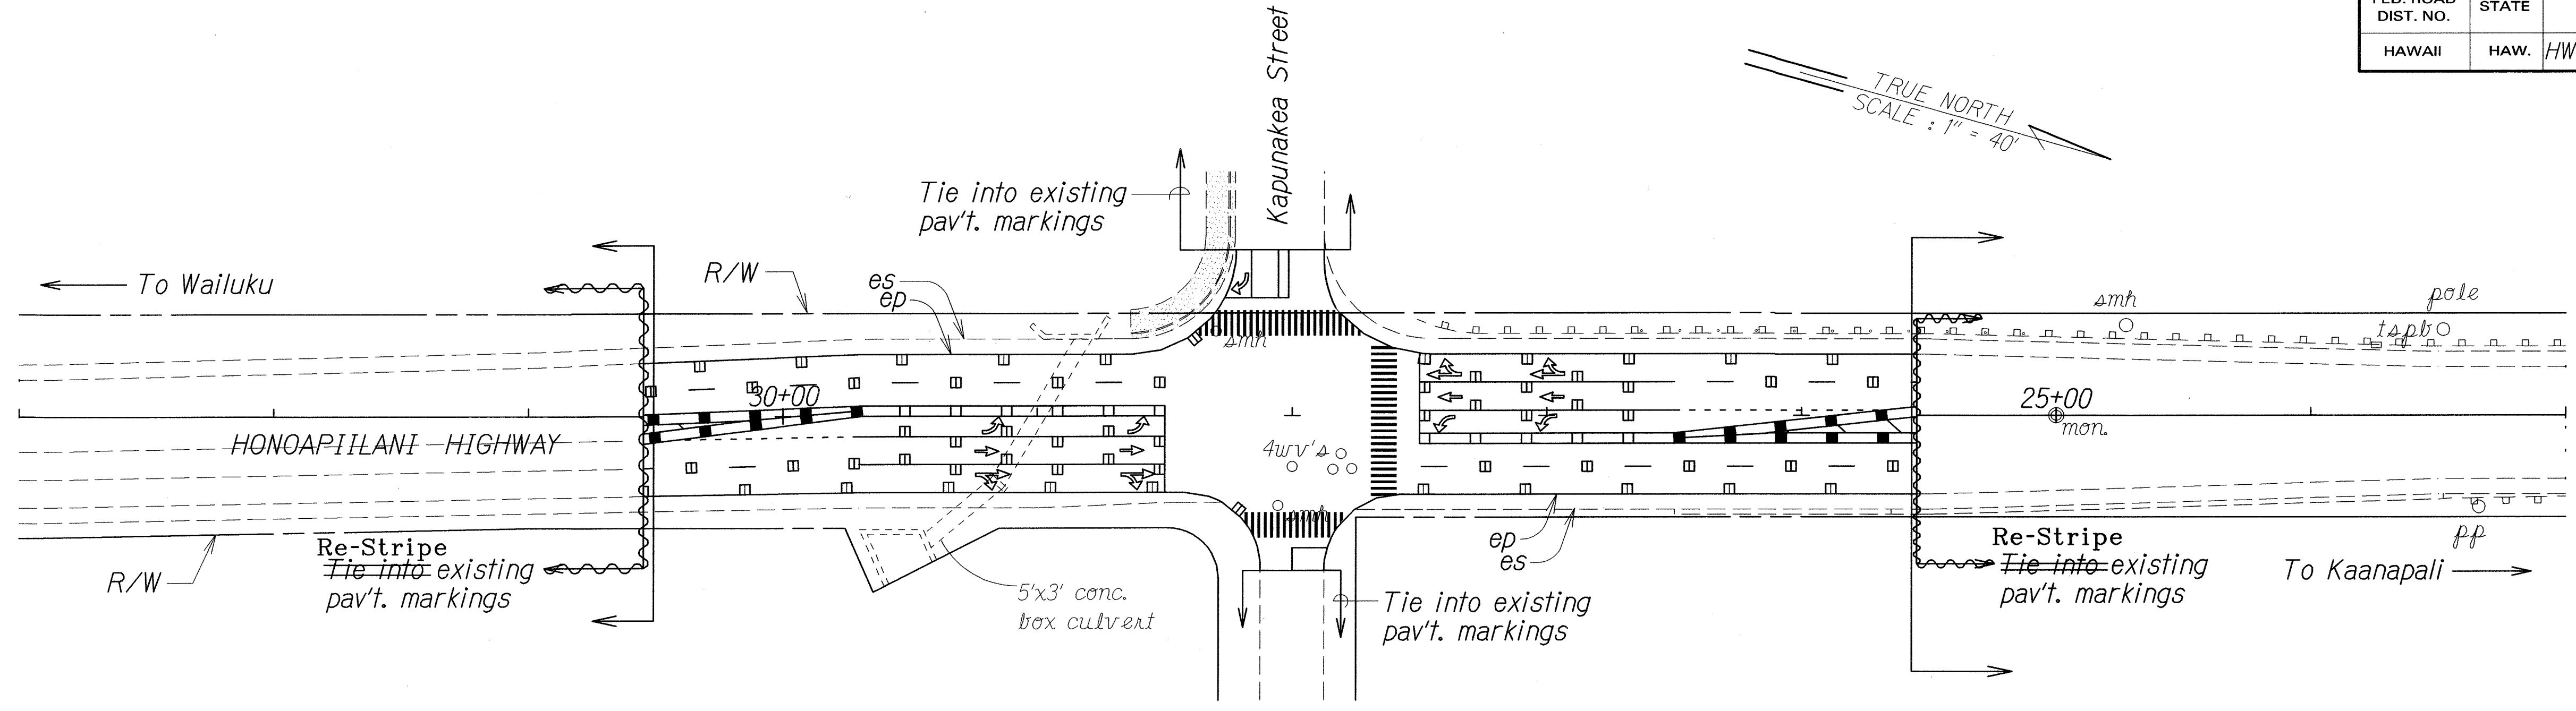

WORK AREA #7
INTERSECTION AT KAPUNAKEA & HONOAPIILANI HIGHWAY
 Scale: 1" = 40'

LEGEND FOR AS-BUILT POSTINGS	
	Squiggly line for as-built deletion
	Double line for as-built deletion
Roadway	Text for as-built posting

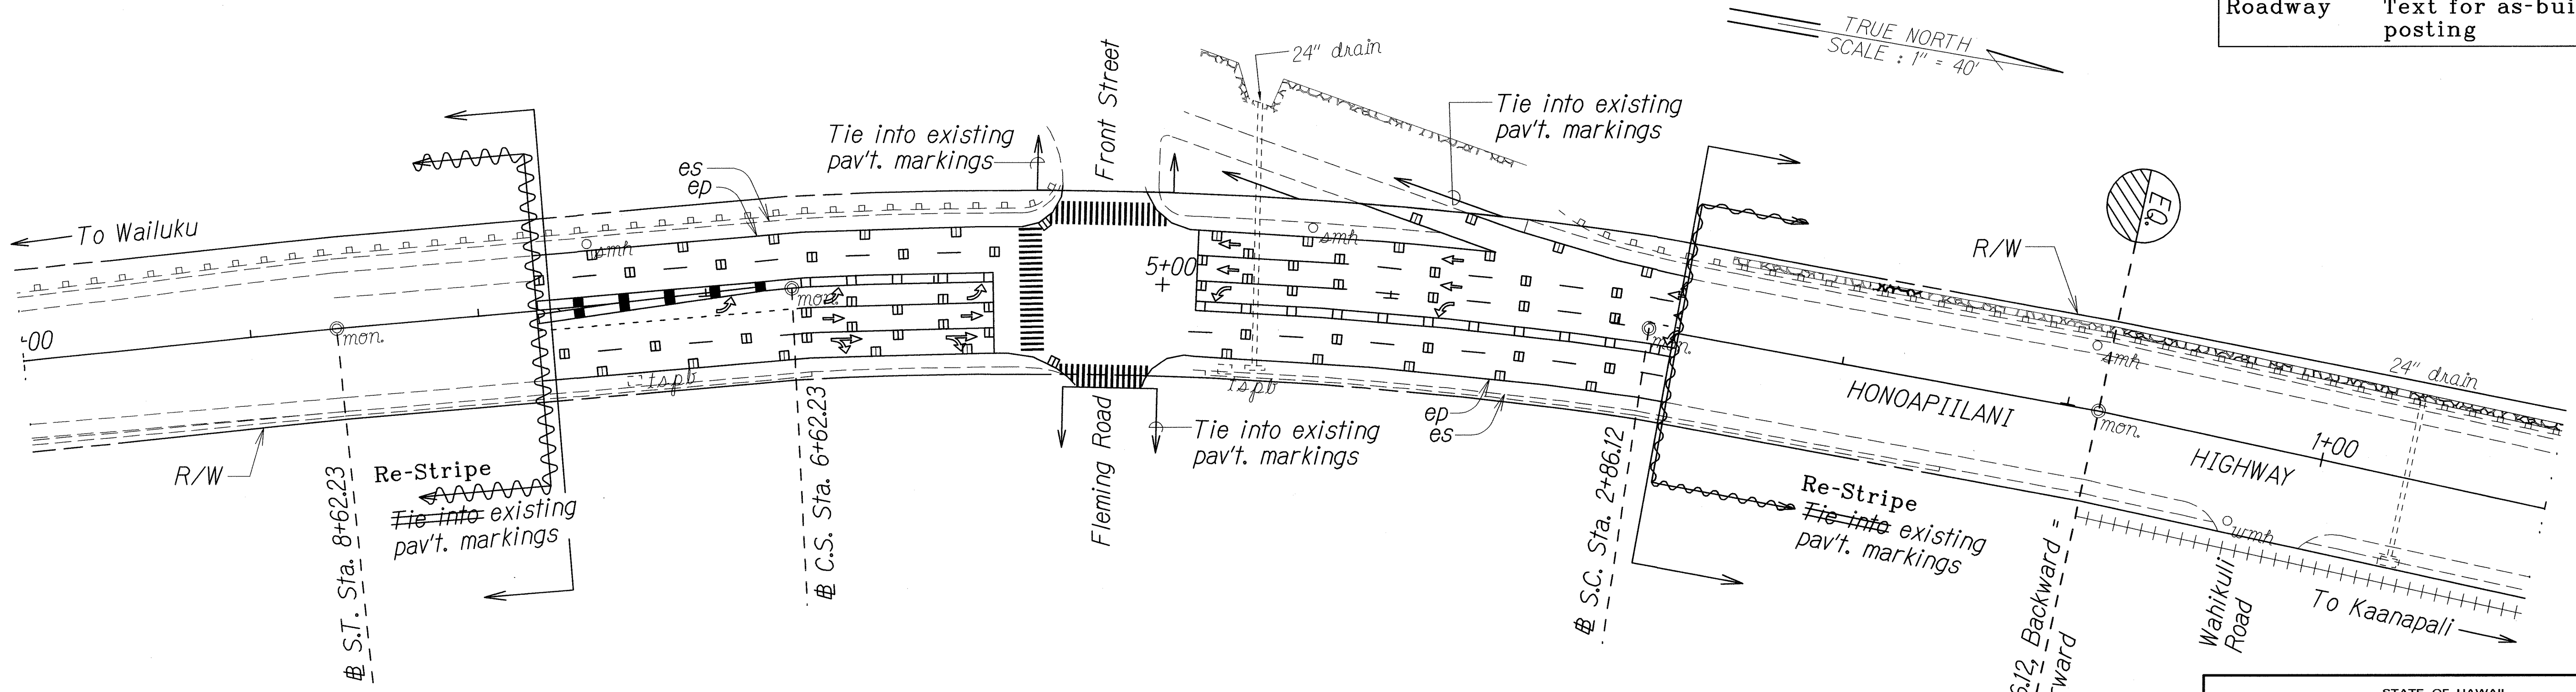

WORK AREA #8
INTERSECTION AT FLEMING RD. & FRONT ST. & HONOAPIILANI HIGHWAY
 Scale: 1" = 40'

STATE OF HAWAII
 DEPARTMENT OF TRANSPORTATION
 HIGHWAYS DIVISION

PAVEMENT MARKING PLAN


PAVEMENT MARKING AND STRIPING
 At Various Locations, Maui
 Project No. HWY-M-07-07M

Scale: 1" = 40' Date: April, 2007

ORIGINAL PLAN	SURVEY PLOTTED BY	DATE
NOTE BOOK	DRAWN BY	4/07
DESIGNED BY	CHECKED BY	
QUANTITIES BY		
DESIGNED BY		
CHECKED BY		


"AS-BUILT"

FED. ROAD DIST. NO.	STATE	PROJ. NO.	FISCAL YEAR	SHEET NO.	TOTAL SHEETS
HAWAII	HAW.	HWY-M-07-07M	2007	11	20

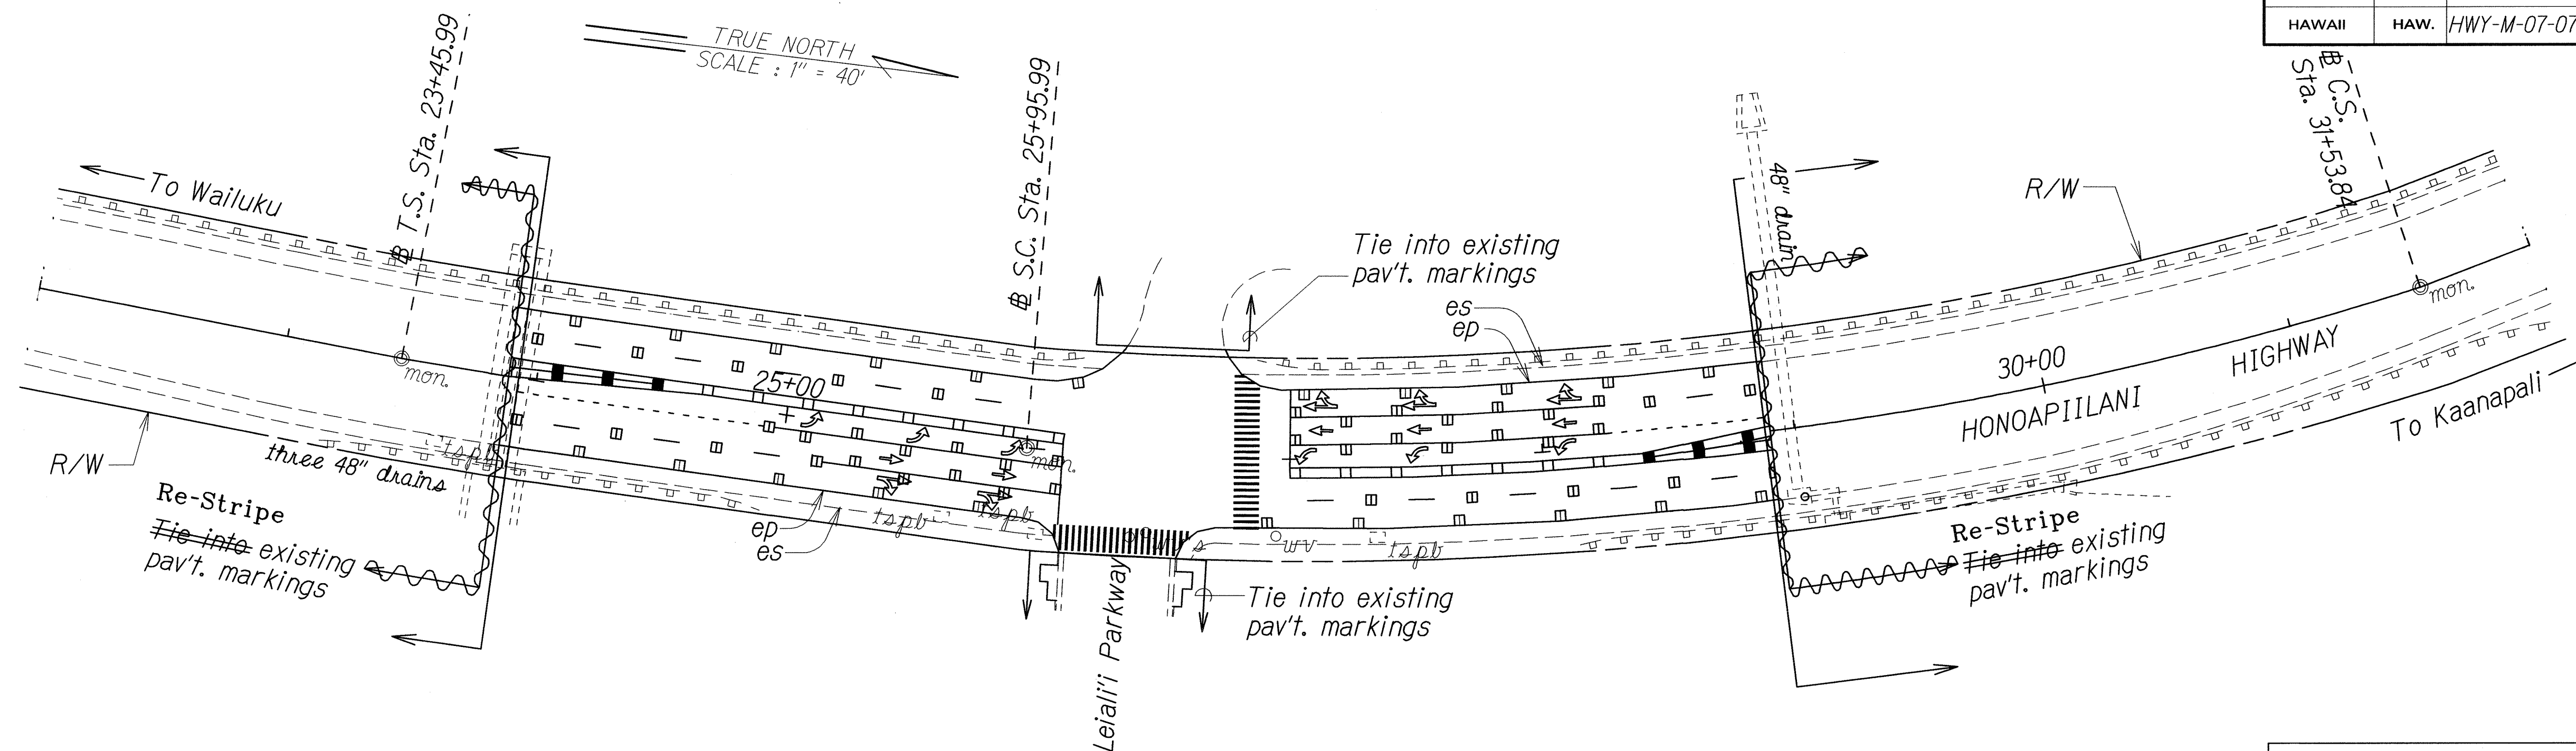

WORK AREA #9
INTERSECTION AT LEIALII PARKWAY & HONOAPIILANI HIGHWAY
Scale: 1" = 40'

LEGEND FOR AS-BUILT POSTINGS	
	Squiggly line for as-built deletion
	Double line for as-built deletion
Roadway	Text for as-built posting

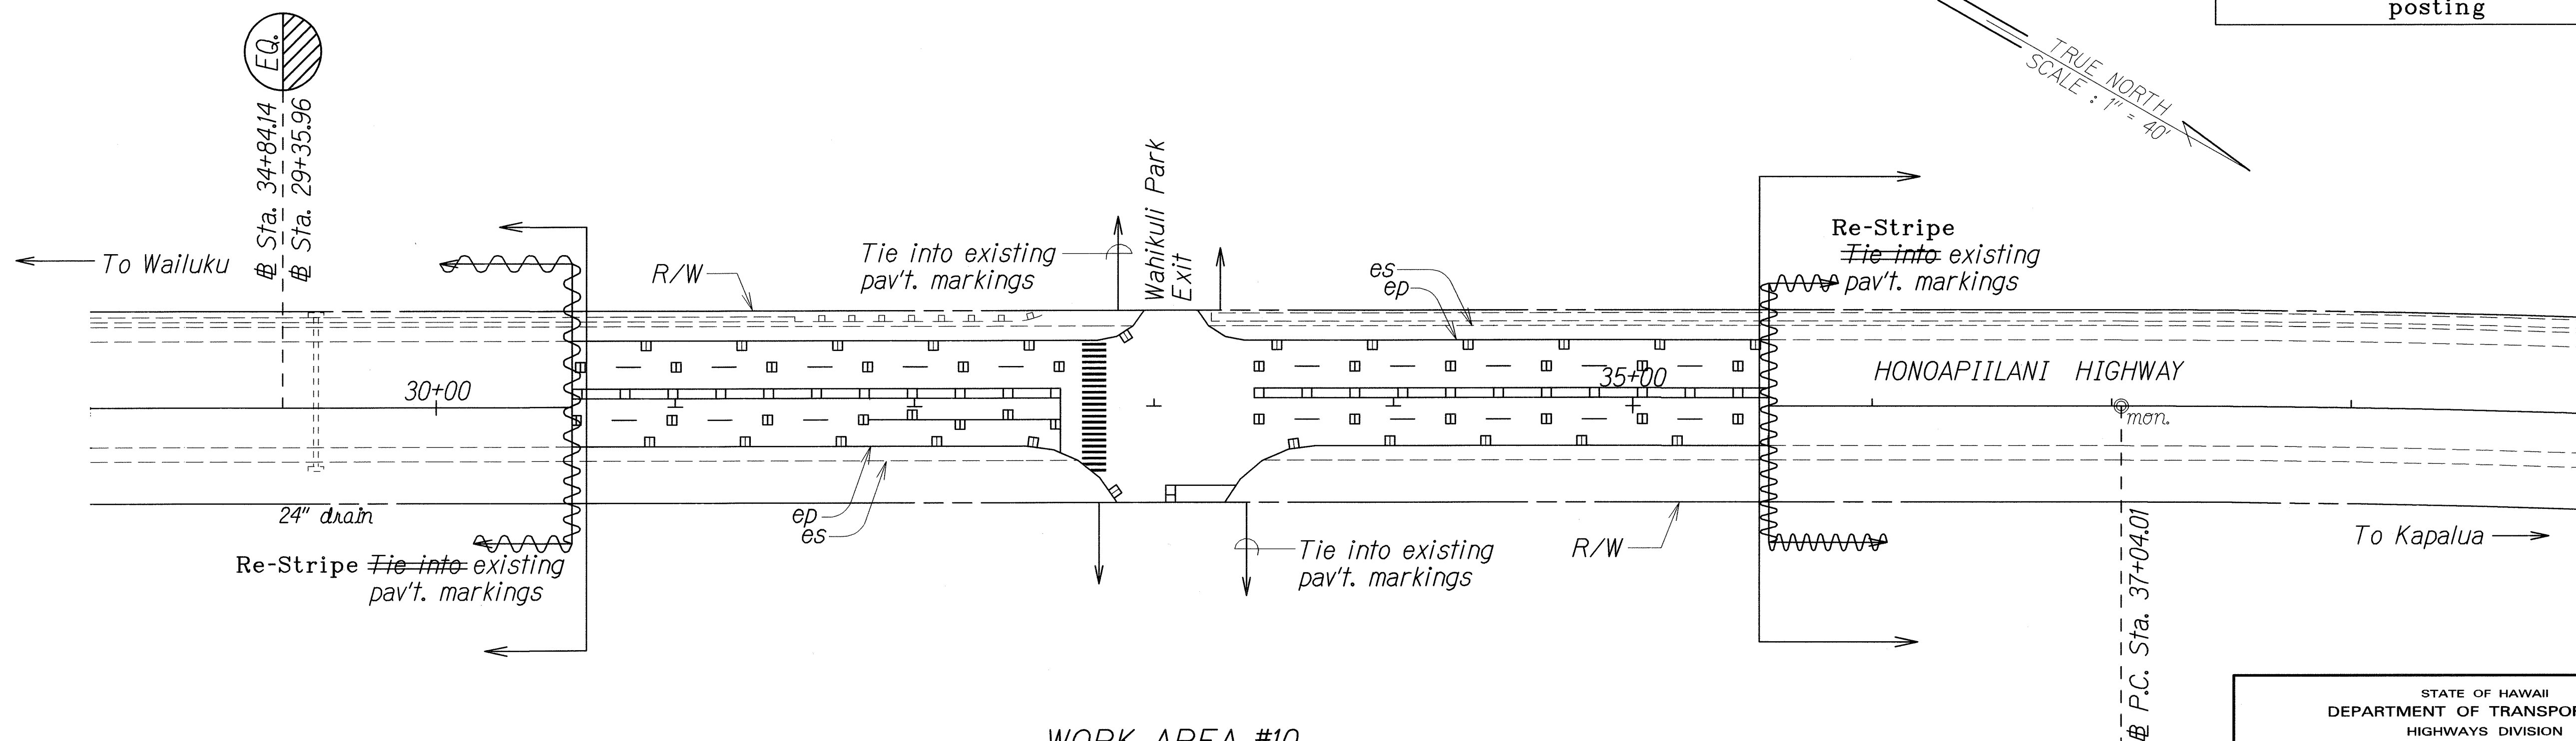


WORK AREA #10
INTERSECTION AT WAHIKULI PARK & HONOAPIILANI HIGHWAY
Scale: 1" = 40'

ORIGINAL PLAN	SURVEY PLOTTED BY	DATE
NOTE BOOK	DRAWN BY	4/07
QUANTITIES BY	TRACED BY	
CHECKED BY	QUANTITIES BY	

STATE OF HAWAII DEPARTMENT OF TRANSPORTATION HIGHWAYS DIVISION	
PAVEMENT MARKING PLAN	
PAVEMENT MARKING AND STRIPING At Various Locations, Maui Project No. HWY-M-07-07M	
Scale: 1" = 40'	Date: April, 2007
SHEET No. 5 OF 14 SHEETS	

"AS-BUILT"

FED. ROAD DIST. NO.	STATE	PROJ. NO.	FISCAL YEAR	SHEET NO.	TOTAL SHEETS
HAWAII	HAW.	HWY-M-07-07M	2007	12	20

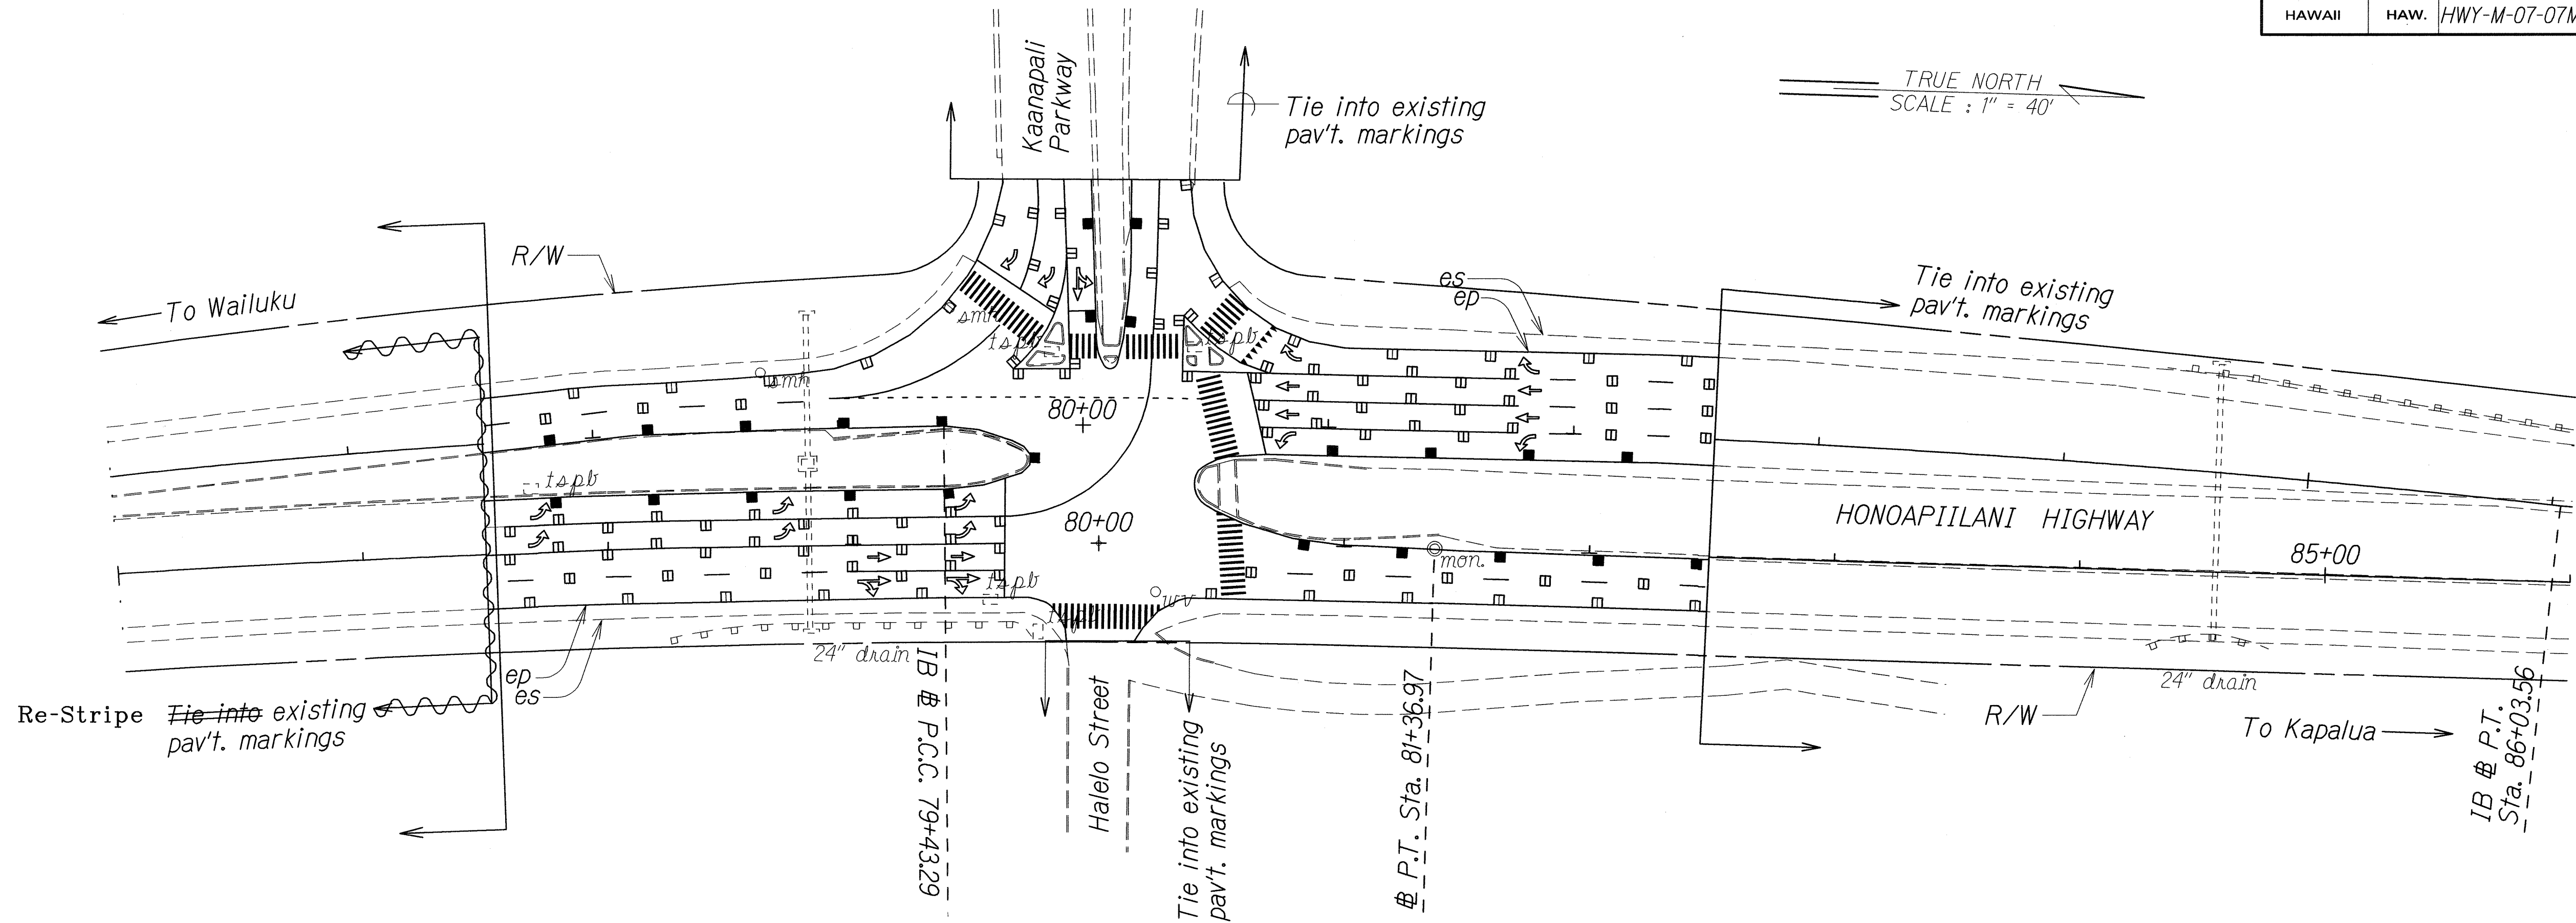

WORK AREA #11
INTERSECTION AT KAAPALI PARKWAY & HALELO ST. & HONOAPIILANI HIGHWAY
Scale: 1" = 40'

LEGEND FOR AS-BUILT POSTINGS	
	Squiggly line for as-built deletion
	Double line for as-built deletion
Roadway	Text for as-built posting


STATE OF HAWAII
DEPARTMENT OF TRANSPORTATION
HIGHWAYS DIVISION

PAVEMENT MARKING PLAN
PAVEMENT MARKING AND STRIPING
At Various Locations, Maui
Project No. HWY-M-07-07M
Scale: 1" = 40' Date: April, 2007
SHEET No. 6 OF 14 SHEETS

ORIGINAL PLAN	SURVEY PLOTTED BY	DATE
NOTE BOOK	DRAWN BY	4/07
DESIGNED BY	DESIGNED BY	
QUANTITIES BY	QUANTITIES BY	
CHECKED BY	CHECKED BY	

"AS-BUILT"

FED. ROAD DIST. NO.	STATE	PROJ. NO.	FISCAL YEAR	SHEET NO.	TOTAL SHEETS
HAWAII	HAW.	HWY-M-07-07M	2007	13	20

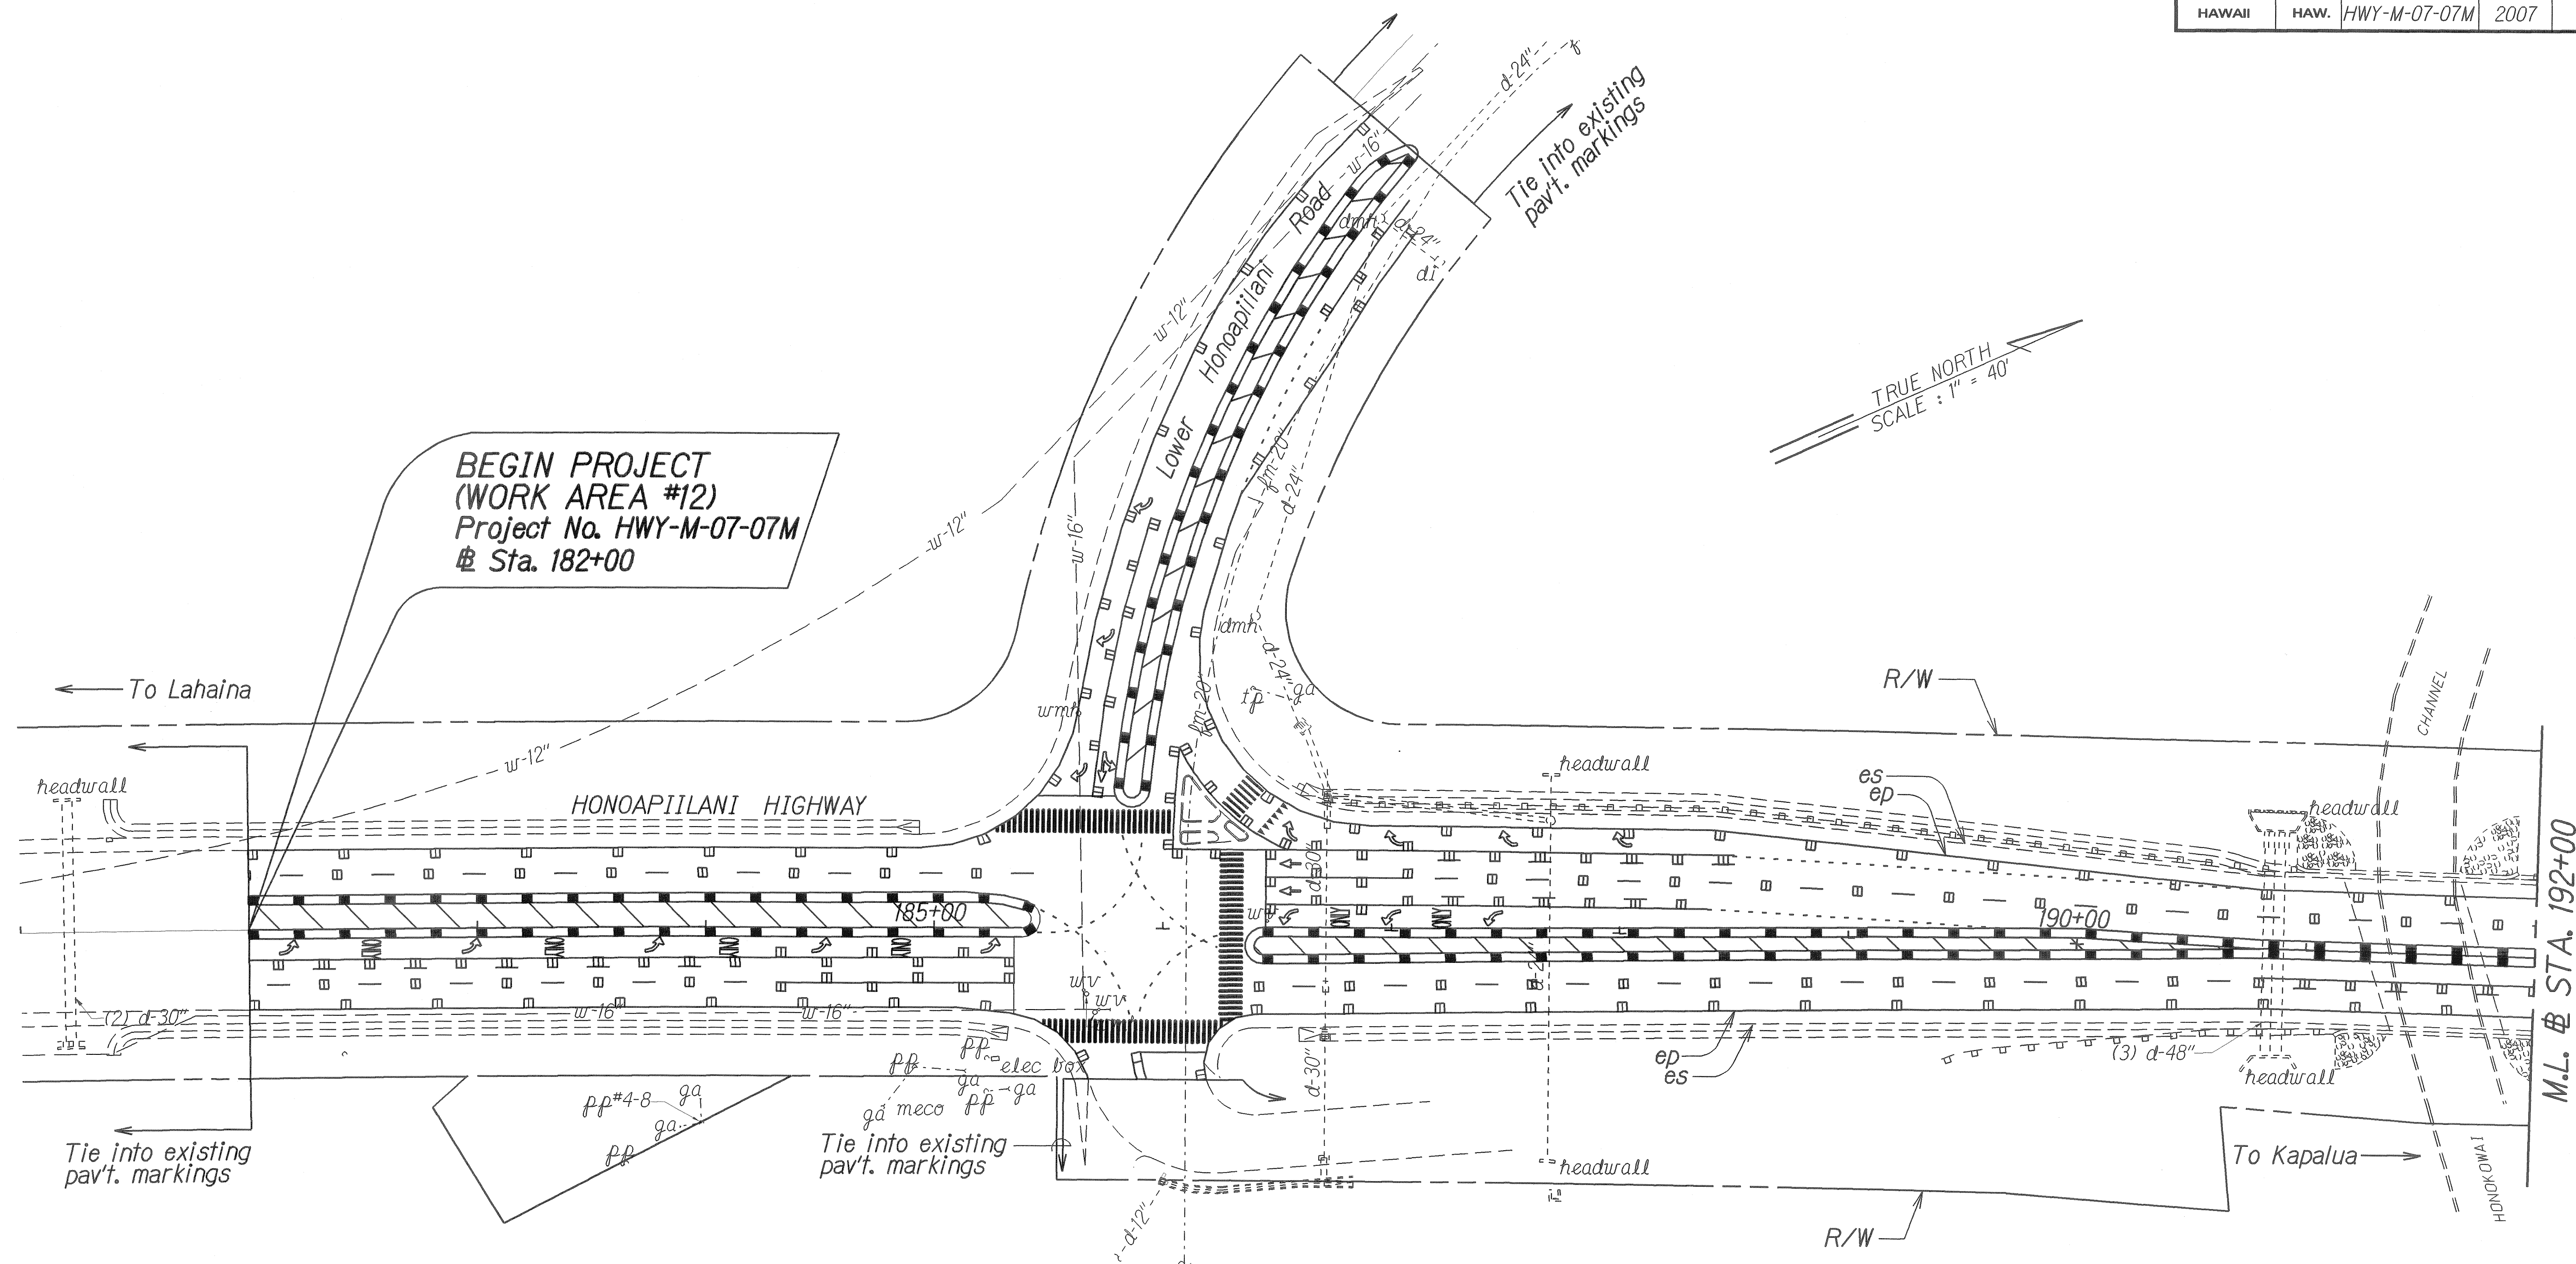

SURVEY PLOTTED BY	DATE
DRIVEN BY	4/07
DESIGNED BY	
QUANTITIES BY	
CHECKED BY	




STATE OF HAWAII
DEPARTMENT OF TRANSPORTATION
HIGHWAYS DIVISION

PAVEMENT MARKING PLAN
PAVEMENT MARKING AND STRIPING
At Various Locations, Maui
Project No. HWY-M-07-07M


Scale: 1" = 40' Date: April, 2007

SHEET No. 7 OF 14 SHEETS

FED. ROAD DIST. NO.	STATE	PROJ. NO.	FISCAL YEAR	SHEET NO.	TOTAL SHEETS
HAWAII	HAW.	HWY-M-07-07M	2007	14	20

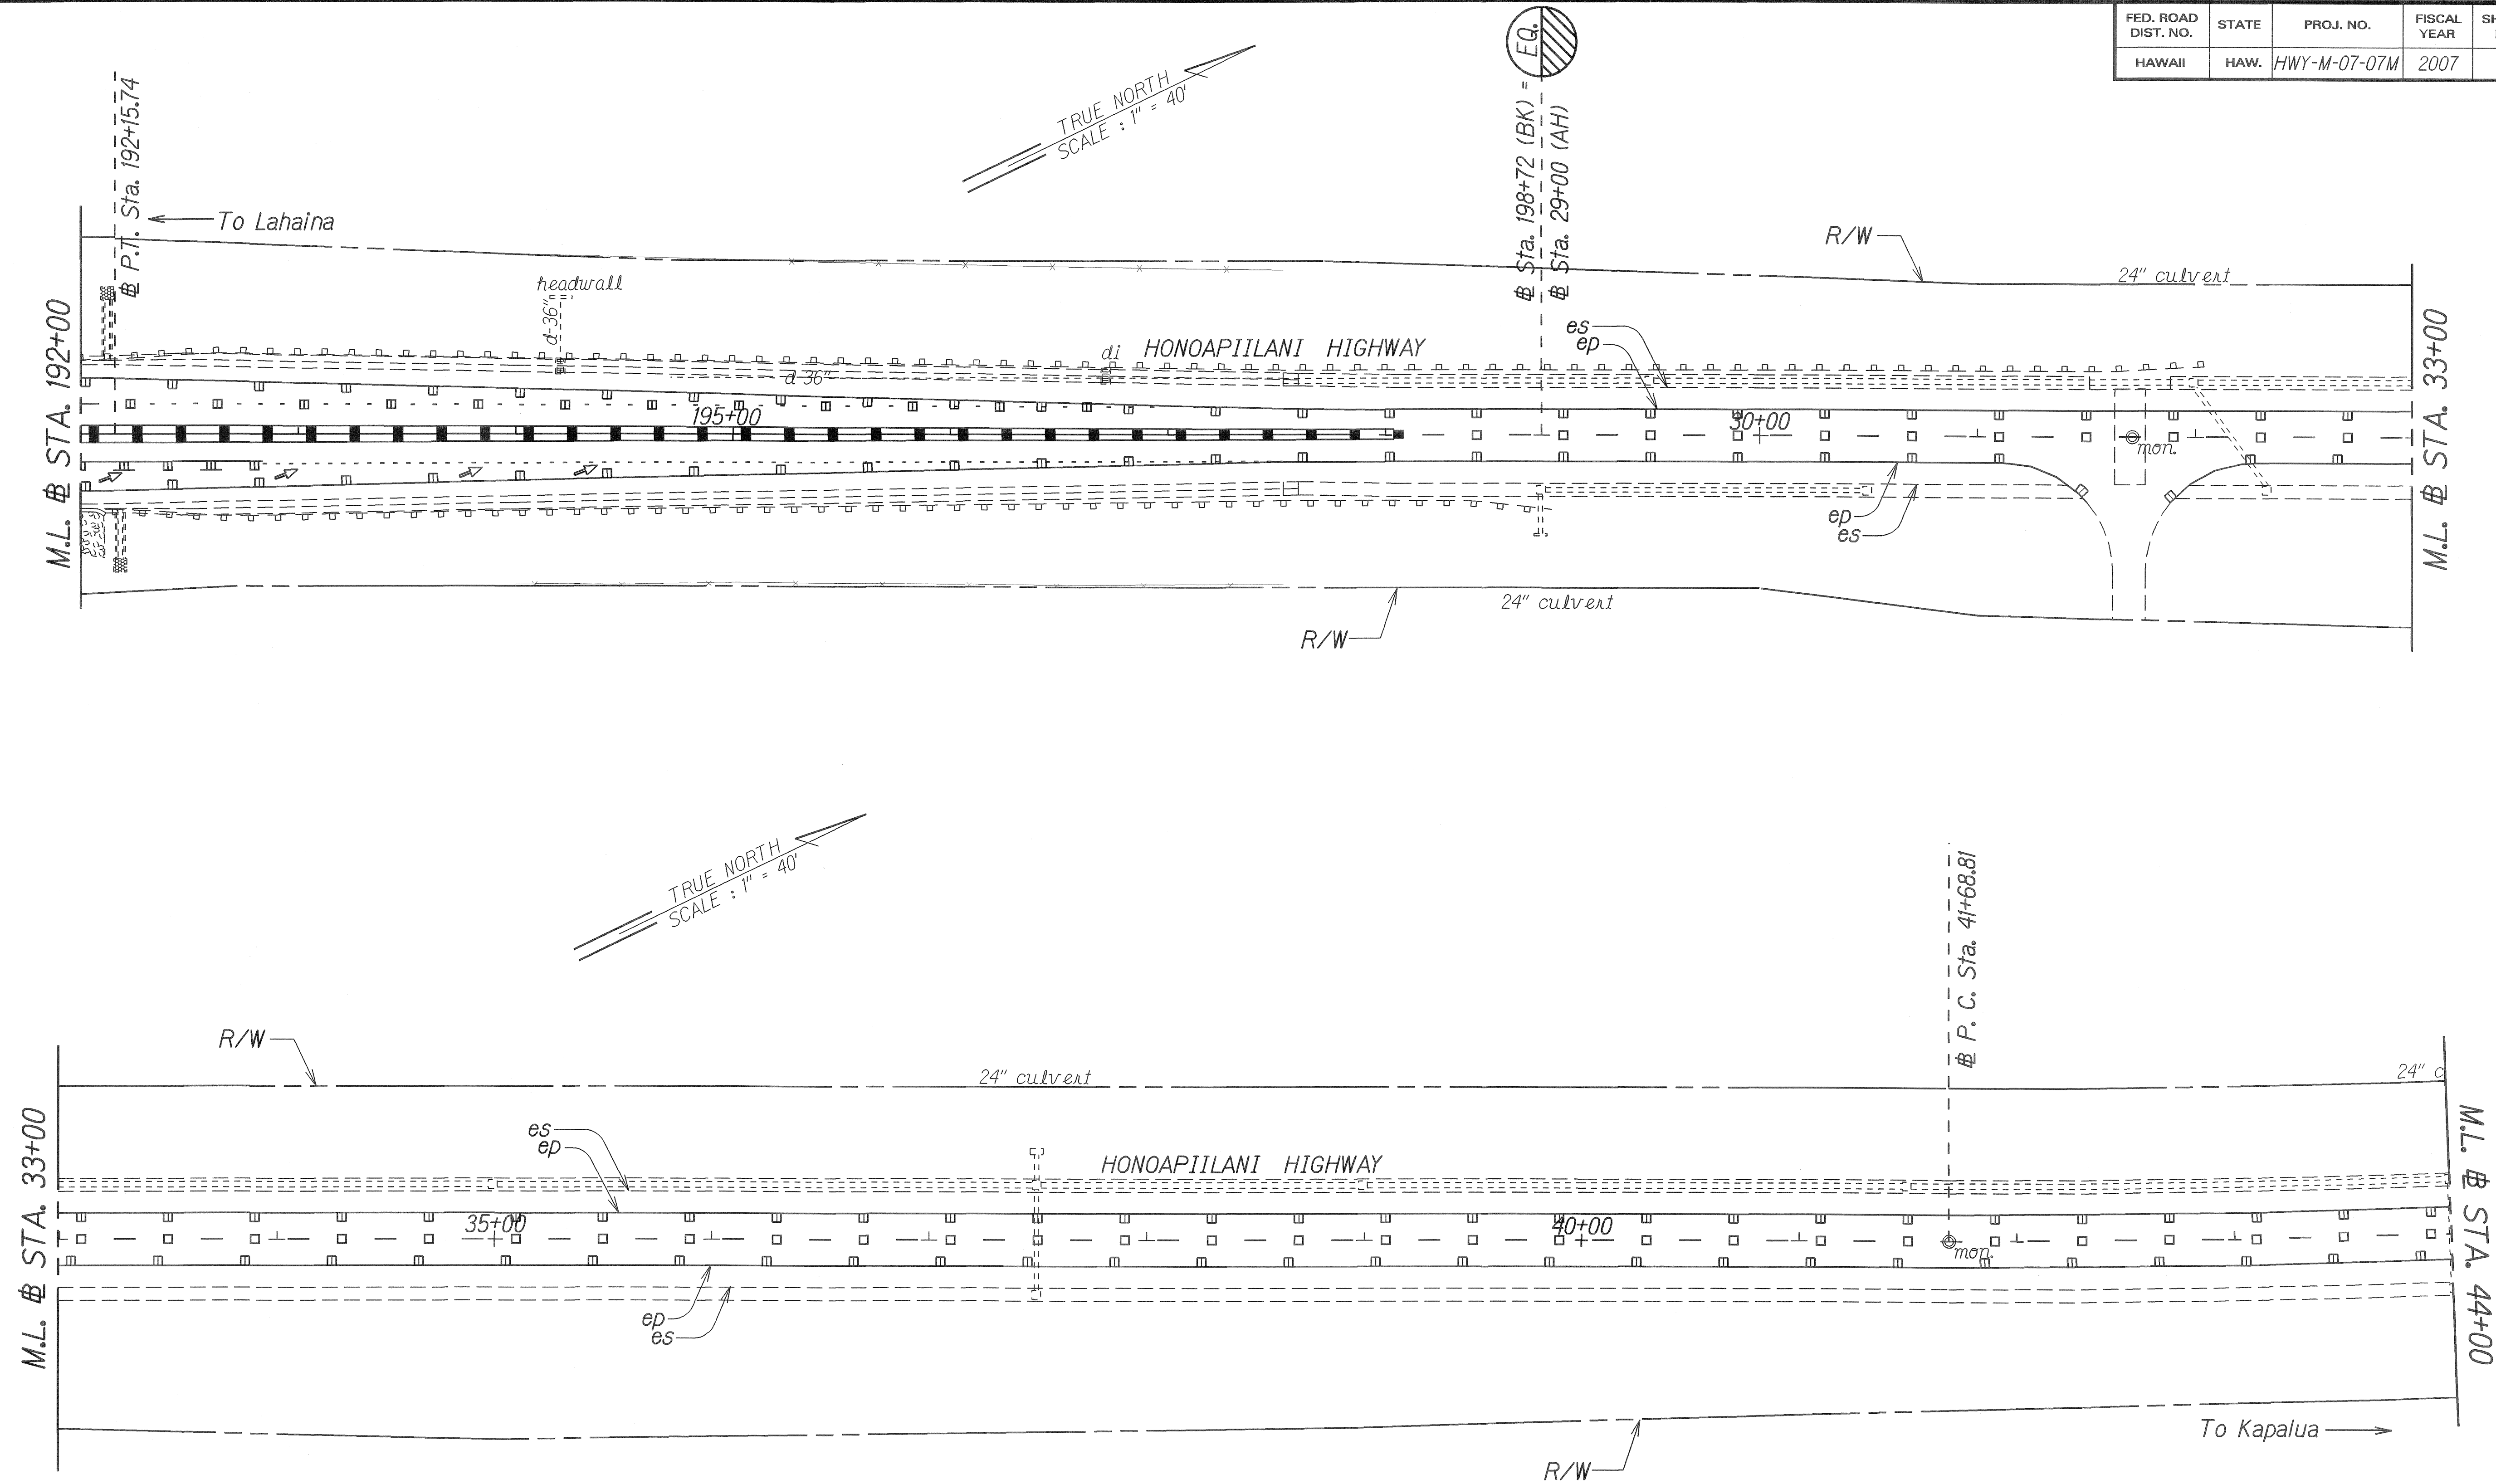

ORIGINAL PLAN	SURVEY PLOTTED BY	DATE
NOTED BOOK	DRAWN BY	4/07
DESIGNED BY	TRACED BY	
CHECKED BY	DESIGNED BY	
APPROVED BY	CHECKED BY	

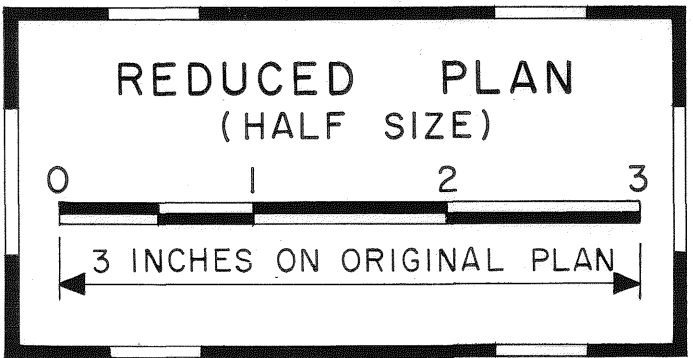

STATE OF HAWAII
DEPARTMENT OF TRANSPORTATION
HIGHWAYS DIVISION

PAVEMENT MARKING PLAN

PAVEMENT MARKING AND STRIPING



At Various Locations, Maui

Project No. HWY-M-07-07M


Scale: 1" = 40' Date: April, 2007

SHEET No. 8 OF 14 SHEETS

FED. ROAD DIST. NO.	STATE	PROJ. NO.	FISCAL YEAR	SHEET NO.	TOTAL SHEETS
HAWAII	HAW.	HWY-M-07-07M	2007	15	20

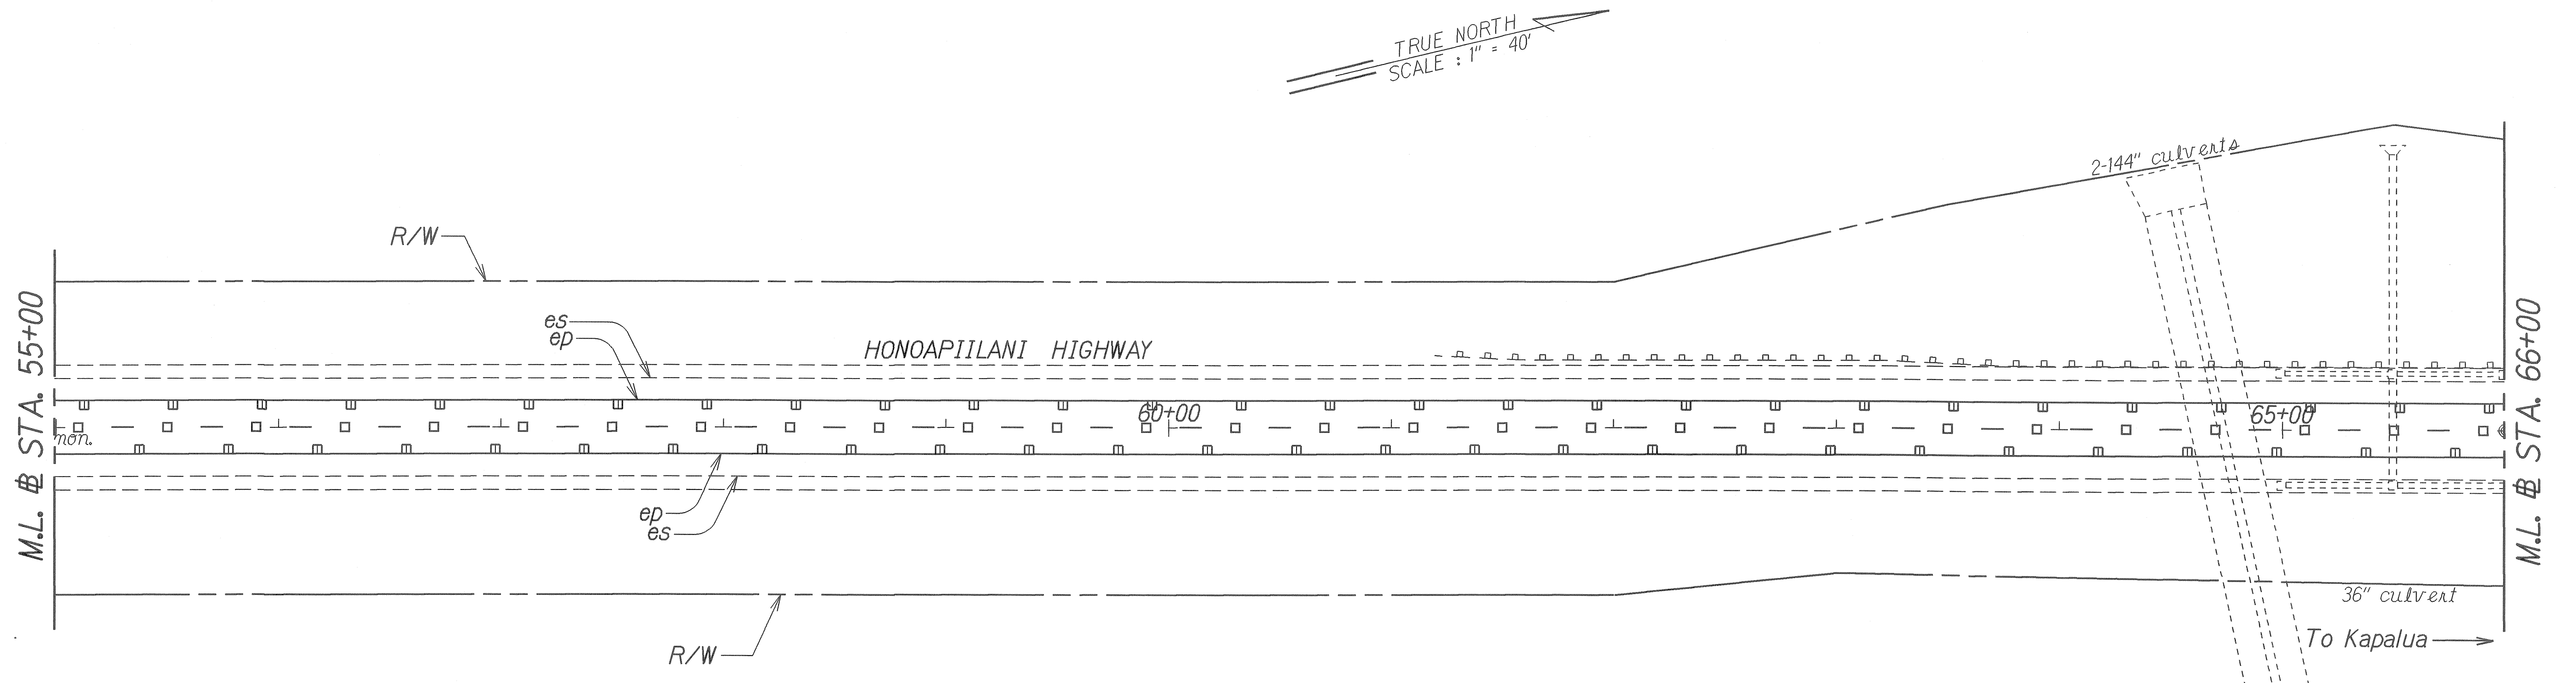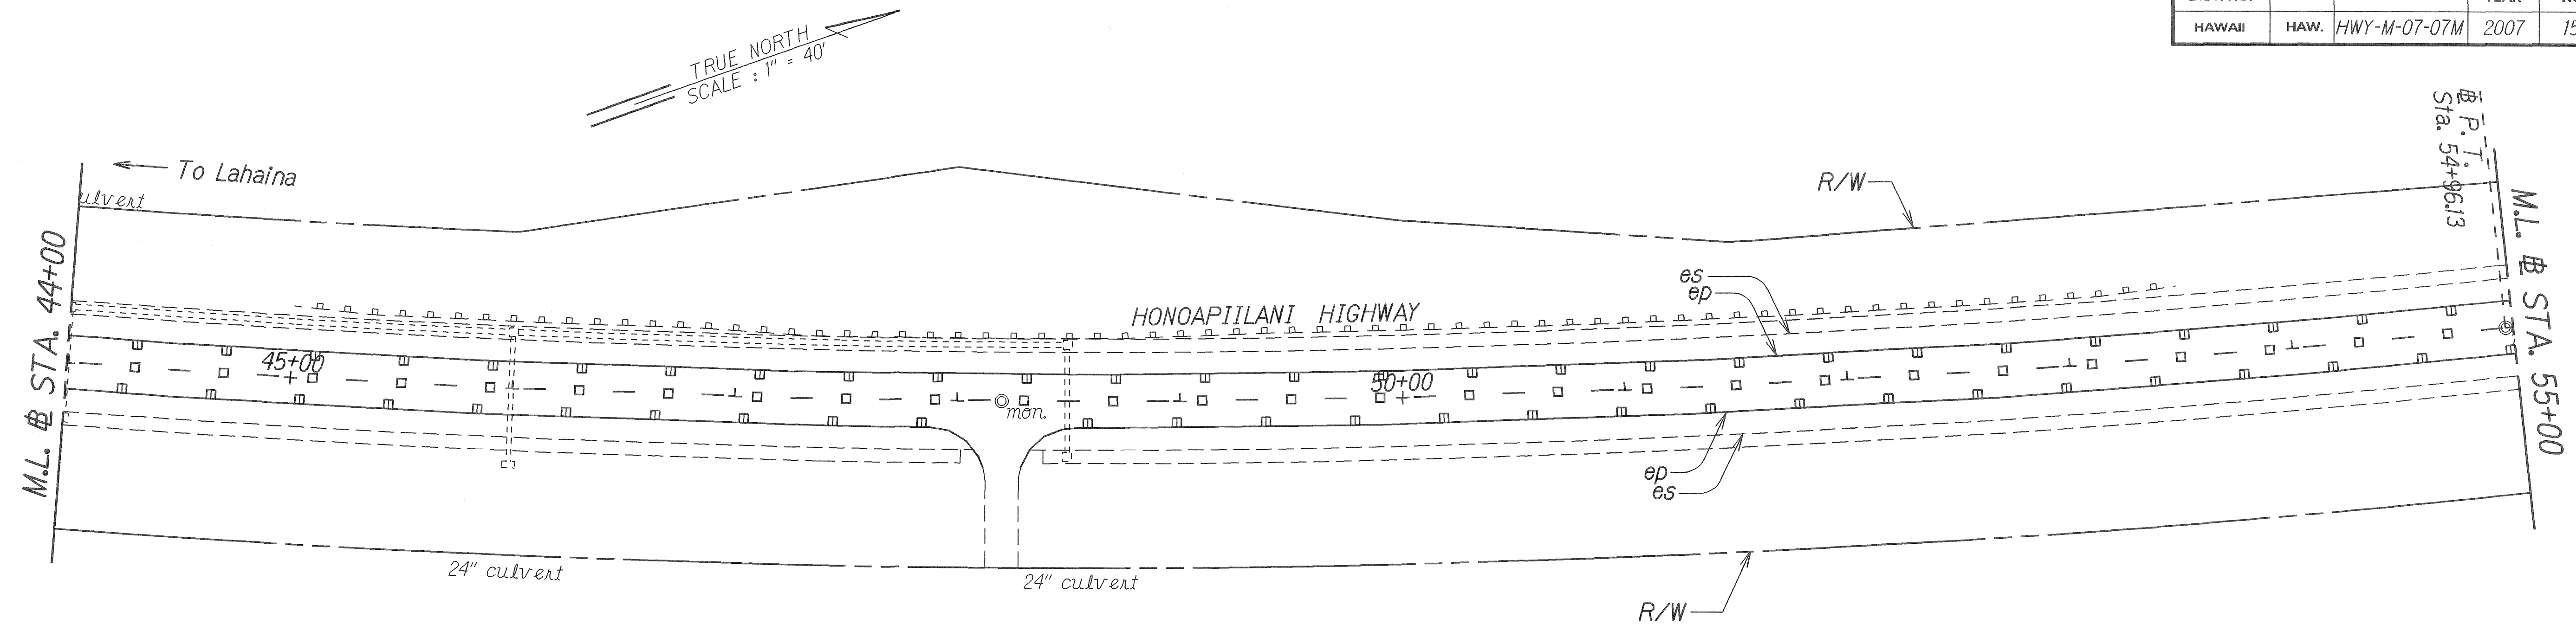

ORIGINAL PLAN	DATE
DESIGNED BY	4/07
TRACED BY	
NOTED BY	
QUANTITIES BY	
CHECKED BY	

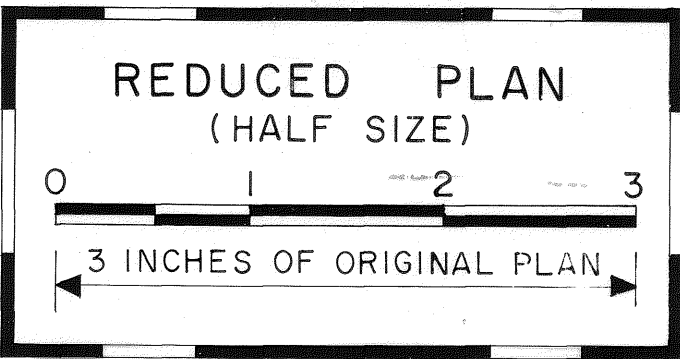

STATE OF HAWAII
DEPARTMENT OF TRANSPORTATION
HIGHWAYS DIVISION



PAVEMENT MARKING PLAN

PAVEMENT MARKING AND STRIPING
At Various Locations, Maui
Project No. HWY-M-07-07M

Scale: 1" = 40' Date: April, 2007

SHEET No. 9 OF 14 SHEETS

FED. ROAD DIST. NO.	STATE	PROJ. NO.	FISCAL YEAR	SHEET NO.	TOTAL SHEETS
HAWAII	HAW.	HWY-M-07-07M	2007	16	20

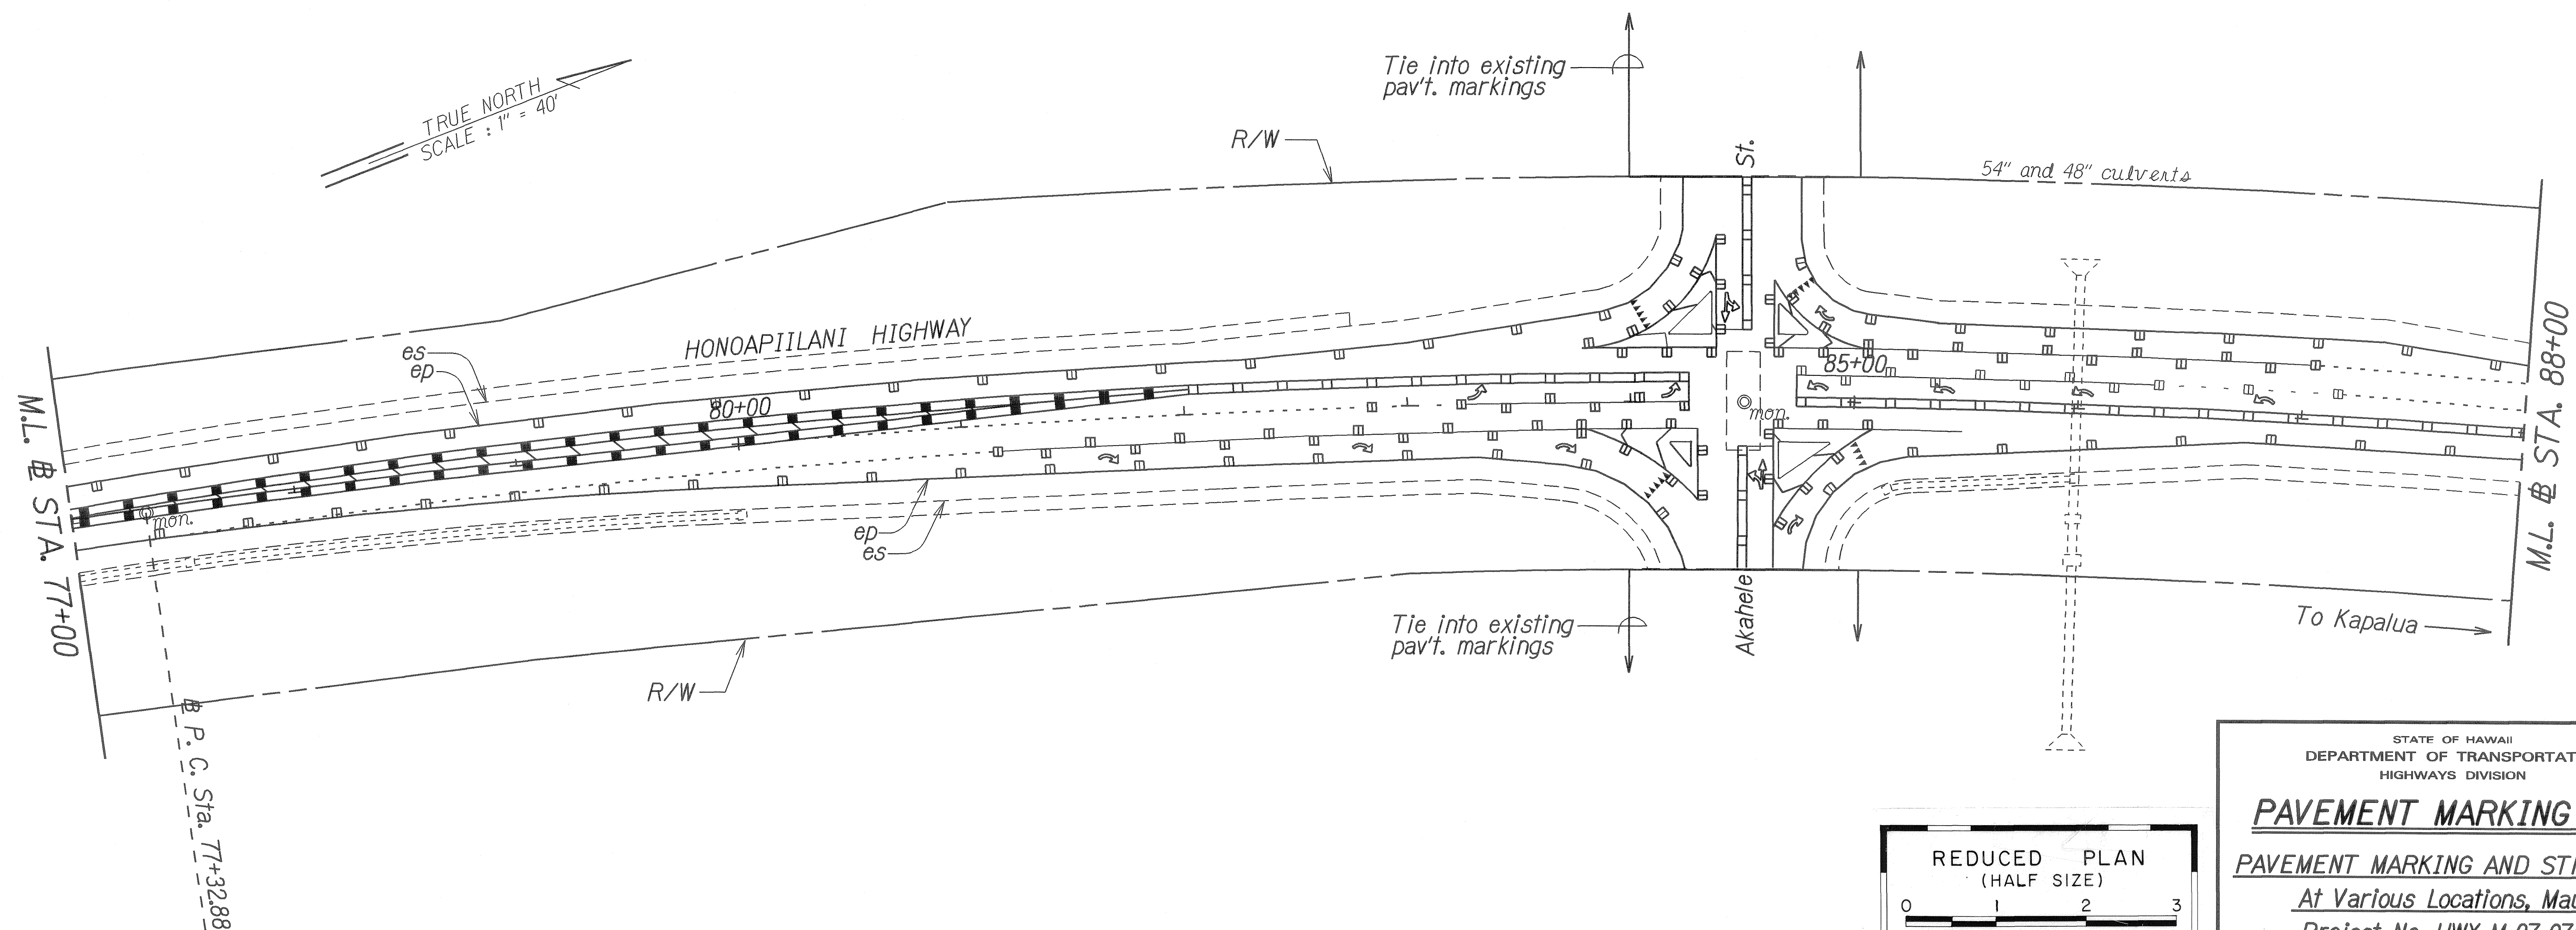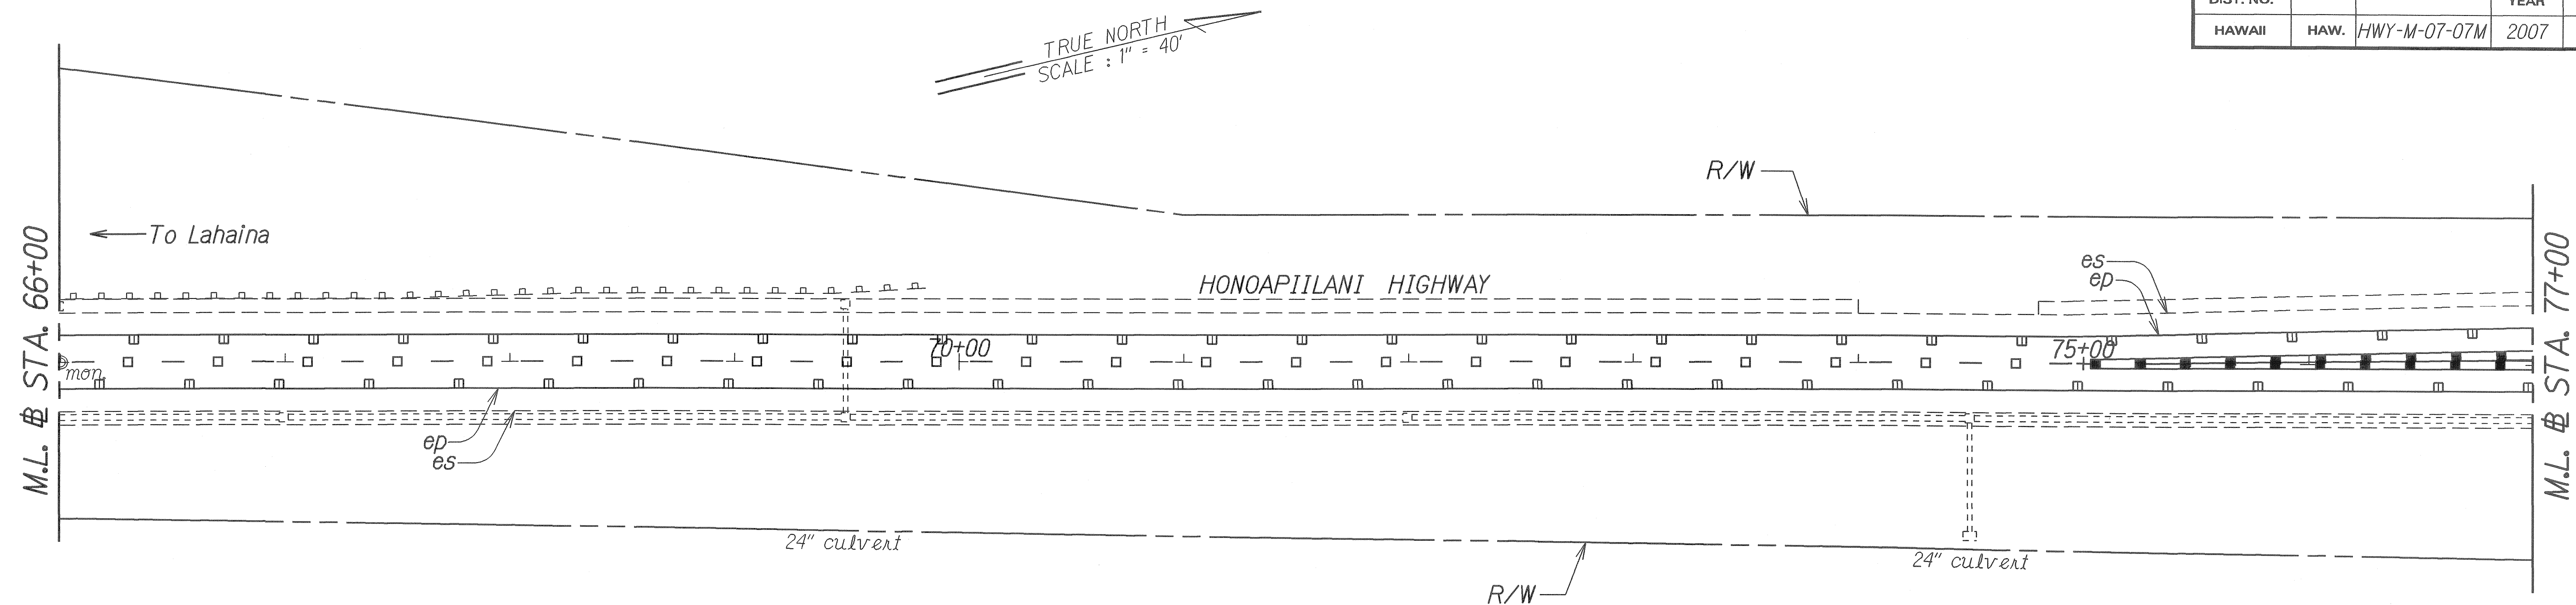

ORIGINAL PLAN	SURVEY PLOTTED BY _____	DATE _____
NOTE BOOK	DRAWN BY <i>40</i>	_____
<i>meljay</i>	TRACED BY _____	_____
<i>hamspldgn</i>	DESIGNED BY <i>73</i>	_____
	QUANTITIES BY _____	_____
	CHECKED BY _____	_____

STATE OF HAWAII
DEPARTMENT OF TRANSPORTATION
HIGHWAYS DIVISION

PAVEMENT MARKING PLAN

PAVEMENT MARKING AND STRIPING

At Various Locations, Maui

Project No. HWY-M-07-07M



Scale: 1" = 40'

Date: April, 2007


SHEET No. 10 OF 14 SHEETS



FED. ROAD DIST. NO.	STATE	PROJ. NO.	FISCAL YEAR	SHEET NO.	TOTAL SHEETS
HAWAII	HAW.	HWY-M-07-07M	2007	17	20

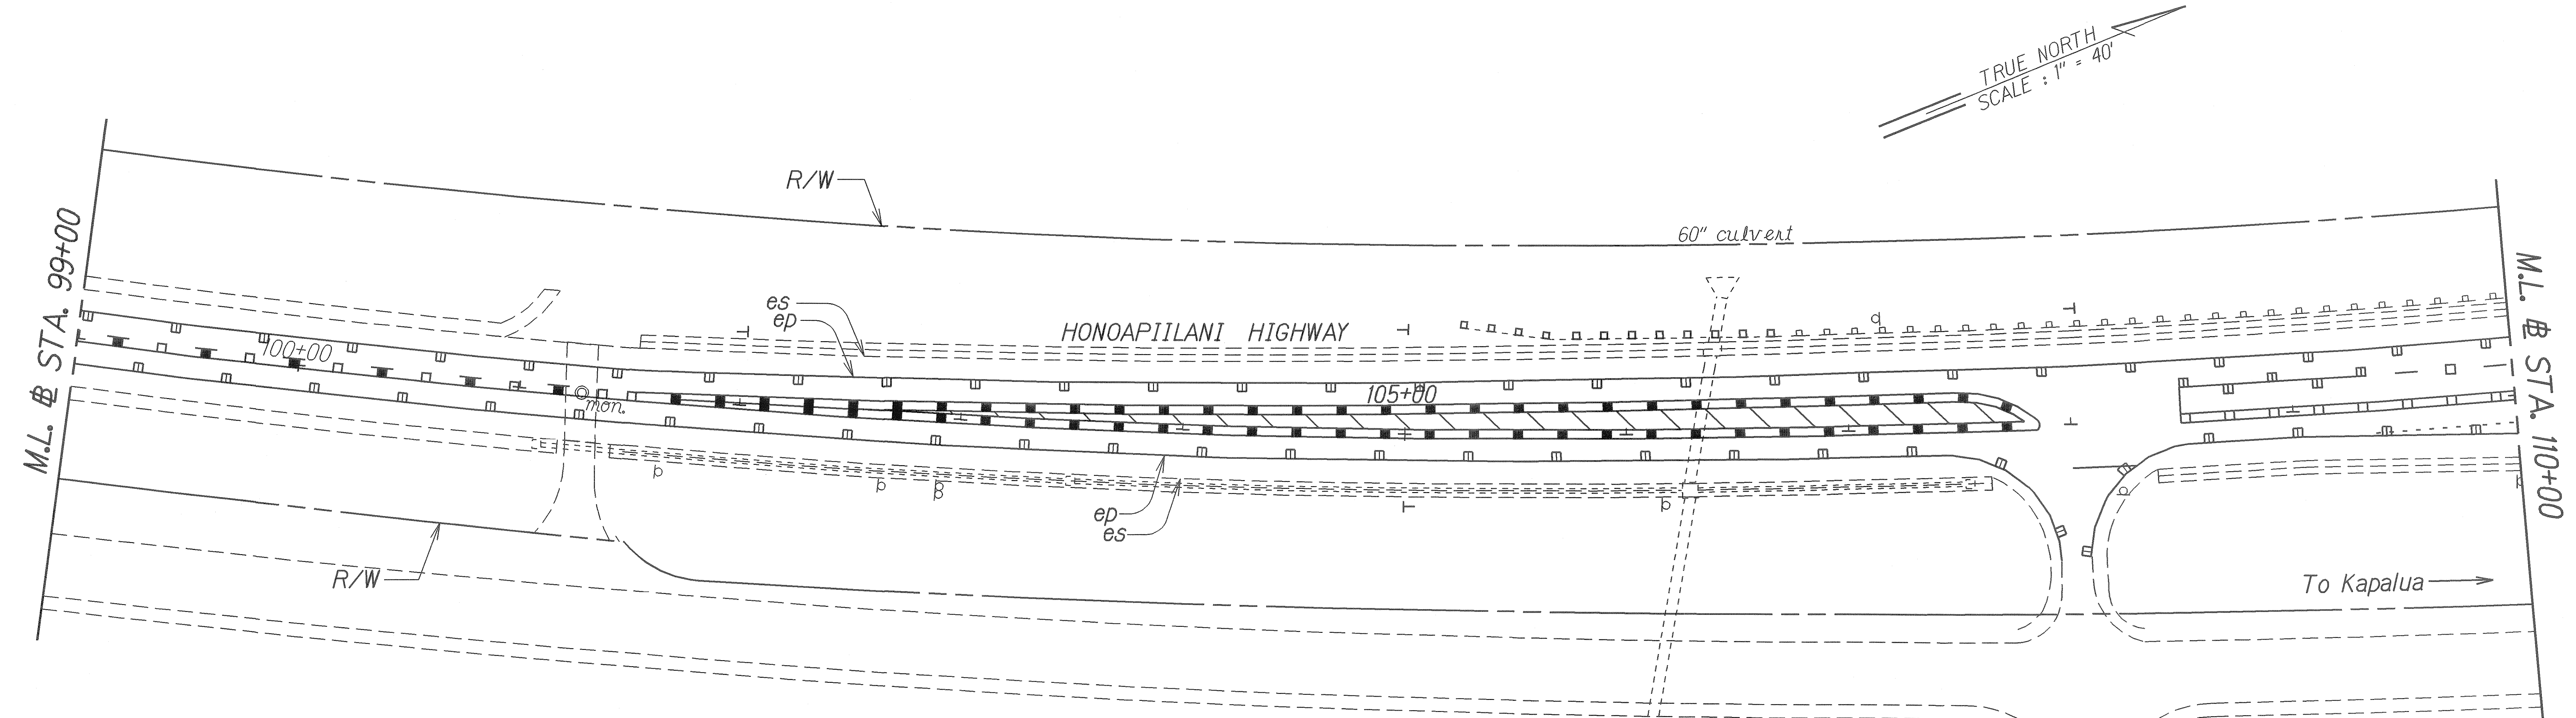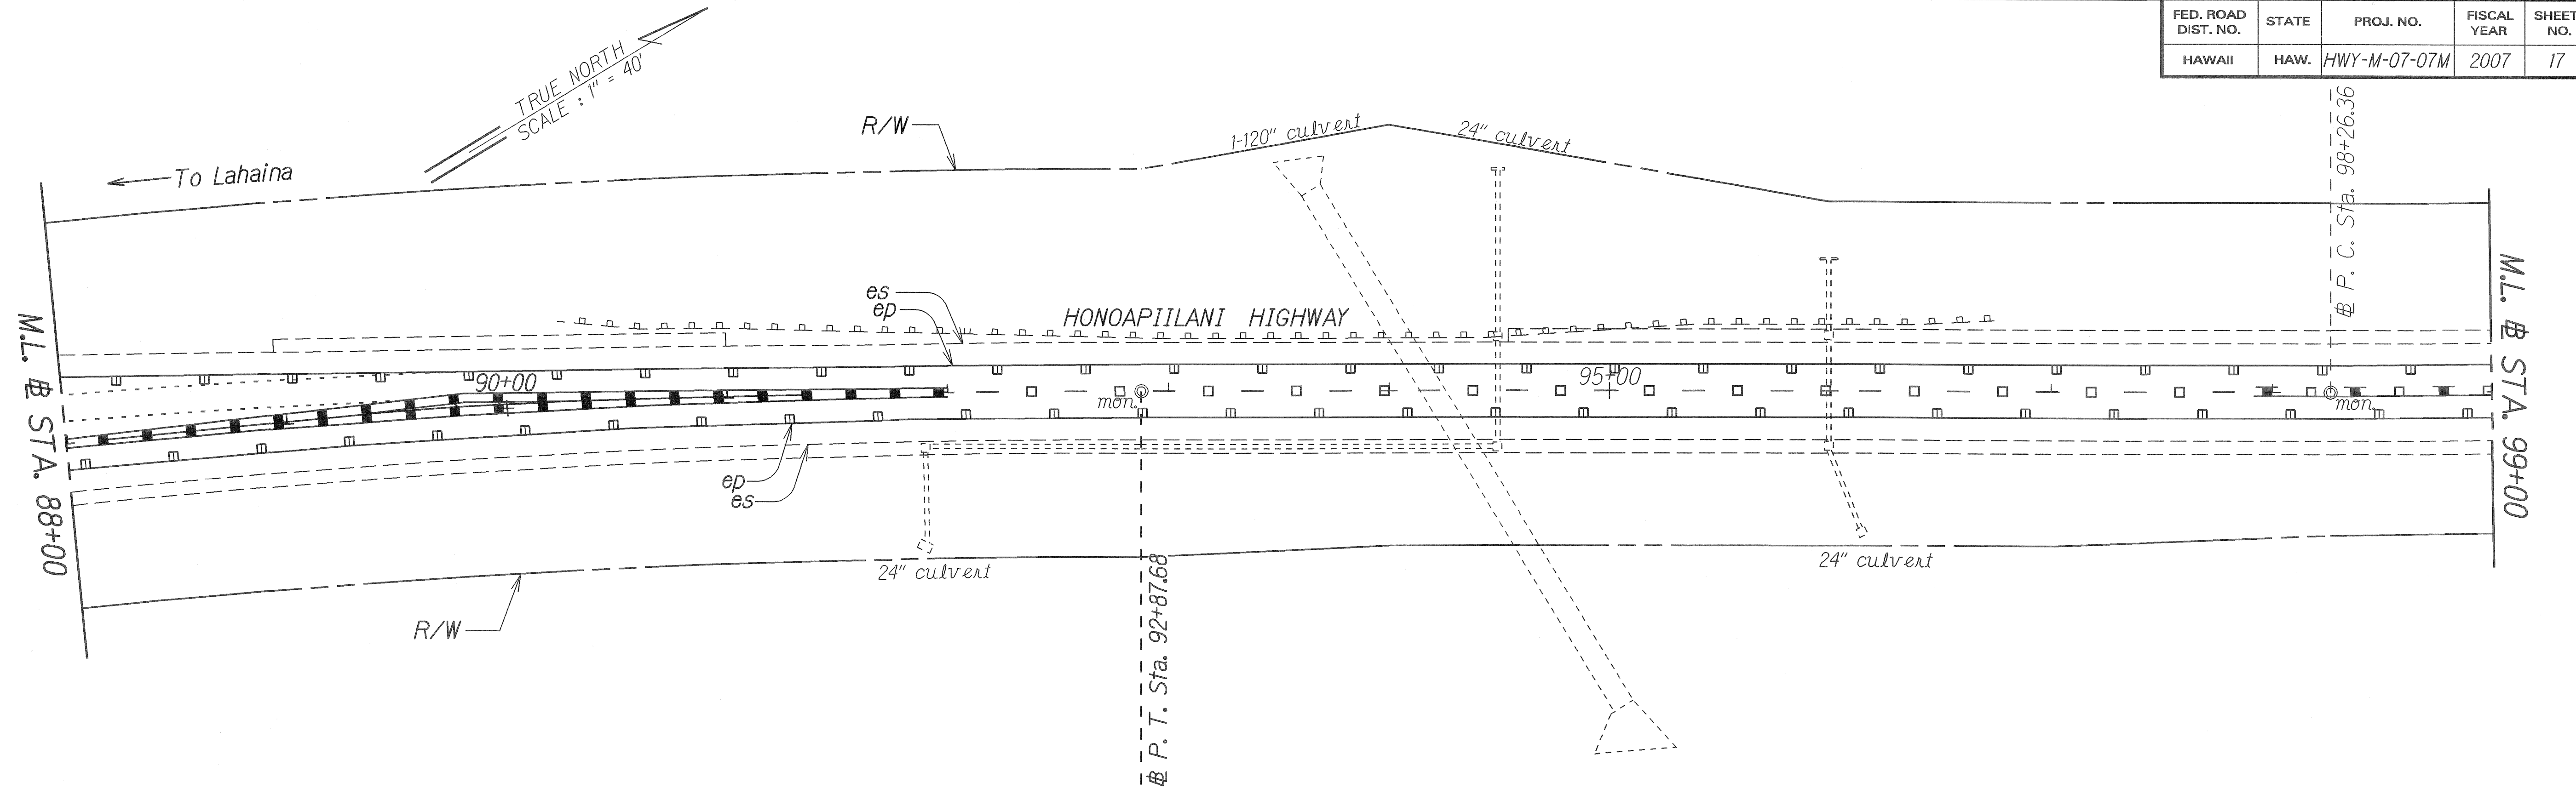

ORIGINAL PLAN	SURVEY PLOTTED BY	DATE
NOTE BOOK	DESIGNED BY	4/07
QUANTITIES BY	CHECKED BY	

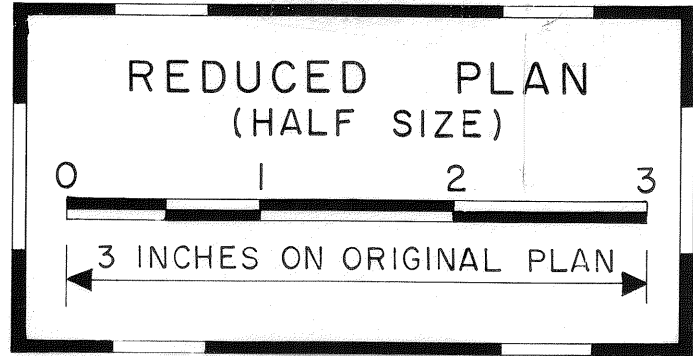

STATE OF HAWAII
DEPARTMENT OF TRANSPORTATION
HIGHWAYS DIVISION


PAVEMENT MARKING PLAN

PAVEMENT MARKING AND STRIPING
At Various Locations, Maui
Project No. HWY-M-07-07M


Scale: 1" = 40' Date: April, 2007

SHEET No. 11 OF 14 SHEETS

FED. ROAD DIST. NO.	STATE	PROJ. NO.	FISCAL YEAR	SHEET NO.	TOTAL SHEETS
HAWAII	HAW.	HWY-M-07-07M	2007	18	20

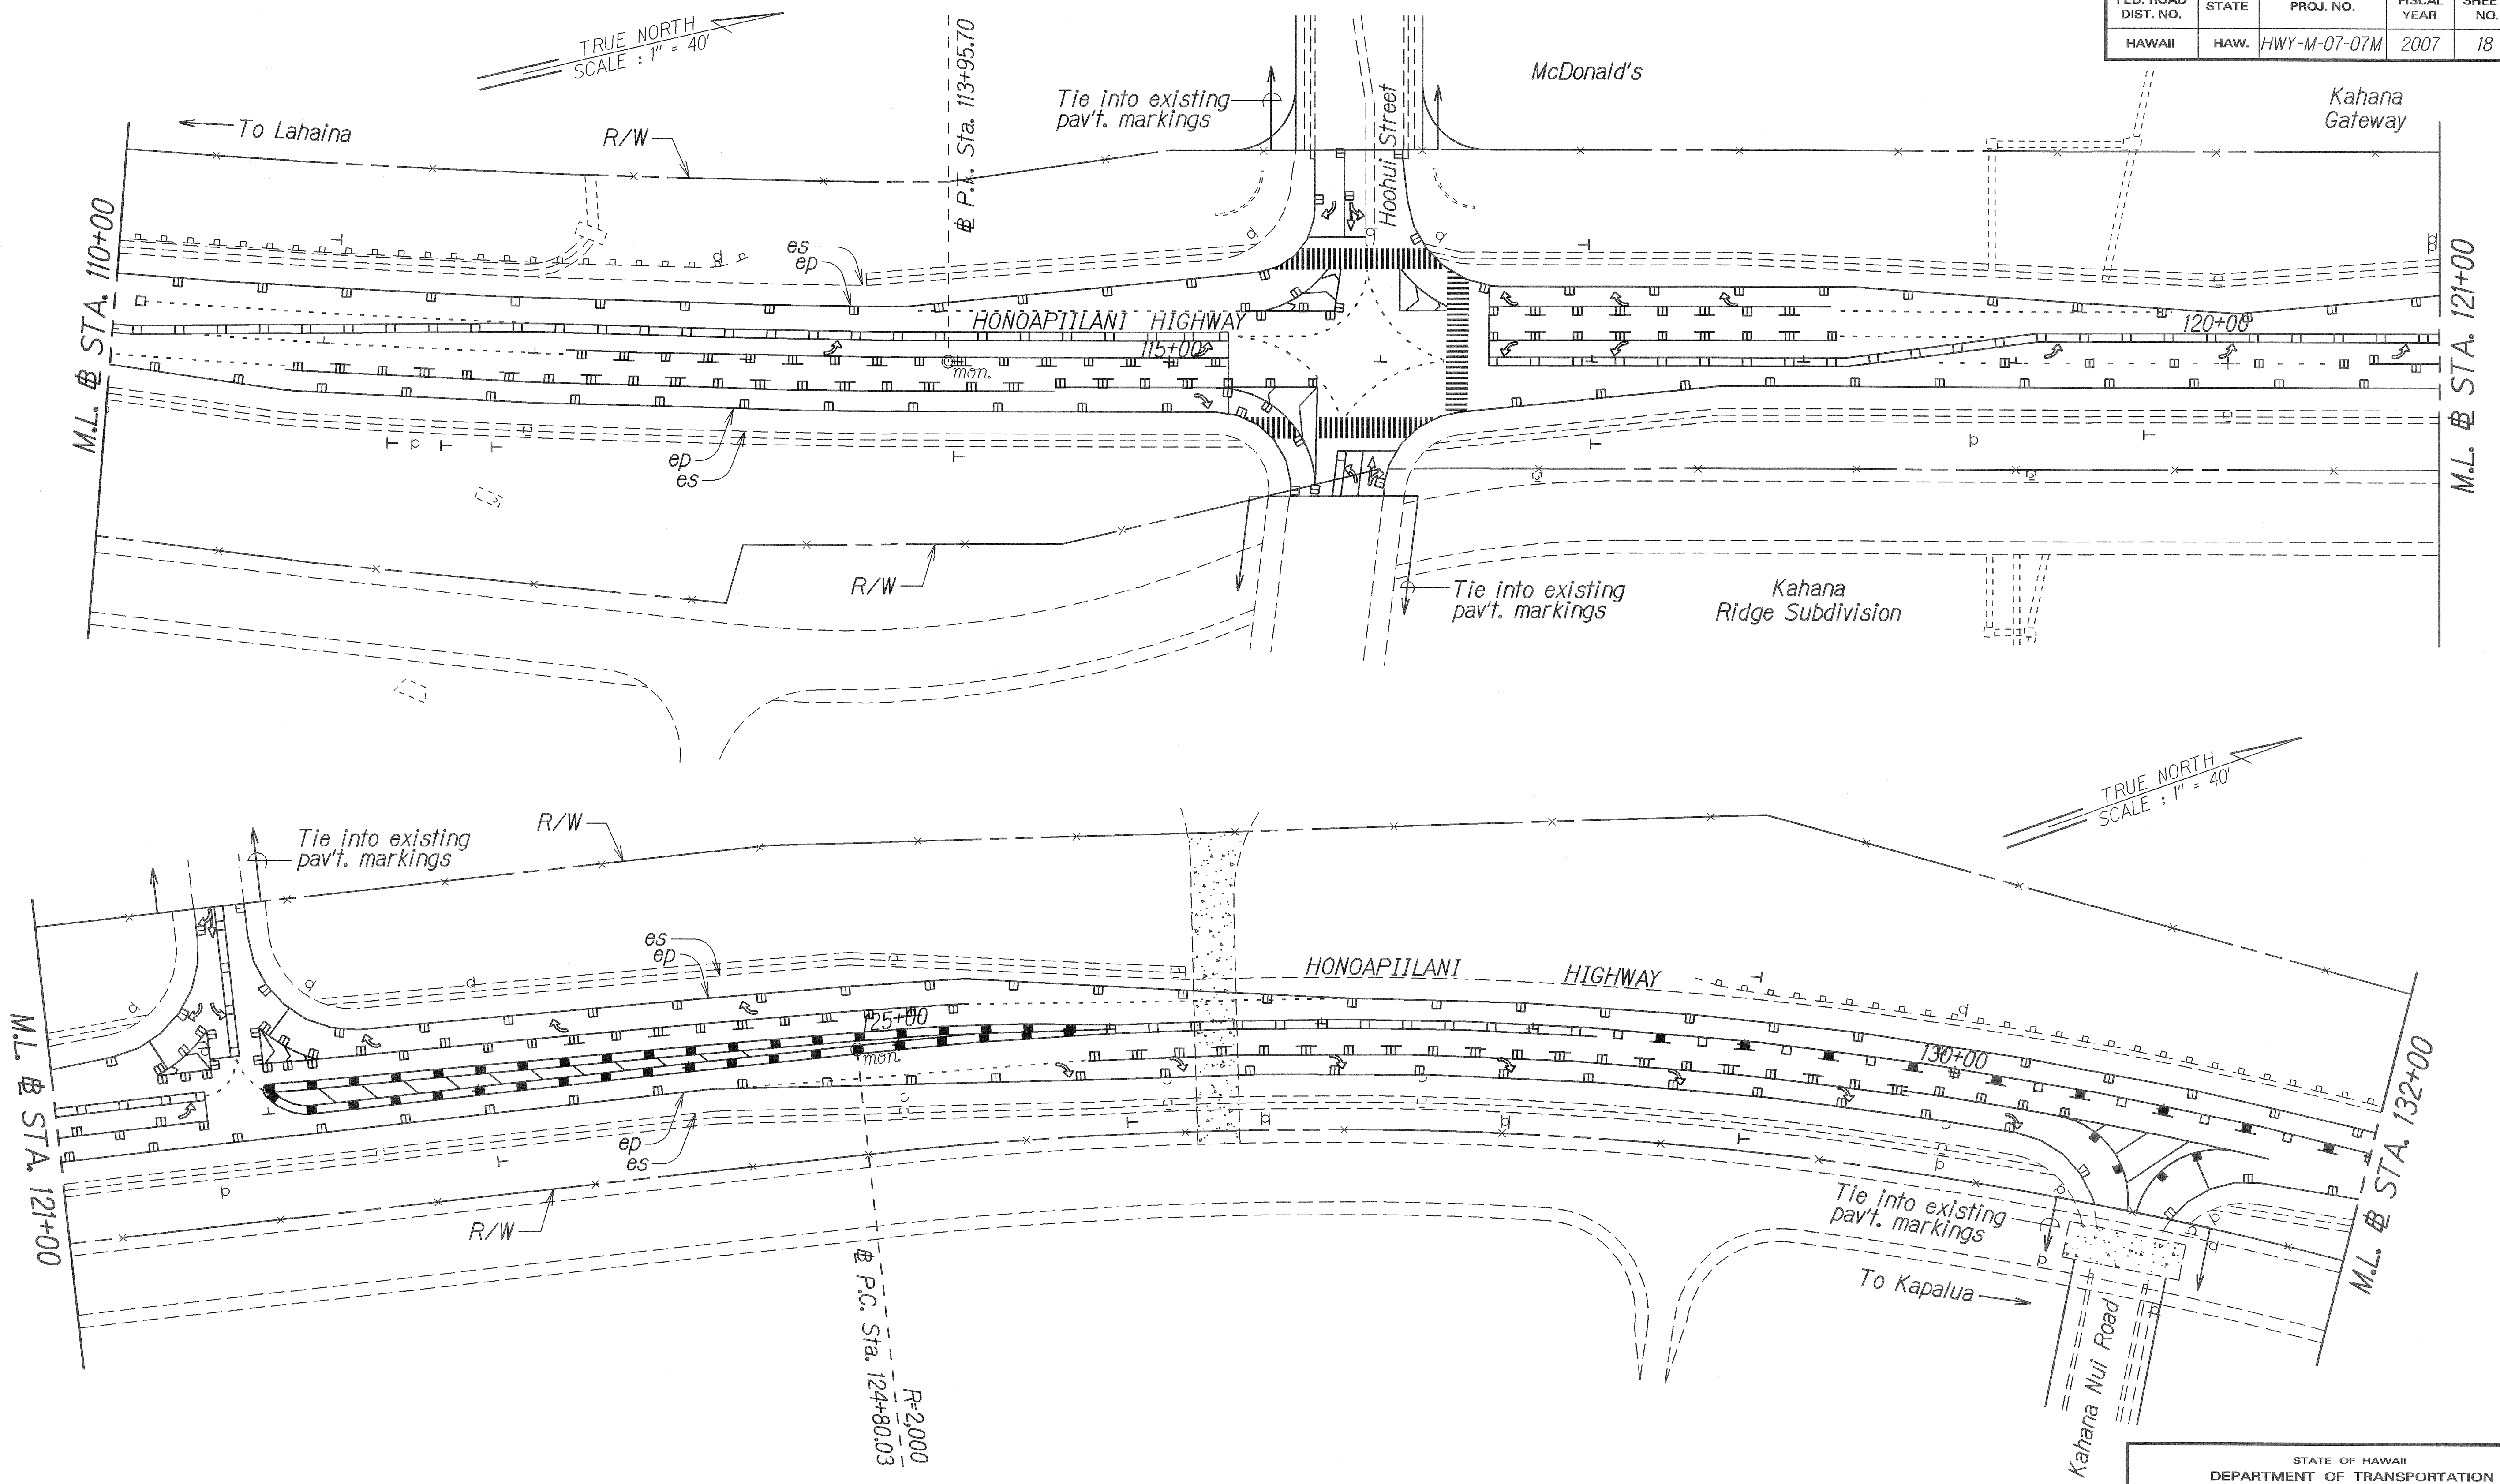

ORIGINAL PLAN	DATE
DESIGNED BY	4/07
TRACED BY	
NOTE BOOK	
DESIGNED BY	
QUANTITIES BY	
CHECKED BY	

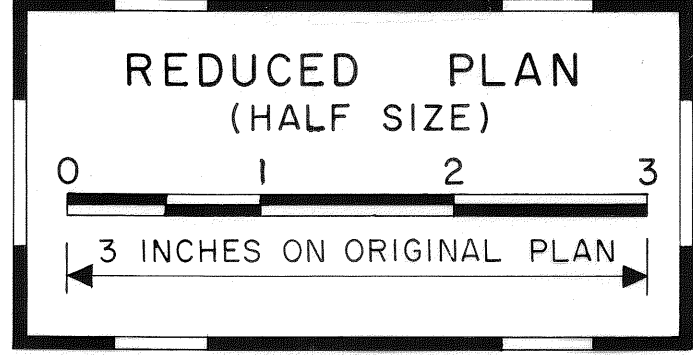

STATE OF HAWAII
DEPARTMENT OF TRANSPORTATION
HIGHWAYS DIVISION


PAVEMENT MARKING PLAN

PAVEMENT MARKING AND STRIPING
At Various Locations, Maui
Project No. HWY-M-07-07M

Scale: 1" = 40' Date: April, 2007

SHEET No. 12 OF 14 SHEETS

FED. ROAD DIST. NO.	STATE	PROJ. NO.	FISCAL YEAR	SHEET NO.	TOTAL SHEETS
HAWAII	HAW.	HWY-M-07-07M	2007	19	20

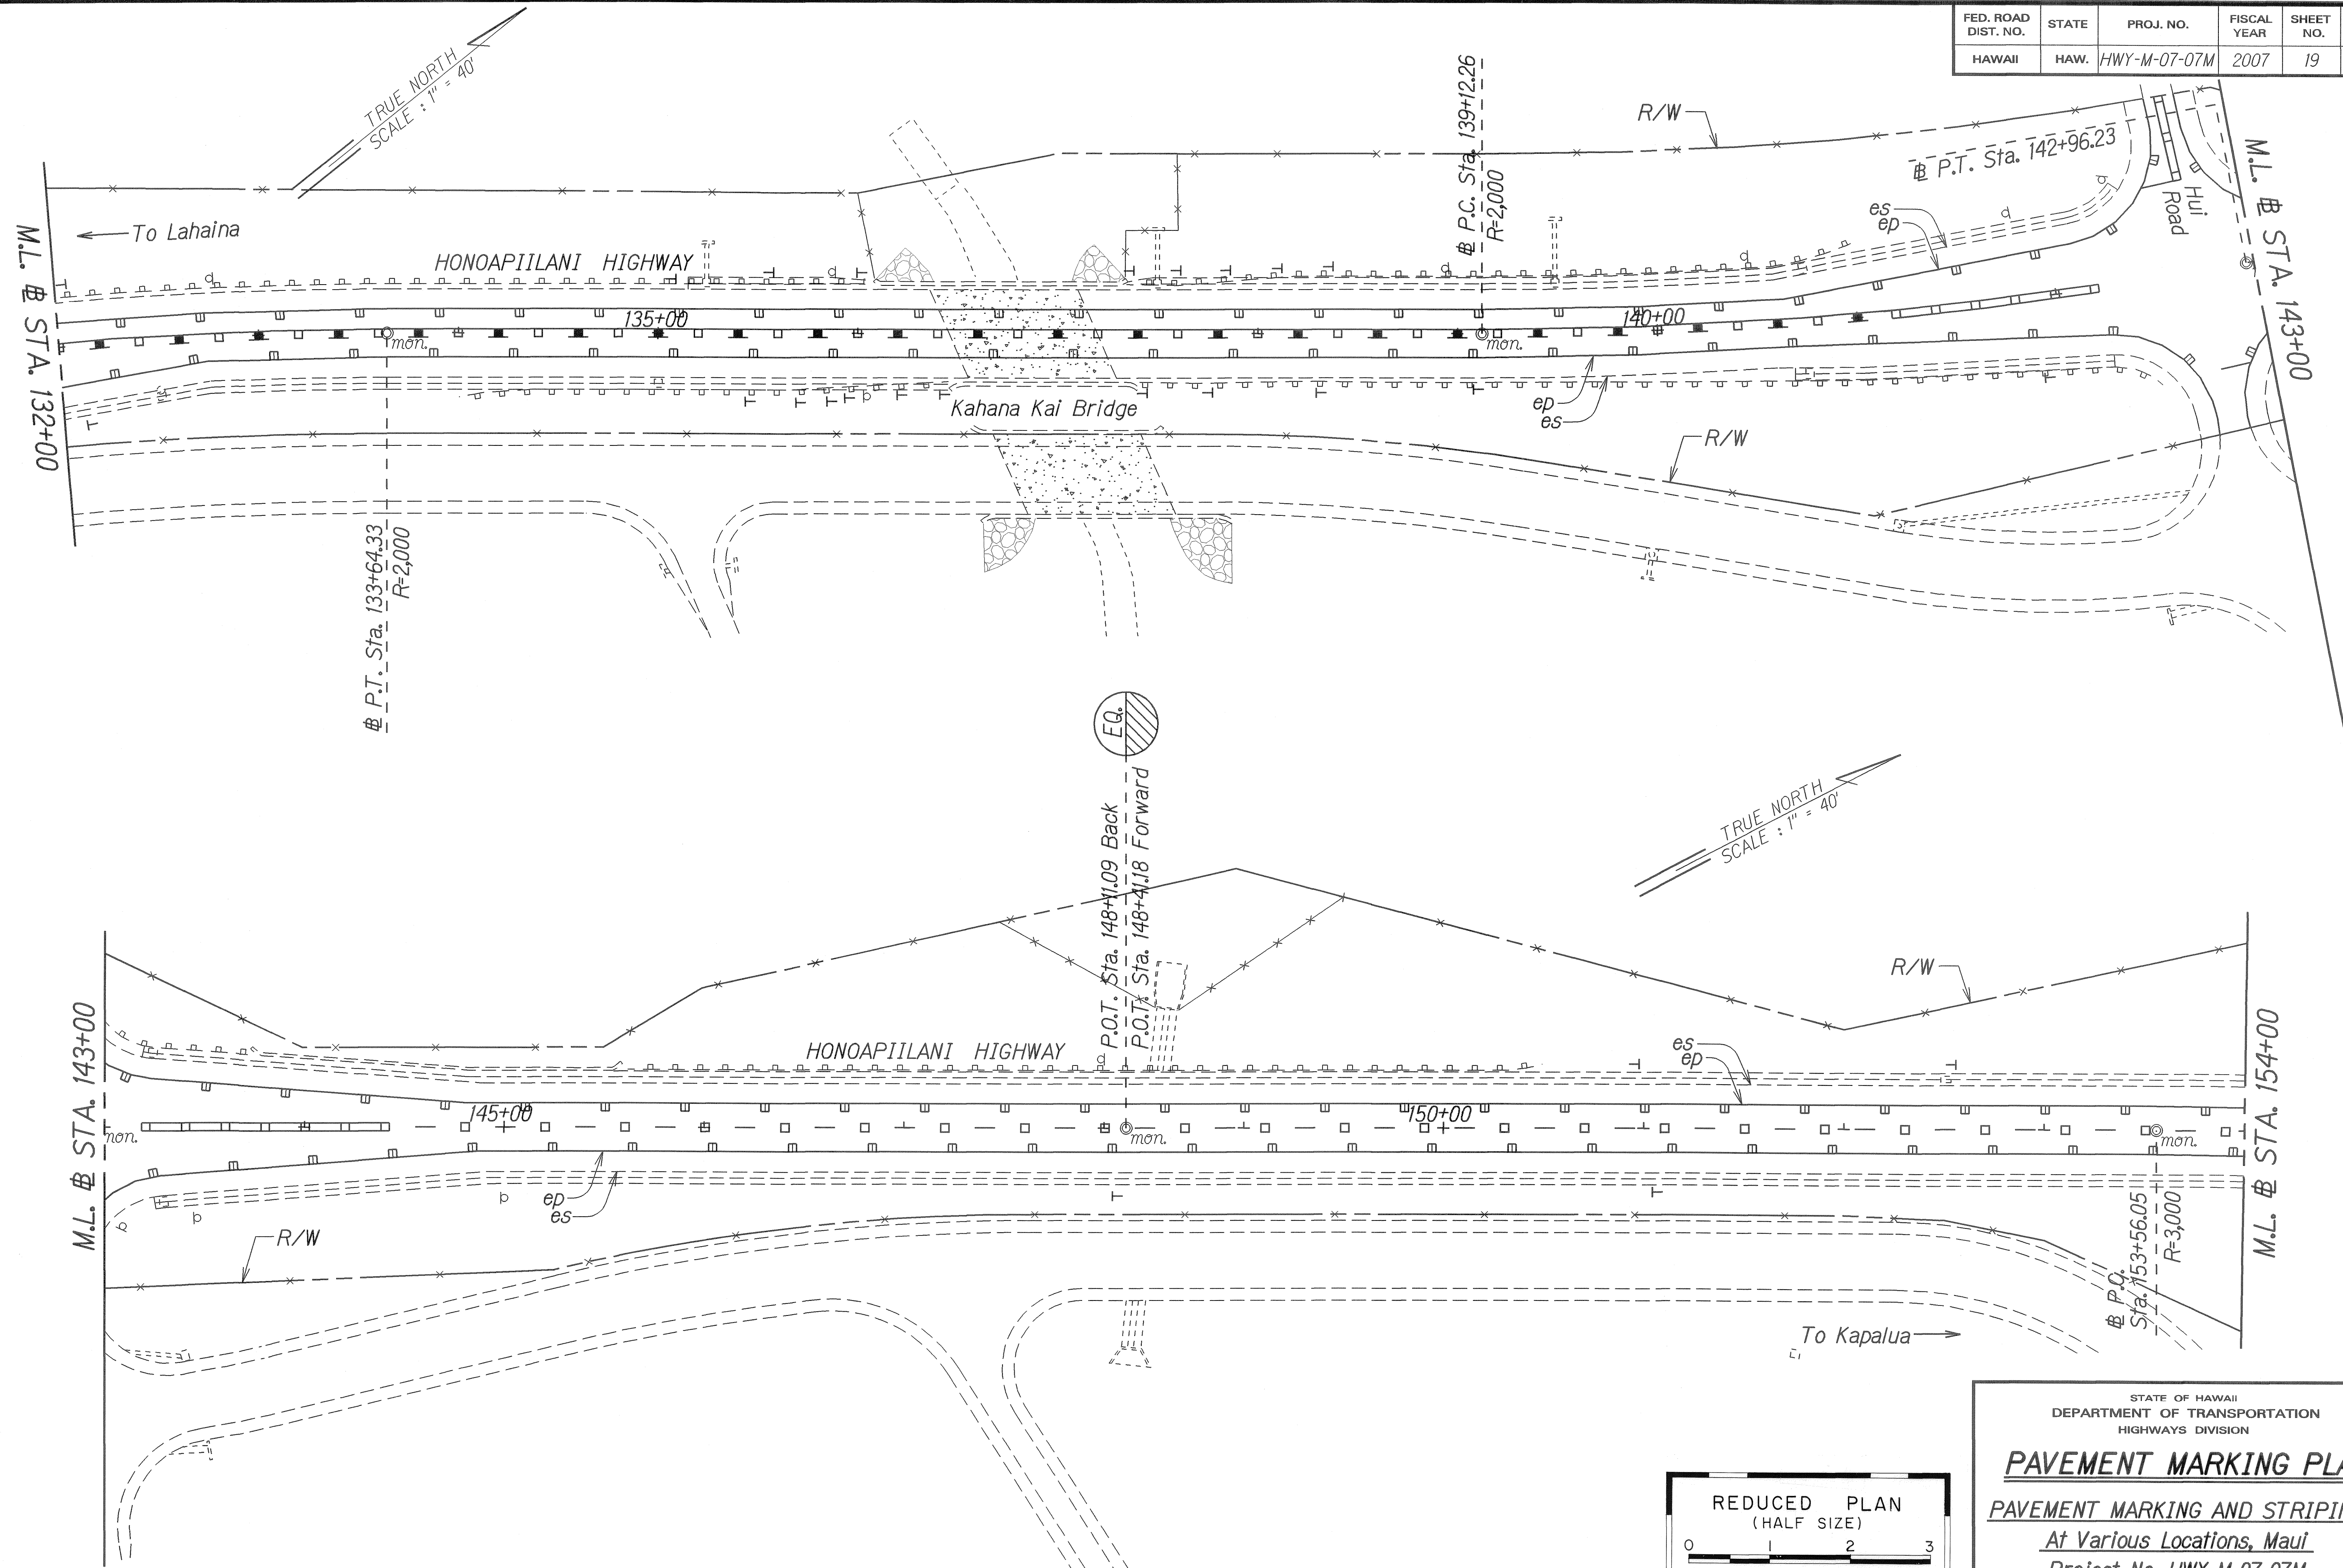

ORIGINAL PLAN	DATE 4/07
NOTED BY	DESIGNED BY
QUANTITIES BY	CHECKED BY


STATE OF HAWAII
DEPARTMENT OF TRANSPORTATION
HIGHWAYS DIVISION

PAVEMENT MARKING PLAN
PAVEMENT MARKING AND STRIPING
At Various Locations, Maui
Project No. HWY-M-07-07M


Scale: 1" = 40' Date: April, 2007

SHEET No. 13 OF 14 SHEETS

FED. ROAD DIST. NO.	STATE	PROJ. NO.	FISCAL YEAR	SHEET NO.	TOTAL SHEETS
HAWAII	HAW.	HWY-M-07-07M	2007	20	20

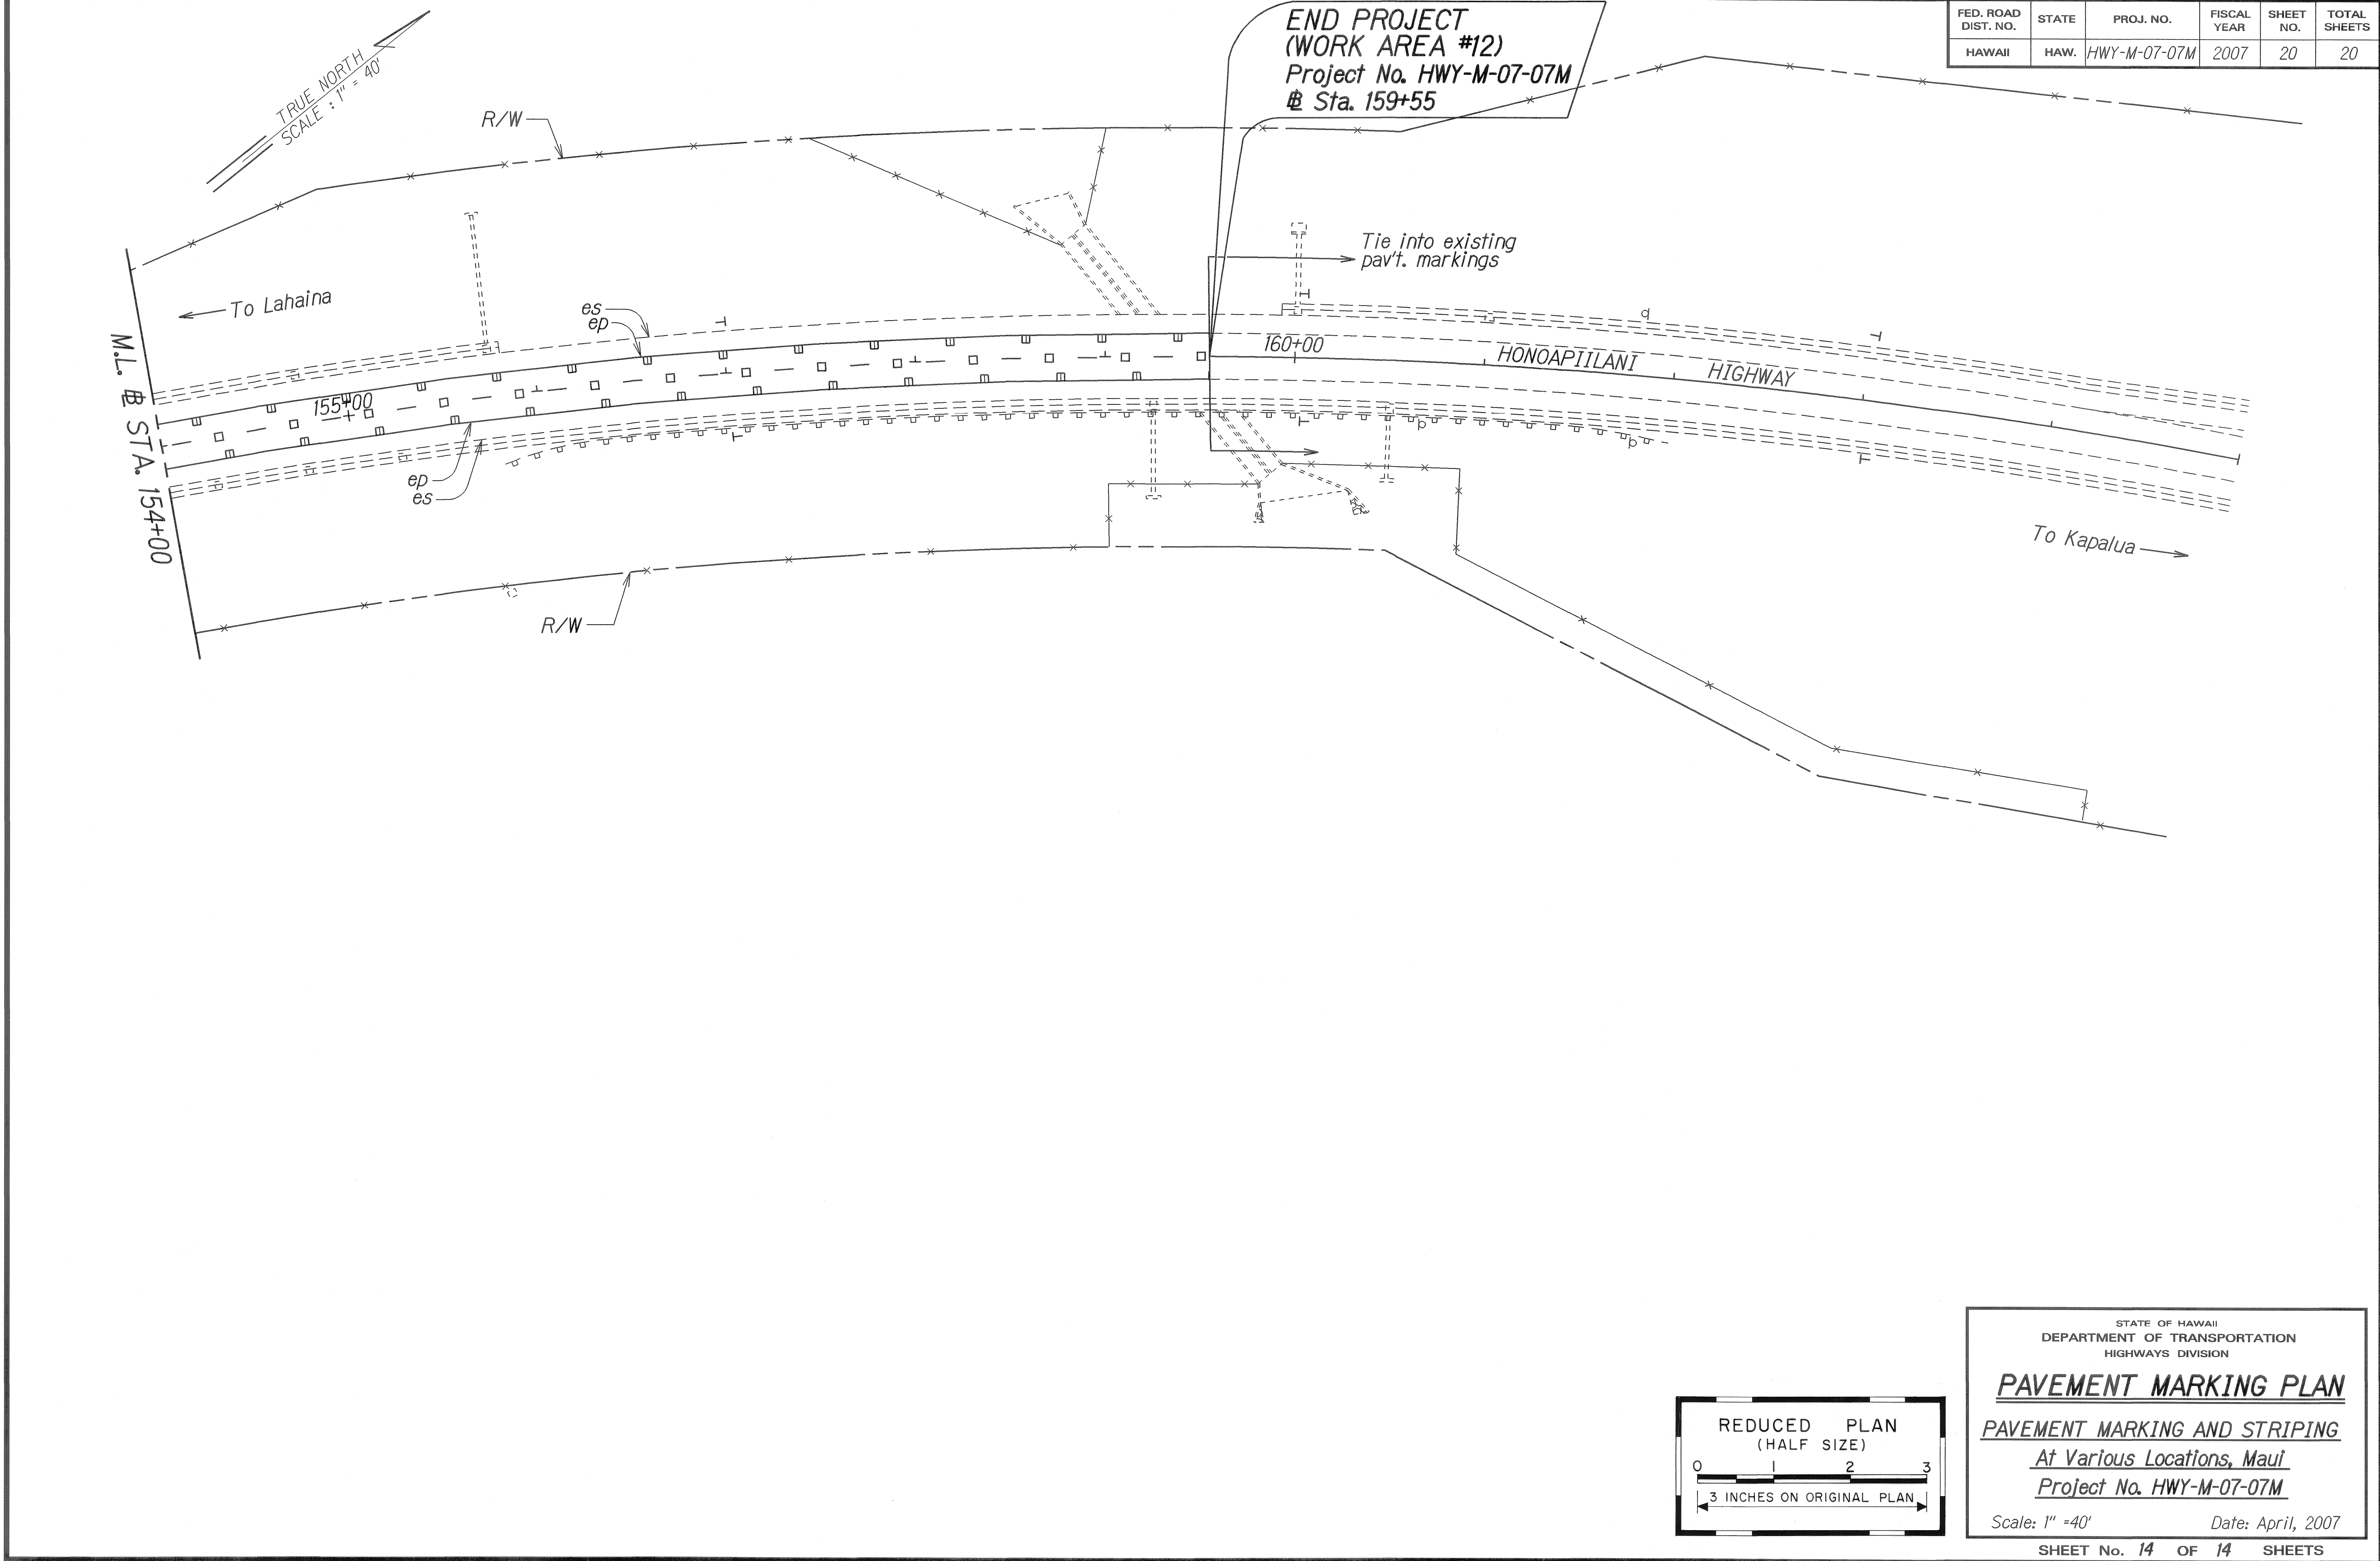

ORIGINAL PLAN	SURVEY PLOTTED BY	DATE
NOTE BOOK	DRAWN BY	4/07
DESIGNED BY	TRACED BY	
CHECKED BY	CHECKED BY	

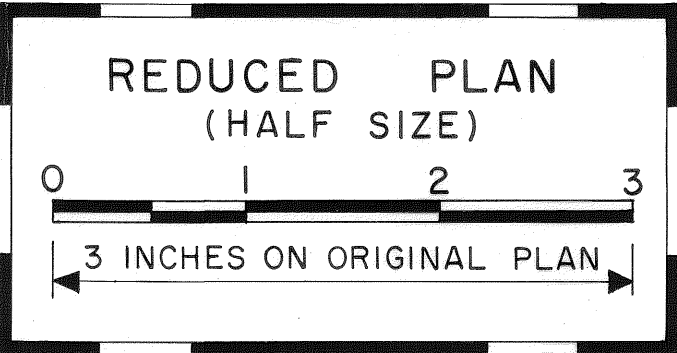

STATE OF HAWAII
DEPARTMENT OF TRANSPORTATION
HIGHWAYS DIVISION

PAVEMENT MARKING PLAN
PAVEMENT MARKING AND STRIPING
At Various Locations, Maui
Project No. HWY-M-07-07M

Scale: 1" = 40'
Date: April, 2007

SHEET No. 14 OF 14 SHEETS