



INDEX TO DRAWINGS	
SHEET NO.	DESCRIPTION
1	TITLE SHEET
2	STANDARD PLANS SUMMARY
3	TYPICAL ACCELERATION AND DECELERATION LANE MARKINGS
4	PAVEMENT MARKING LEGEND, DETAILS AND GENERAL NOTES
5 - 6	WATER POLLUTION & EROSION CONTROL NOTES
7 - 20	PAVEMENT MARKING PLANS

FED. ROAD DIST. NO.	STATE	PROJ. NO.	FISCAL YEAR	SHEET NO.	TOTAL SHEETS
HAWAII	HAW.	HWY-M-07-07M	2007	1	20

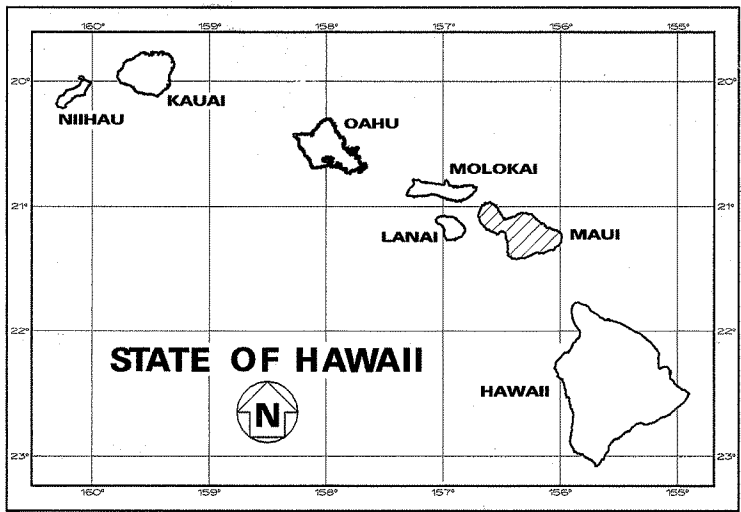

STATE OF HAWAII
DEPARTMENT OF TRANSPORTATION
HIGHWAYS DIVISION
HONOLULU, HAWAII
"AS-BUILT"
PLANS FOR
PAVEMENT MARKING AND STRIPING
AT VARIOUS LOCATIONS, MAUI
PROJECT NO. HWY-M-07-07M
DISTRICT OF LAHAINA
ISLAND OF MAUI

HWY-M
DESIGNED BY
PAUL CHUNG
MANAGED BY
873-3535
PHONE
MAR., 2007
DATE

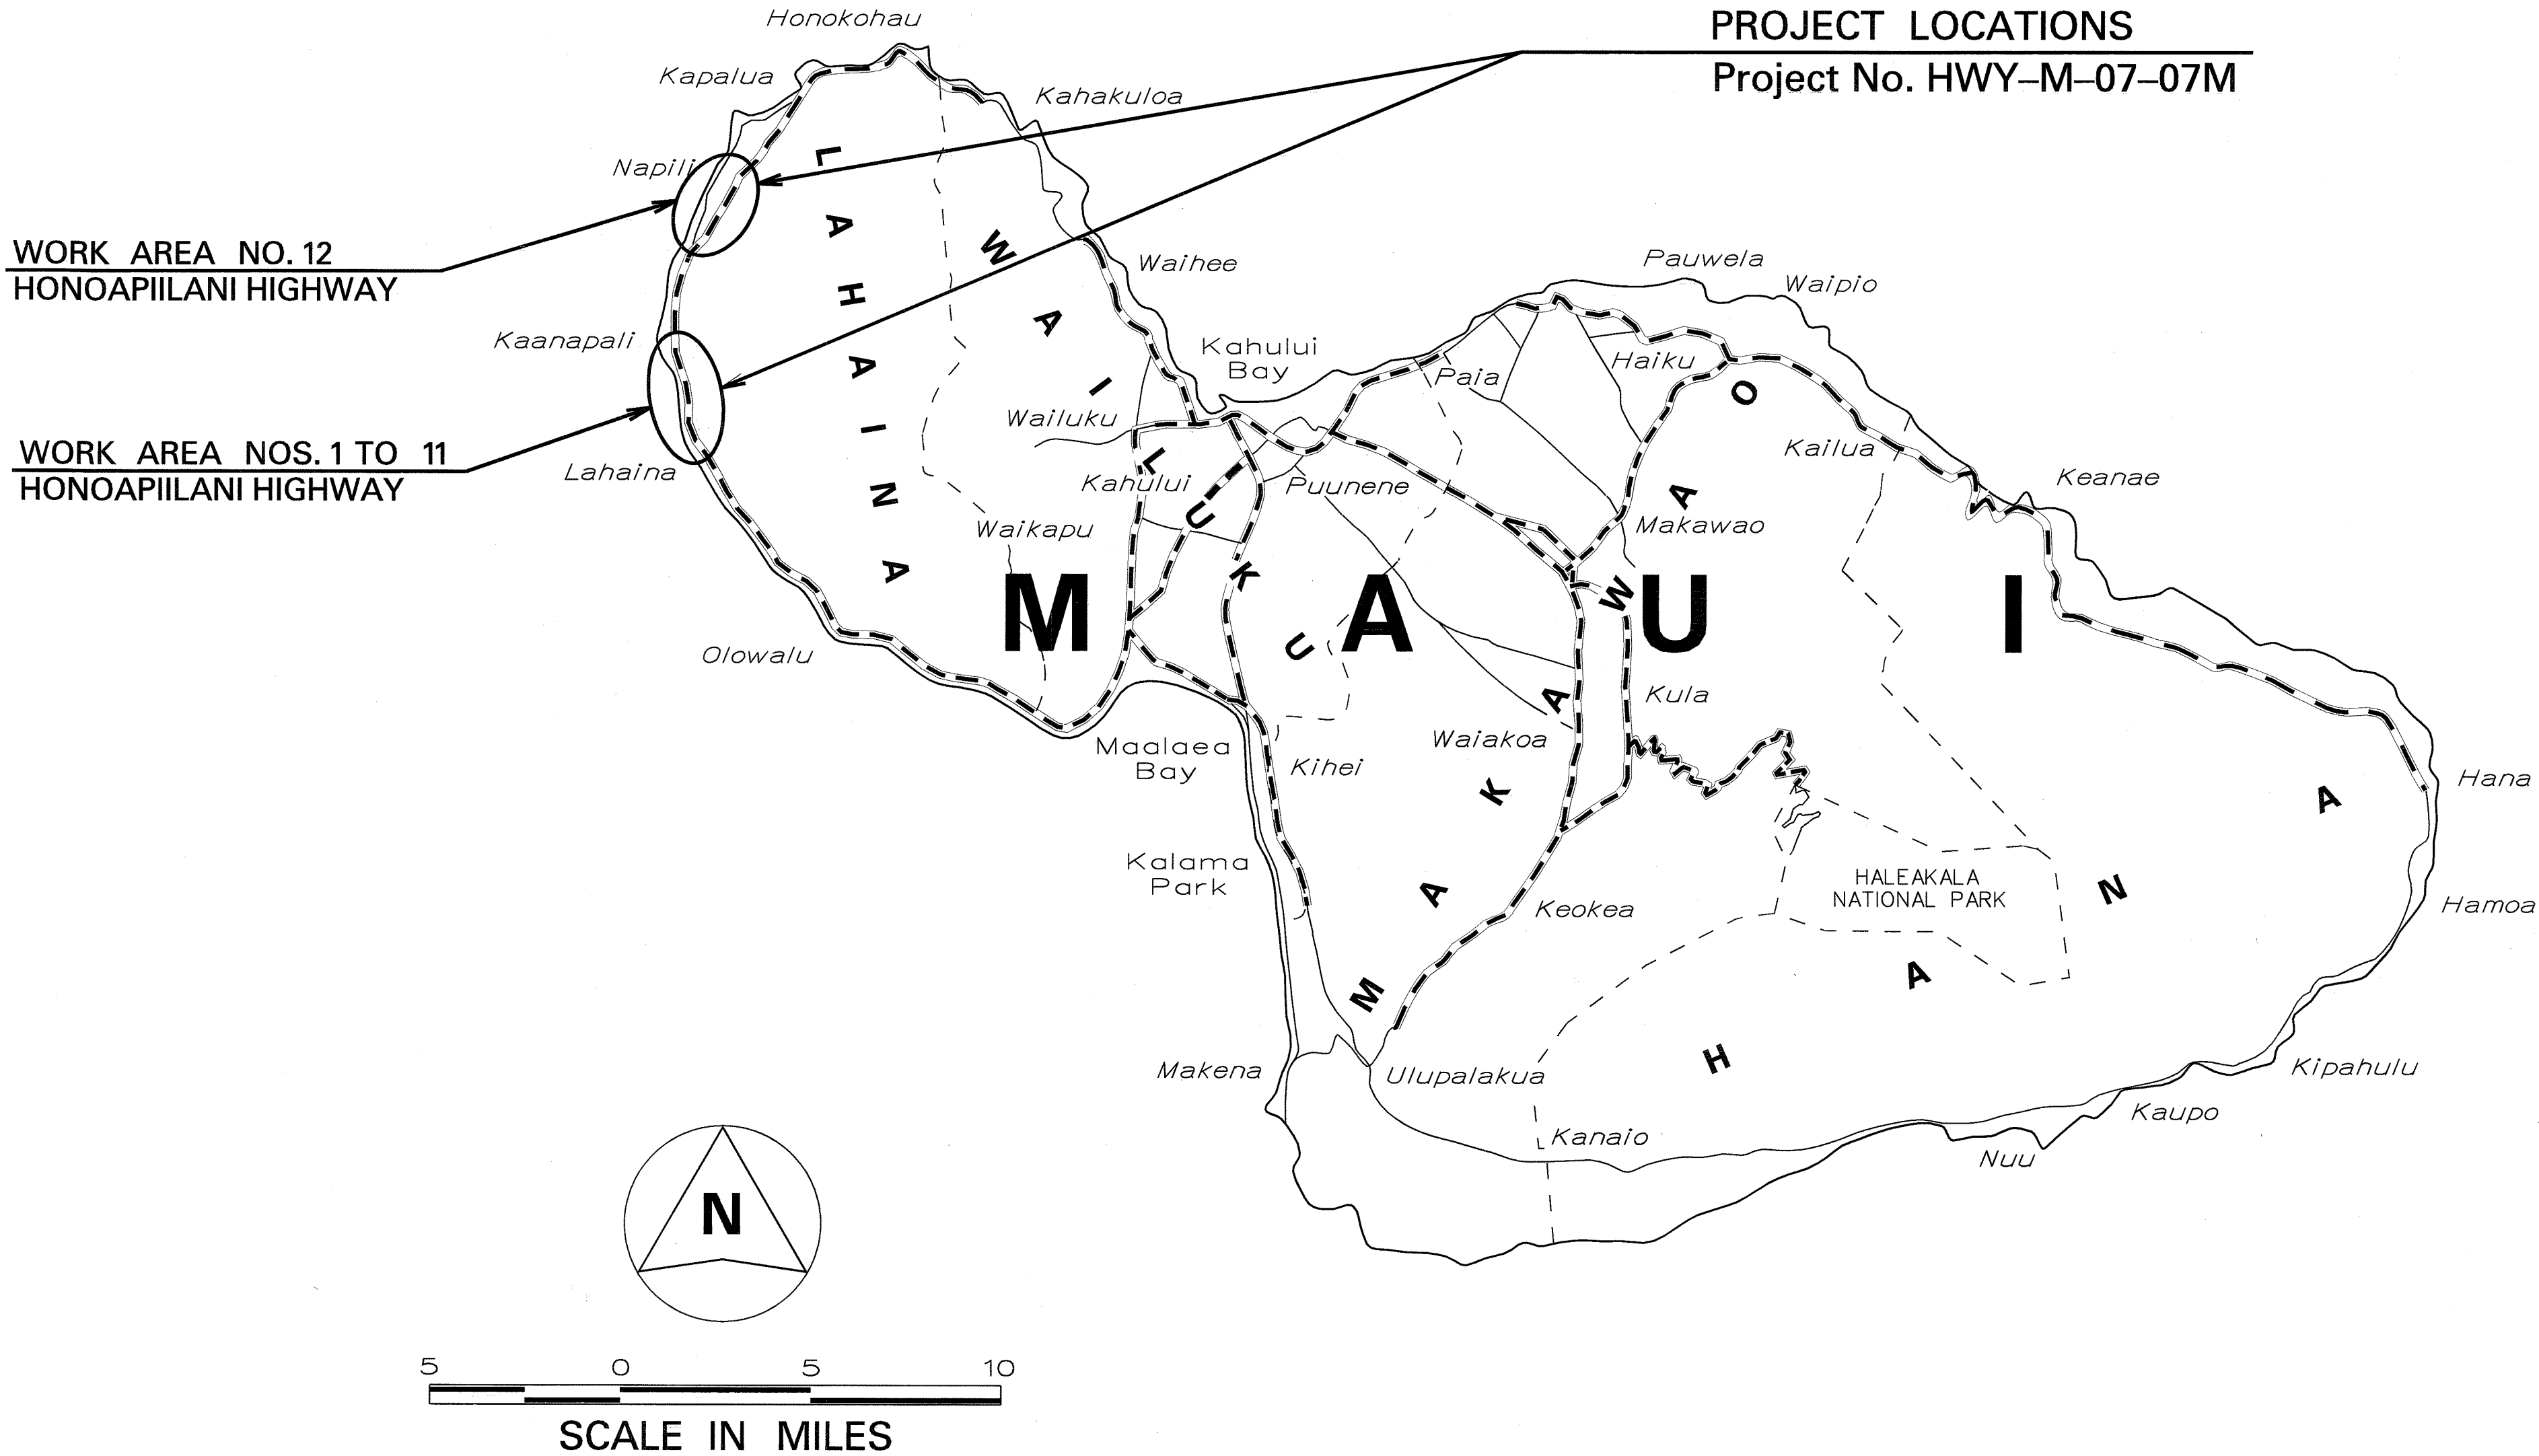

----- FEDERAL AID PROJECTS PREVIOUSLY CONSTRUCTED
OR UNDER CONSTRUCTION

CHANGES MADE DURING CONSTRUCTION HAVE BEEN
INCORPORATED ON THESE PLANS EXCEPT CHANGES
IN THE ORIGINAL THEORETICAL QUANTITIES. FOR
ACTUAL QUANTITIES, REFER TO PROJECT LEDGER
AND/OR COMPUTATION BOOK.

Blamm
RESIDENT ENGINEER
9-22-11
DATE

DEPARTMENT OF TRANSPORTATION
STATE OF HAWAII
APPROVED:
Blamm
DIR. OF TRANSPORTATION
5-18-07
DATE