


FED. ROAD DIST. NO.	STATE	FED. AID PROJ. NO.	FISCAL YEAR	SHEET NO.	TOTAL SHEETS
HAWAII	HAW.	STP-0900(073)	2010	ADD.18	38

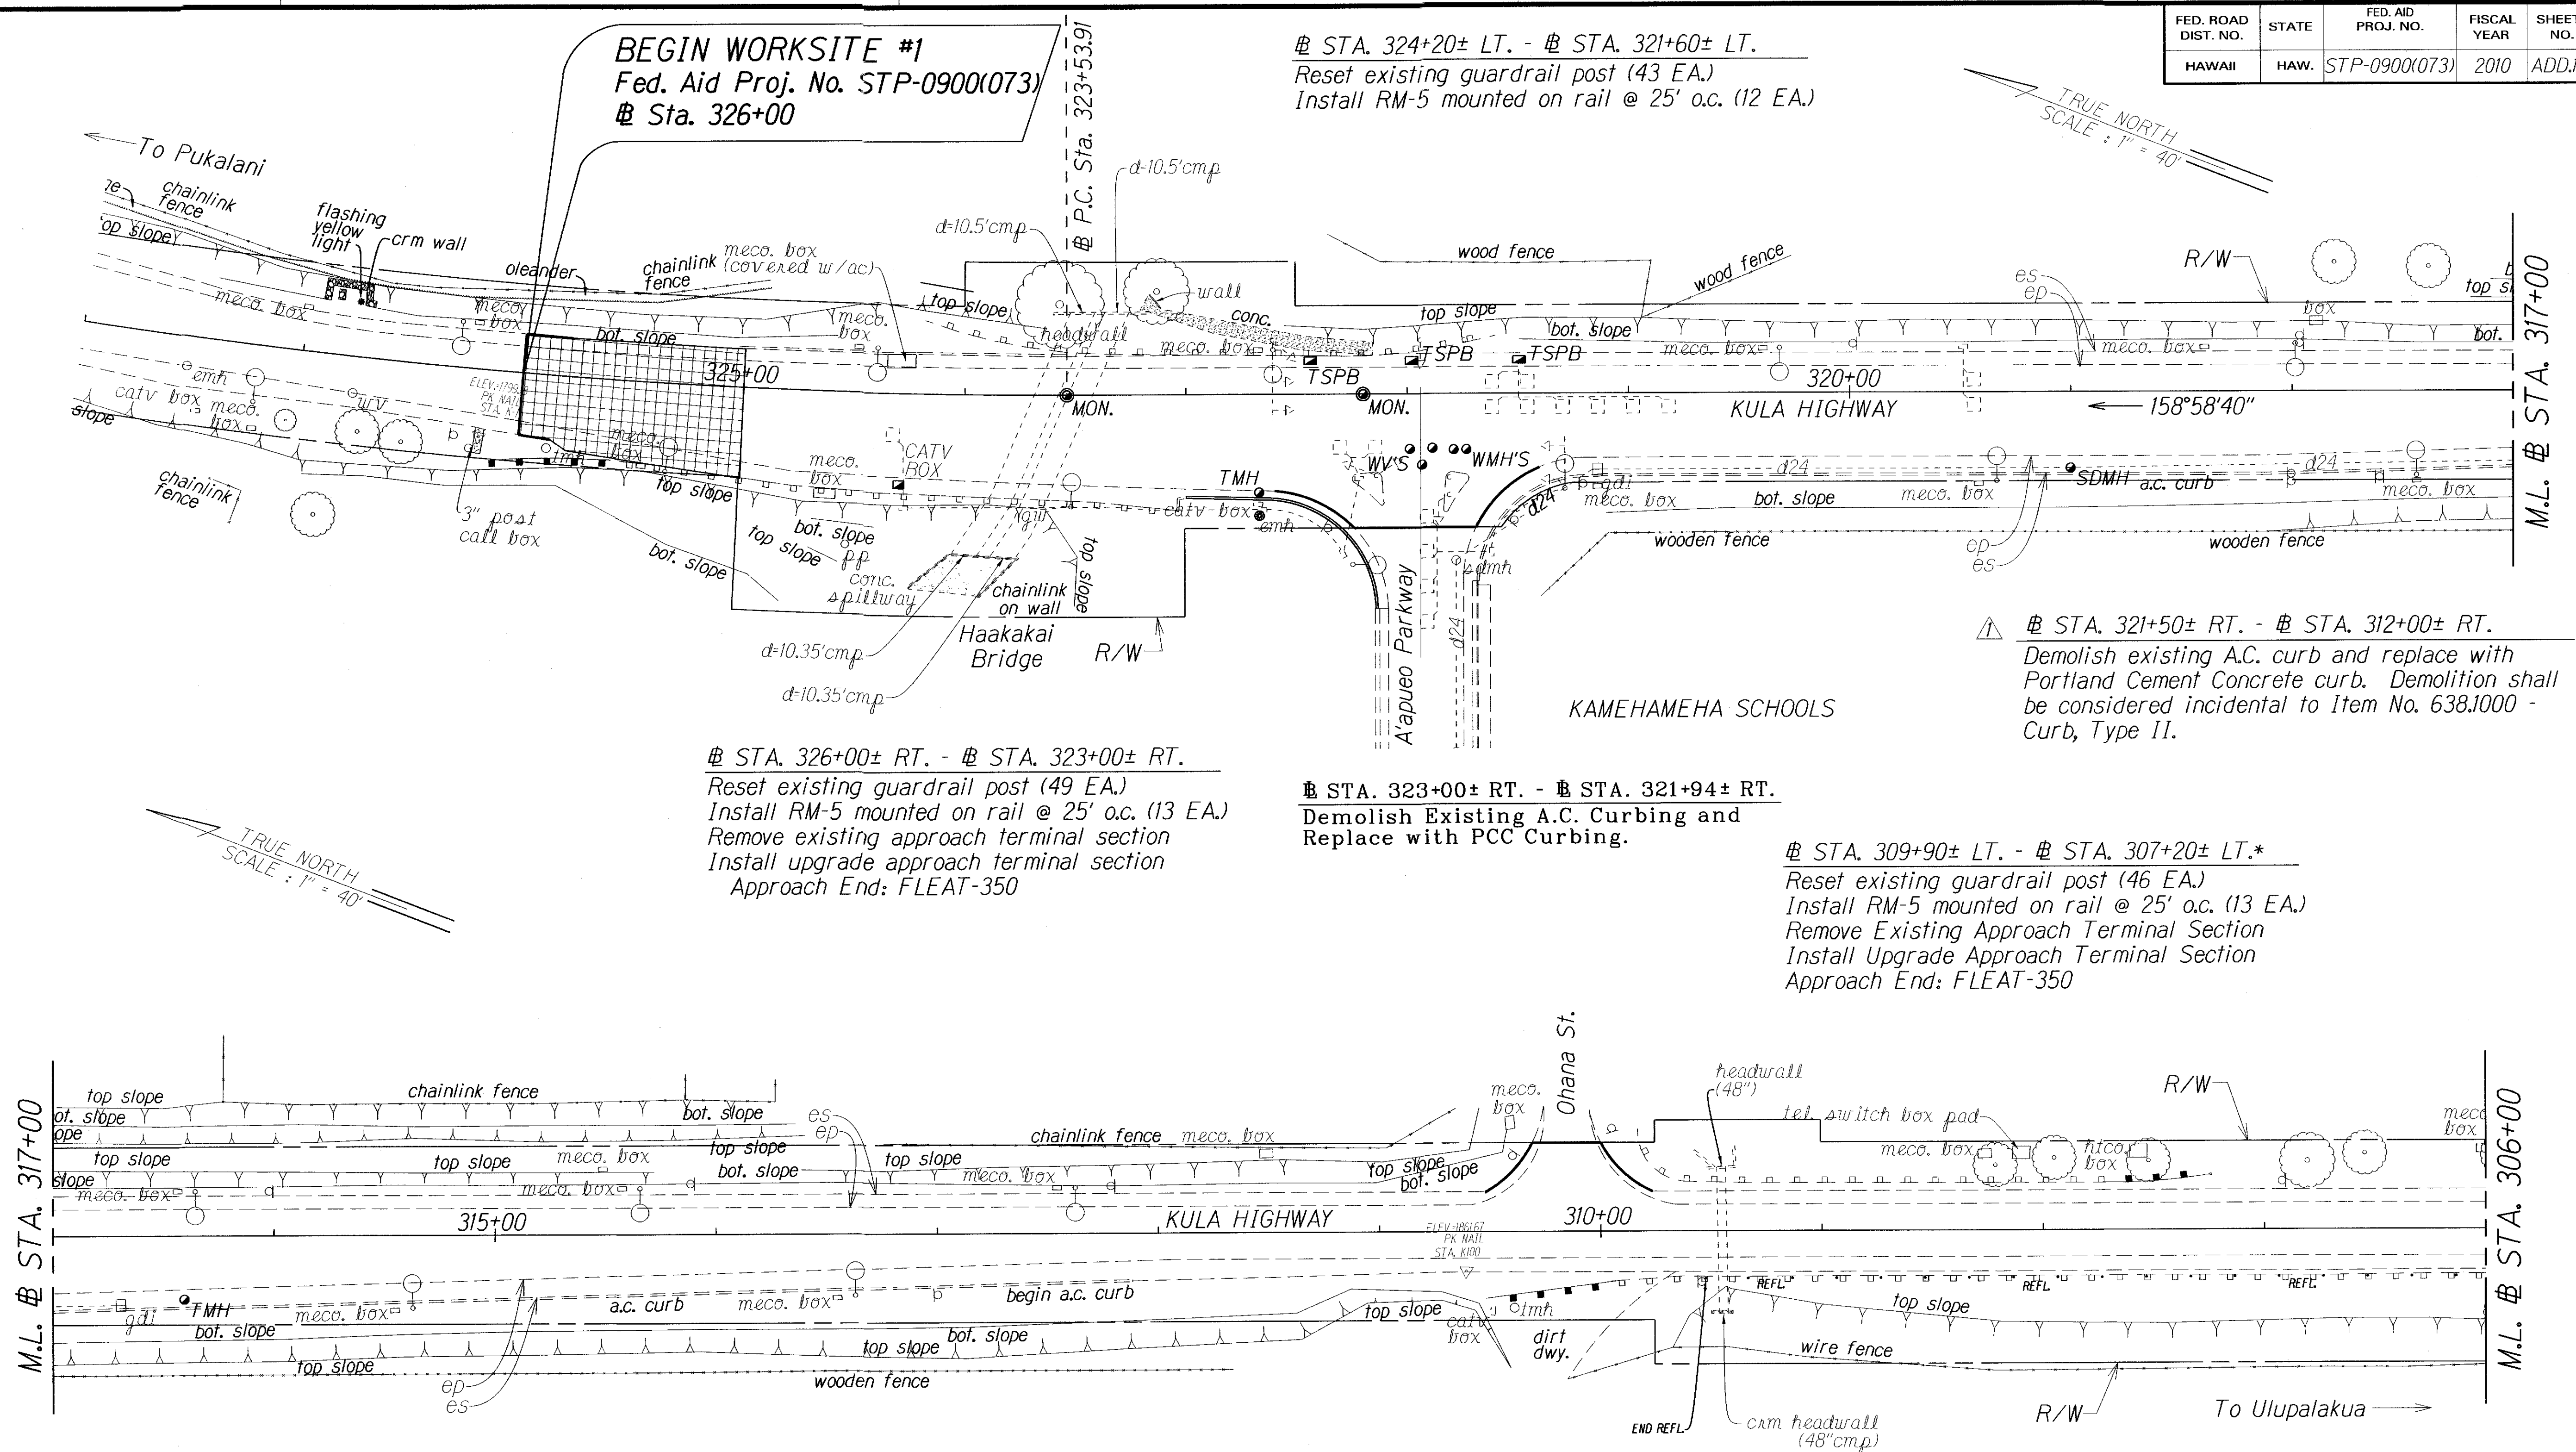

M.L. # STA. 317+00

M.L. # STA. 306+00

LEGEND FOR AS-BUILT POSTINGS	
	Squiggly line for as-built deletion
	Double line for as-built deletion
Roadway	Text for as-built posting

*Extend pavement from existing edge of pavement to back of guardrail post. See Sht. 8.

STA. 310+00± RT. - # STA. 305+30± RT.*
 Reset existing guardrail post (76 EA.)
 Install RM-5 mounted on rail @ 25' o.c. (20 EA.)
 Remove existing approach terminal section.
 Extend guardrail at approach end. (50 Ft.±)
 Install upgrade approach terminal section.
 Approach End: FLEAT-350


6-9-11	Added Replacement of A.C. curb with PCC curb.
DATE	REVISION

STATE OF HAWAII
 DEPARTMENT OF TRANSPORTATION
 HIGHWAYS DIVISION
ROADWAY PLAN
 KULA HIGHWAY RESURFACING
 Haakakai Bridge towards Old Lower Kula Rd. and
 HONOAPIILANI HIGHWAY RESURFACING
 Kapoli St. to Kaheawa Wind Farm Access Rd.
 Federal-Aid Project No. STP-0900(073)
 Scale: 1" = 40' Date: May, 2009
 SHEET No. 1 OF 7 SHEETS

"AS-BUILT"


ADD. 18

FED. ROAD DIST. NO.	STATE	FED. AID PROJ. NO.	FISCAL YEAR	SHEET NO.	TOTAL SHEETS
HAWAII	HAW.	STP-0900(073)	2010	19	38

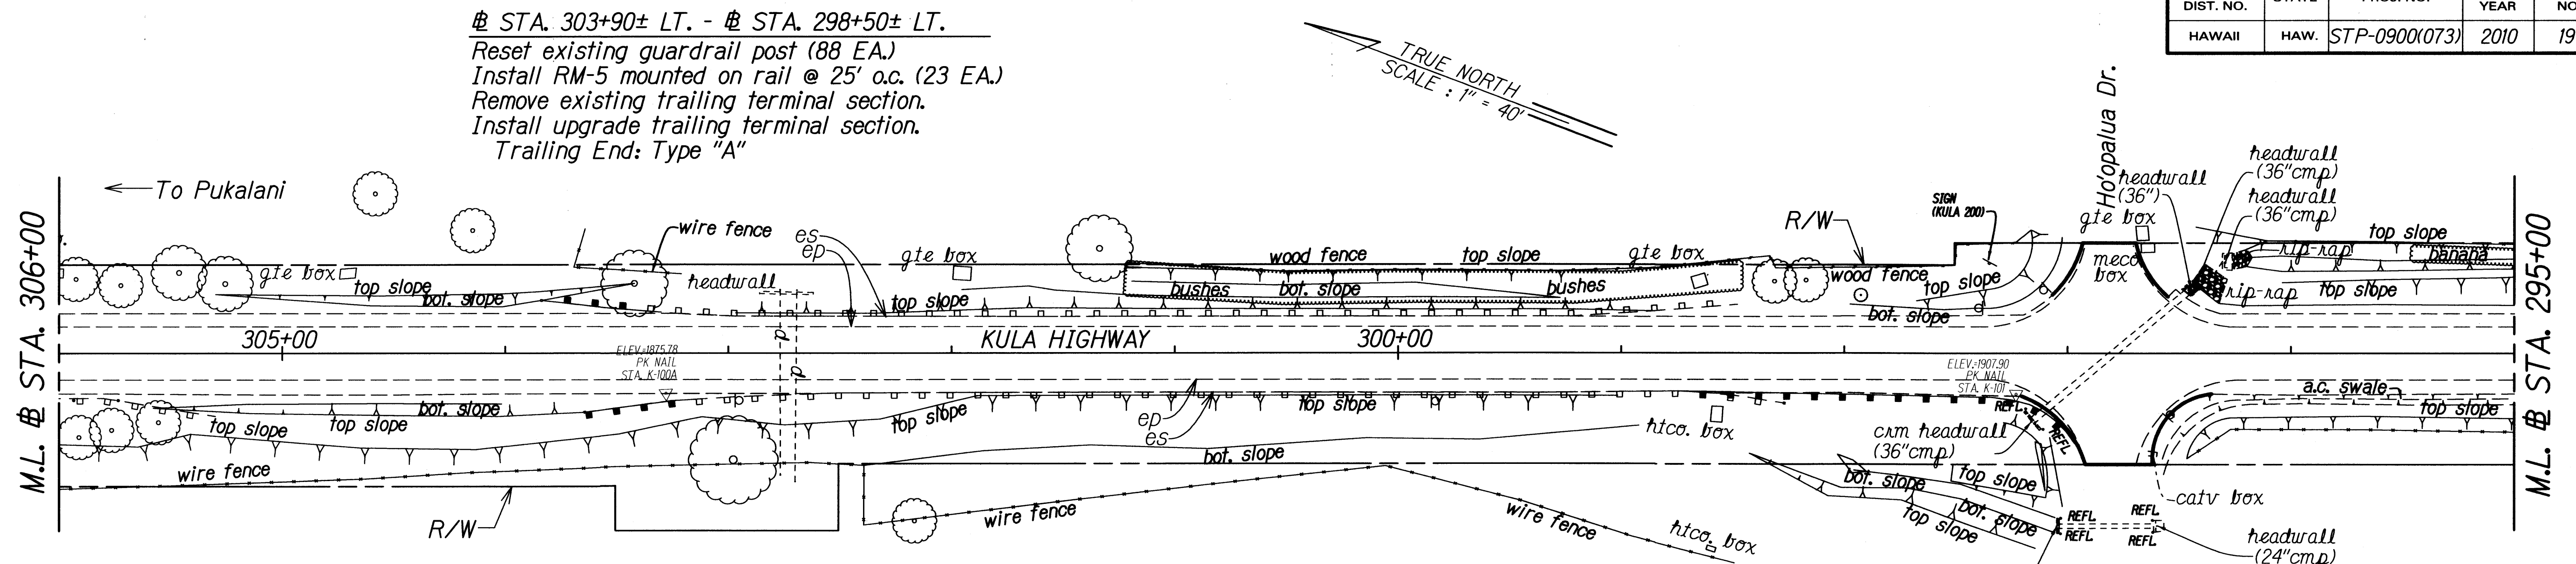

@ STA. 303+70± RT. - @ STA. 298+20± RT.*
 Reset existing guardrail post (89 EA.)
 Install RM-5 mounted on rail @ 25' o.c. (23 EA.)
 Remove existing terminal sections.
 Replace 25 Ft. of damaged guardrail at approach end.
 Extend guardrail at trailing end up to culvert (150 Ft.).
 Install upgrade terminal sections.
 Approach End: Type "A"
 Trailing End: Modified Type "G" (R=30 Ft.)

@ STA. 287+70± LT. - @ STA. 282+60± LT.*
 Reset existing guardrail post (83 EA.)
 Install RM-5 mounted on rail @ 25' o.c. (22 EA.)

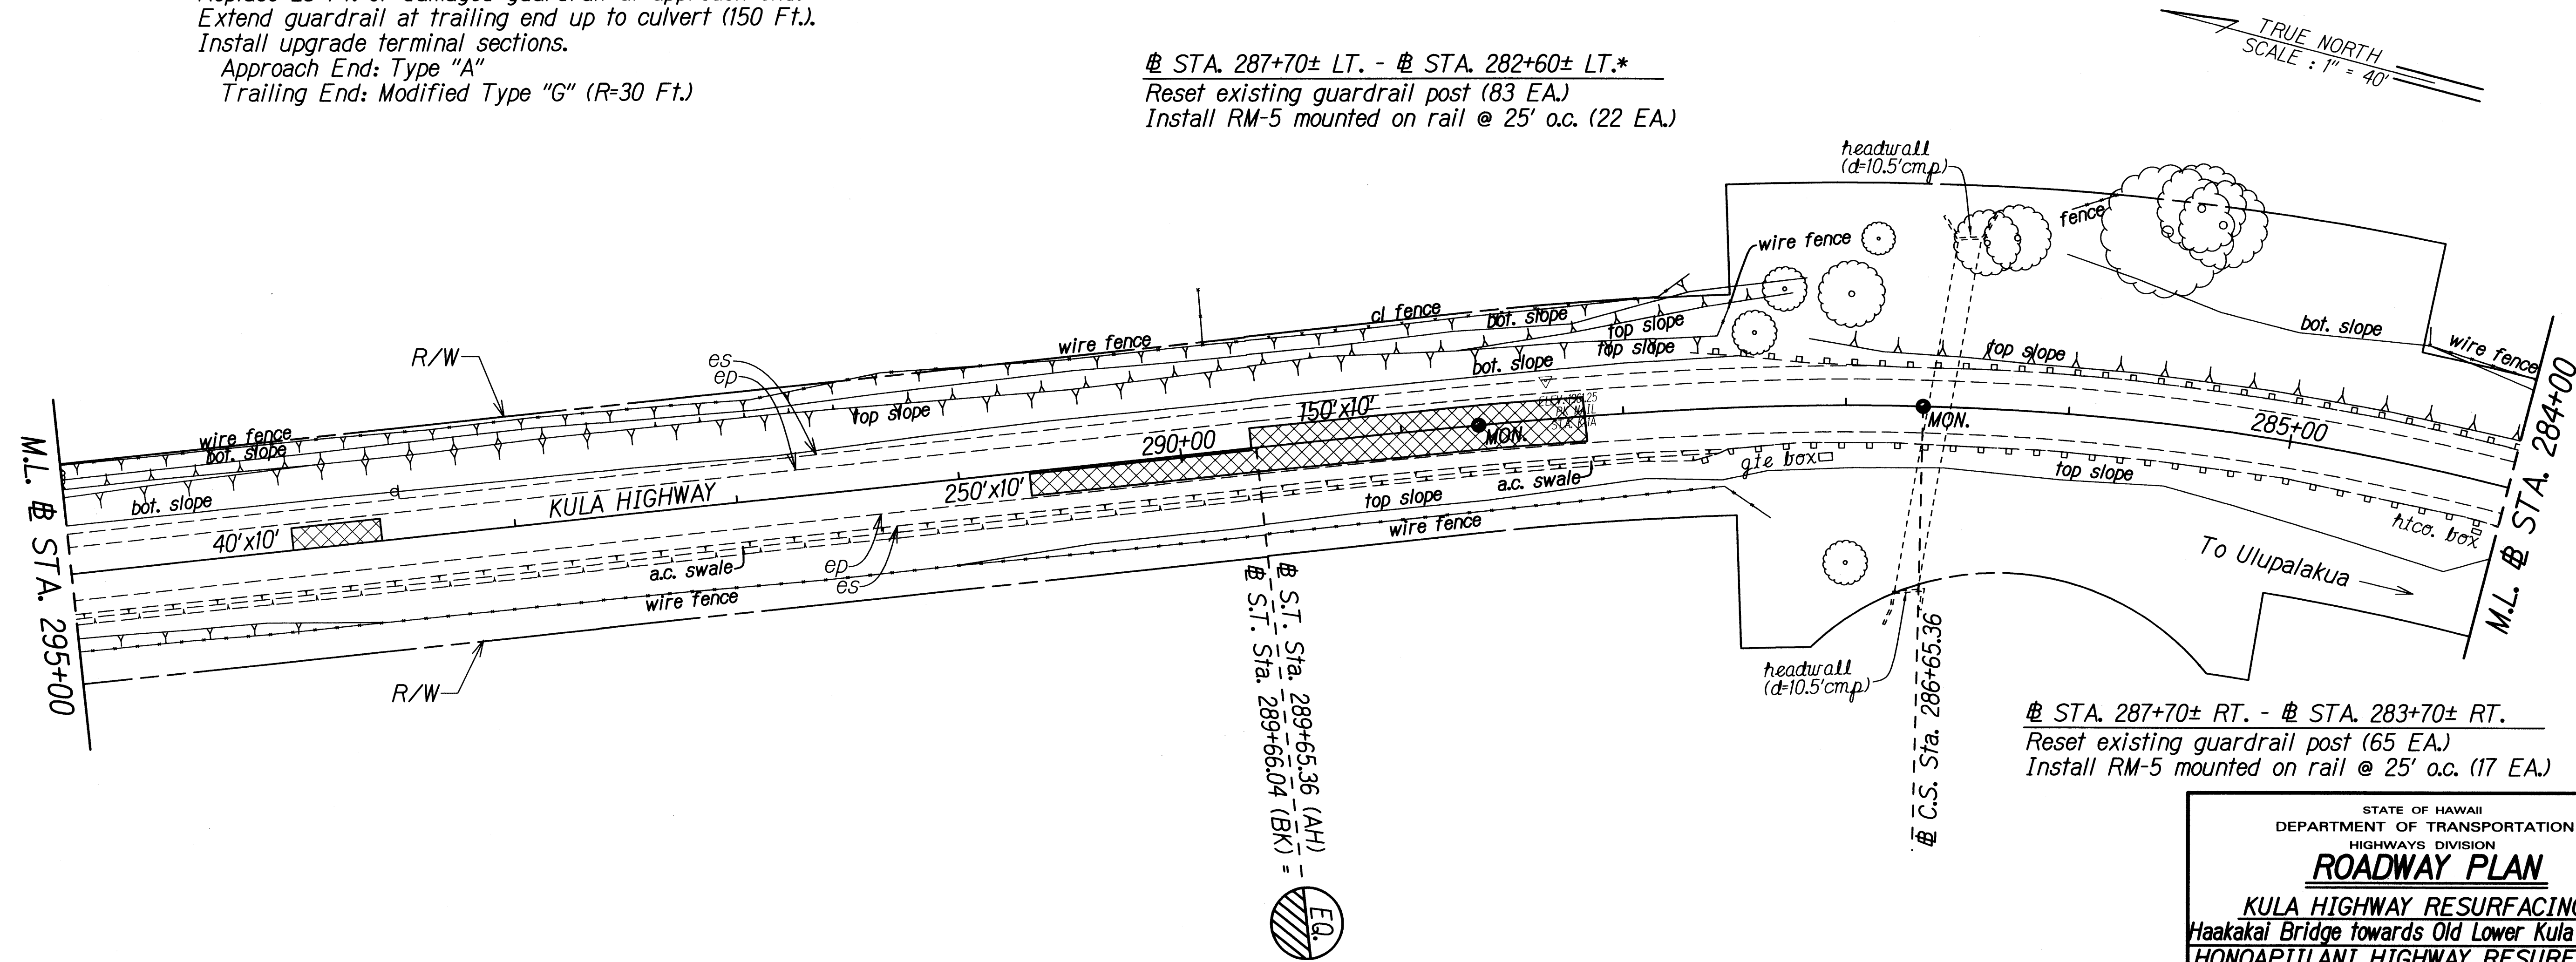

@ STA. 287+70± RT. - @ STA. 283+70± RT.
 Reset existing guardrail post (65 EA.)
 Install RM-5 mounted on rail @ 25' o.c. (17 EA.)


*Extend pavement from existing edge of pavement
 to 1 ft. behind guardrail post. See Sht. 8.

STATE OF HAWAII
 DEPARTMENT OF TRANSPORTATION
 HIGHWAYS DIVISION

ROADWAY PLAN
 KULA HIGHWAY RESURFACING
 Haakakai Bridge towards Old Lower Kula Rd. and
 HONOAPIILANI HIGHWAY RESURFACING
 Kapoli St. to Kaheawa Wind Farm Access Rd.
 Federal-Aid Project No. STP-0900(073)
 Scale: 1" = 40' Date: May, 2009

ORIGINAL PLAN	SURVEY PLOTTED BY	DATE
TRACED BY		
NOTE BOOK		
QUANTITIES BY		
CHECKED BY		


FED. ROAD DIST. NO.	STATE	FED. AID PROJ. NO.	FISCAL YEAR	SHEET NO.	TOTAL SHEETS
HAWAII	HAW.	STP-0900(073)	2010	ADD.21	38

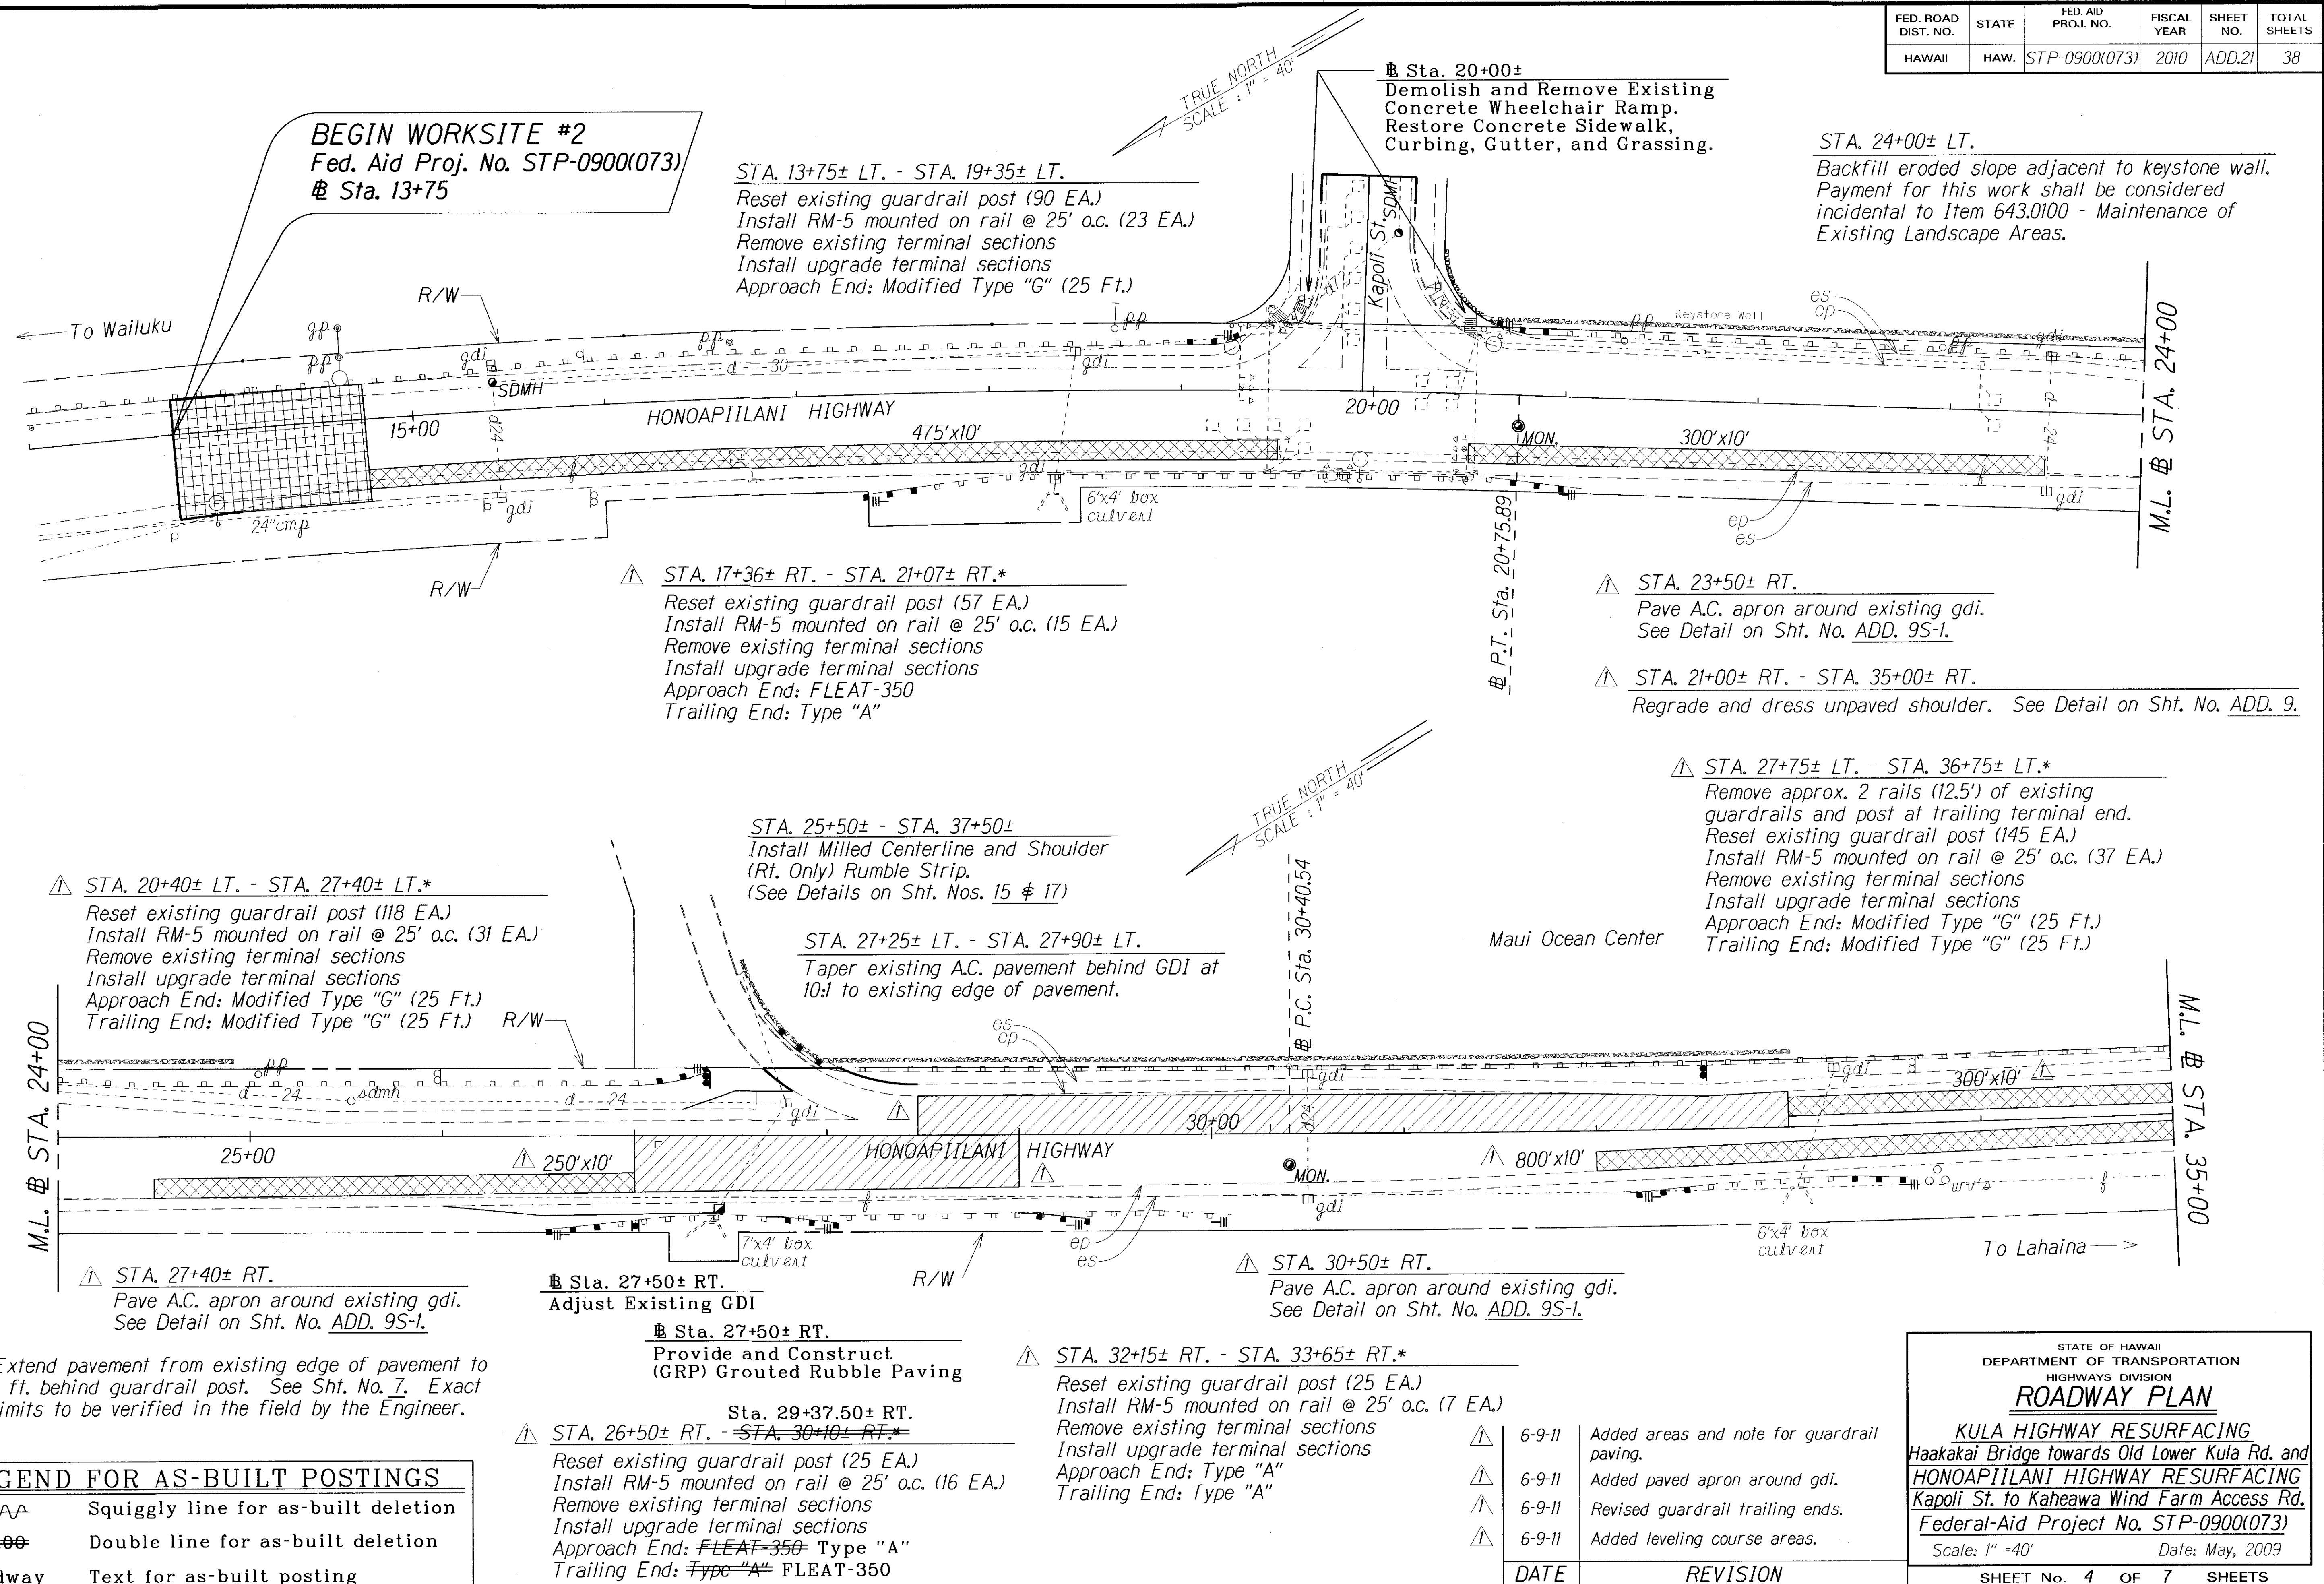


"AS-BUILT"

ADD. 21

FED. ROAD DIST. NO.	STATE	FED. AID PROJ. NO.	FISCAL YEAR	SHEET NO.	TOTAL SHEETS
HAWAII	HAW.	STP-0900(073)	2010	ADD.22	38

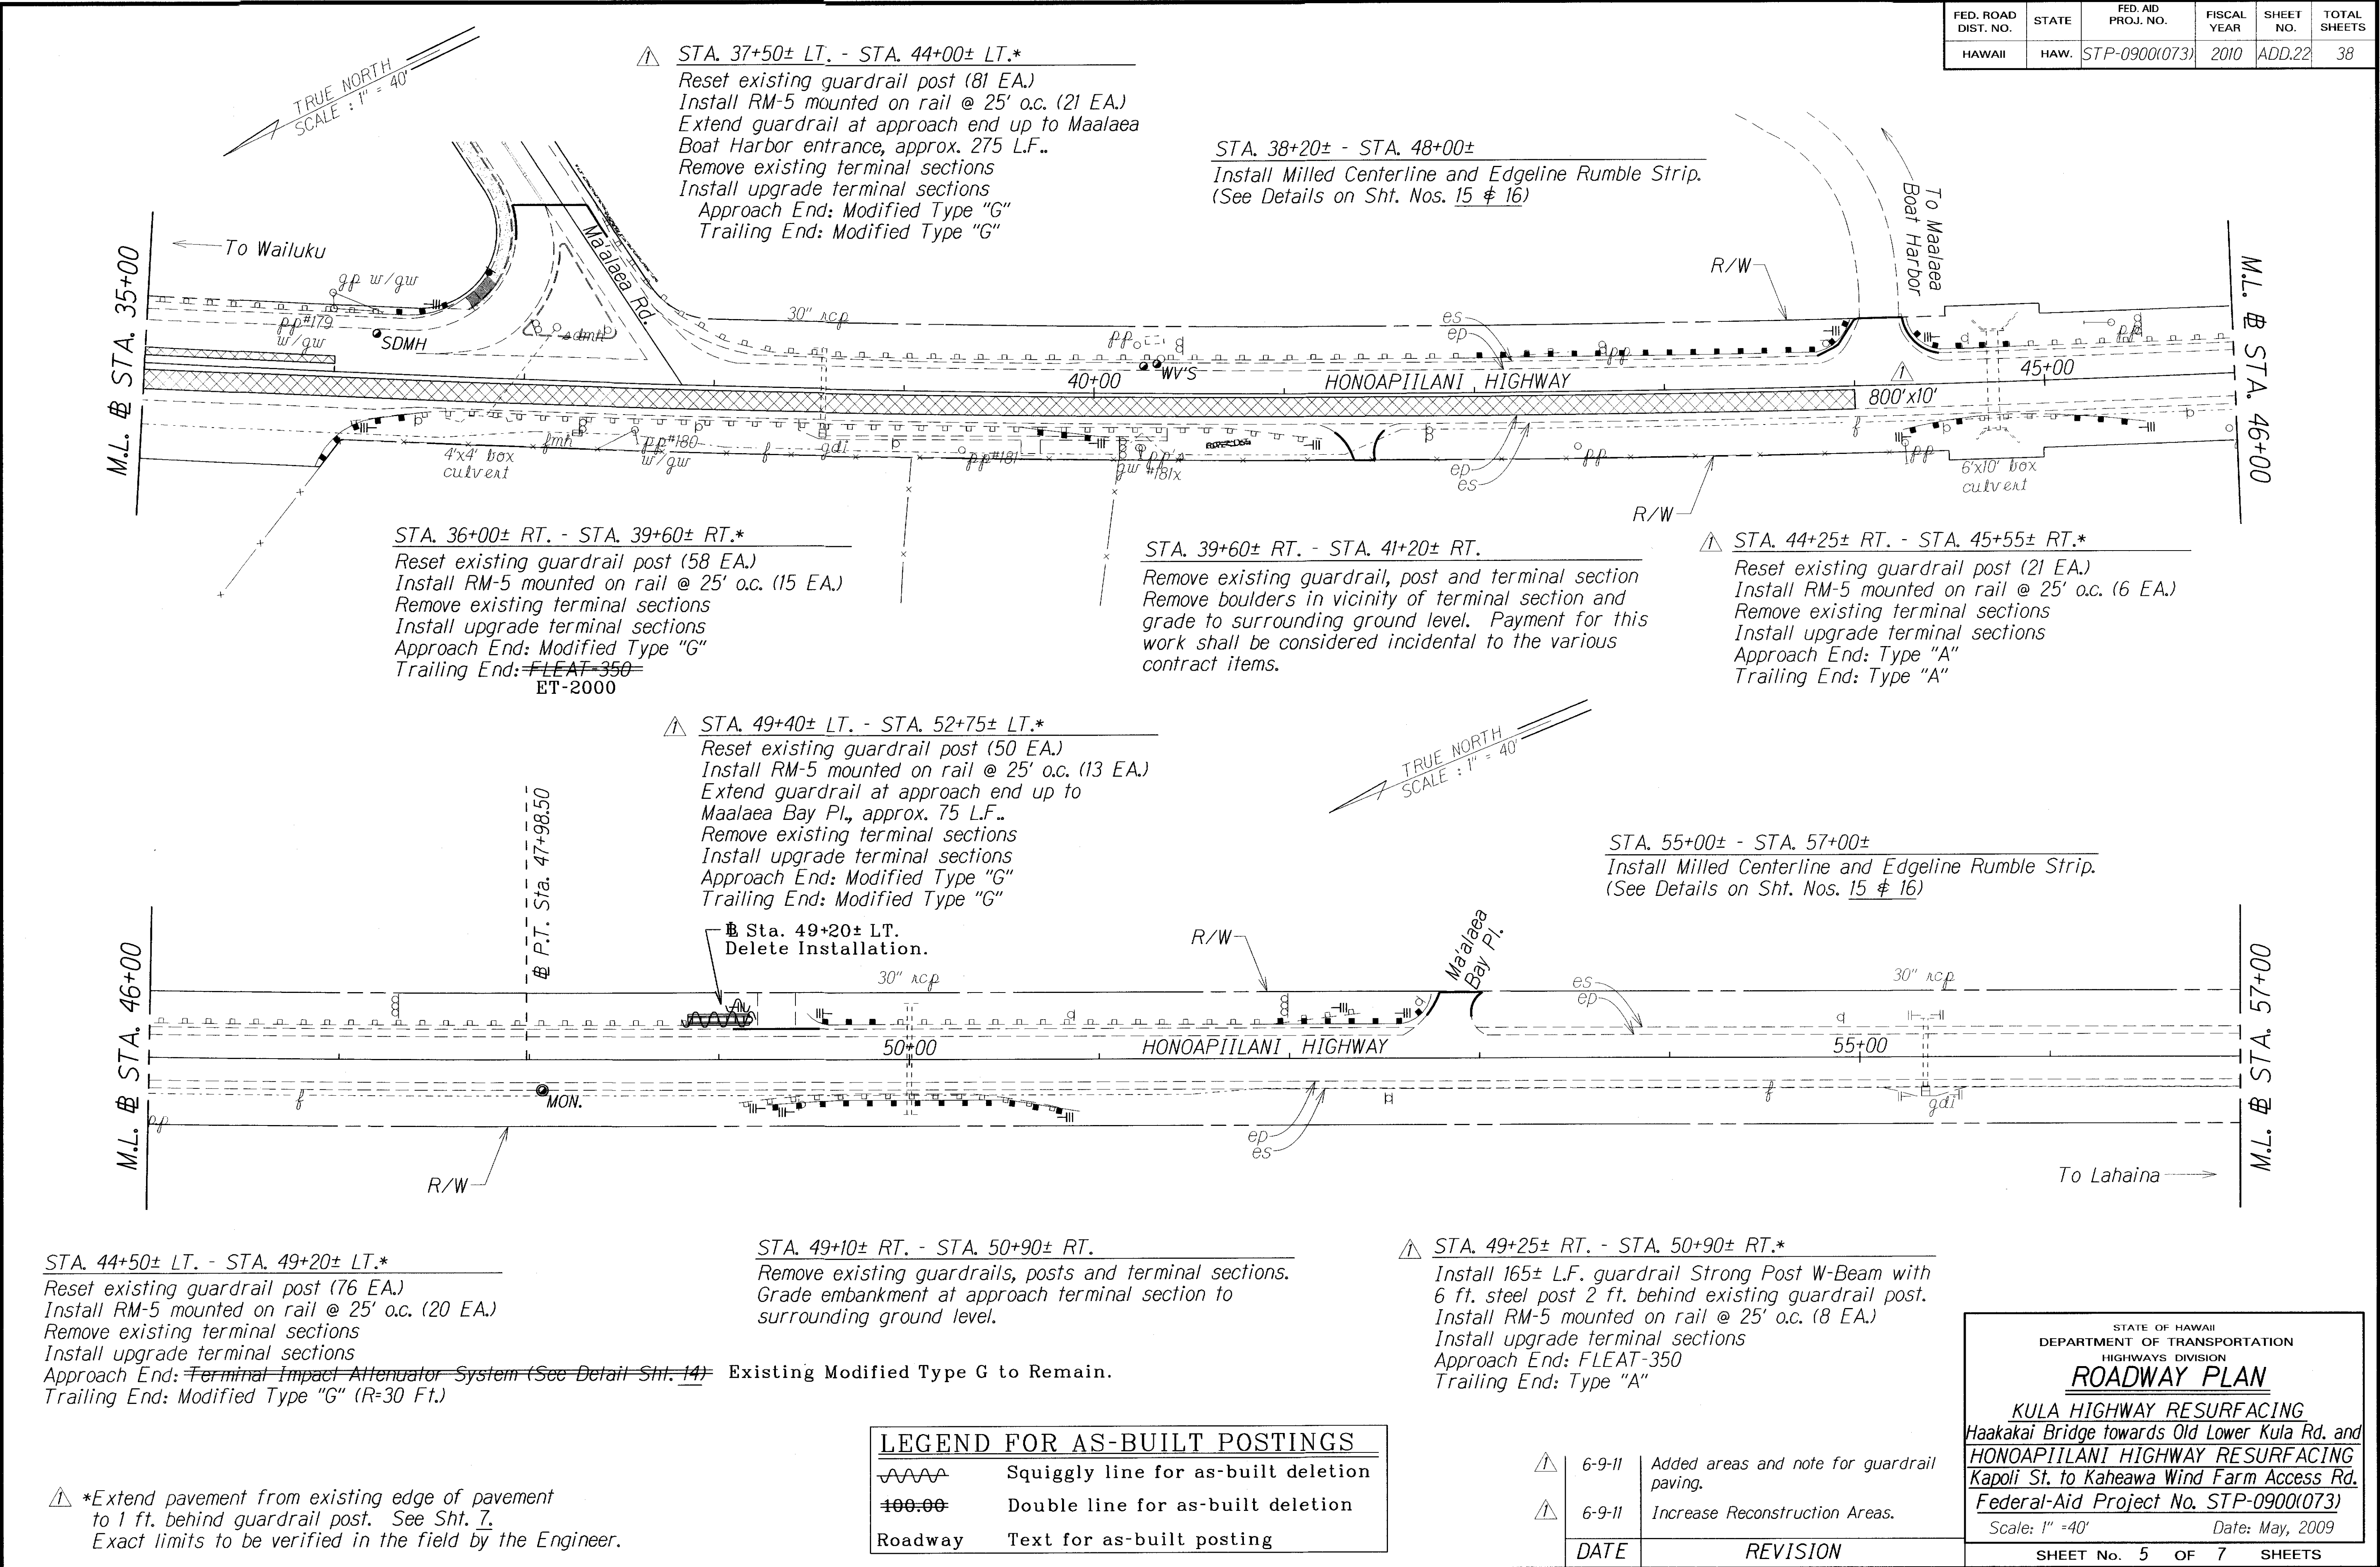

FED. ROAD DIST. NO.	STATE	FED. AID PROJ. NO.	FISCAL YEAR	SHEET NO.	TOTAL SHEETS
HAWAII	HAW.	STP-0900(073)	2010	ADD.23	38

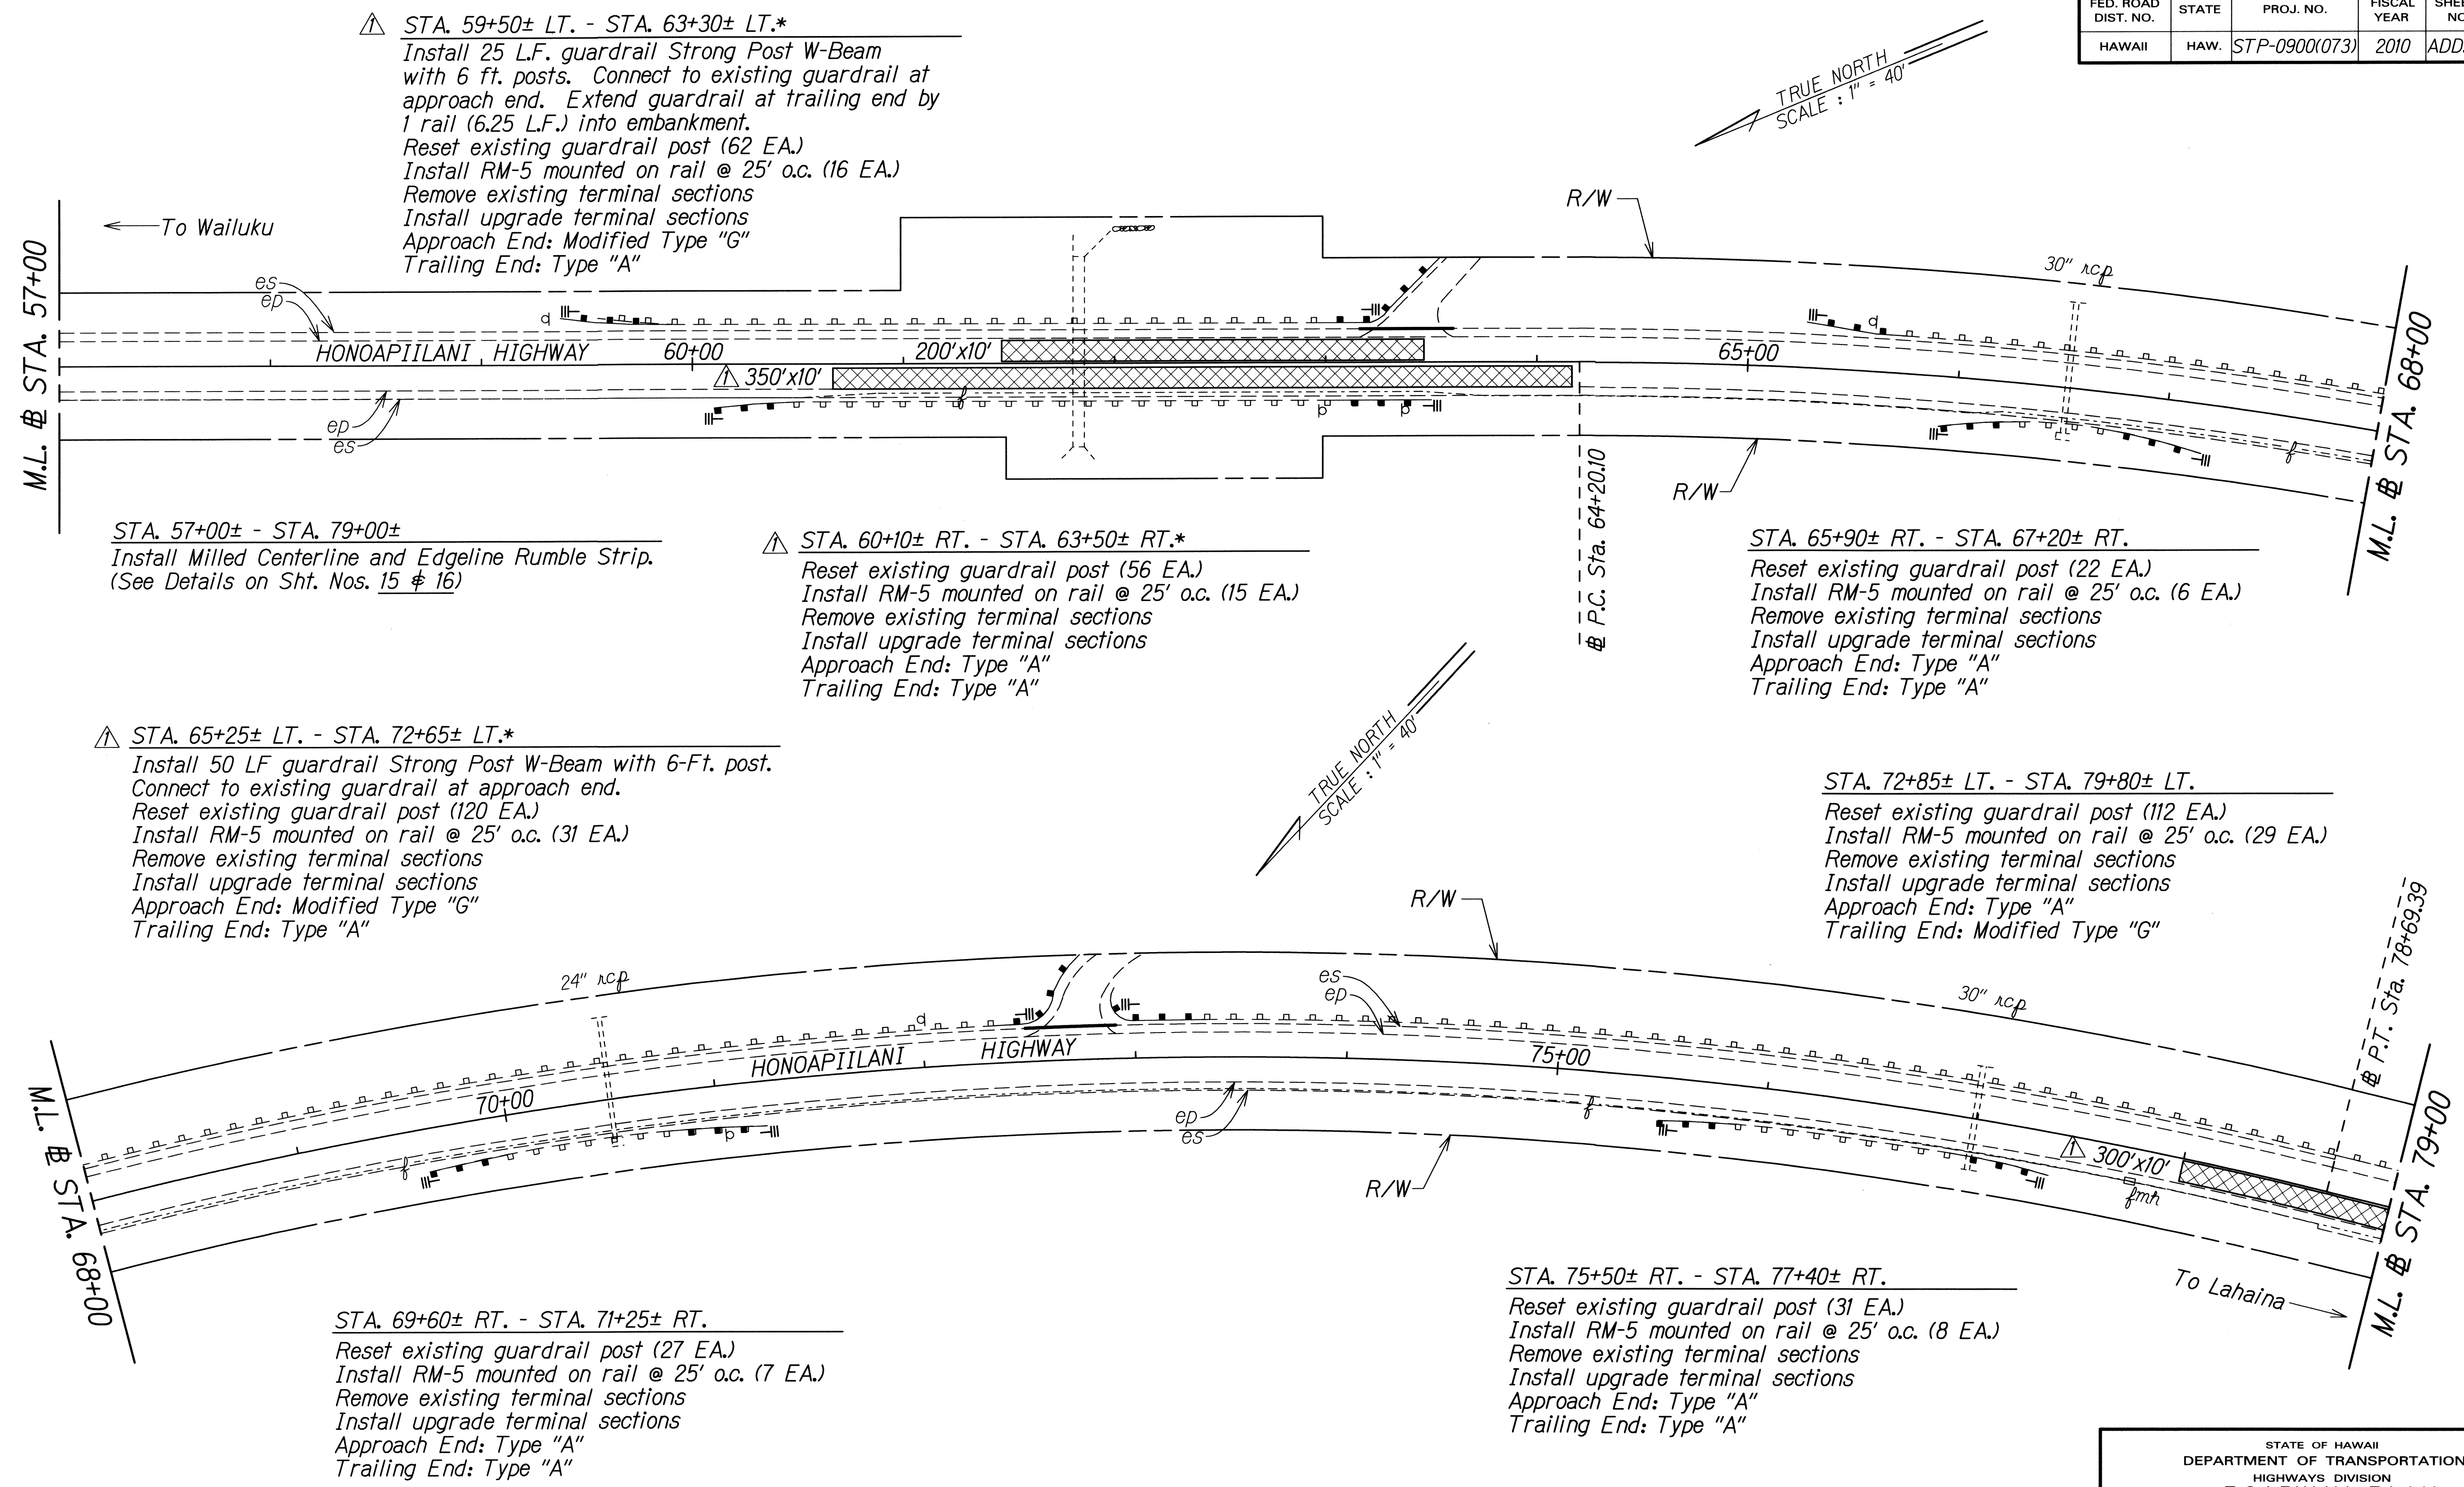

△ *Extend pavement from existing edge of pavement to 1 ft. behind guardrail post. See Sht. No. 7.
 Exact limits to be verified in the field by the Engineer.

△	6-9-11	Added areas and note for guardrail paving.
△	6-9-11	Added installation of new guardrails.
△	6-9-11	Increased Reconstruction Areas.
DATE	REVISION	

STATE OF HAWAII
 DEPARTMENT OF TRANSPORTATION
 HIGHWAYS DIVISION
ROADWAY PLAN
KULA HIGHWAY RESURFACING
Haakakai Bridge towards Old Lower Kula Rd. and HONOAPIILANI HIGHWAY RESURFACING
Kapoli St. to Kaheawa Wind Farm Access Rd.
Federal-Aid Project No. STP-0900(073)
 Scale: 1" = 40' Date: May, 2009
 SHEET No. 6 OF 7 SHEETS

