

INDEX TO DRAWINGS	
SHEET NO.	DESCRIPTION
1	TITLE SHEET
2	STANDARD PLANS SUMMARY
3	GENERAL NOTES AND LEGEND
4 - 5	WATER POLLUTION & EROSION CONTROL NOTES
6 - 9	TYPICAL SECTIONS AND DETAILS
10 - 14	GUARDRAIL DETAILS
15 - 17	RUMBLE STRIP DETAILS & NOTES
18 - 24	ROADWAY PLANS
25	PAVEMENT MARKING LEGEND, DETAILS & NOTES
26 - 29	SIGN PANEL LAYOUTS
30	WORK ZONE SIGNING PLAN, NOTES & DETAILS
31 - 37	SIGNING & PAVEMENT MARKING PLANS
38	TRAFFIC SIGNAL PLAN

STATE OF HAWAII

DEPARTMENT OF TRANSPORTATION

HIGHWAYS DIVISION

HONOLULU, HAWAII

"AS-BUILT"

PLANS FOR

KULA HIGHWAY RESURFACING

HAAKAKAI BRIDGE TOWARDS OLD LOWER KULA ROAD

AND




HONOAPIILANI HIGHWAY RESURFACING

KAPOLI STREET TO KAHEAWA WIND FARM ACCESS ROAD

FEDERAL-AID PROJECT NO. STP-0900(073)

DISTRICTS OF MAKAWAO AND WAILUKU

ISLAND OF MAUI

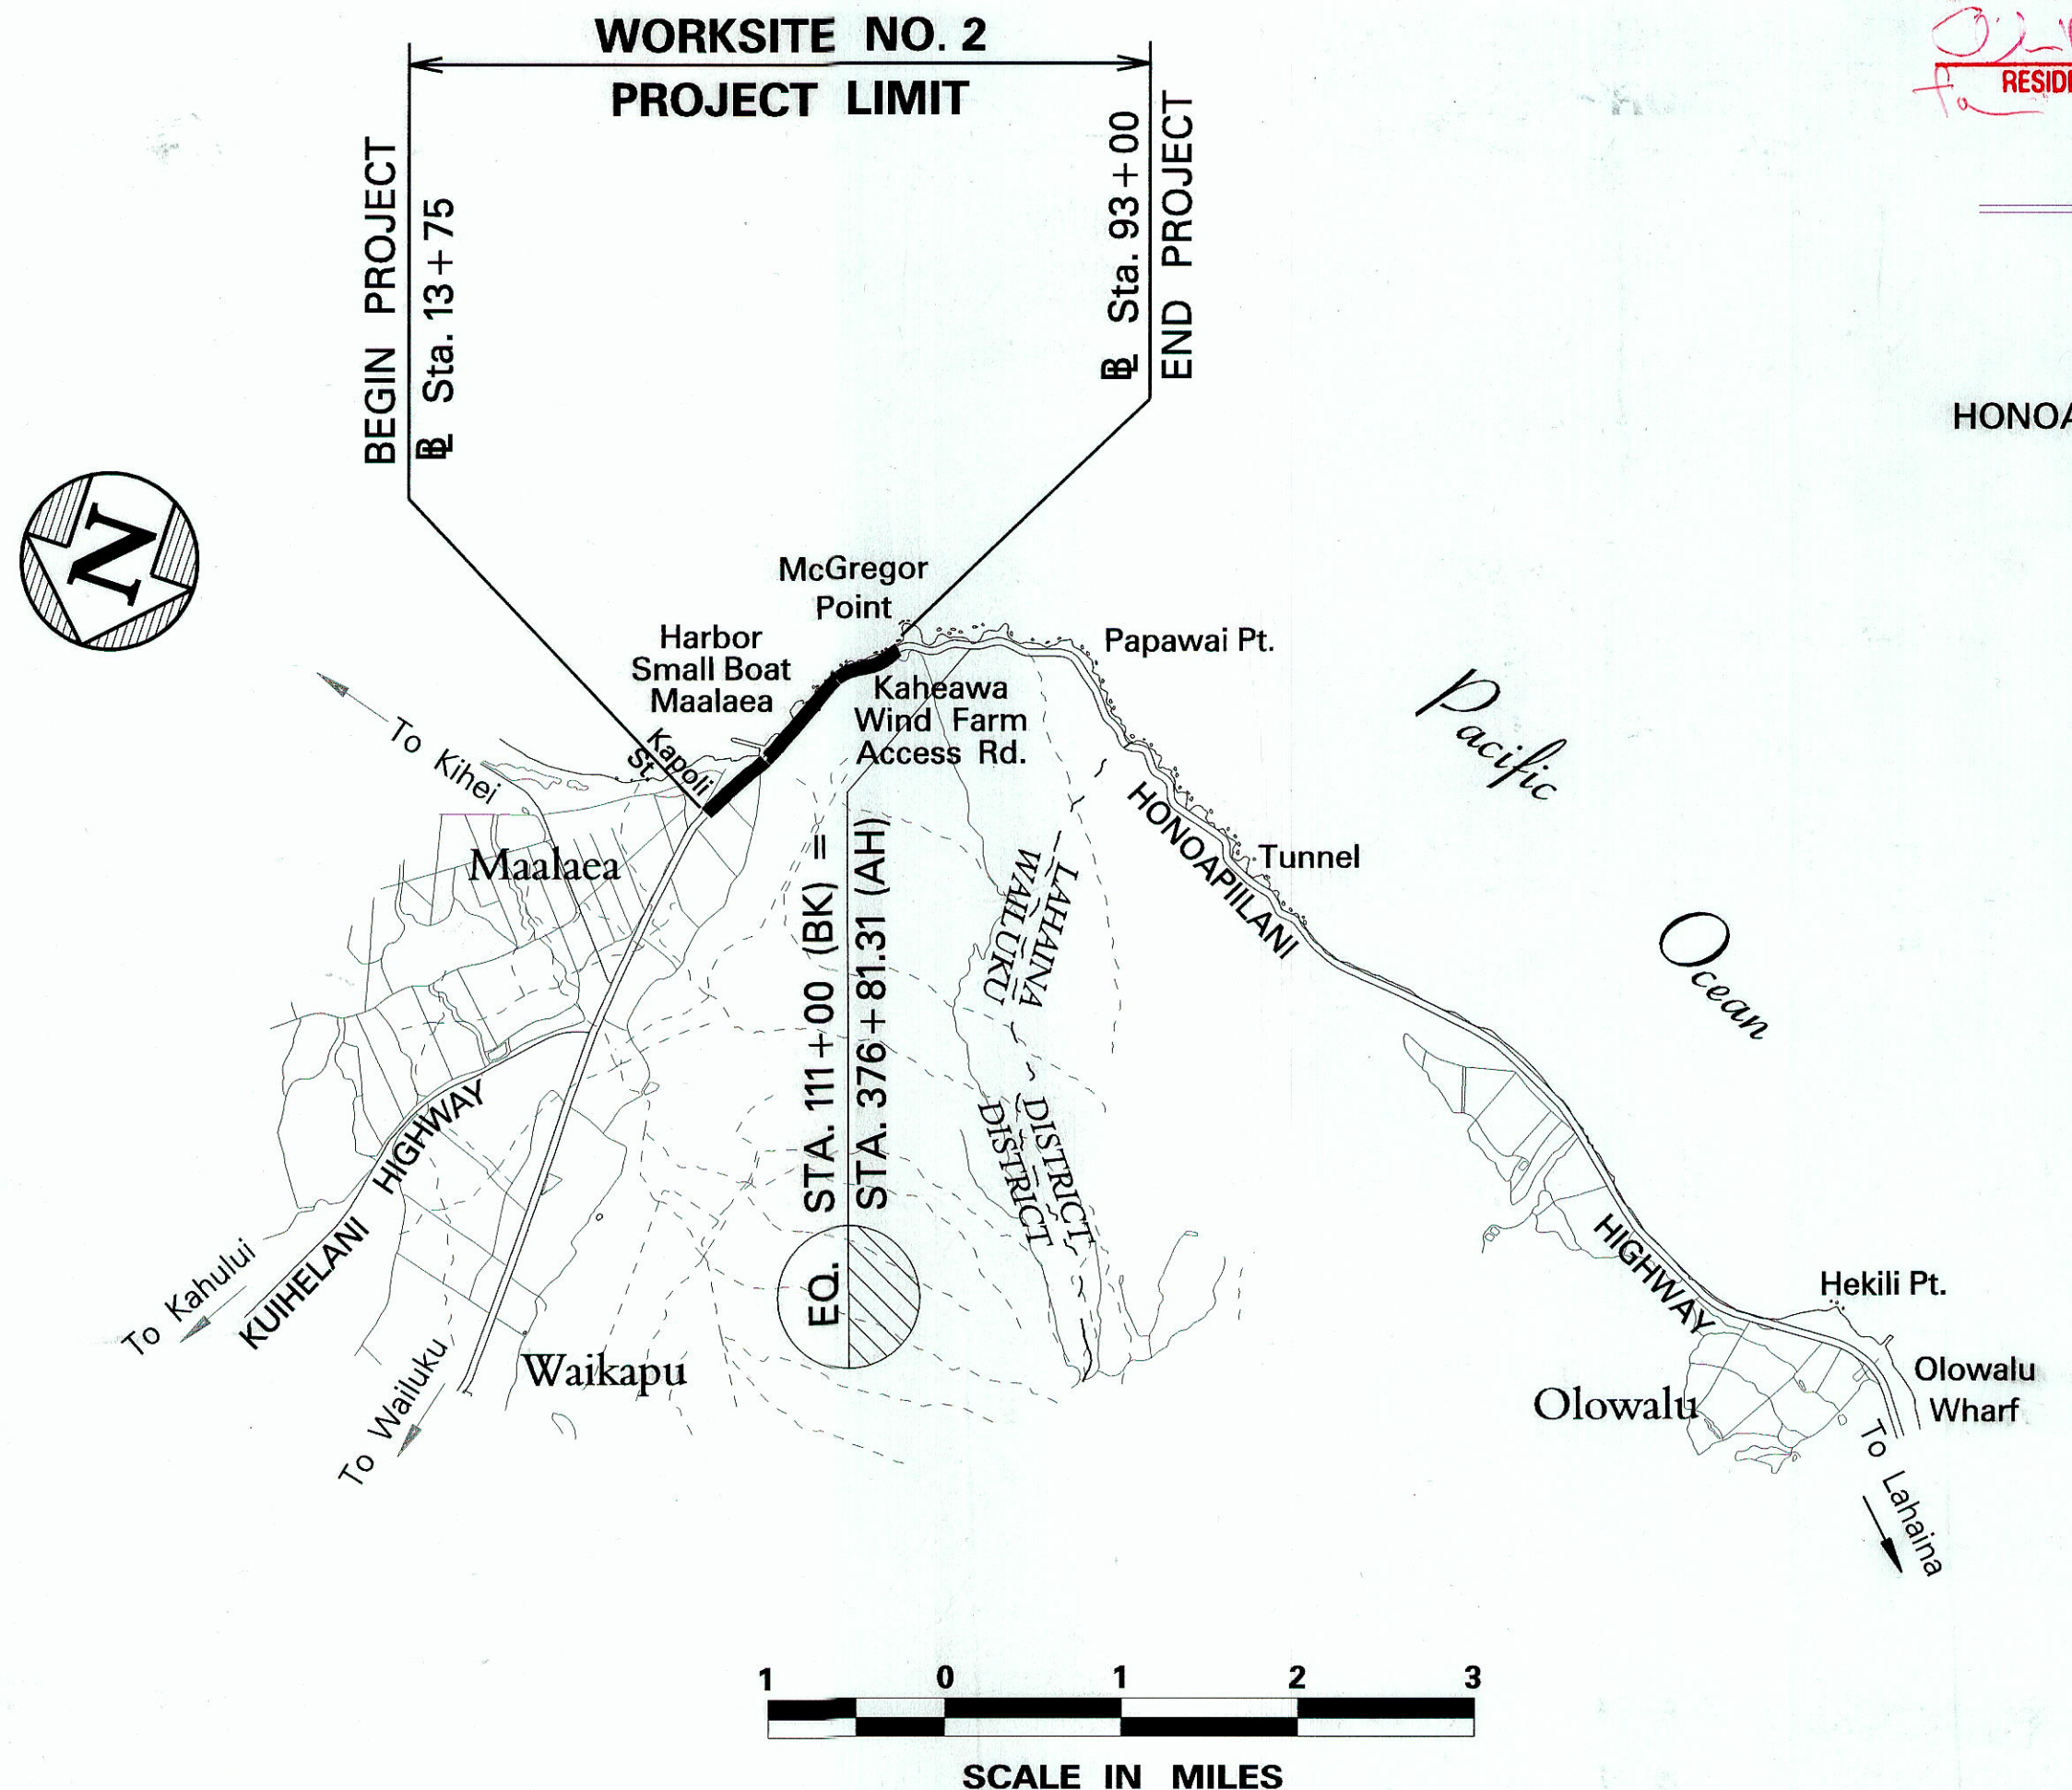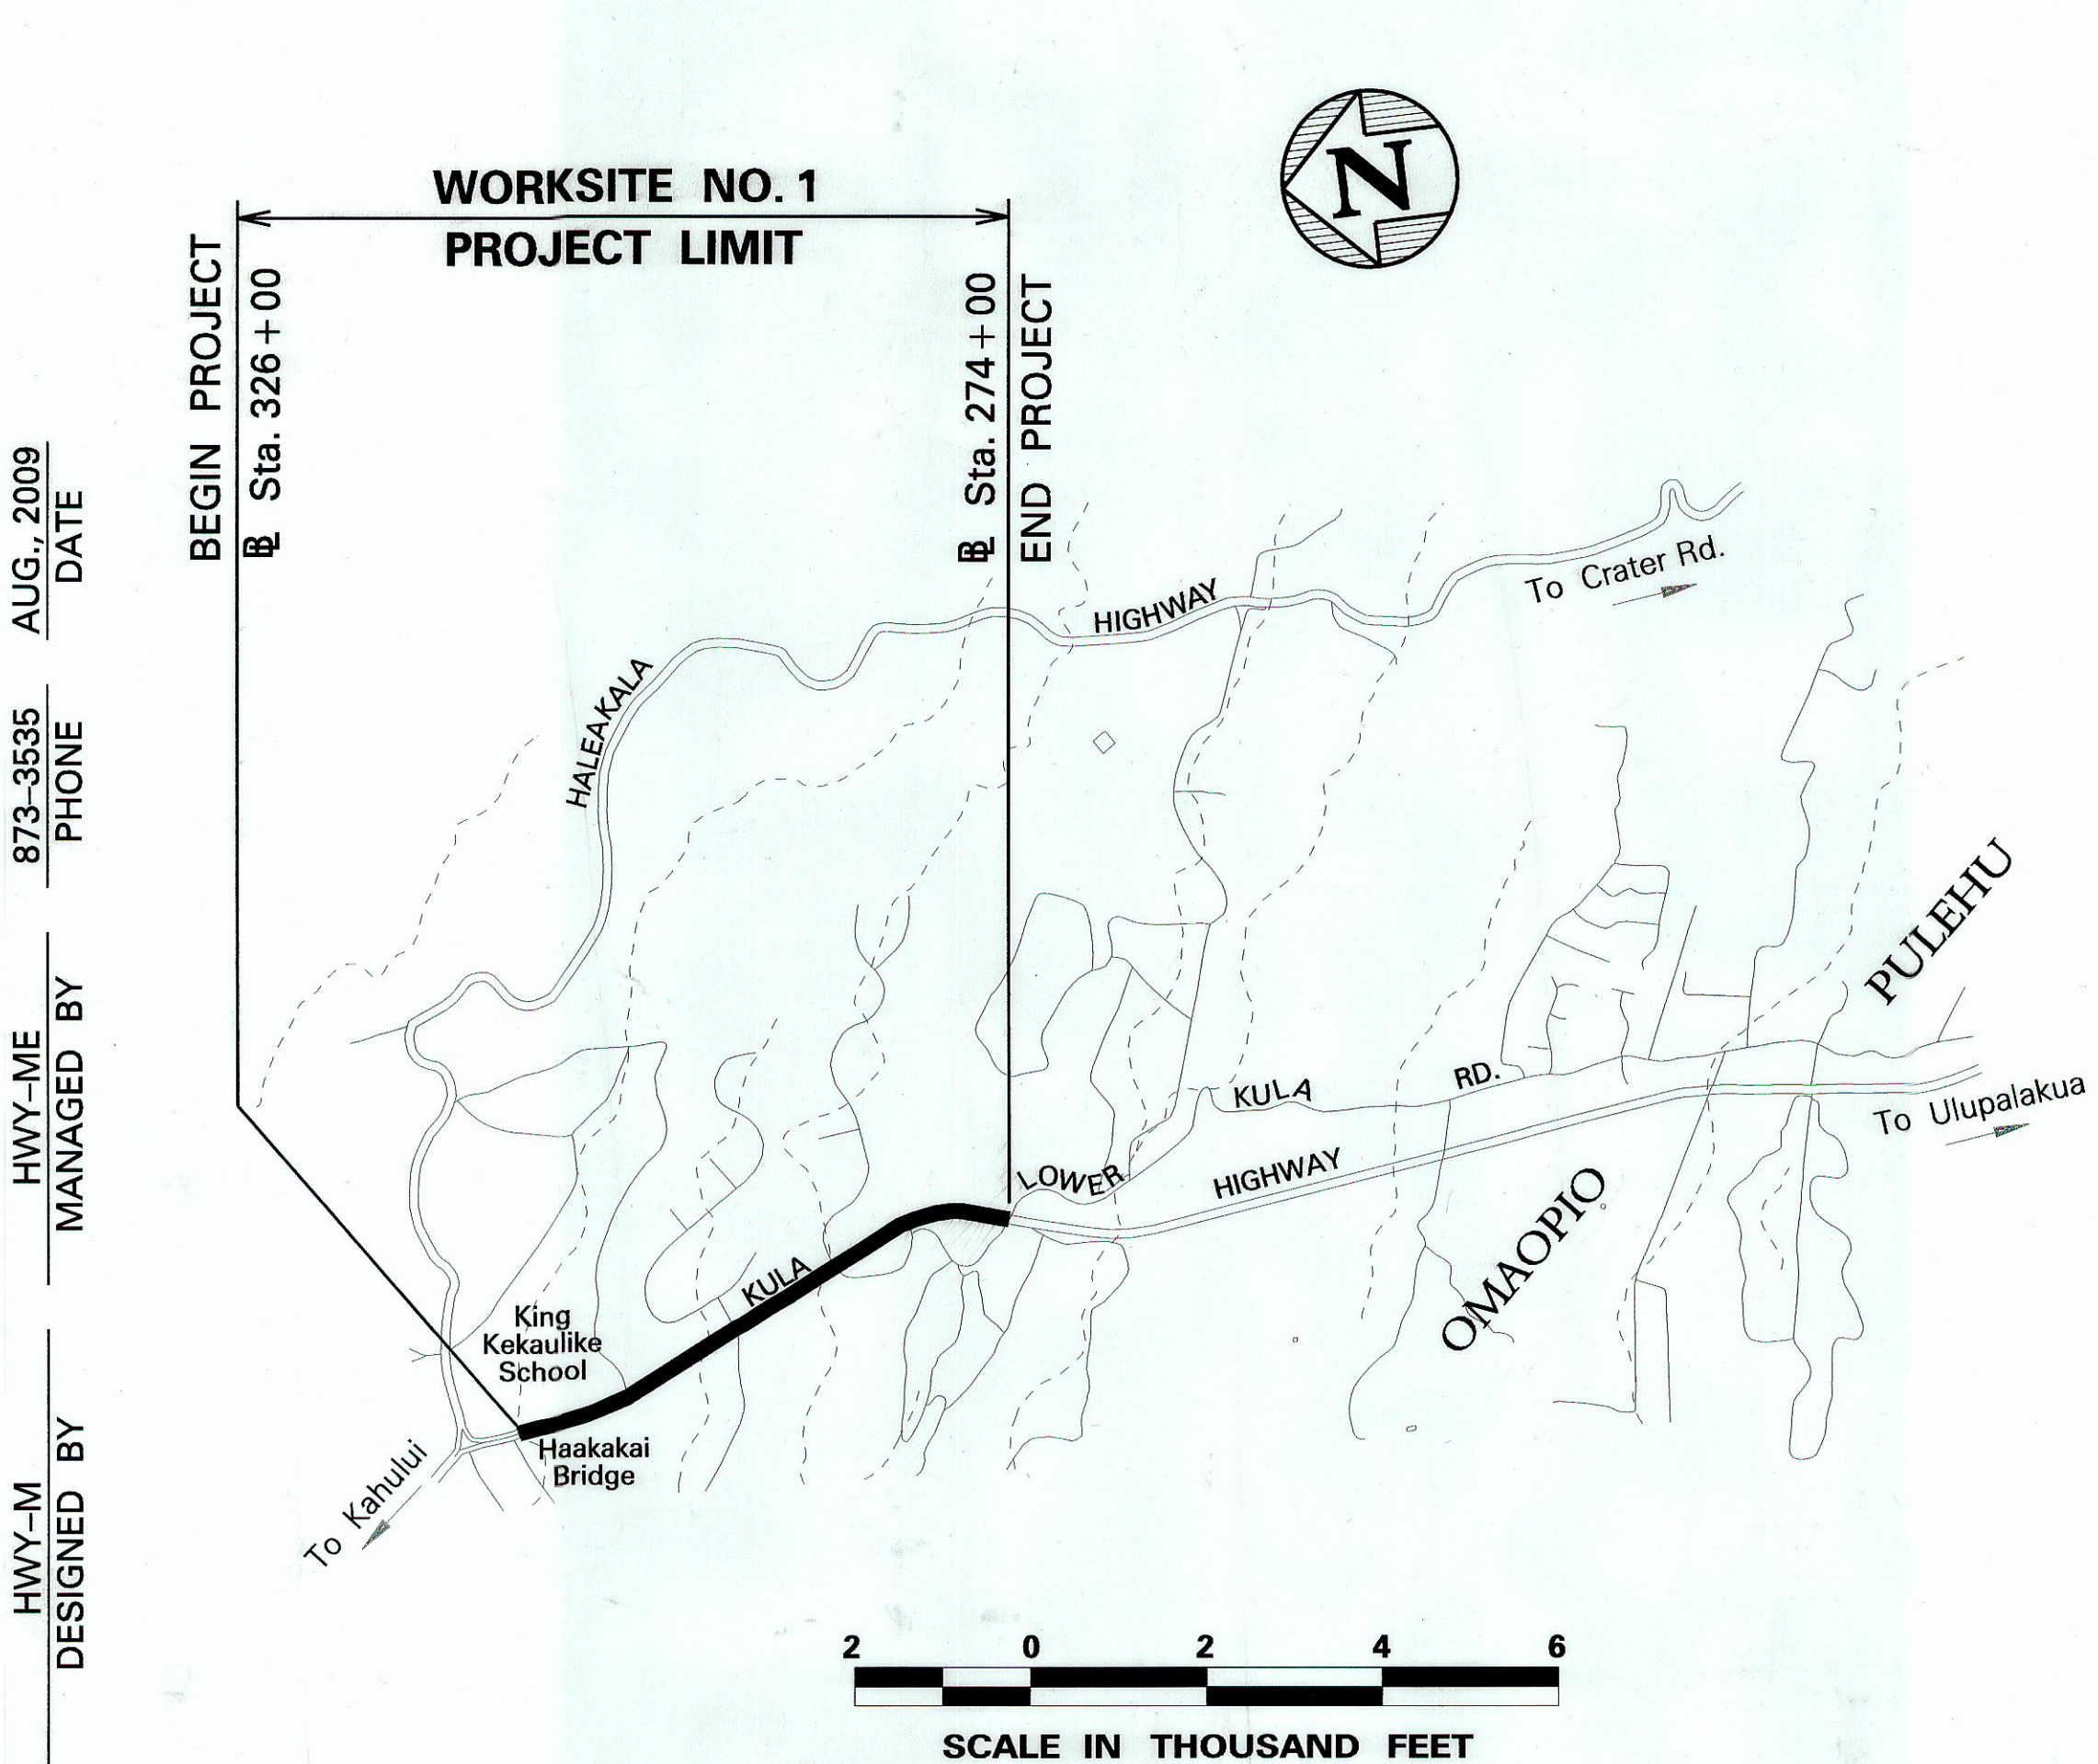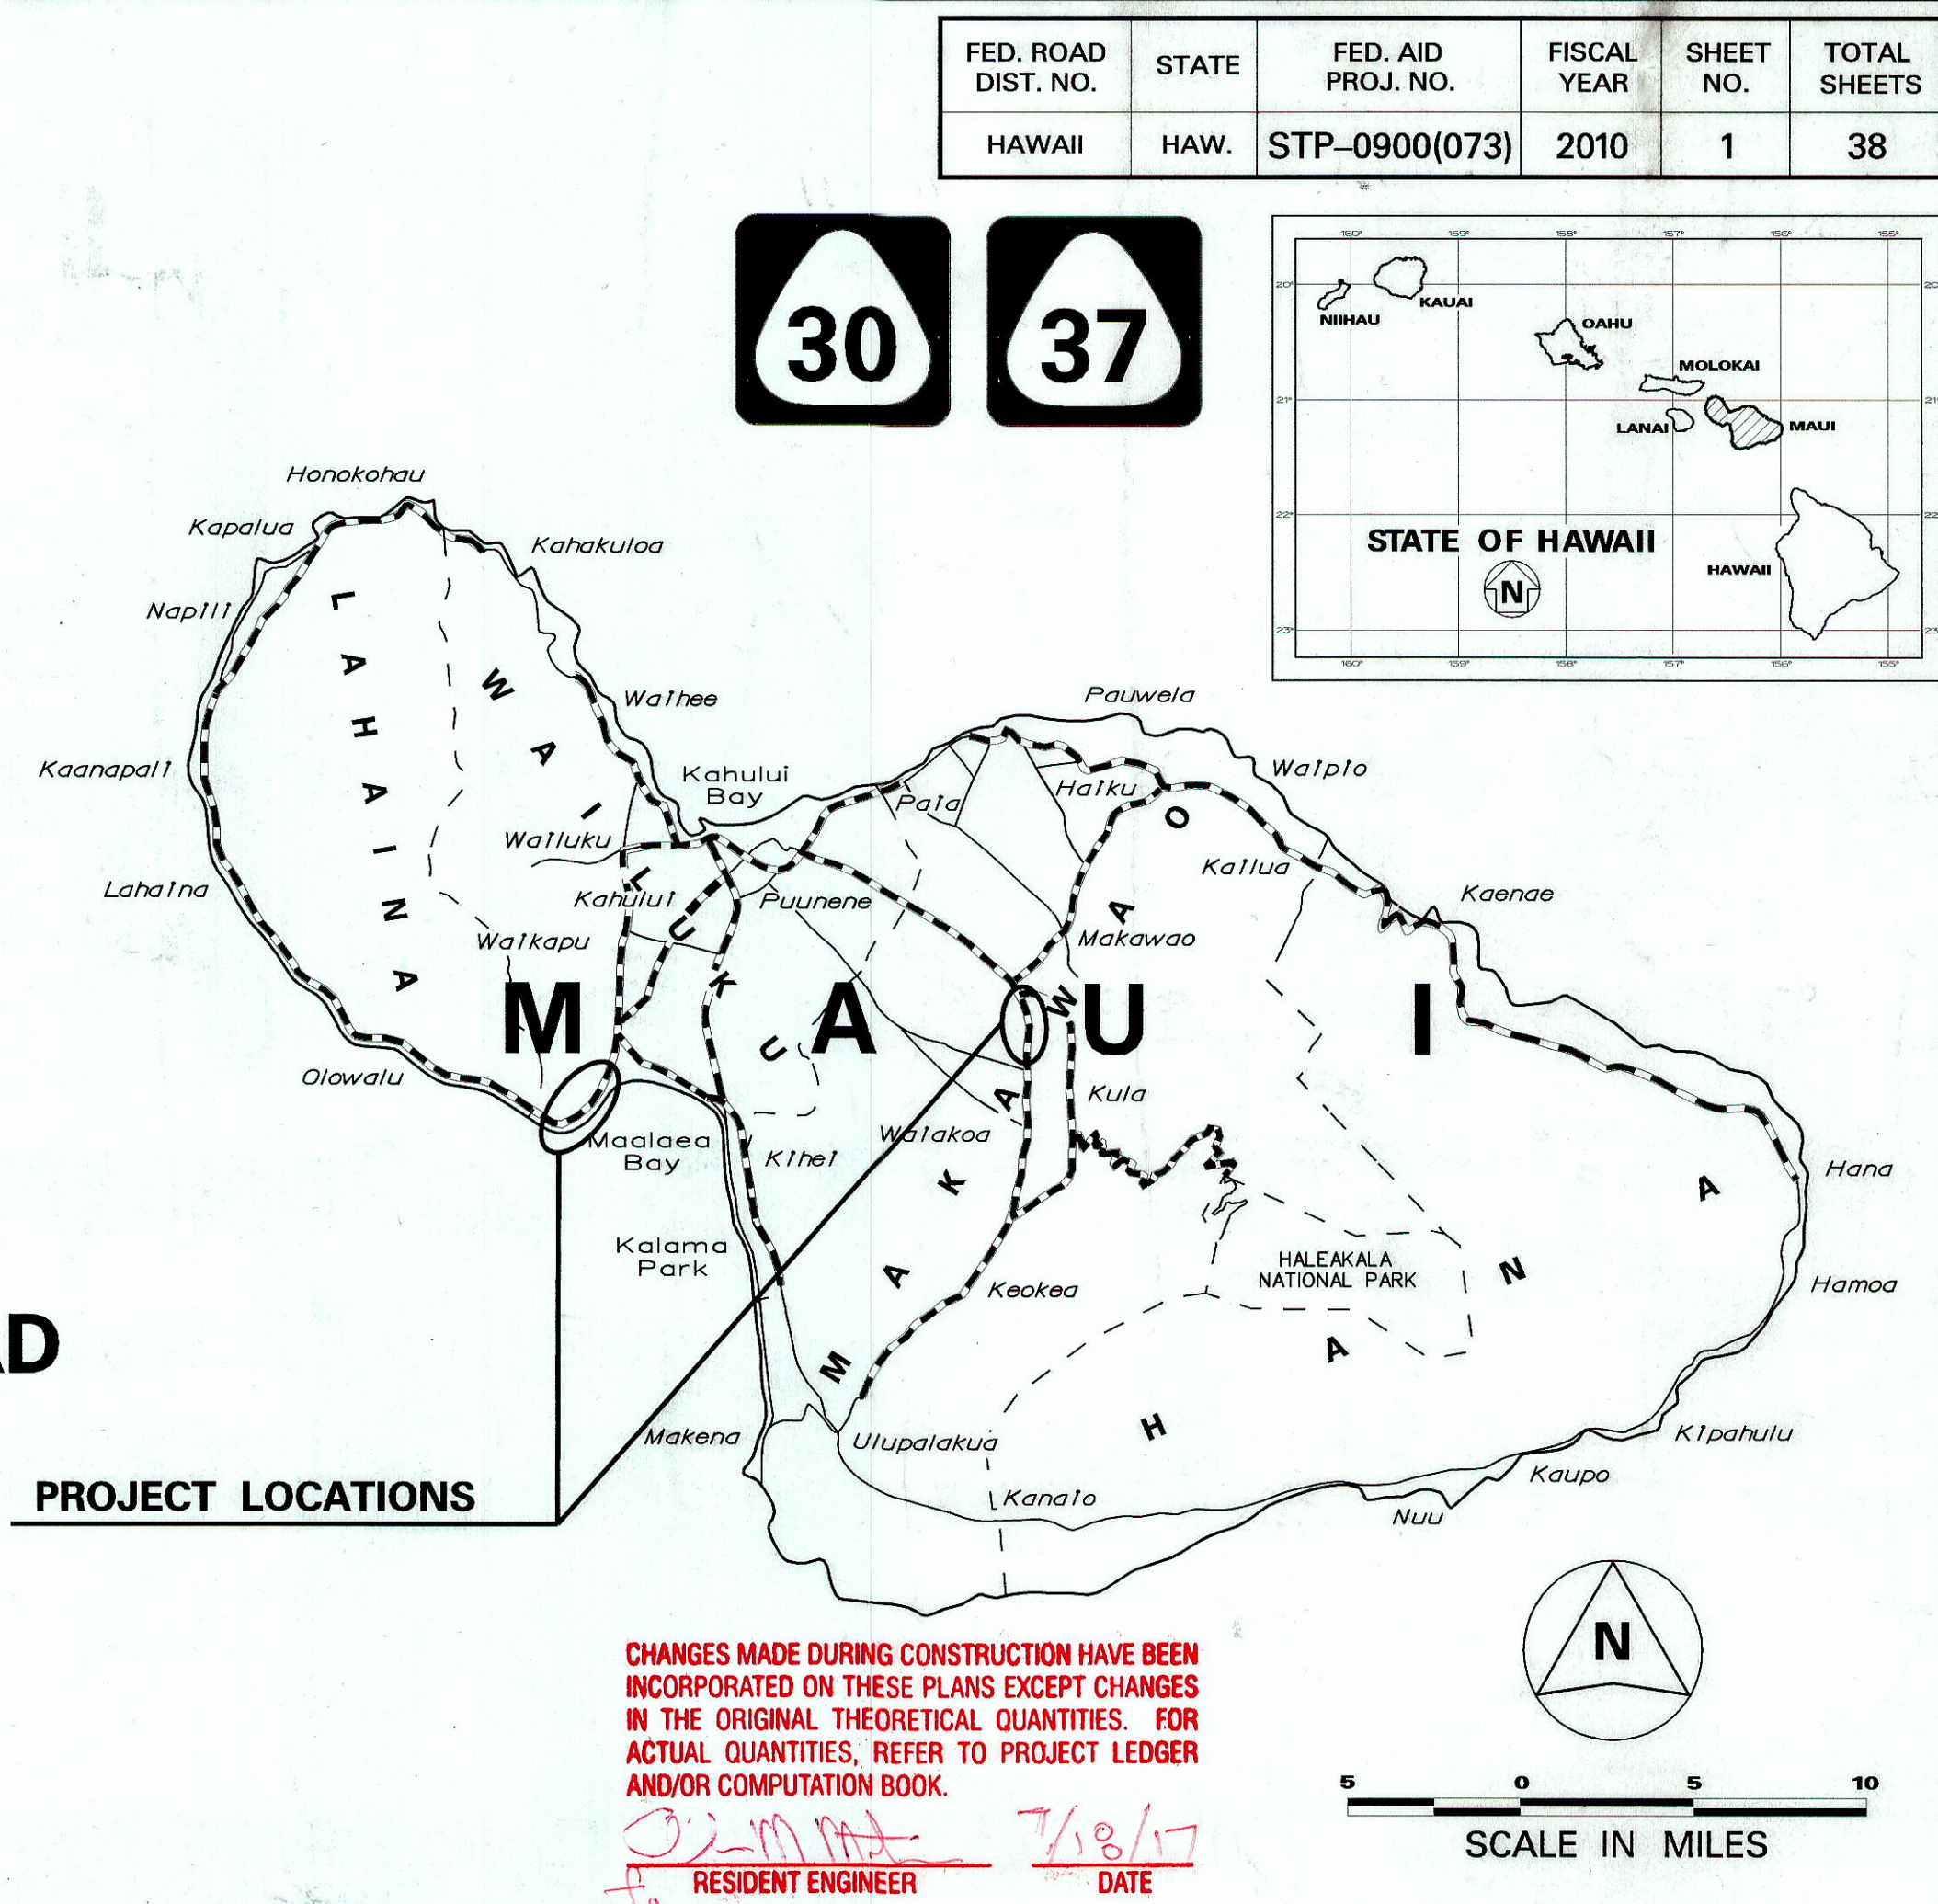

FEDERAL AID PROJECTS PREVIOUSLY CONSTRUCTED OR UNDER CONSTRUCTION

KULA HIGHWAY MILE POST

7.84 TO MILE POST

8.83

HONOAPIILANI HIGHWAY MILE POST

6.27 TO MILE POST

7.67

DESIGN DESIGNATION		
TRAFFIC DATA	KULA HWY. HAAKAKAI BRIDGE TO OLD LOWER KULA RD.	HONOAPIILANI HWY. KAPOLI ST. TO KAHEAWA WIND FARM ACCESS RD.
ADT (2009)	15,600	26,300
ADT (2019)	19,700	36,900
DHV	2,000	3,000
DESIGN K	10.0	8.0
DESIGN D	60/40	55/45
DESIGN T	3.0	3.5
T24	3.5	5.0

DEPARTMENT OF TRANSPORTATION

STATE OF HAWAII

APPROVED:

DIR. OF TRANSPORTATION

DATE

5/3/11