


FED. ROAD DIST. NO.	STATE	FED. AID PROJ. NO.	FISCAL YEAR	SHEET NO.	TOTAL SHEETS
HAWAII	HAW.	NH-0900(080)	2013	ADD.9	47

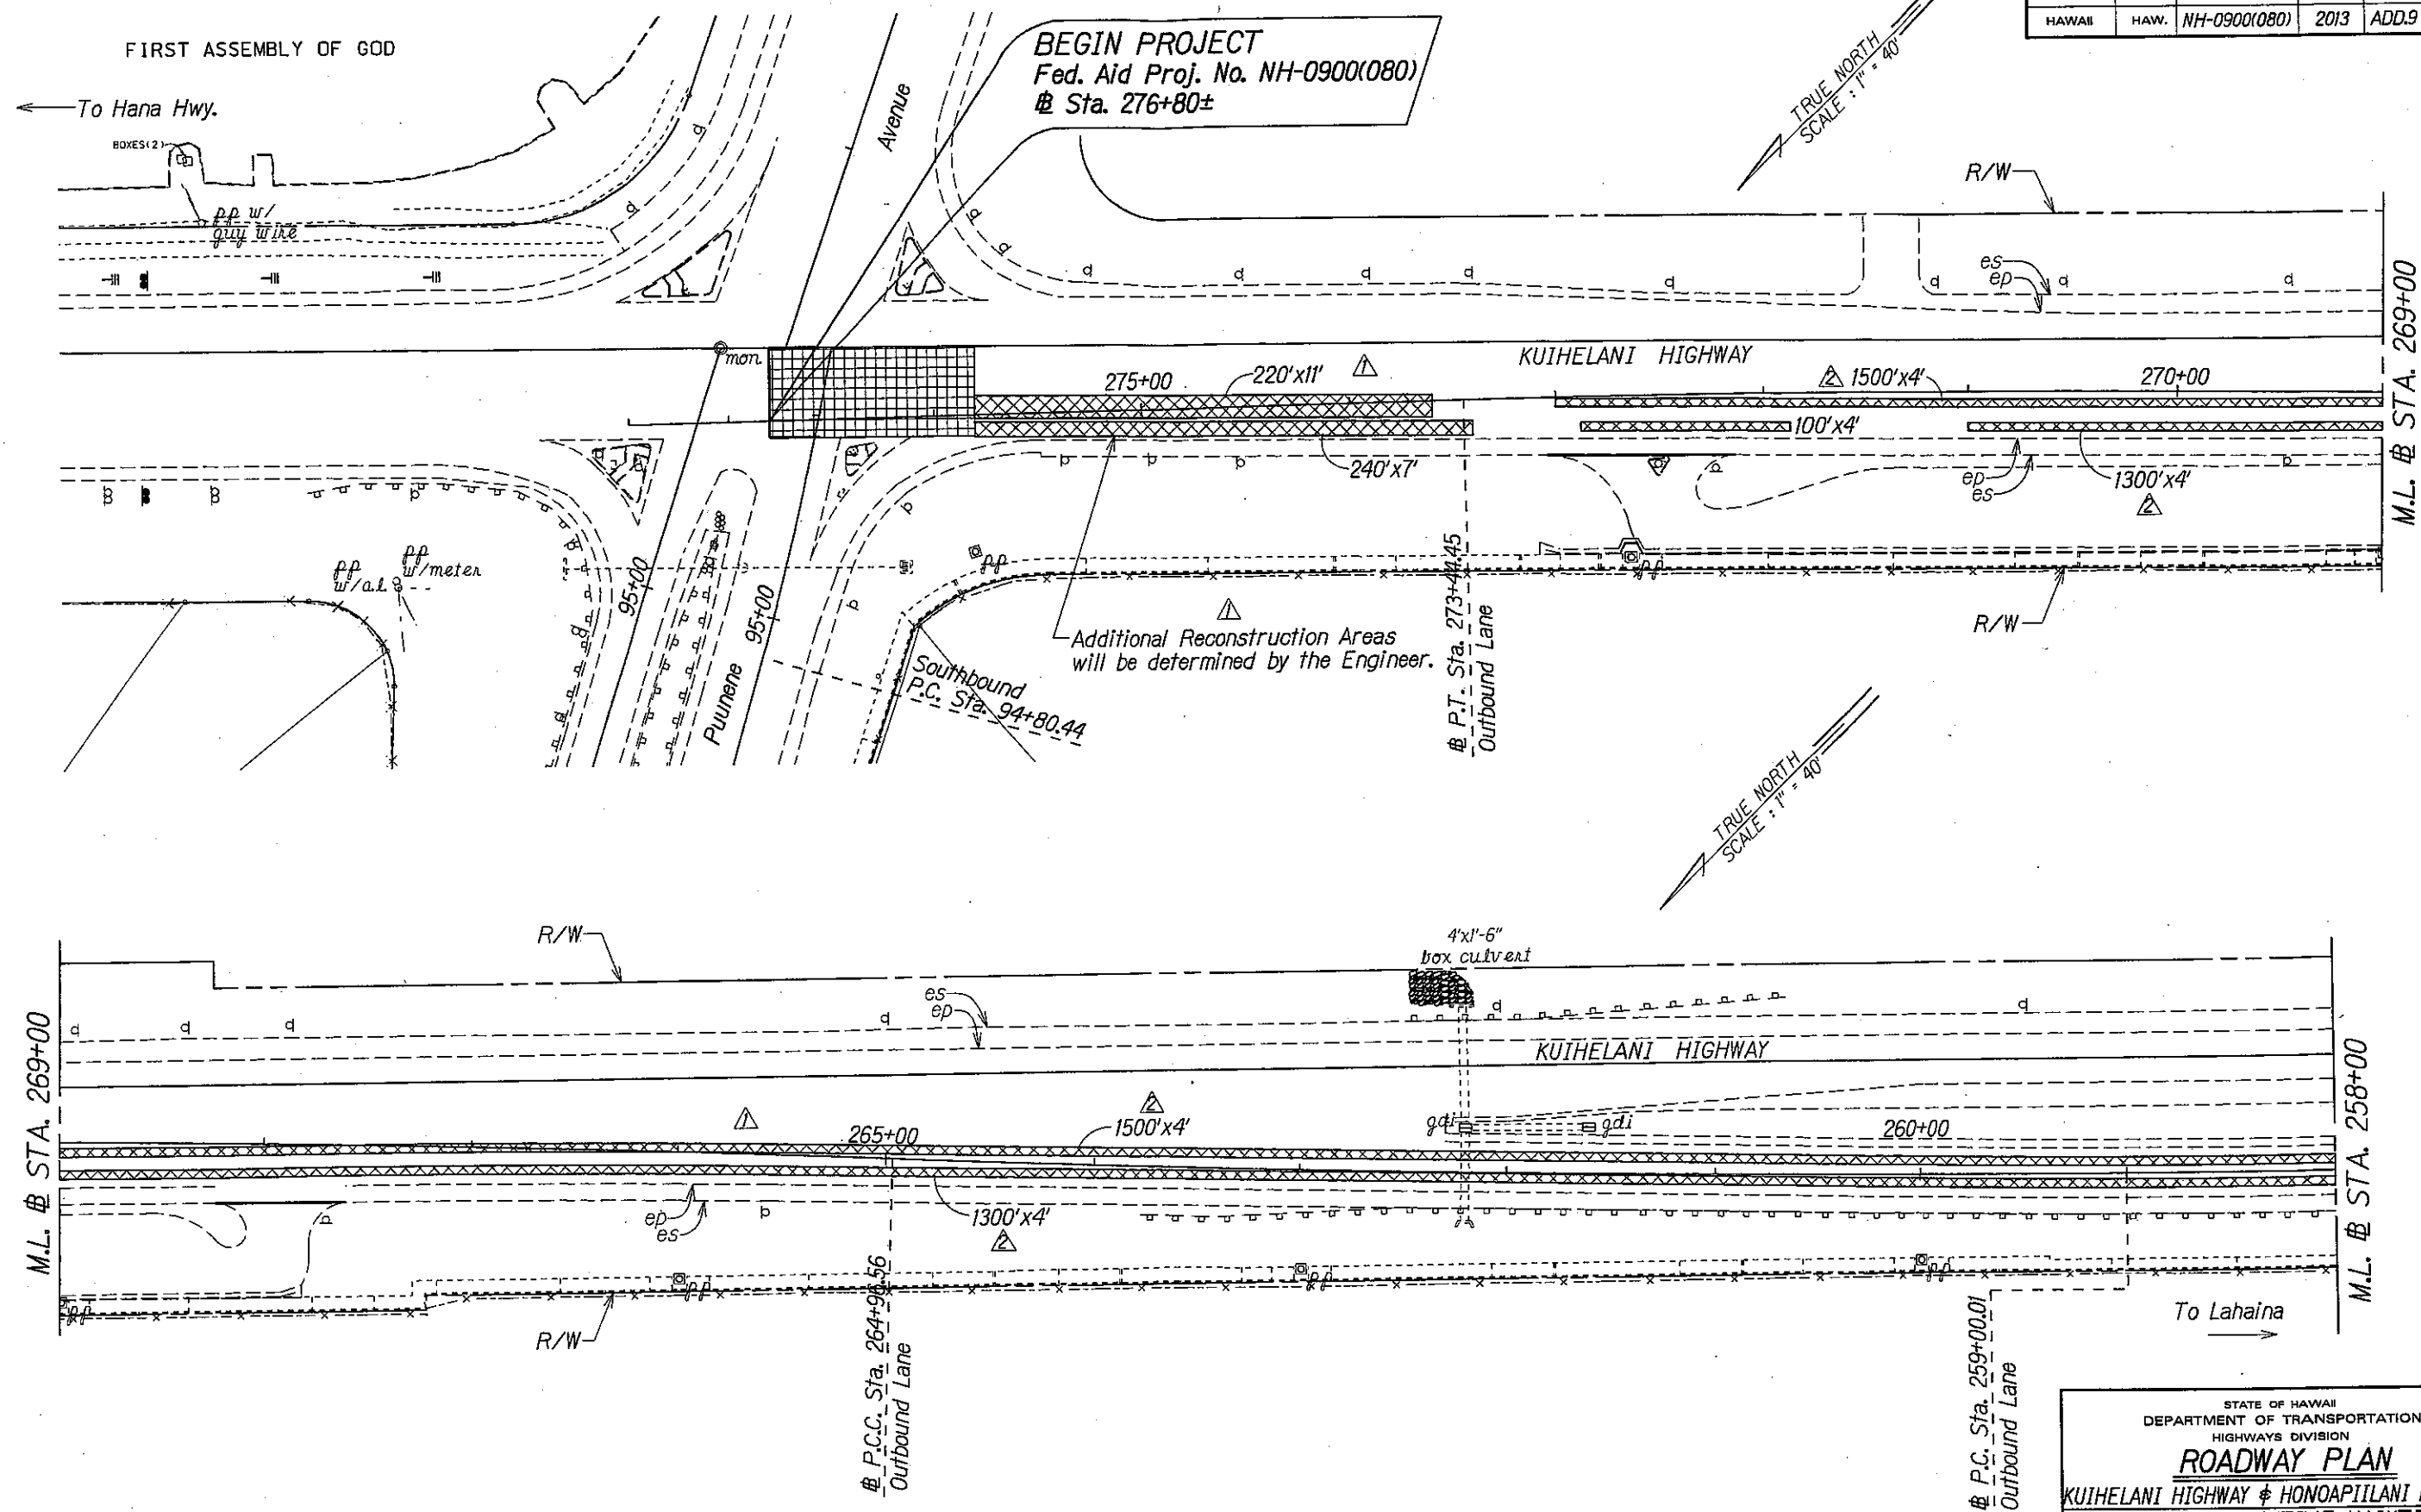

DATE	1/12
SURVEY PLOTTED BY	
DRAWN BY	
DESIGNED BY	
CHECKED BY	
NOTED BY	
APPROVED BY	

2-22-13	Added Reconstruction Areas and notes.
3-4-13	Revised Reconstruction Limits.
DATE	REVISION

STATE OF HAWAII
DEPARTMENT OF TRANSPORTATION
HIGHWAYS DIVISION
ROADWAY PLAN
KUIHELANI HIGHWAY & HONOAPIILANI HIGHWAY
PAVEMENT PREVENTIVE MAINTENANCE
Puunene Avenue to Honoapiilani Highway
and Kuihelani Highway to Kapoli Street
Federal-Aid Project No. NH-0900(080)
Scale: 1" = 40'
Date: May, 2012

SHEET No. 1 OF 18 SHEETS
ADD. 9