


FED. ROAD DIST. NO.	STATE	FED. AID PROJ. NO.	FISCAL YEAR	SHEET NO.	TOTAL SHEETS
HAWAII	HAW.	NH-0900(080)	2013	9	47

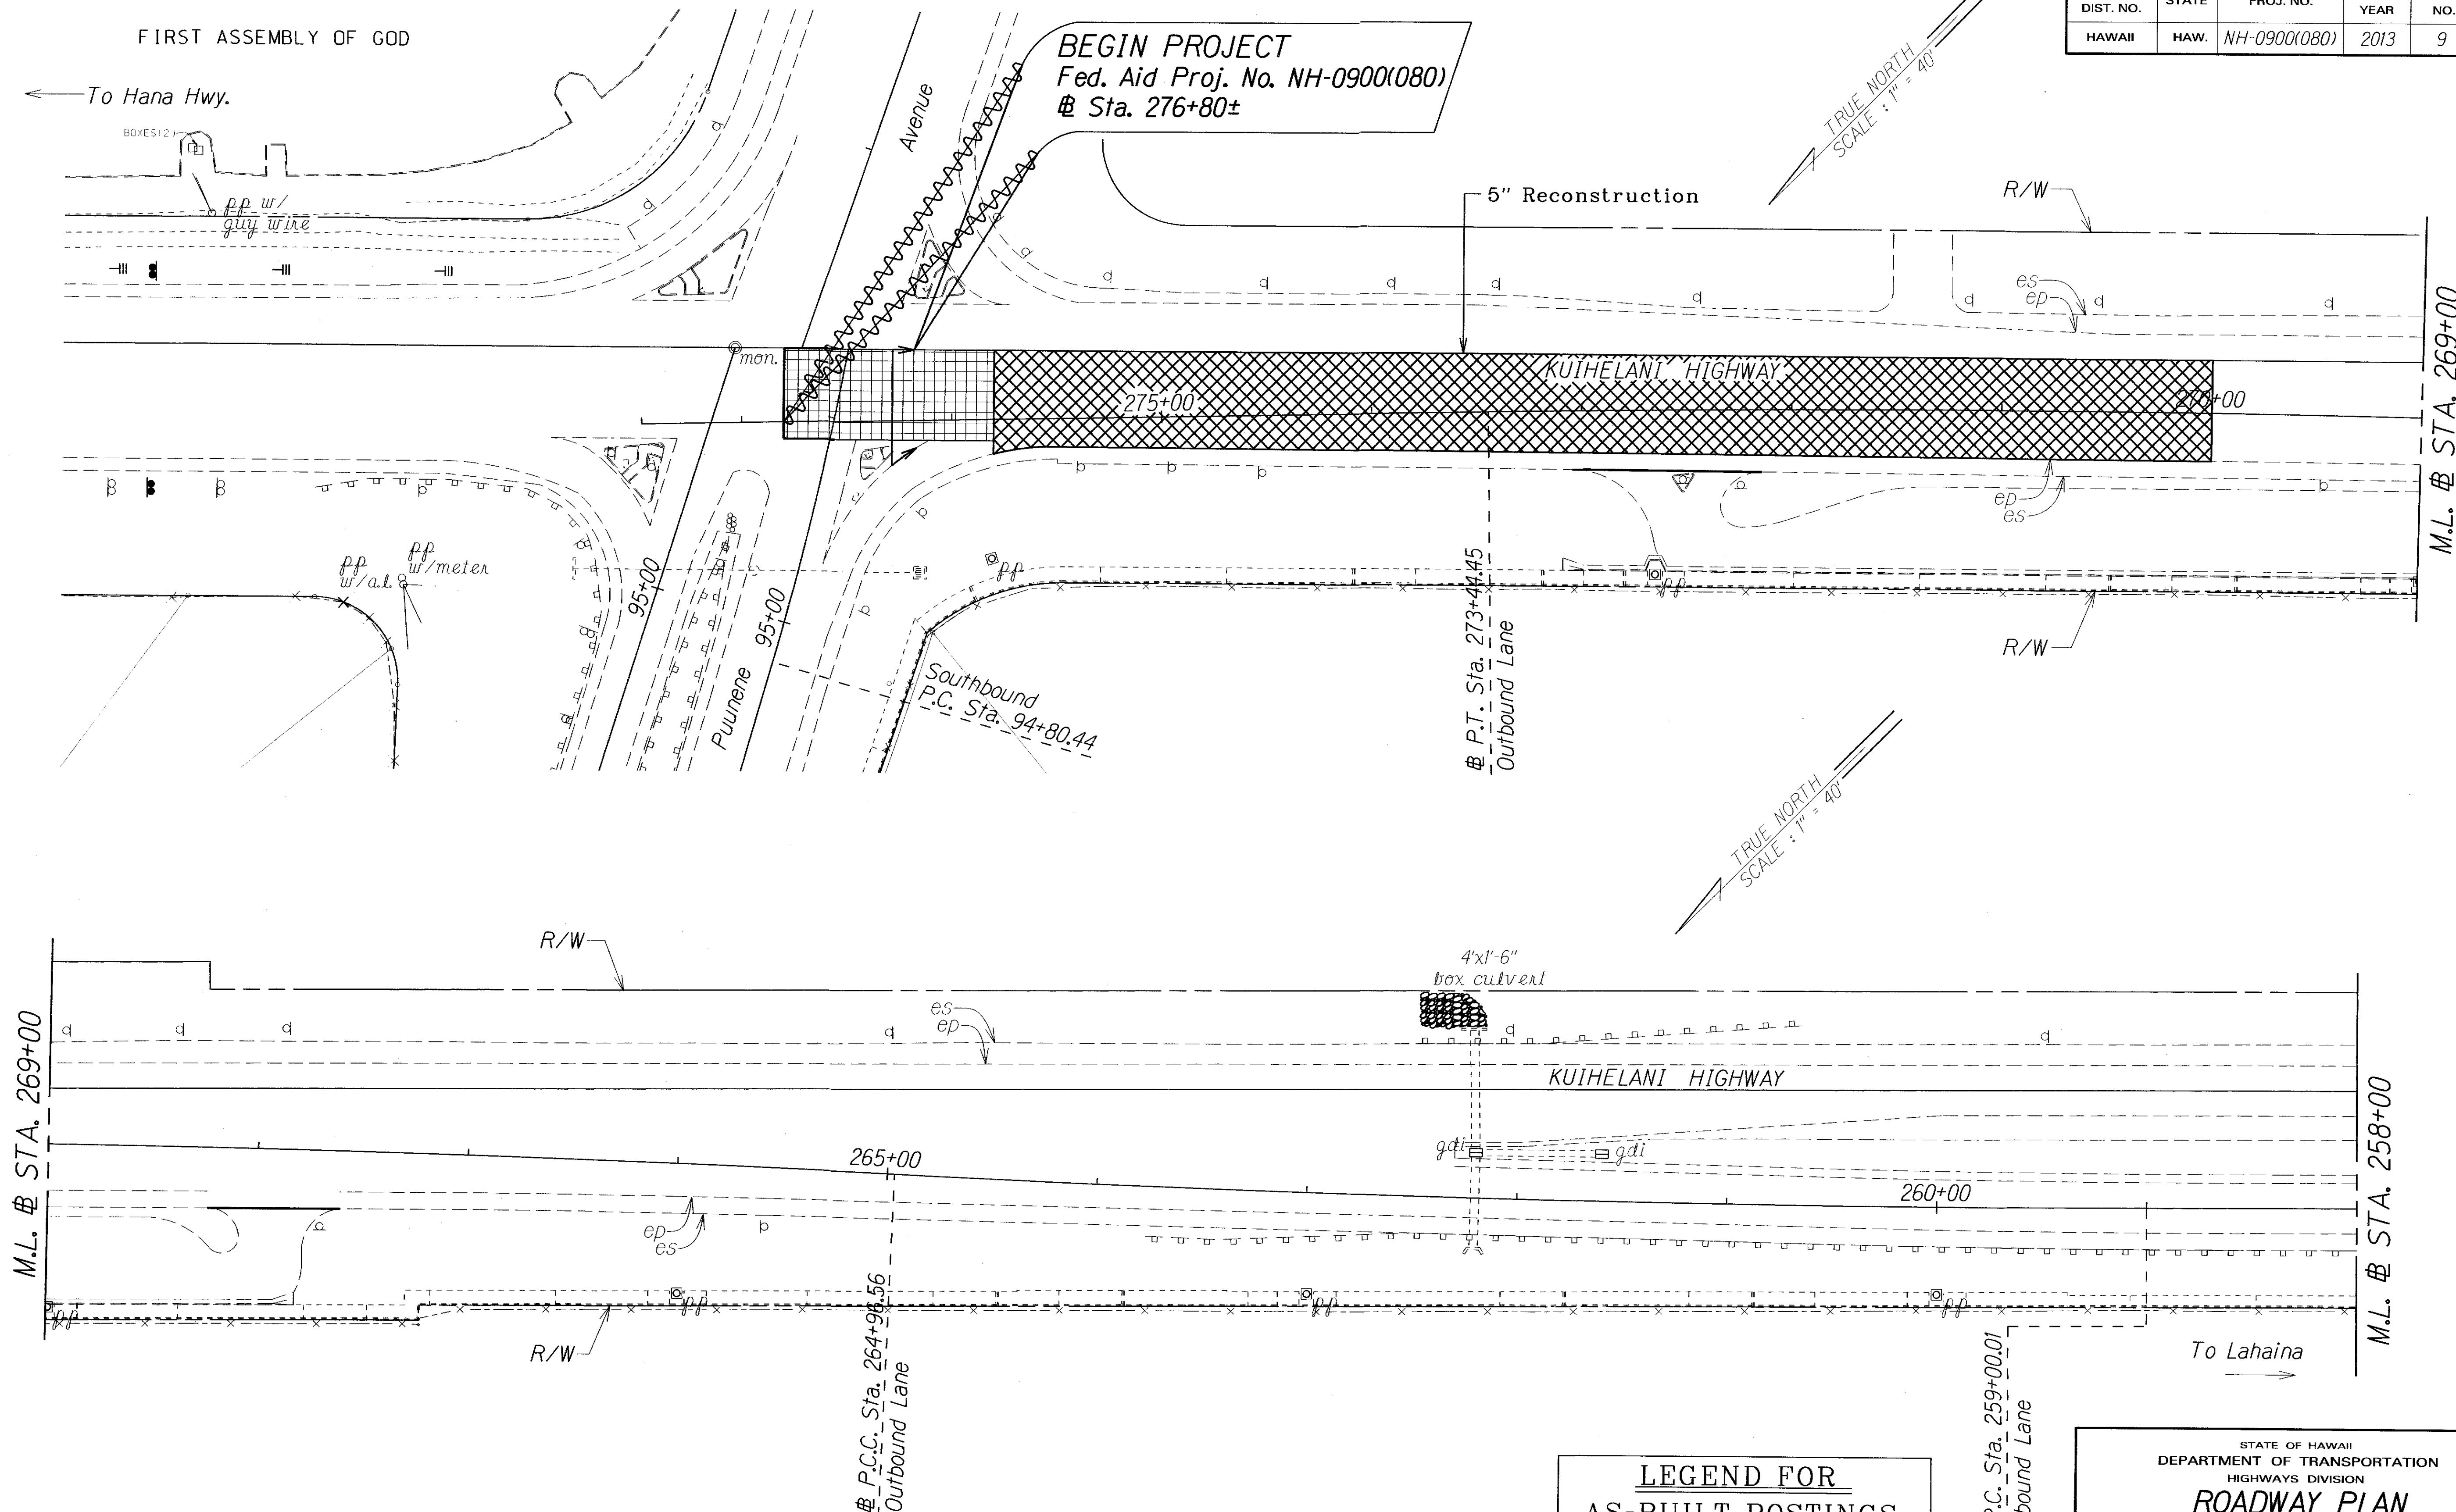

ORIGINAL PLAN	DATE 11/12
SURVEY DRAFTED BY	
DRAWN BY	
NOTE BOOK DESIGNED BY	
QUANTITIES BY	
CHECKED BY	

LEGEND FOR AS-BUILT POSTINGS	
	Squiggly line for as-built deletion
	Double line for as-built deletion
Roadway	Text for as-built posting


STATE OF HAWAII
DEPARTMENT OF TRANSPORTATION
HIGHWAYS DIVISION

ROADWAY PLAN

KUIHELANI HIGHWAY & HONOAPIILANI HIGHWAY
PAVEMENT PREVENTIVE MAINTENANCE
Puunene Avenue to Honoapiilani Highway
and Kuihelani Highway to Kapoli Street
Federal-Aid Project No. NH-0900(080)
Scale: 1" = 40' Date: May, 2012

"AS-BUILT"

FED. ROAD DIST. NO.	STATE	FED. AID PROJ. NO.	FISCAL YEAR	SHEET NO.	TOTAL SHEETS
HAWAII	HAW.	NH-0900(080)	2012	10	47

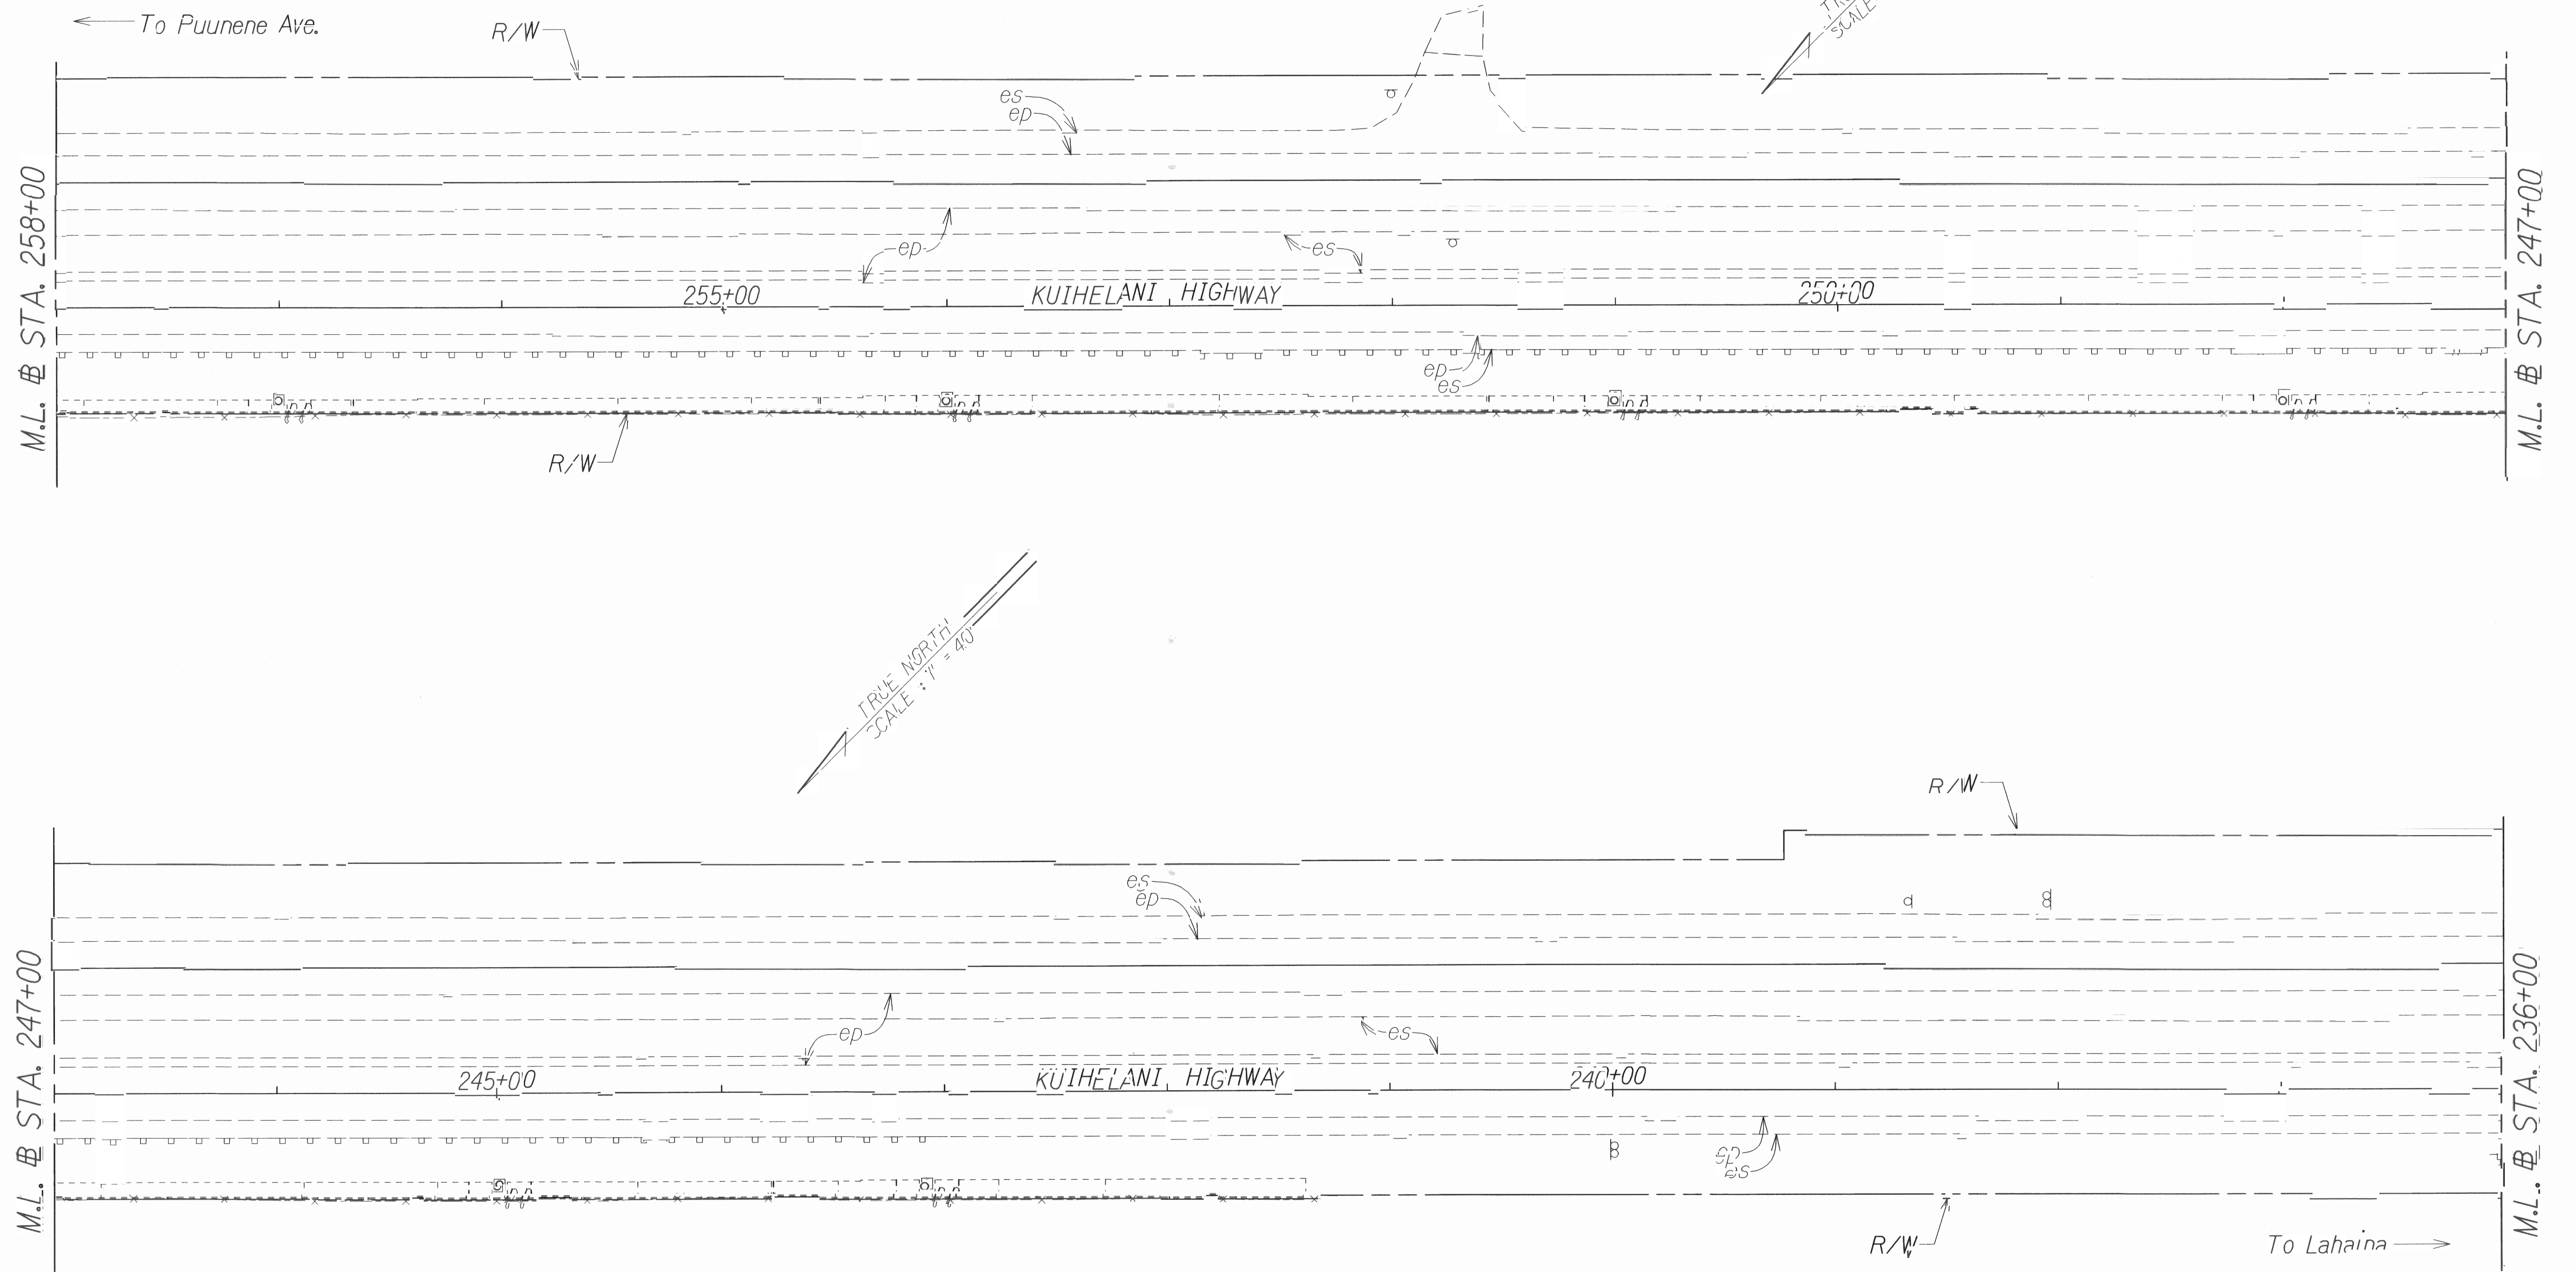

ORIGINAL PLAN	SURVEY PLOTTED BY	DATE
NOTE BOOK	DRAWN BY	7/12
me/lay	TRACED BY	
me/lay	QUANTITIES BY	
me/lay	CHECKED BY	


STATE OF HAWAII
DEPARTMENT OF TRANSPORTATION
HIGHWAYS DIVISION

ROADWAY PLAN

KUIHELANI HIGHWAY & HONOAPIILANI HIGHWAY
PAVEMENT PREVENTIVE MAINTENANCE
Puunene Avenue to Honoapiilani Highway
and Kuihelani Highway to Kapoli Street
Federal-Aid Project No. NH-0900(080)
Scale: 1" = 40' Date: May, 2012

SHEET No. 2 OF 18 SHEETS

FED. ROAD DIST. NO.	STATE	FED. AID PROJ. NO.	FISCAL YEAR	SHEET NO.	TOTAL SHEETS
HAWAII	HAW.	NH-0900(080)	2013	11	47

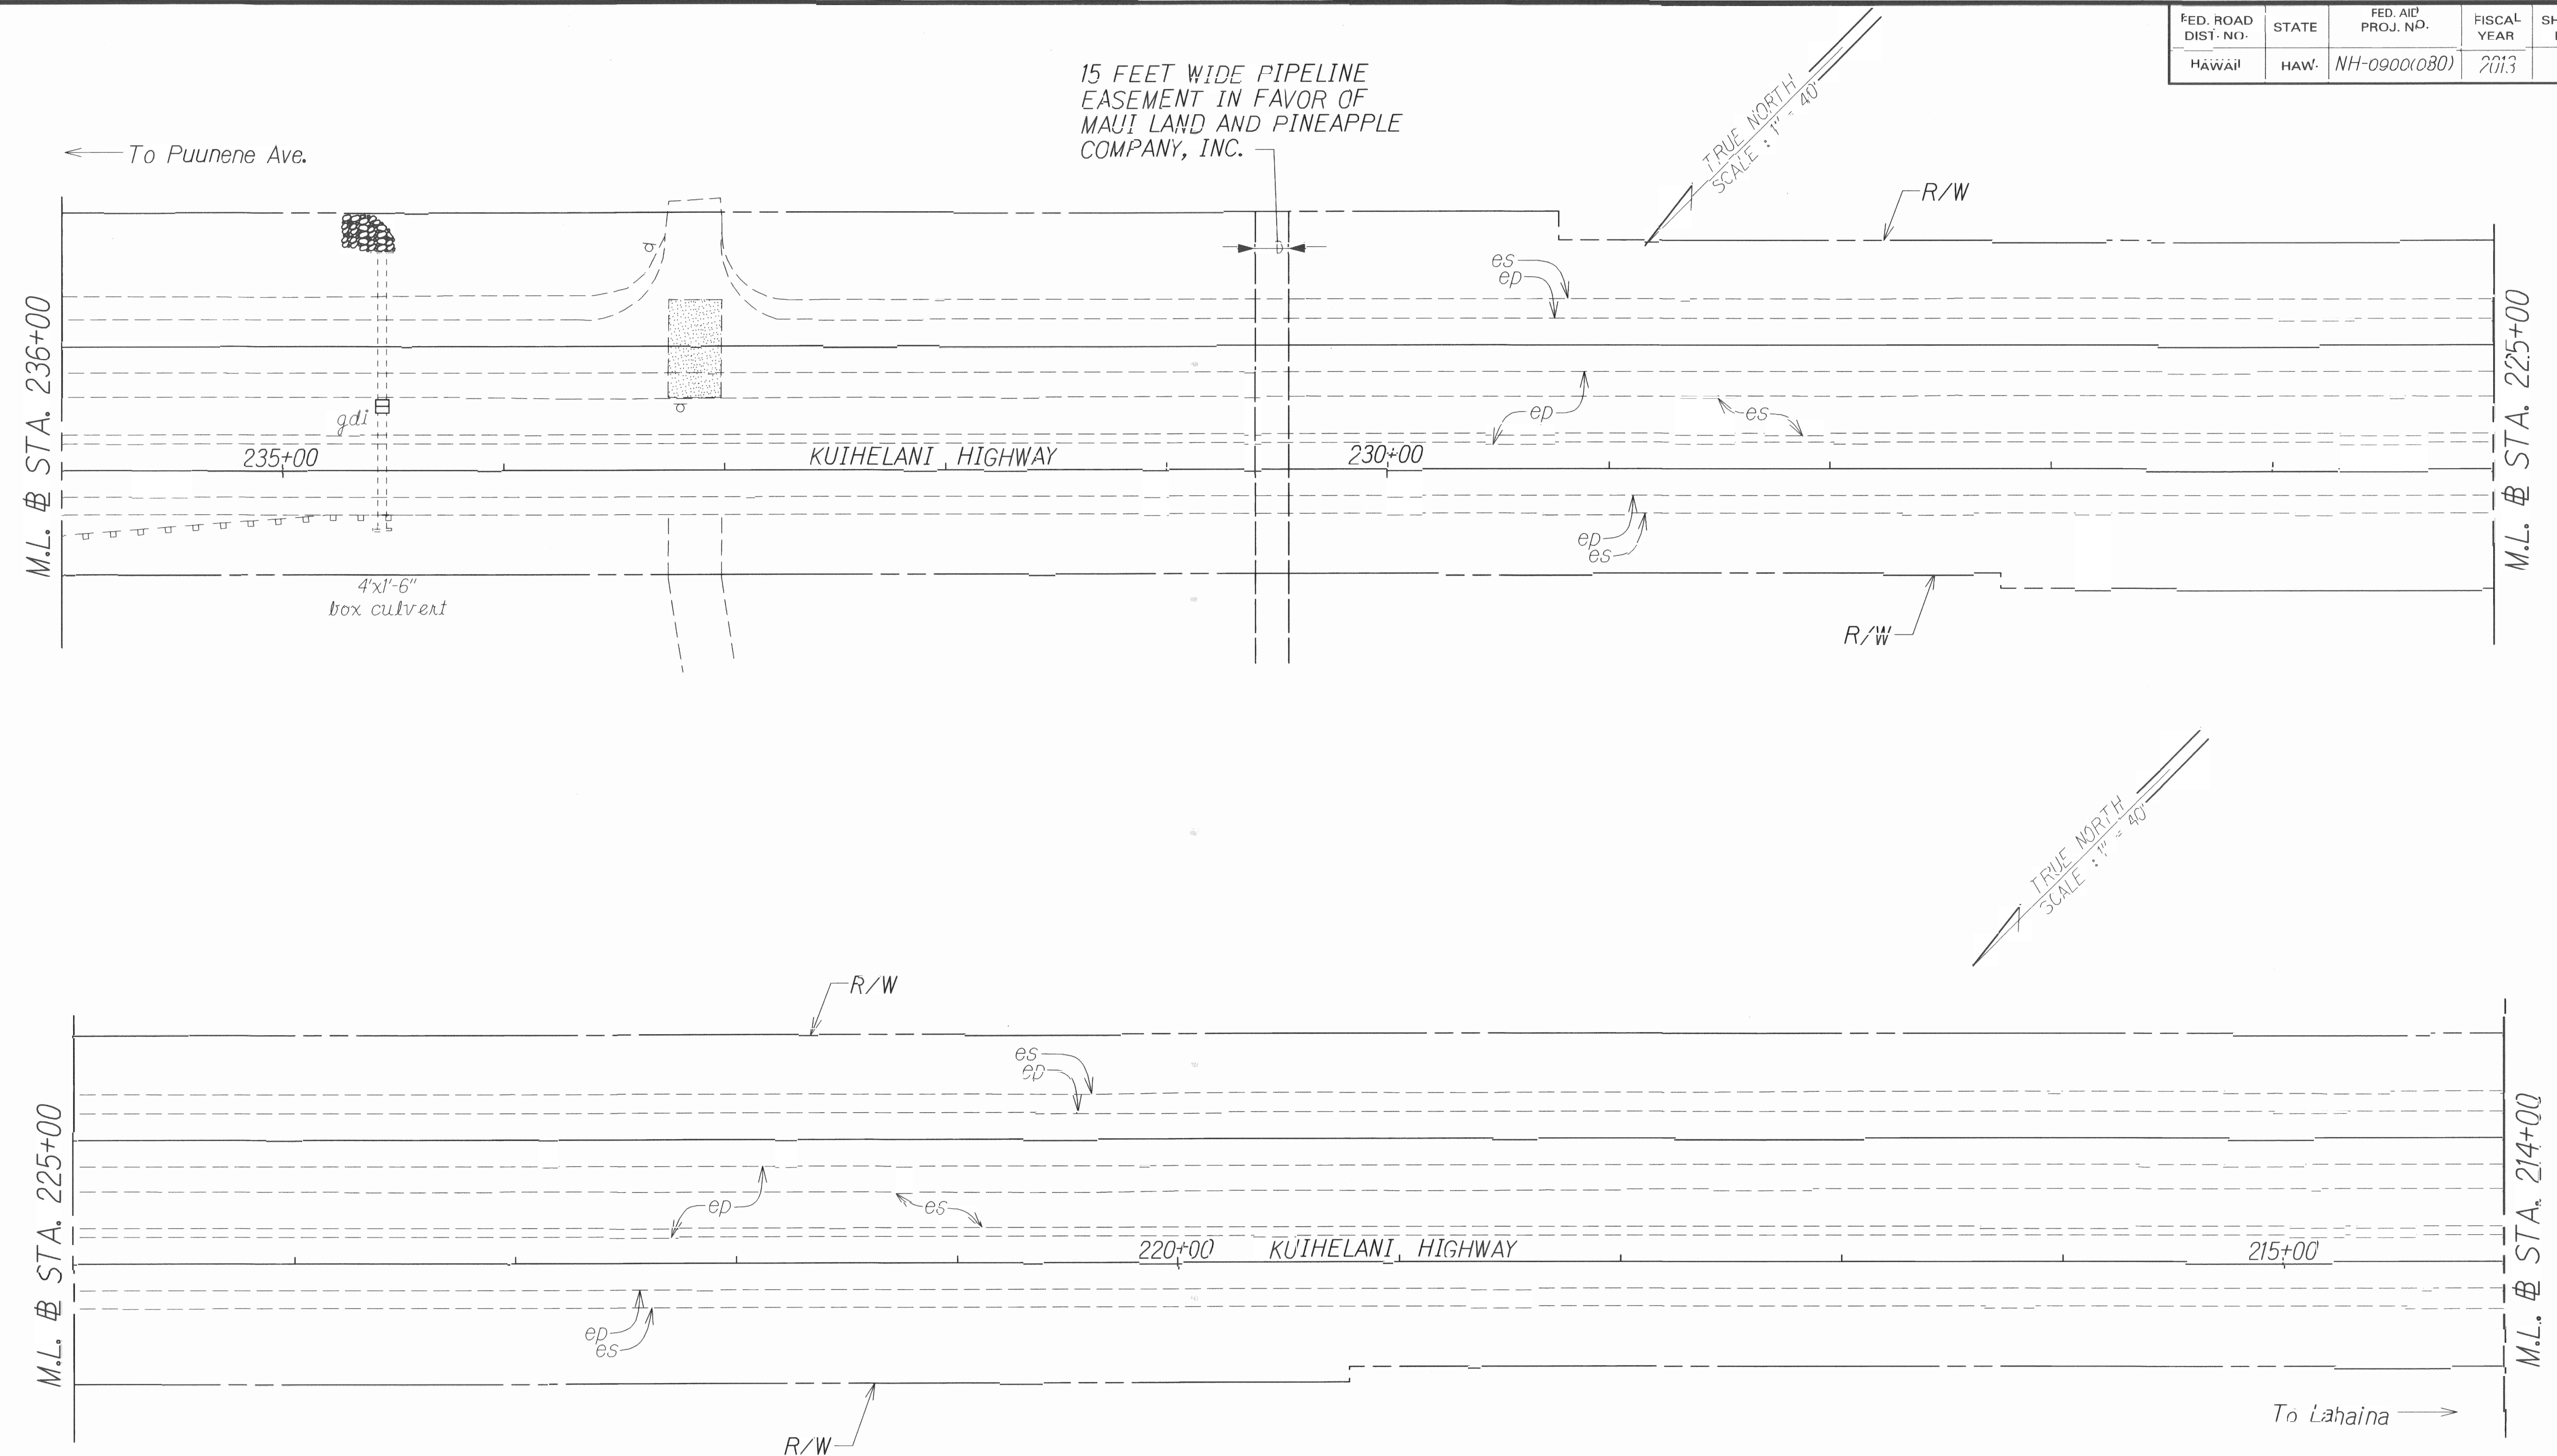

ORIGINAL PLAN	DATE
NOTE BOOK	1/12
DESIGNED BY	
QUANTITIES BY	
CHECKED BY	



STATE OF HAWAII
DEPARTMENT OF TRANSPORTATION
HIGHWAYS DIVISION

ROADWAY PLAN

KUIHELANI HIGHWAY & HONOAPIILANI HIGHWAY
PAVEMENT PREVENTIVE MAINTENANCE
Puunene Avenue to Honoapiilani Highway
and Kuihelani Highway to Kapoli Street
Federal-Aid Project No. NH-0900(080)
Scale: 1" = 40' Date: May, 2012

SHEET No. 3 OF 18 SHEETS

FED. ROAD DIST. NO.	STATE	FED. AID PROJ. NO.	FISCAL YEAR	SHEET NO.	TOTAL SHEETS
HAWAII	HAW.	NH-0900(080)	2013	12	47

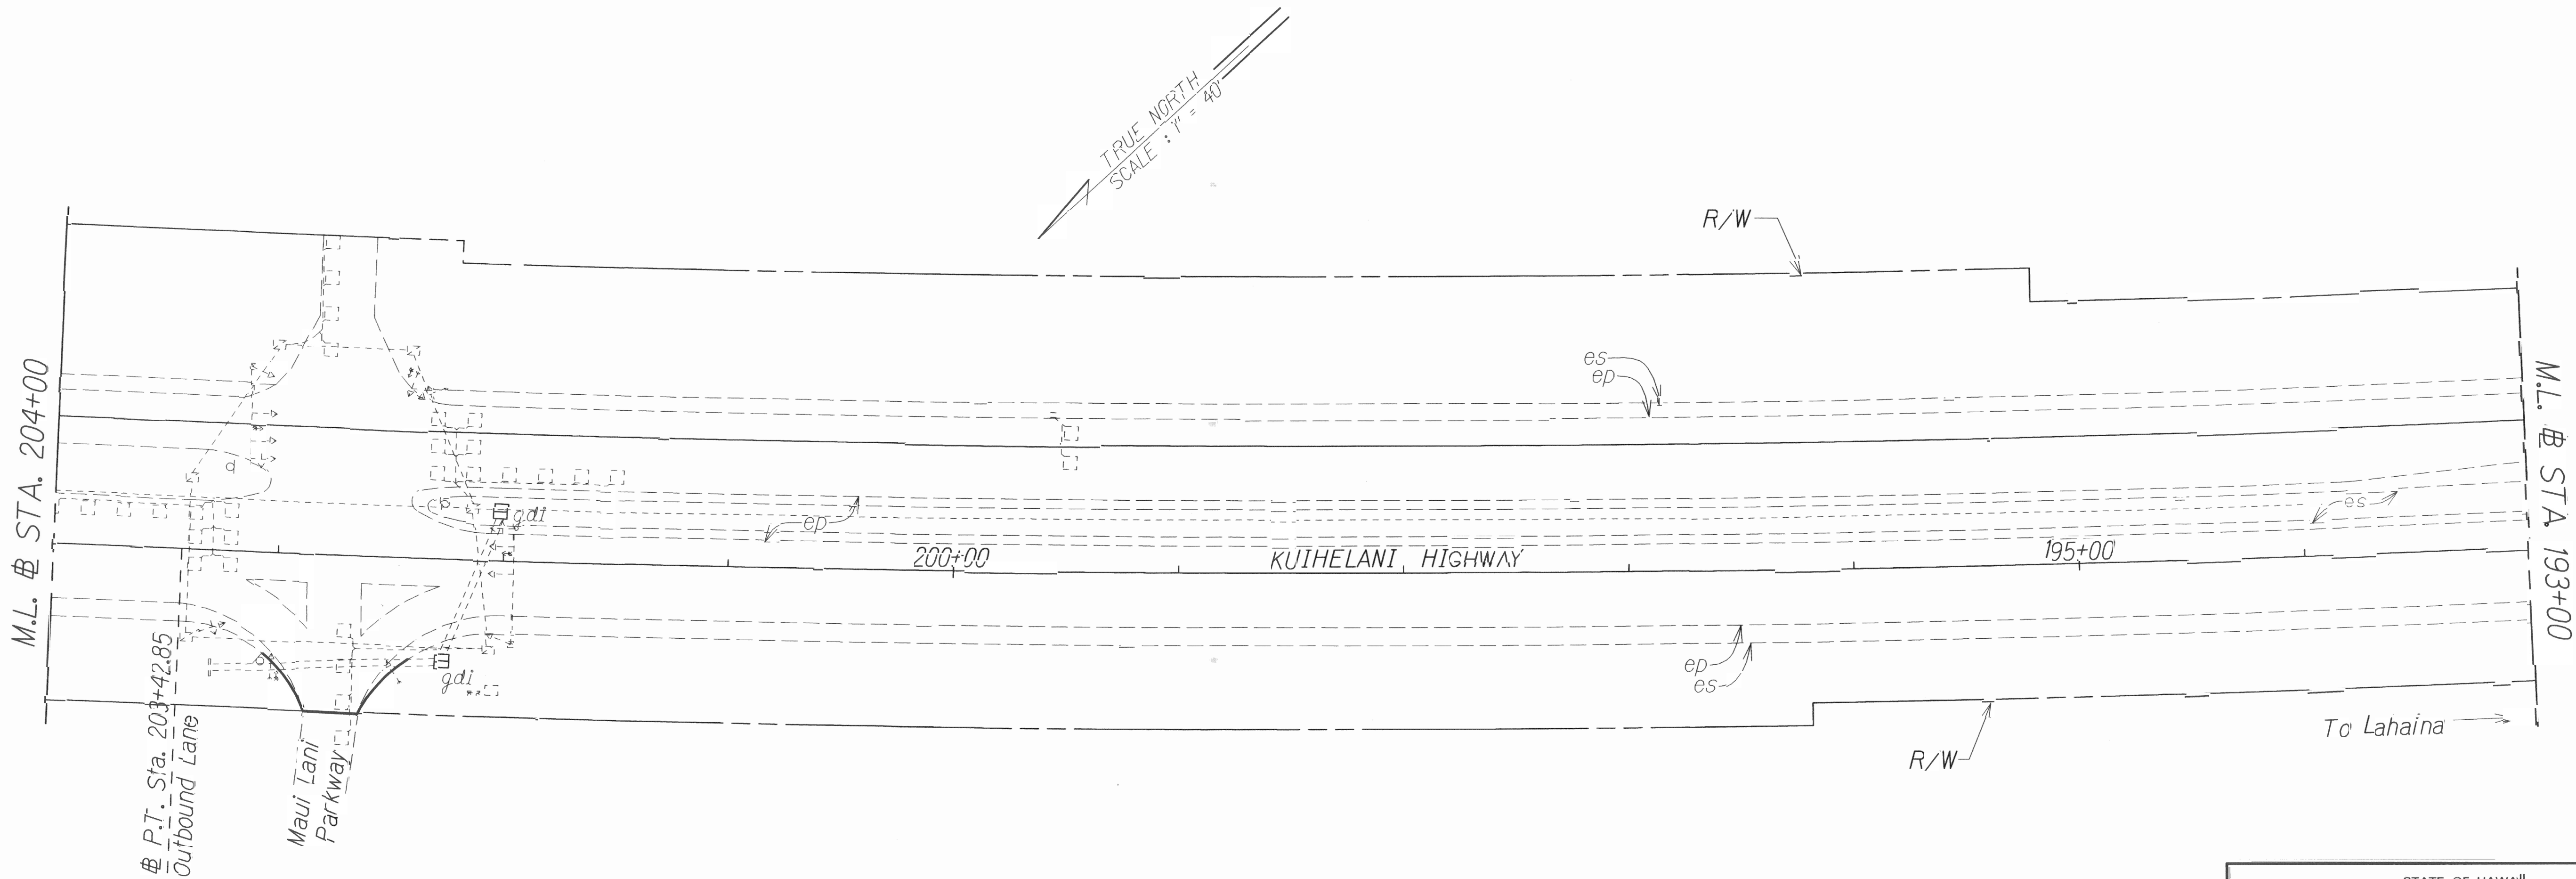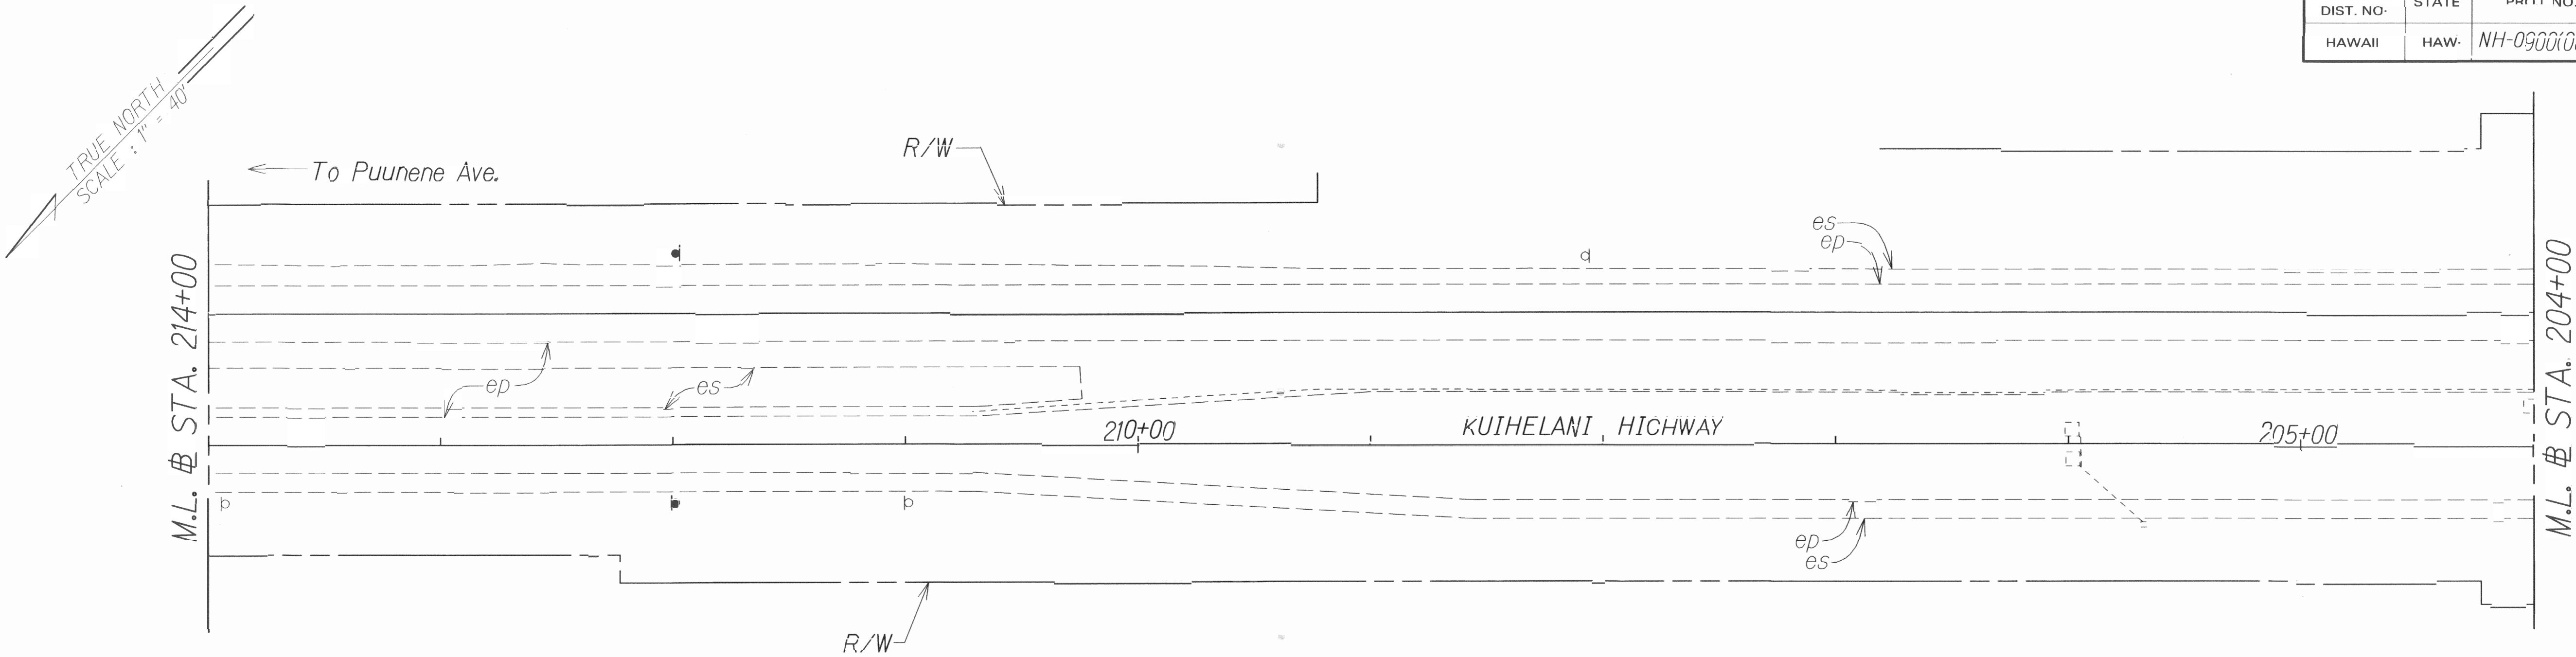


ORIGINAL PLAN	DATE
NOTED BY	2/12
DESIGNED BY	
QUANTITIES BY	
CHECKED BY	

STATE OF HAWAII
DEPARTMENT OF TRANSPORTATION
HIGHWAYS DIVISION

ROADWAY PLAN
KUIHELANI HIGHWAY & HONOAPIILANI HIGHWAY
PAVEMENT PREVENTIVE MAINTENANCE
Puunene Avenue to Honoapiilani Highway
and Kuihelani Highway to Kapoli Street
Federal-Aid Project No. NH-0900(080)
Scale: 1" = 40'

Date: May, 2012

FED. ROAD DIST. NO.	STATE	FED. AID PROJ. NO.	FISCAL YEAR	SHEET NO.	TOTAL SHEETS
HAWAII	HAW.	NH-0900(080)	2013	13	47

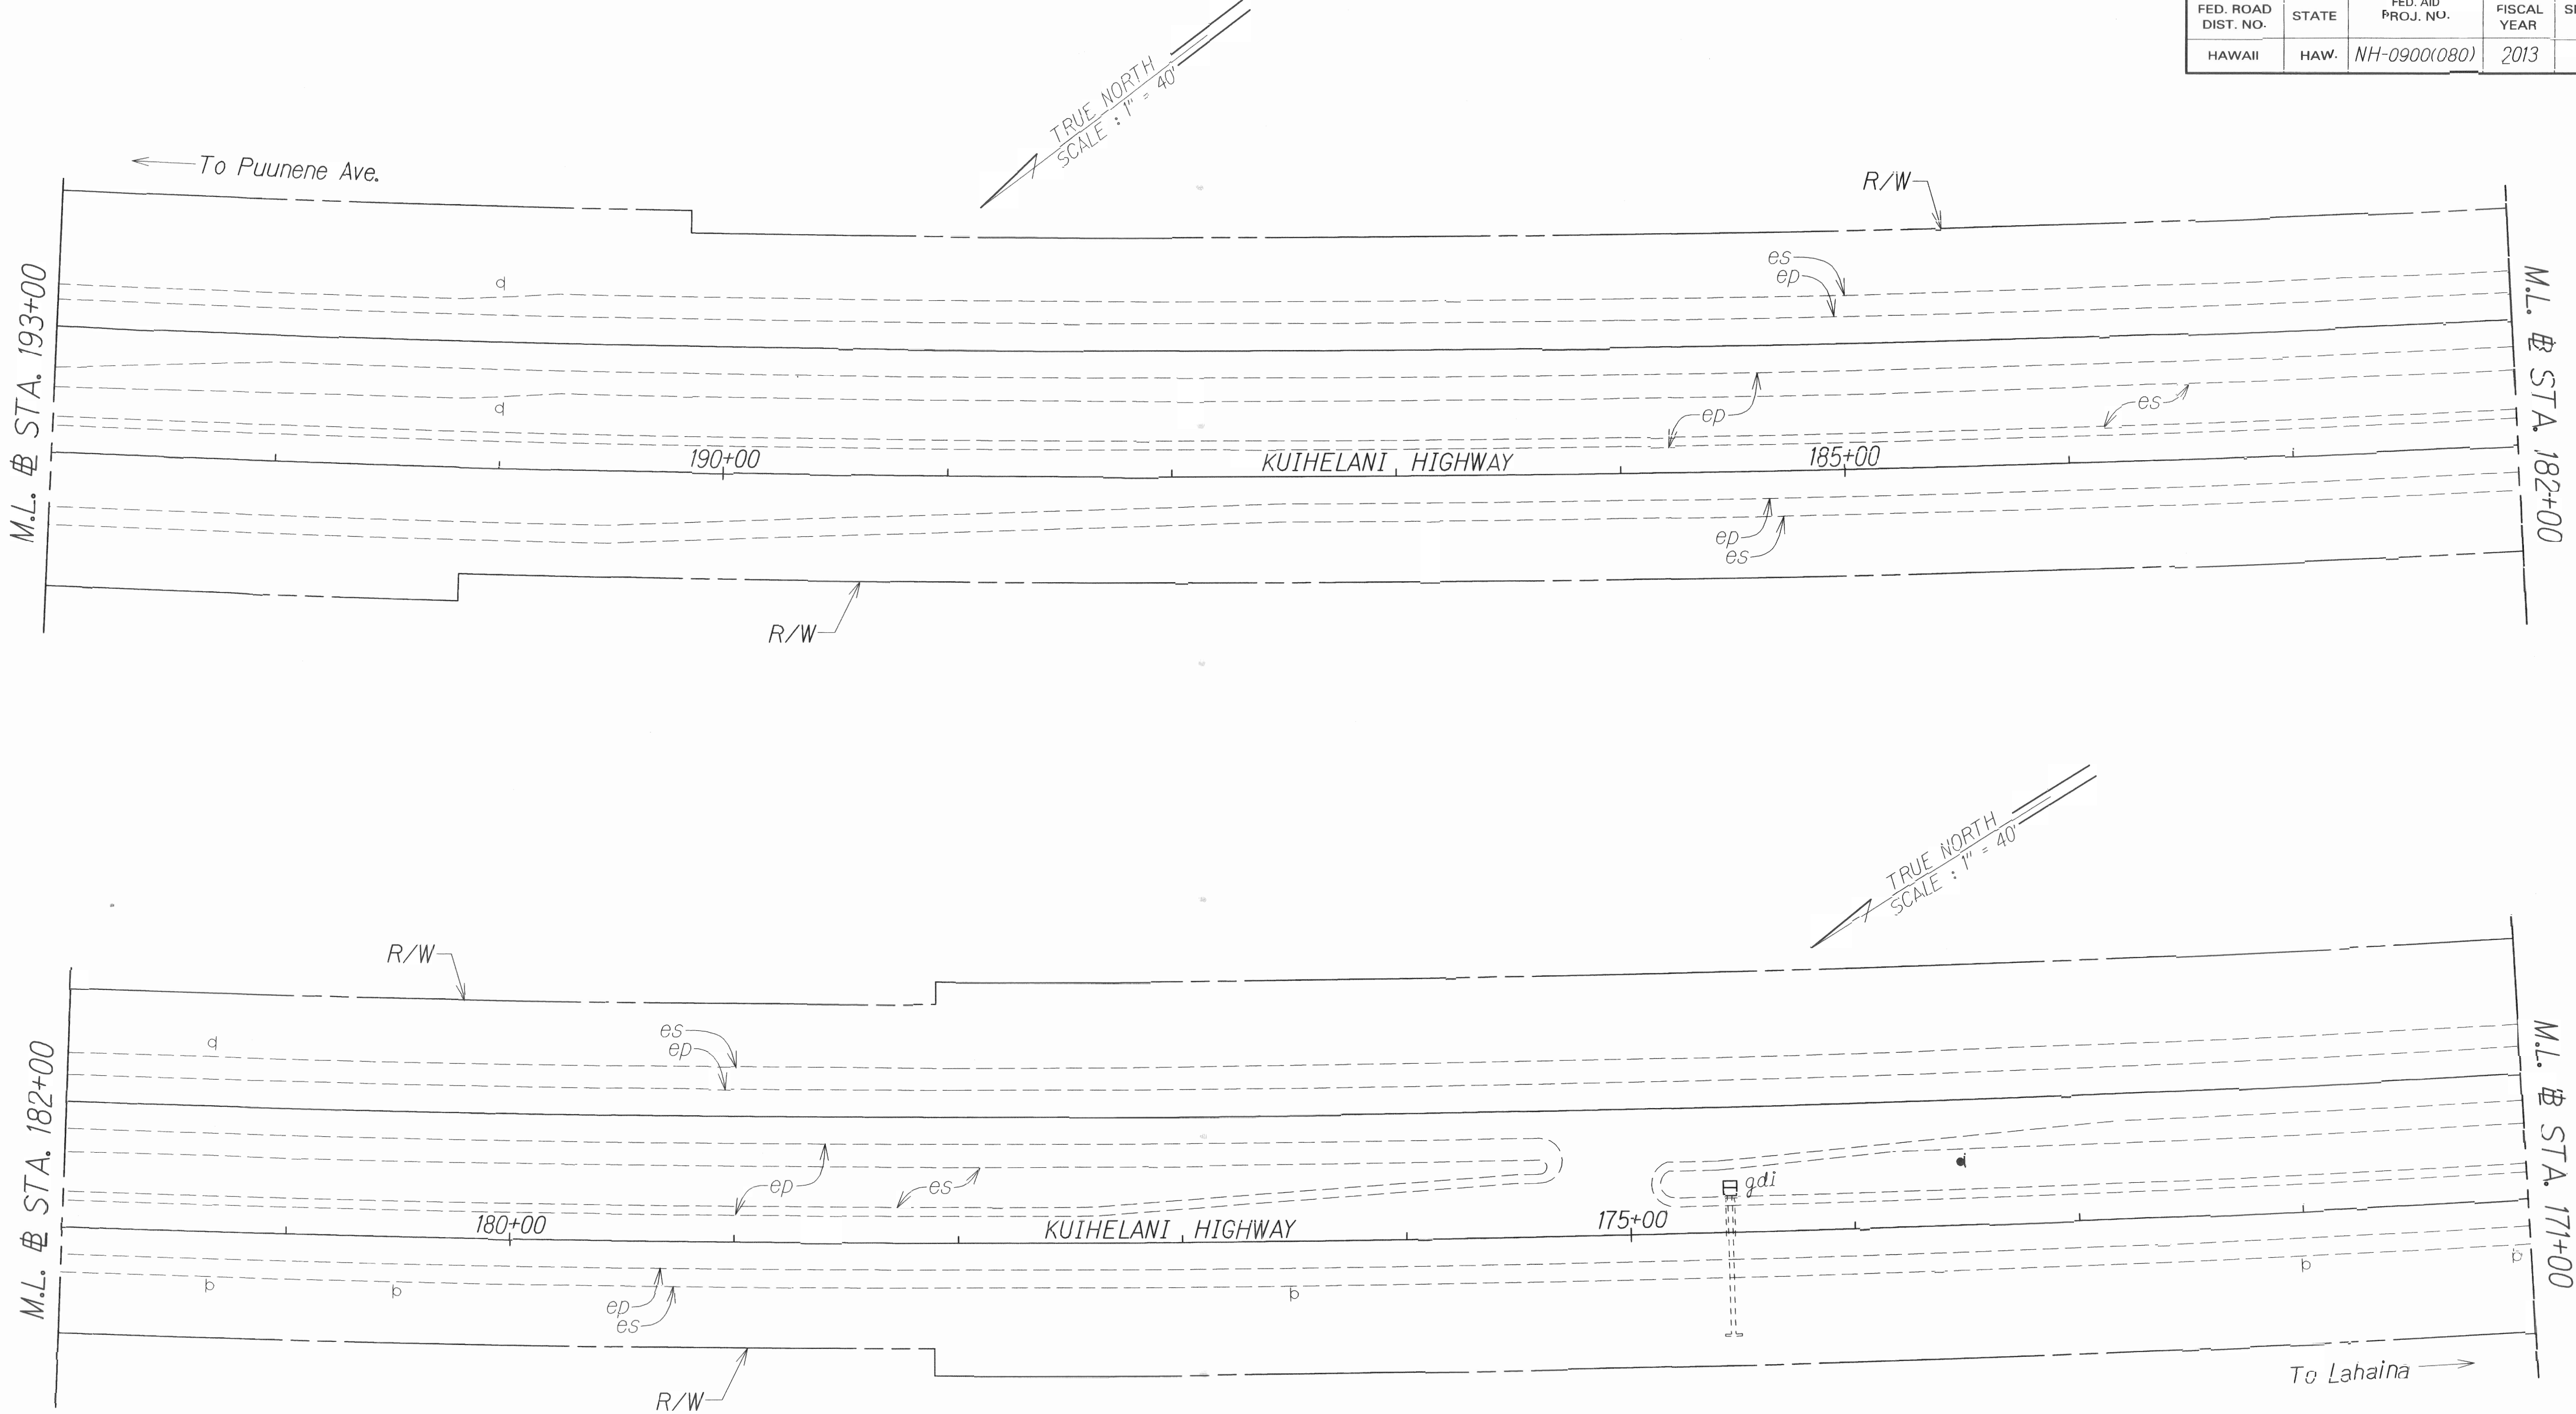


ORIGINAL PLAN	SURVEY PLOTTED BY	DATE
NOTE BOOK	DRAWN BY	1/12
DESIGNED BY	DESIGNED BY	
CHECKED BY	CHECKED BY	

STATE OF HAWAII
DEPARTMENT OF TRANSPORTATION
HIGHWAYS DIVISION

ROADWAY PLAN

KUIHELANI HIGHWAY & HONOAPIILANI HIGHWAY
PAVEMENT PREVENTIVE MAINTENANCE
Puunene Avenue to Honoapiilani Highway
and Kuihelani Highway to Kapoli Street
Federal-Aid Project No. NH-0900(080)
Scale: 1" = 40' Date: May, 2012

FED. ROAD DIST. NO.	STATE	FED. AID PROJ. NO.	FISCAL YEAR	SHEET NO.	TOTAL SHEETS
HAWAII	HAW.	NH-na00(080)	2013	14	47

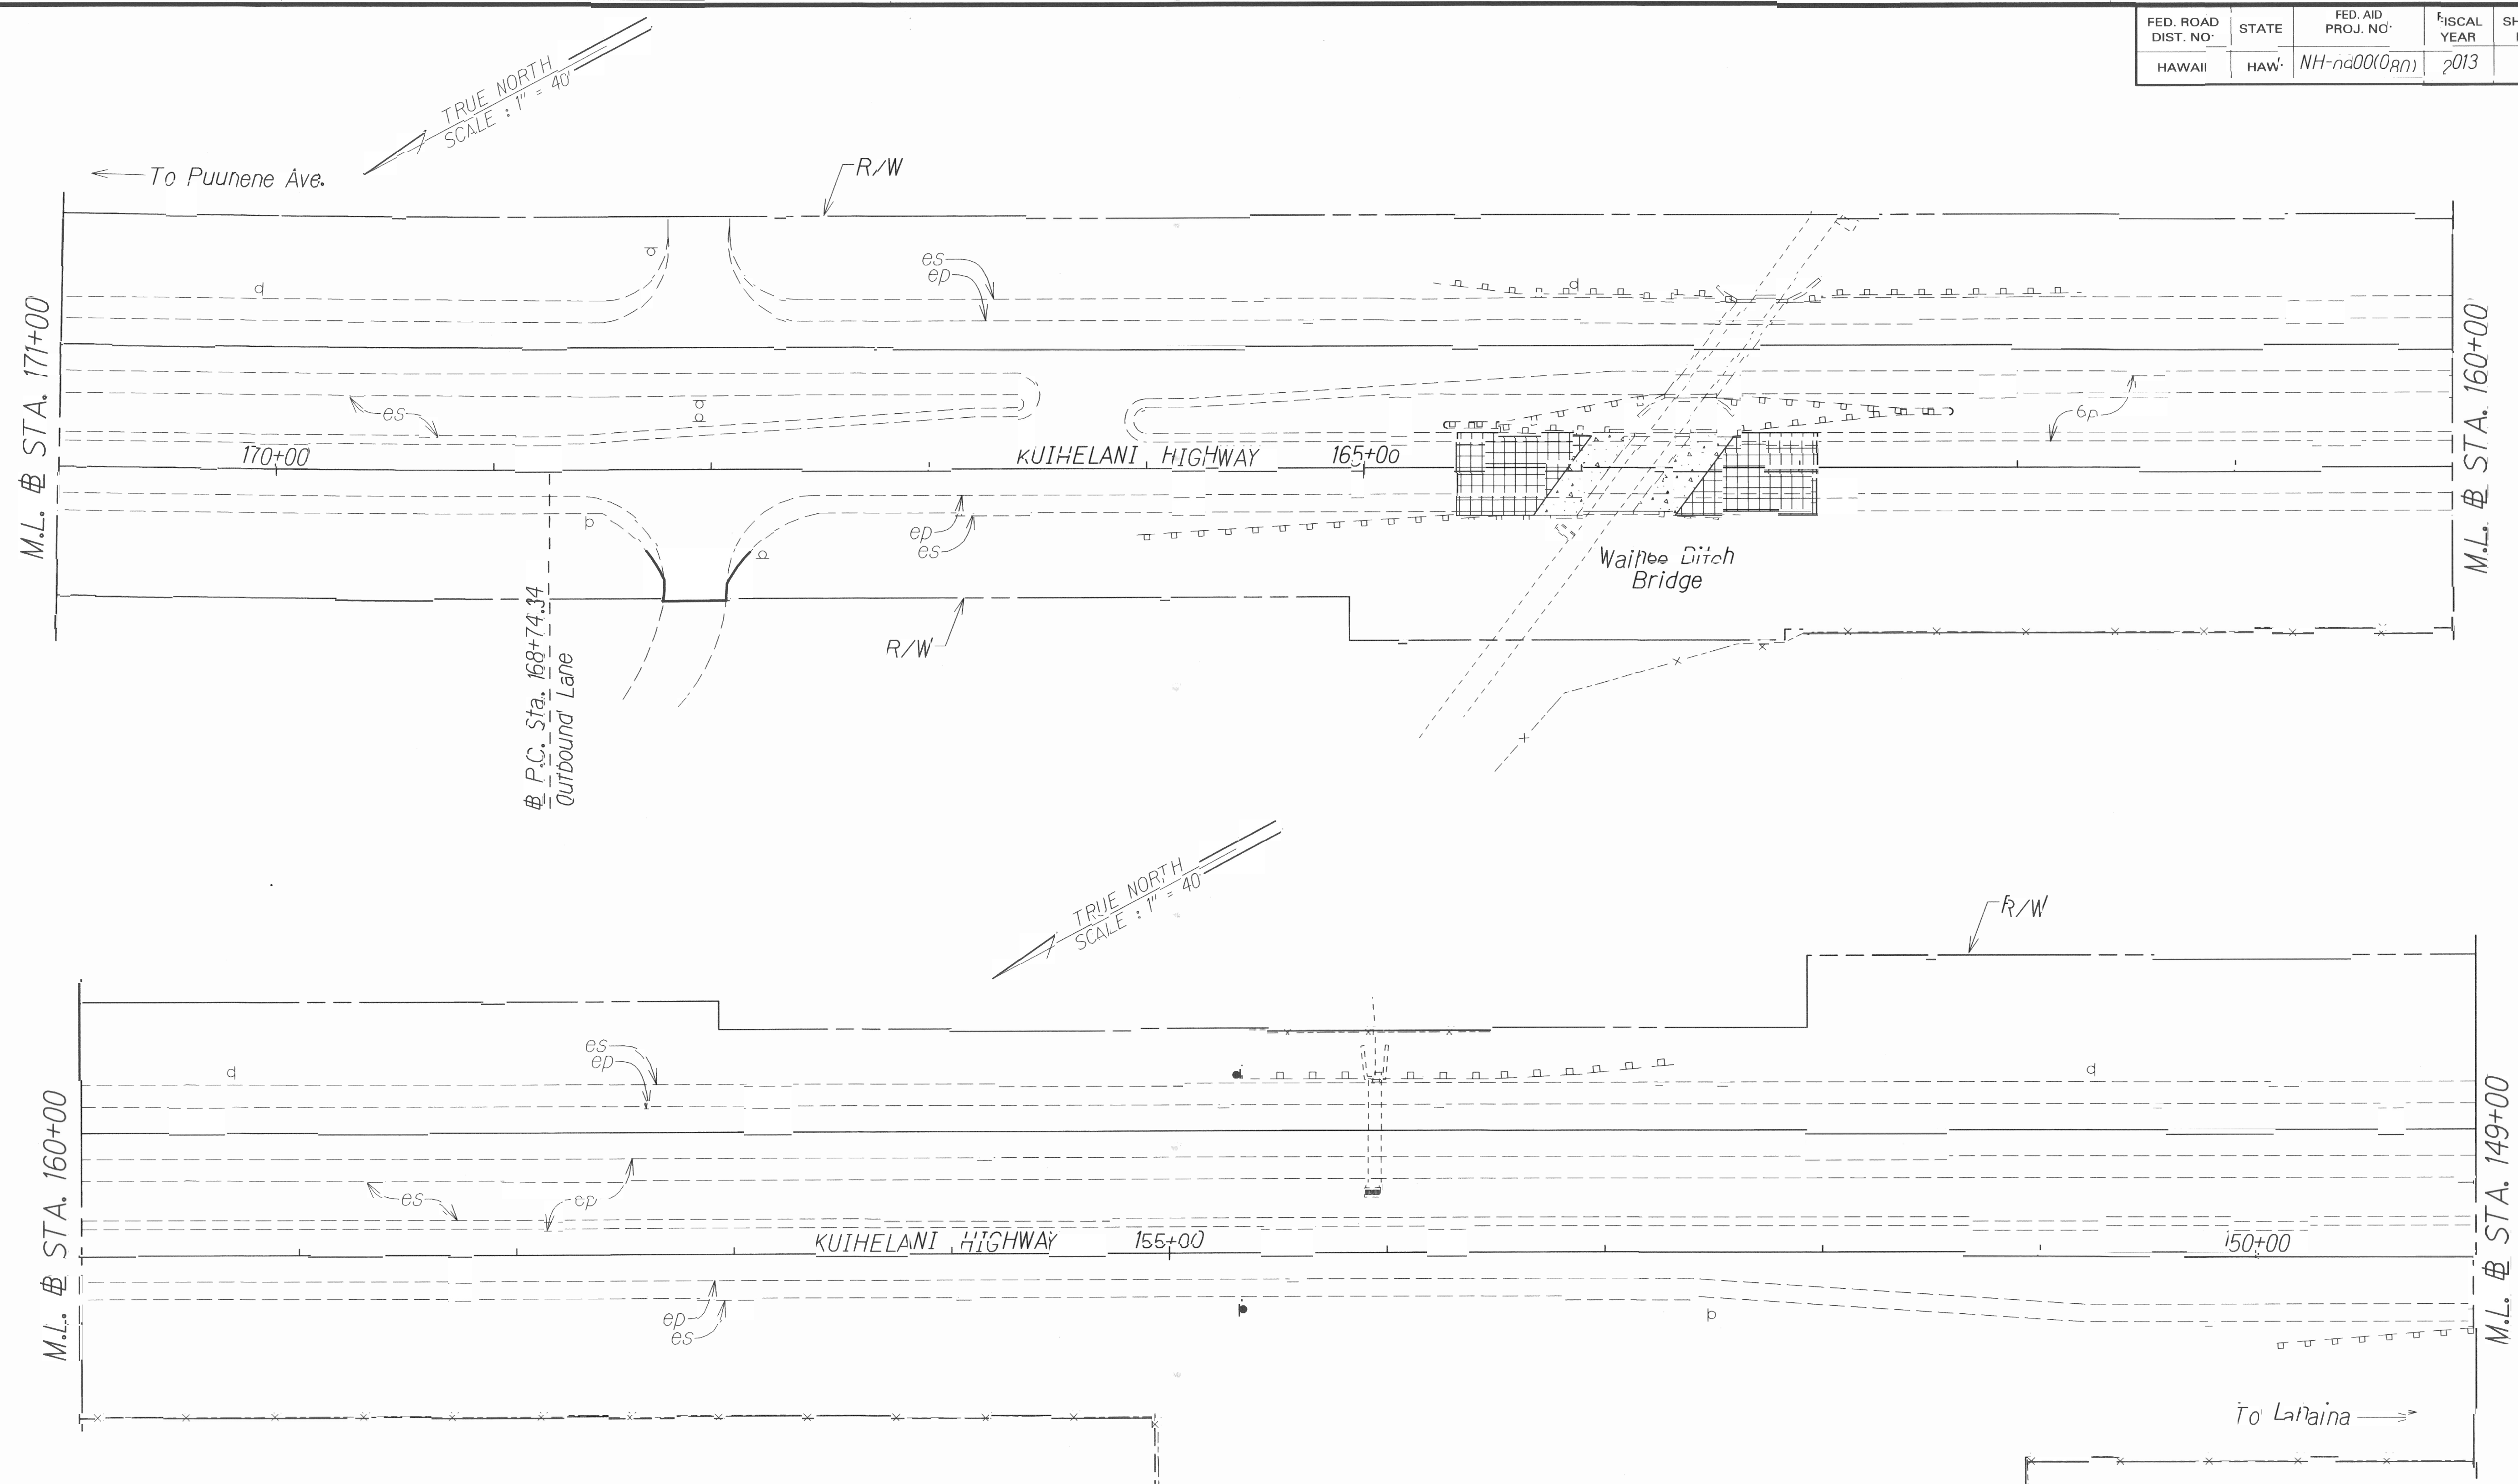

ORIGINAL PLAN	DATE
NOTED BY	7/12
DESIGNED BY	
QUANTITIES BY	
CHECKED BY	



STATE OF HAWAII
DEPARTMENT OF TRANSPORTATION
HIGHWAYS DIVISION

ROADWAY PLAN

KUIHELANI HIGHWAY & HONOAPIILANI HIGHWAY
PAVEMENT PREVENTIVE MAINTENANCE
Puunene Avenue to Honoapiilani Highway
and Kuihelani Highway to Kapoli Street
Federal-Aid Project No. NH-0900(080)

Scale: 1" = 40' Date: May, 2012

FED. ROAD DIST. NO.	STATE	FED. AID PROJ. NO.	FISCAL YEAR	SHEET NO.	TOTAL SHEETS
HAWAII	HAW.	NH-0900(080)	2013	15	47

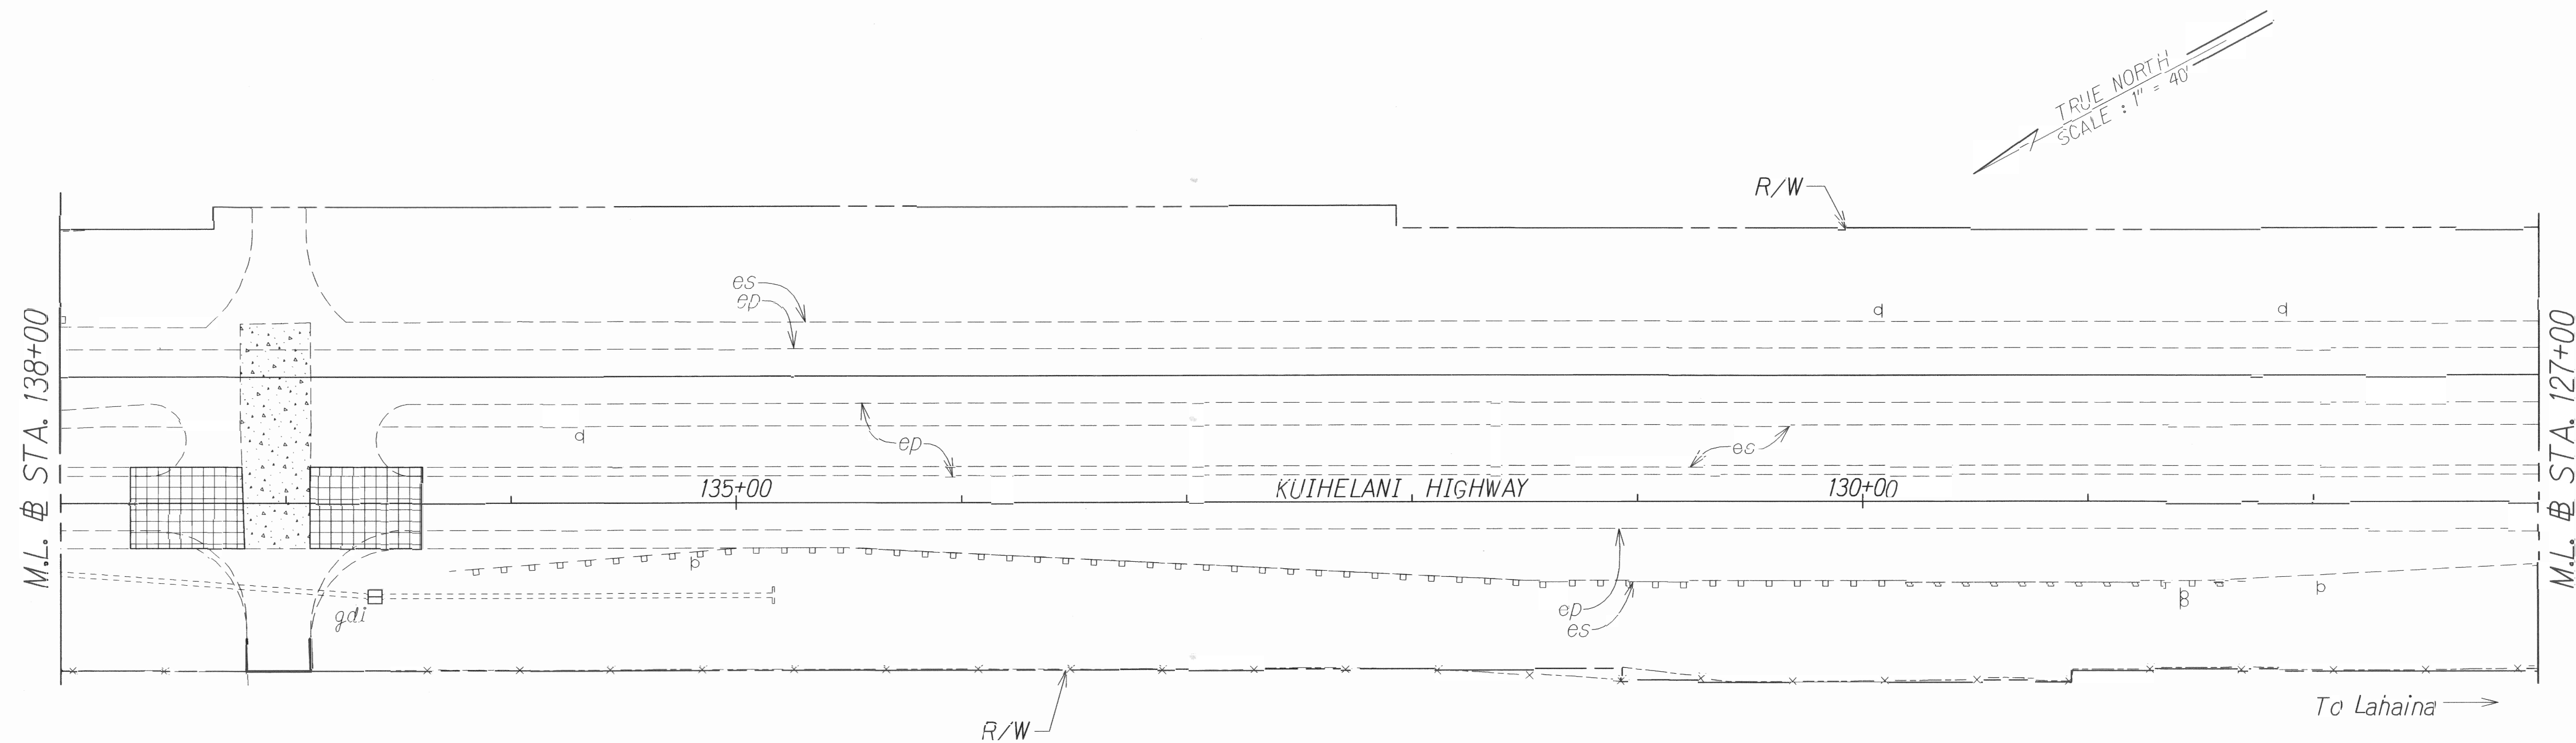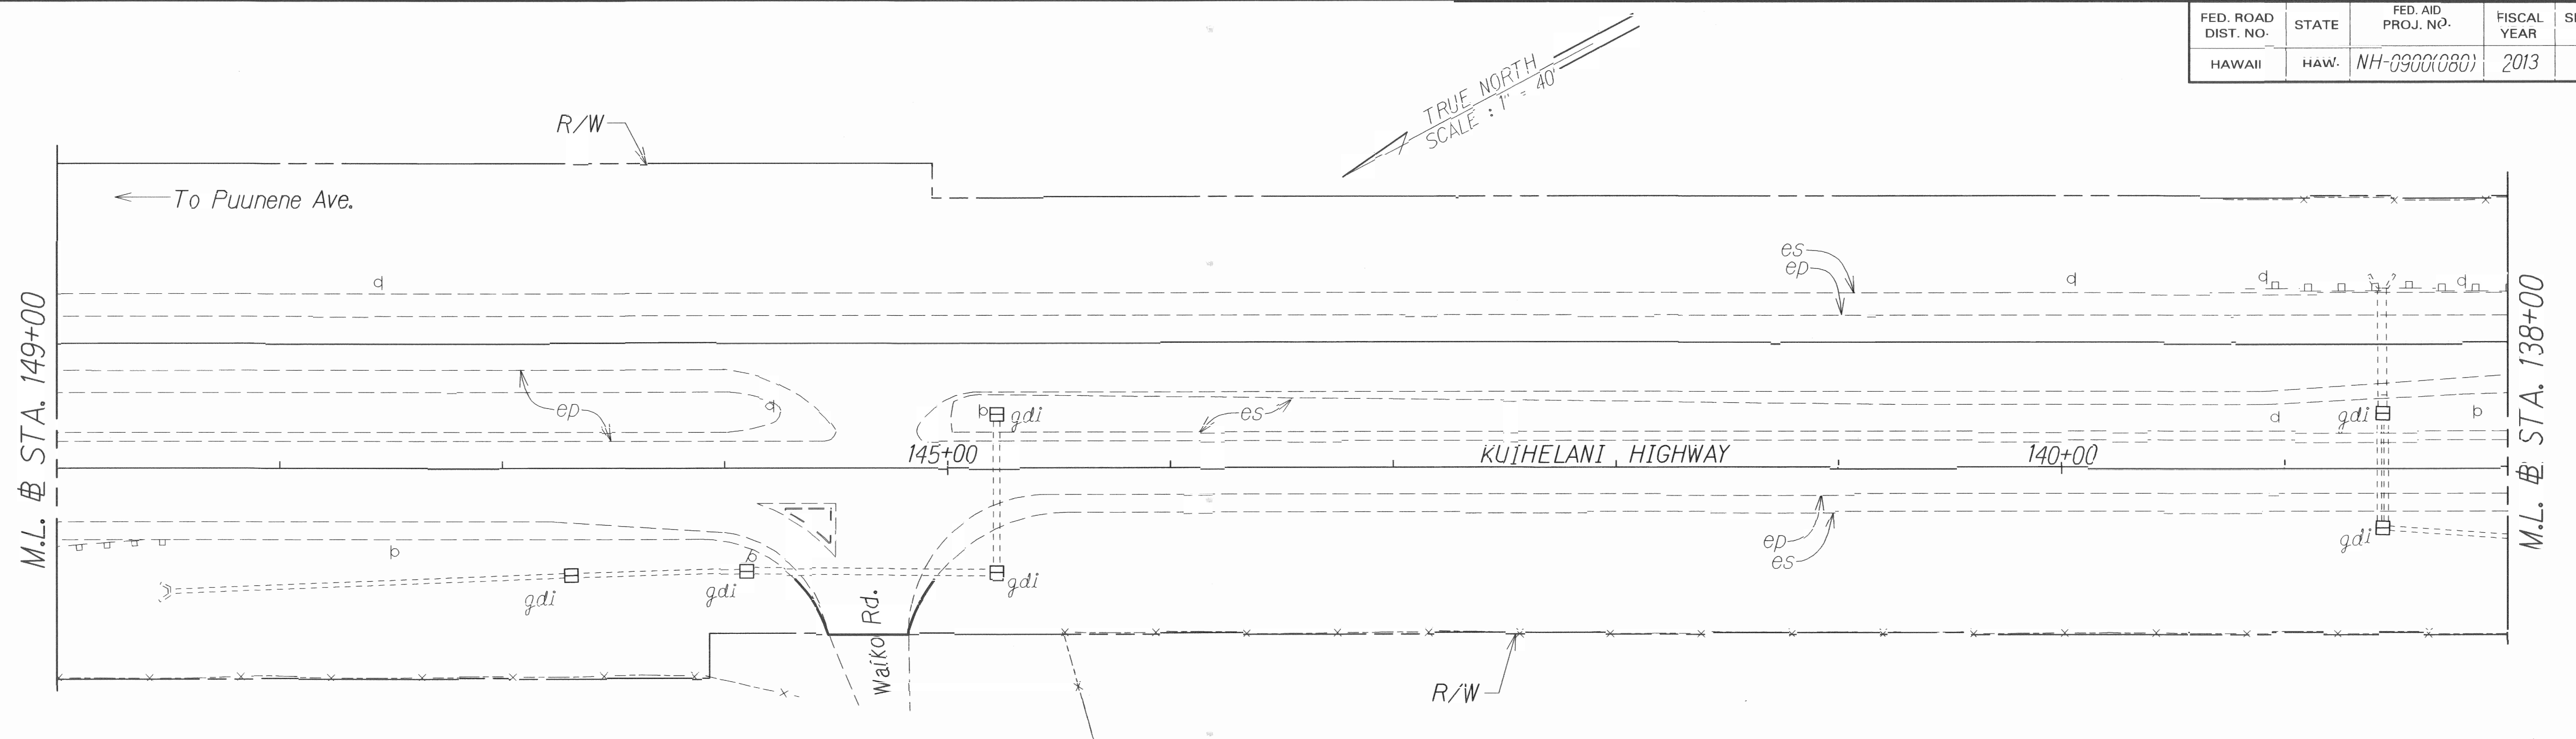


ORIGINAL PLAN	DATE	1/12
SURVEY DRAWN BY		
DESIGNED BY		
QUANTITIES BY		
CHECKED BY		

STATE OF HAWAII
DEPARTMENT OF TRANSPORTATION
HIGHWAYS DIVISION

ROADWAY PLAN

KUIHELANI HIGHWAY & HONOAPIʻILANI HIGHWAY
PAVEMENT PREVENTIVE MAINTENANCE
Puunene Avenue to Honoapiʻilani Highway
and Kuihelani Highway to Kapoli Street
Federal-Aid Project No. NH-0900(080)
Scale: 1" = 40' Date: May, 2012


FED. ROAD DIST. NO.	STATE	FED. AID PROJ. NO.	FISCAL YEAR	SHEET NO.	TOTAL SHEETS
HAWAII	HAW.	NH-0900(080)	2013	16	17

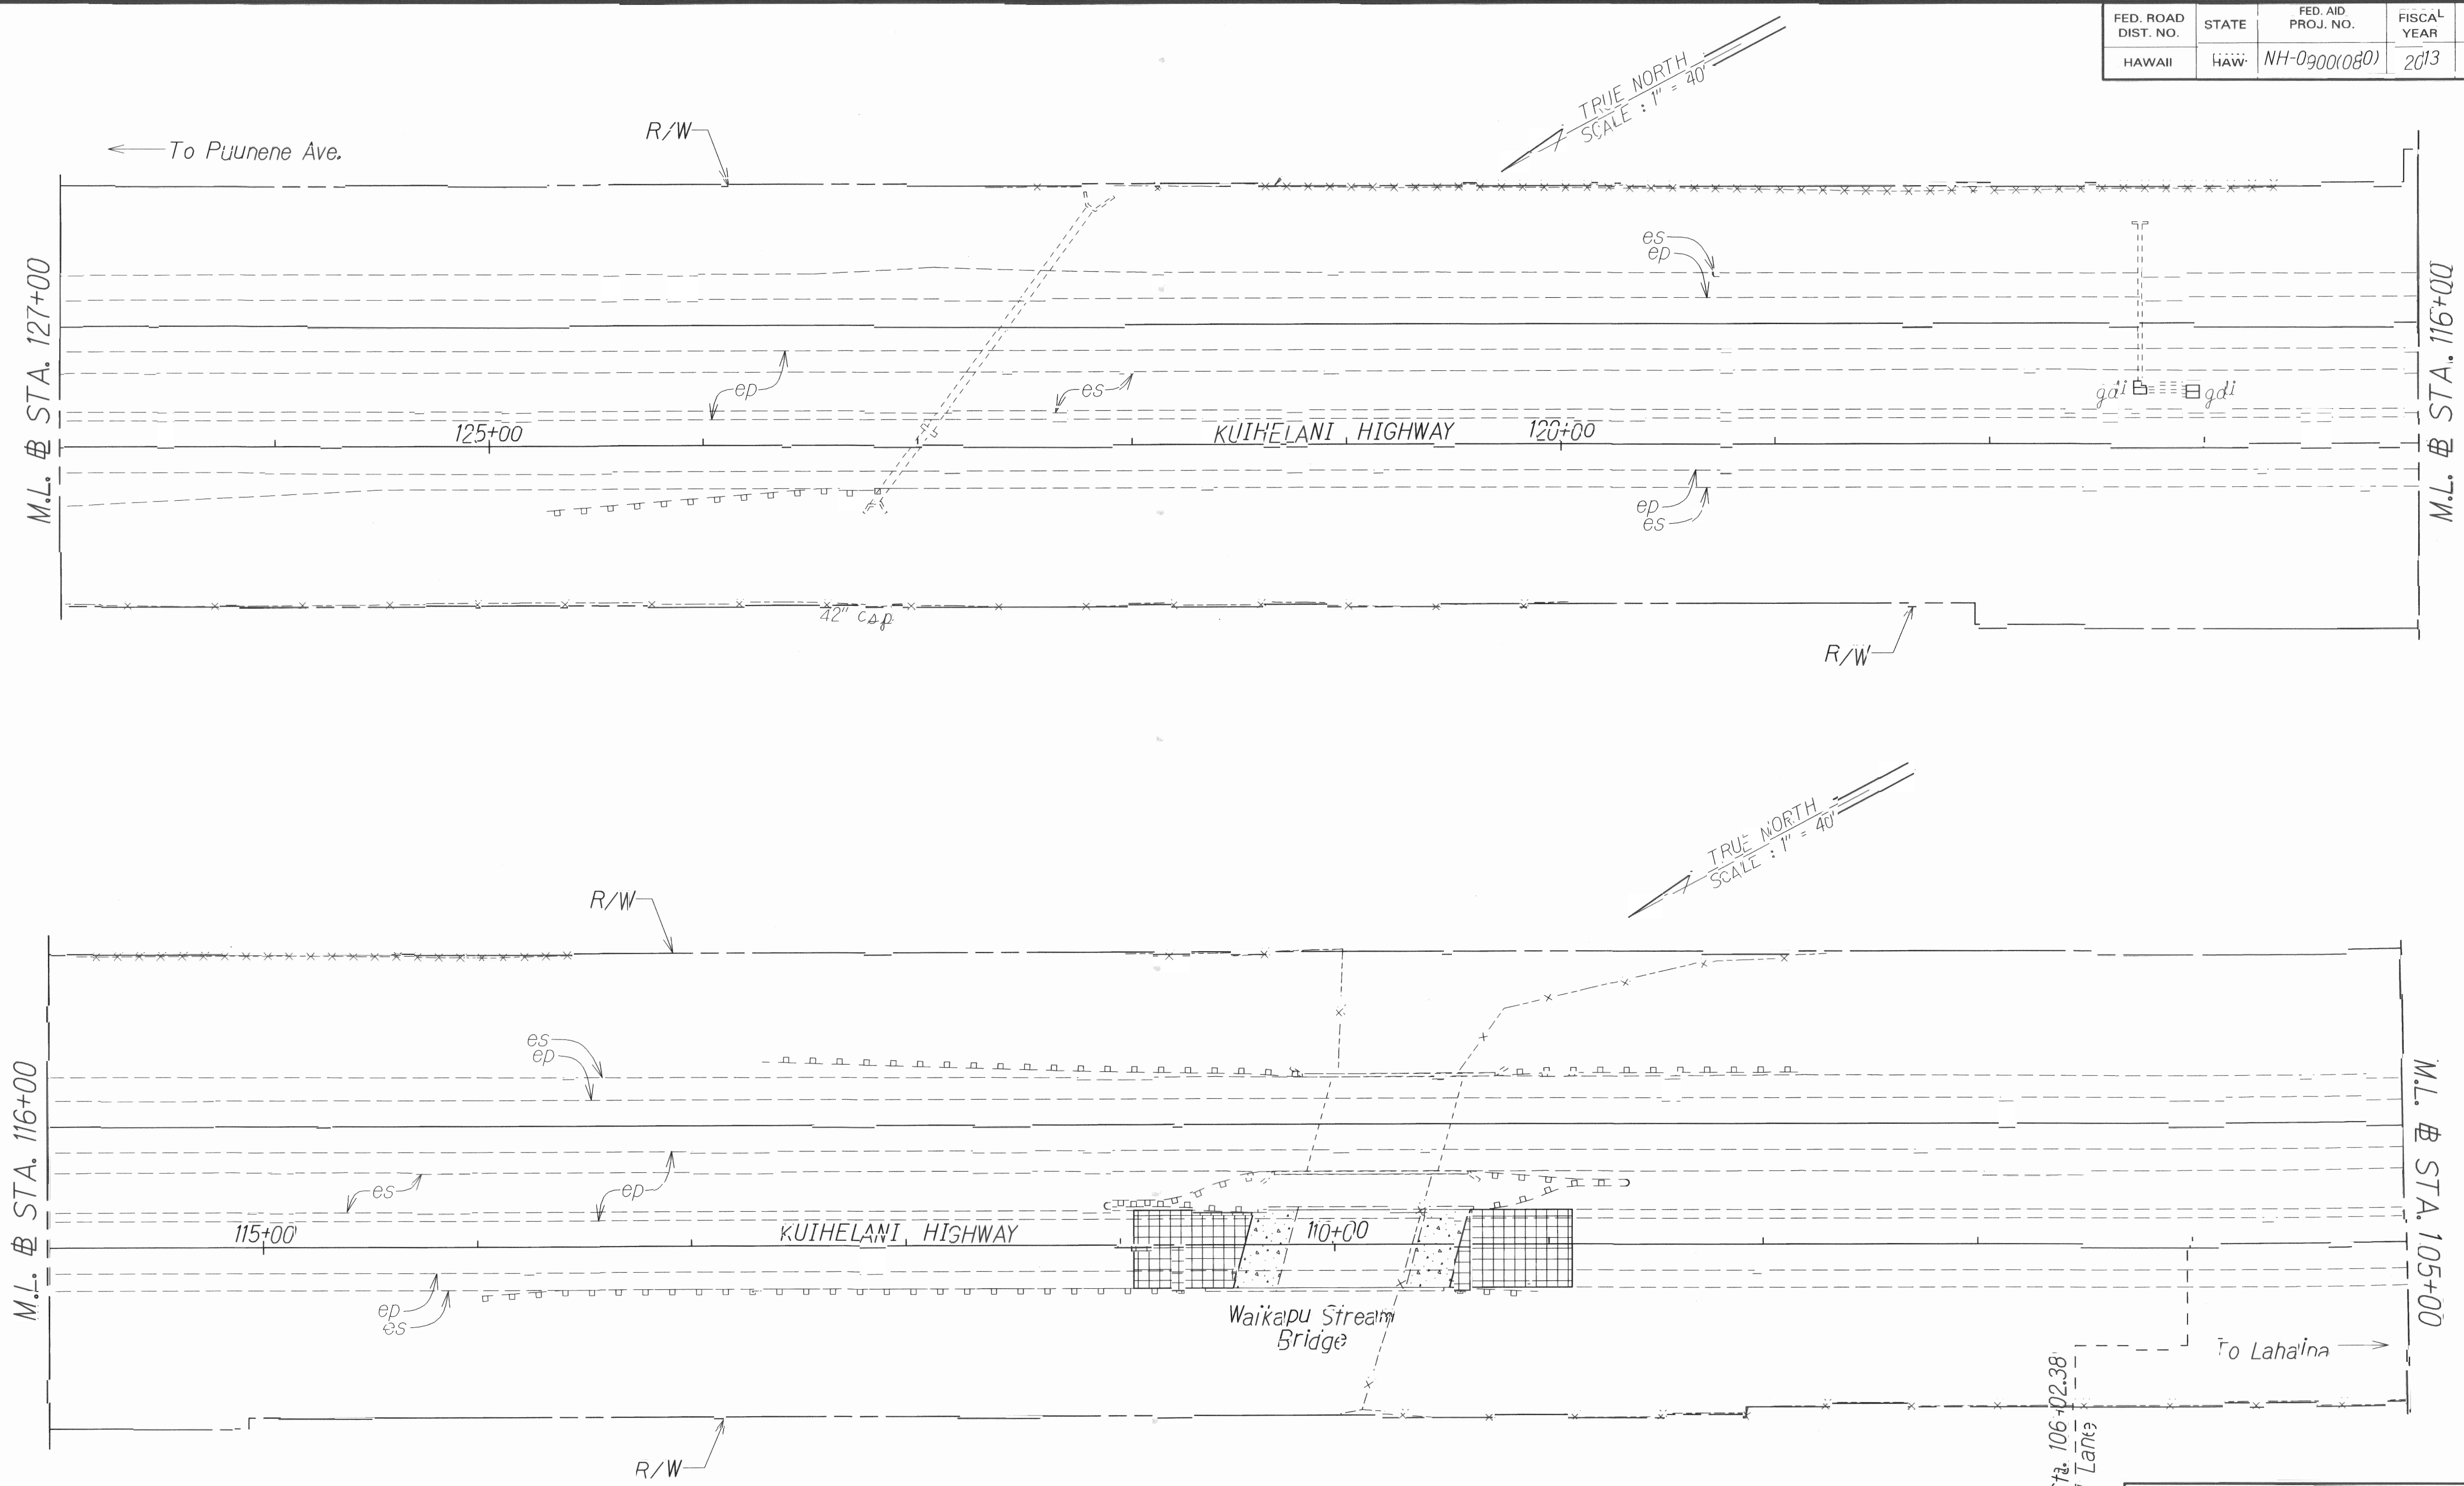

ORIGINAL PLAN	DATE
NOTED BY	DATE
DESIGNED BY	DATE
CHECKED BY	DATE

STATE OF HAWAII
DEPARTMENT OF TRANSPORTATION
HIGHWAYS DIVISION
ROADWAY PLAN
KUIHELANI HIGHWAY & HONOAPIILANI HIGHWAY
PAVEMENT PREVENTIVE MAINTENANCE
Puunene Avenue to Honoapiilani Highway
and Kuihelani Highway to Kapoli Street
Federal-Aid Project No. NH-0900(080)
Scale: 1" = 40' Date: May, 2012

FED. ROAD DIST. NO.	STATE	FED. AID PROJ. NO.	FISCAL YEAR	SHEET NO.	TOTAL SHEETS
HAWAII	HAW.	NH-0900(080)	2013	17	47

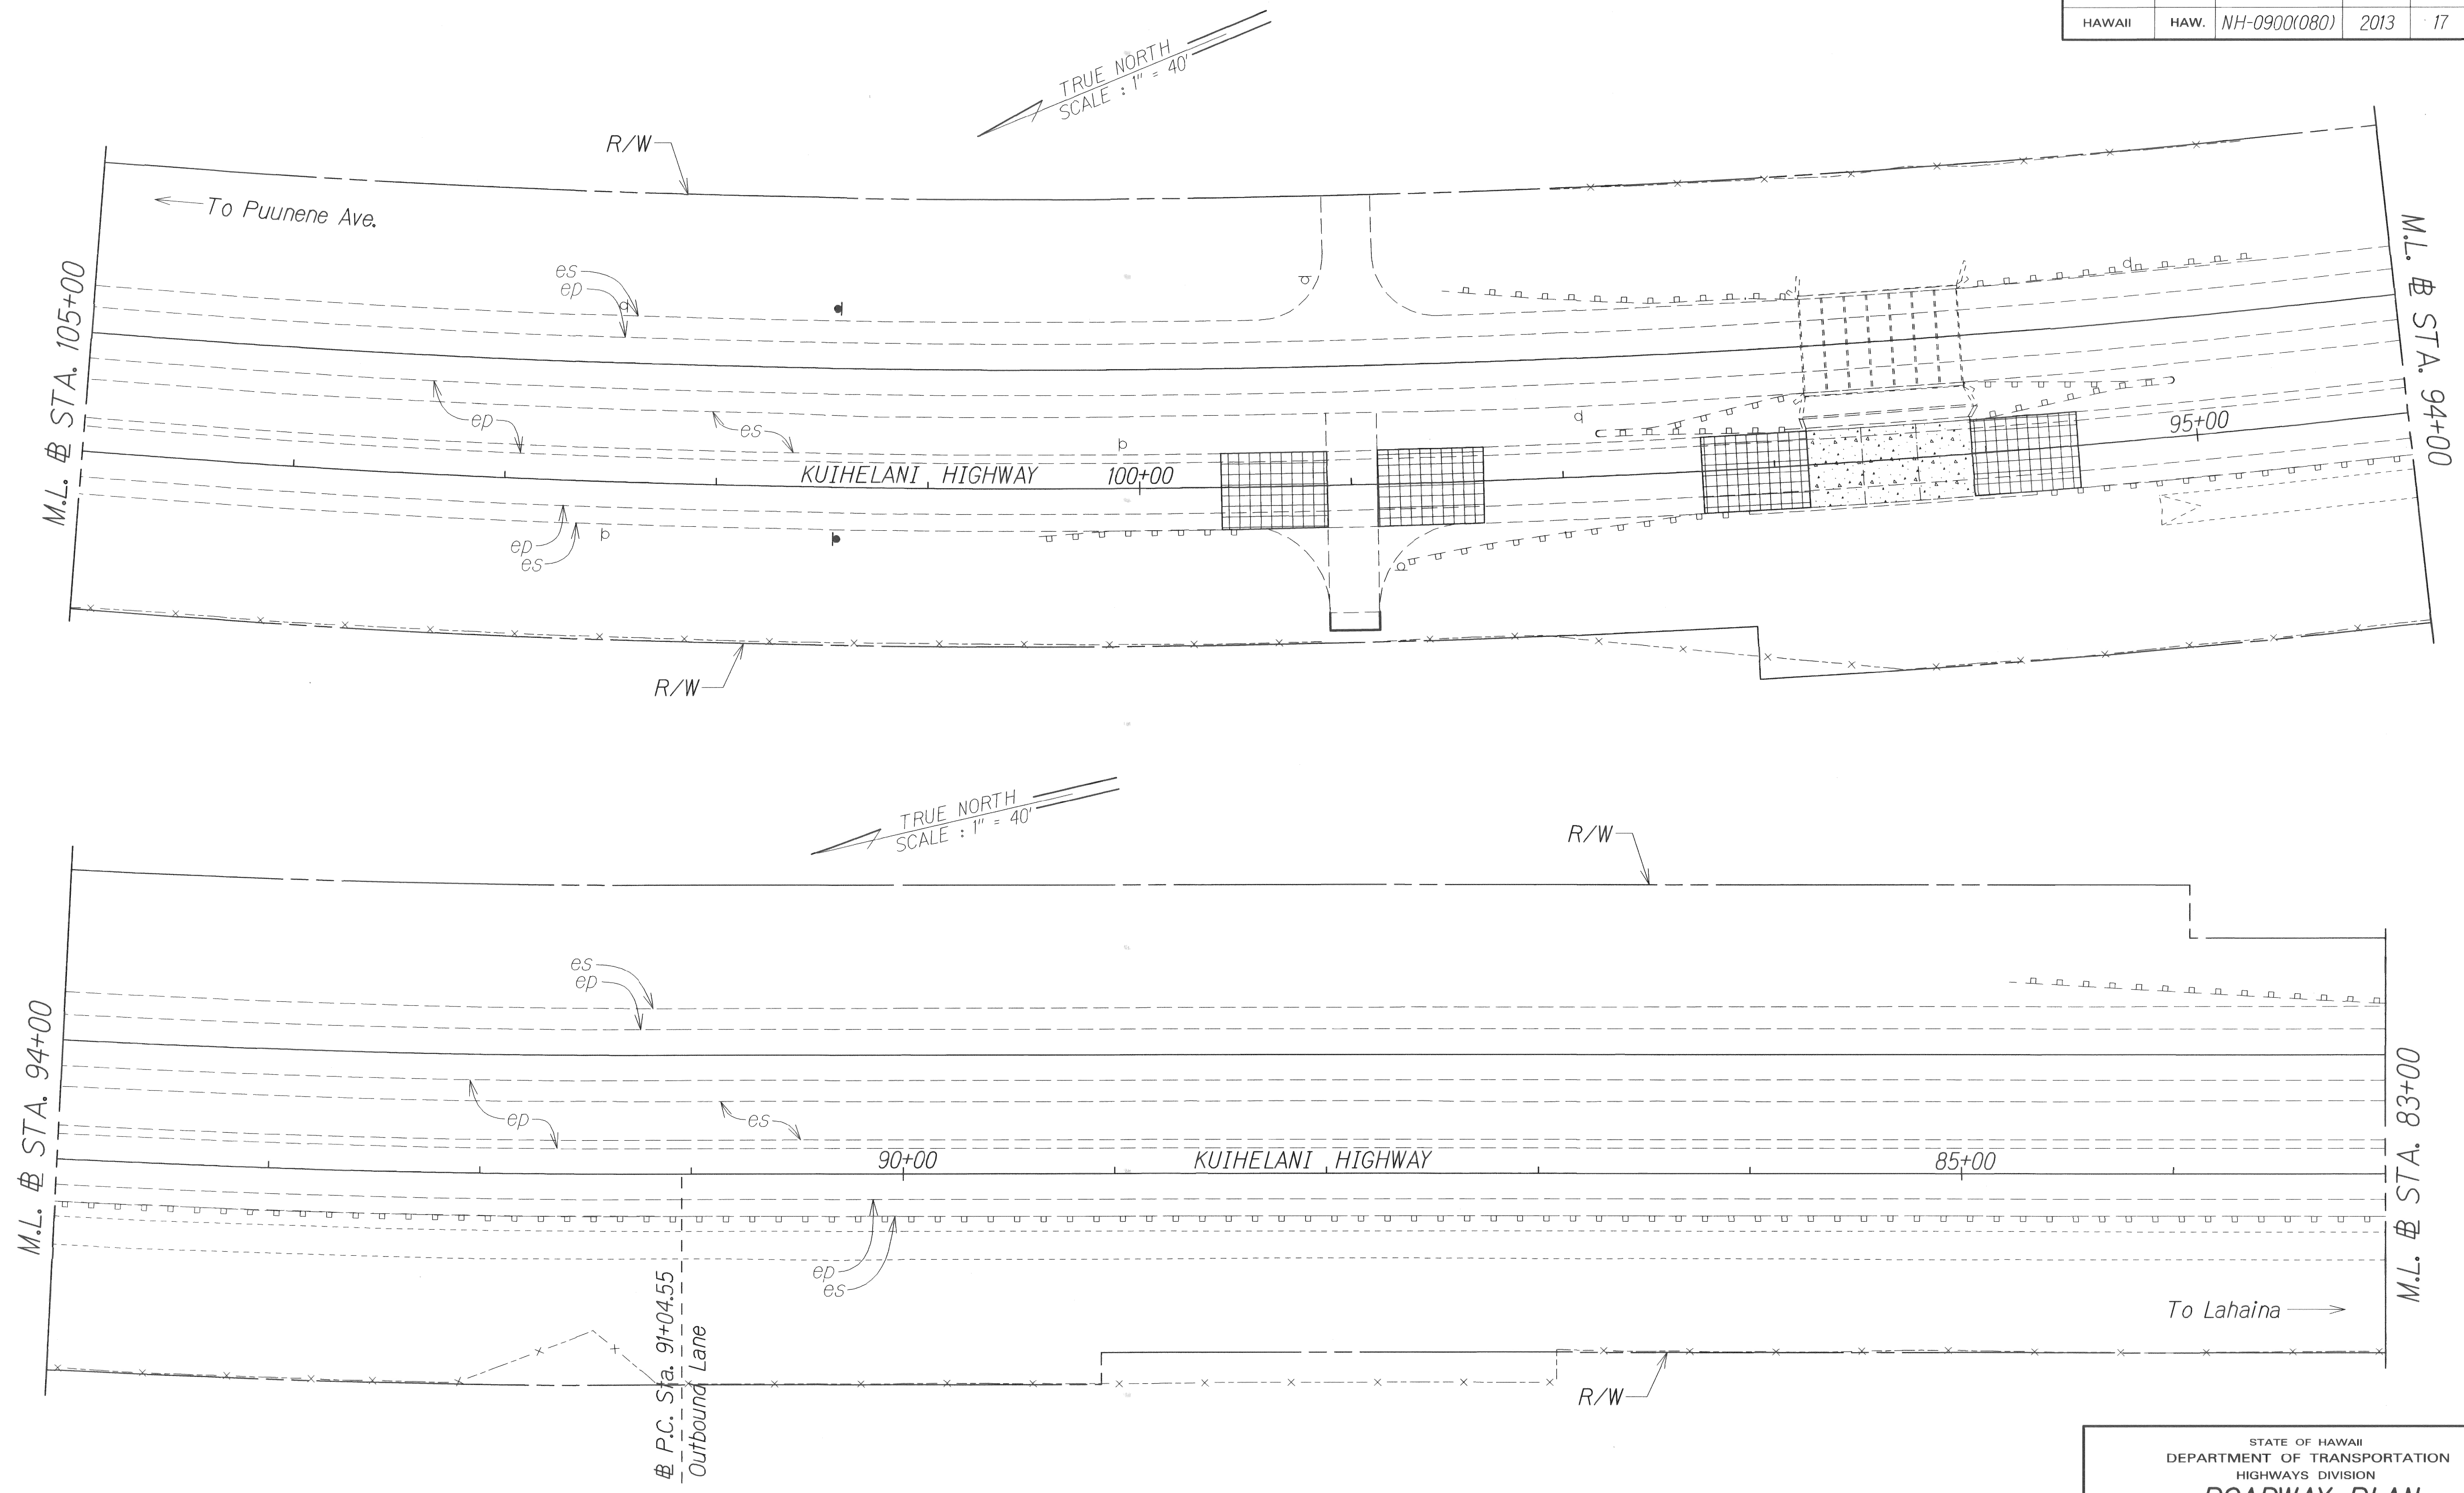


ORIGINAL PLAN	DATE
NOTED BY	7/12
DESIGNED BY	
QUANTITIES BY	
CHECKED BY	

STATE OF HAWAII
DEPARTMENT OF TRANSPORTATION
HIGHWAYS DIVISION

ROADWAY PLAN

KUIHELANI HIGHWAY & HONOAPIILANI HIGHWAY
PAVEMENT PREVENTIVE MAINTENANCE
Puunene Avenue to Honoapiilani Highway
and Kuihelani Highway to Kapoli Street
Federal-Aid Project No. NH-0900(080)
Scale: 1" = 40' Date: May, 2012

FED. ROAD DIST. NO.	STATE	FED. AID PROJ. NO.	FISCAL YEAR	SHEET NO.	TOTAL SHEETS
HAWAII	HAW.	NH-0900(080)	2013	18	47

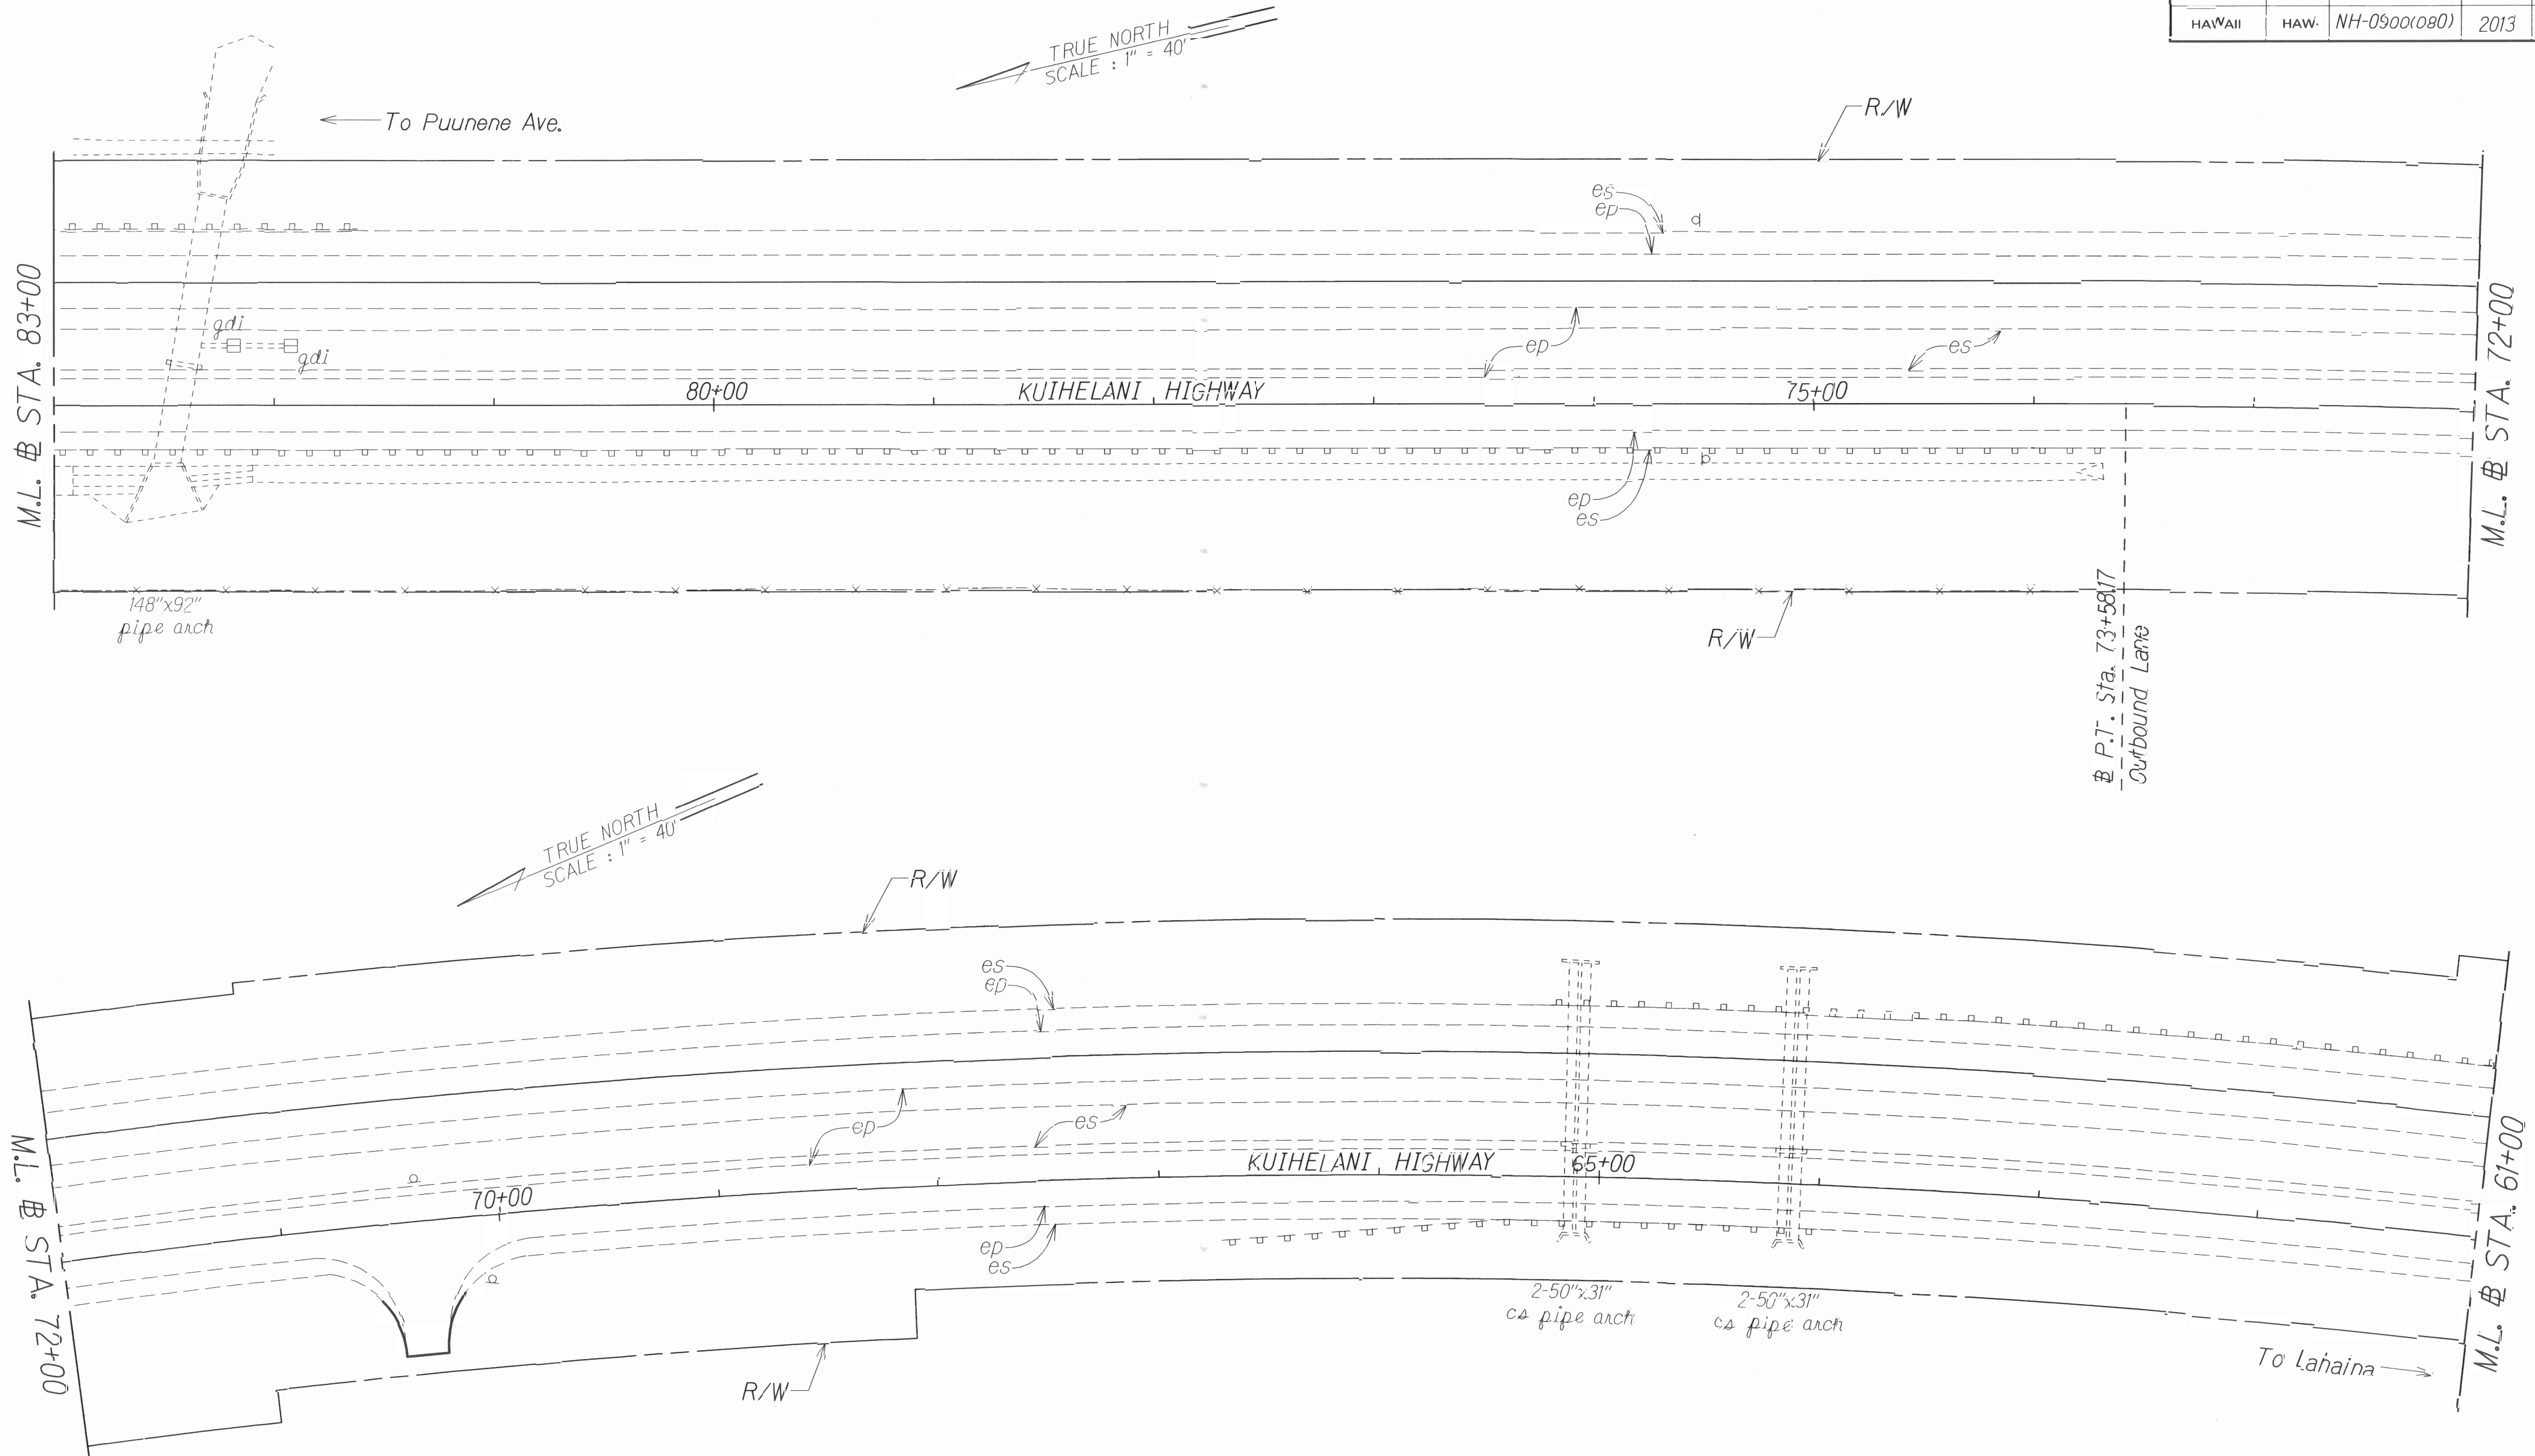

ORIGINAL PLAN	DATE
SURVEY LOCATED BY	1/12
TRACED BY	
DESIGNED BY	
QUANTITIES BY	
CHECKED BY	



STATE OF HAWAII
DEPARTMENT OF TRANSPORTATION
HIGHWAYS DIVISION

ROADWAY PLAN

KUIHELANI HIGHWAY & HONOAPIILANI HIGHWAY
PAVEMENT PREVENTIVE MAINTENANCE
Puunene Avenue to Honoapiilani Highway
and Kuihelani Highway to Kapoli Street
Federal-Aid Project No. NH-0900(080)
Scale: 1" = 40' Late: May, 2012

SHEET No. 10 OF 18 SHEETS

FED. ROAD DIST. NO.	STATE	FED. AID PROJ. NO.	FISCAL YEAR	SHEET NO.	TOTAL SHEETS
HAWAII	HAW.	NH-0900(080)	2013	19	47

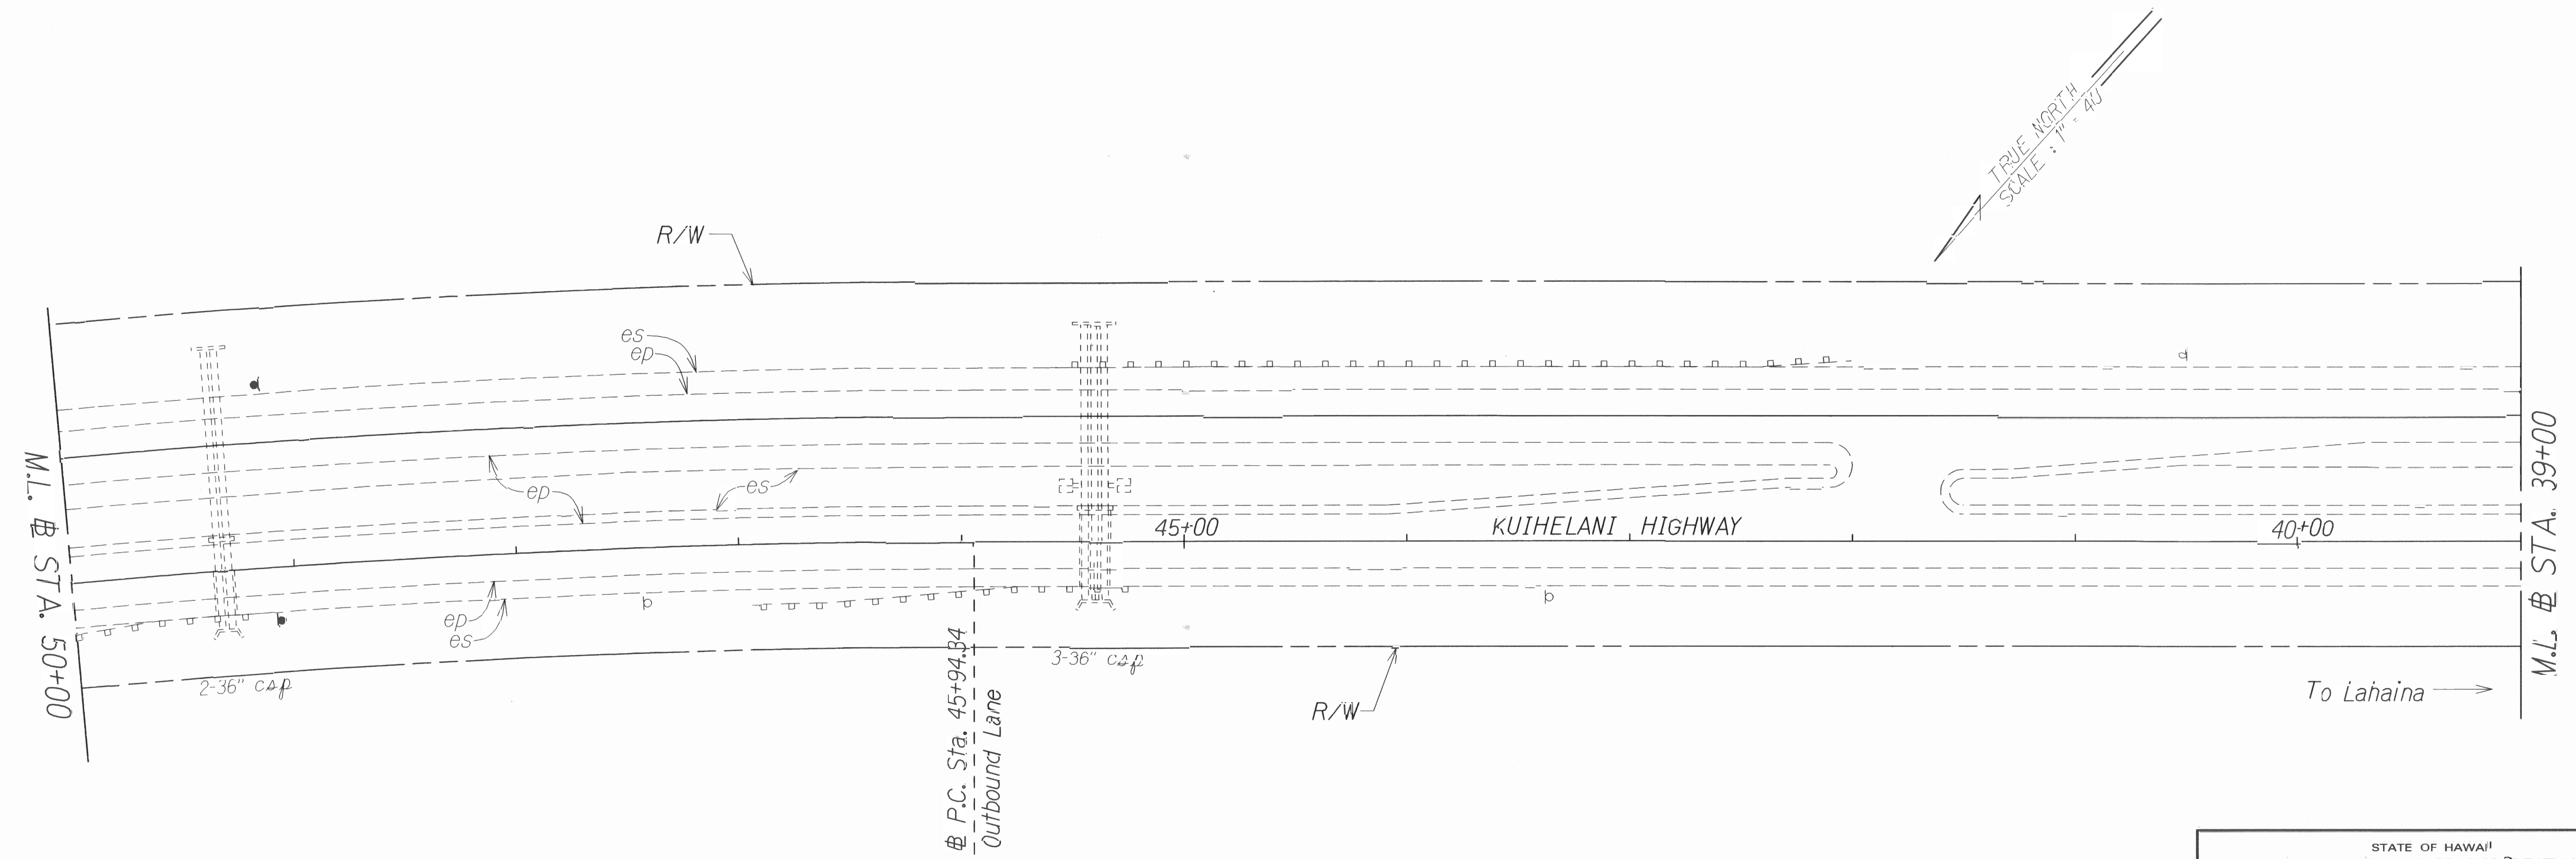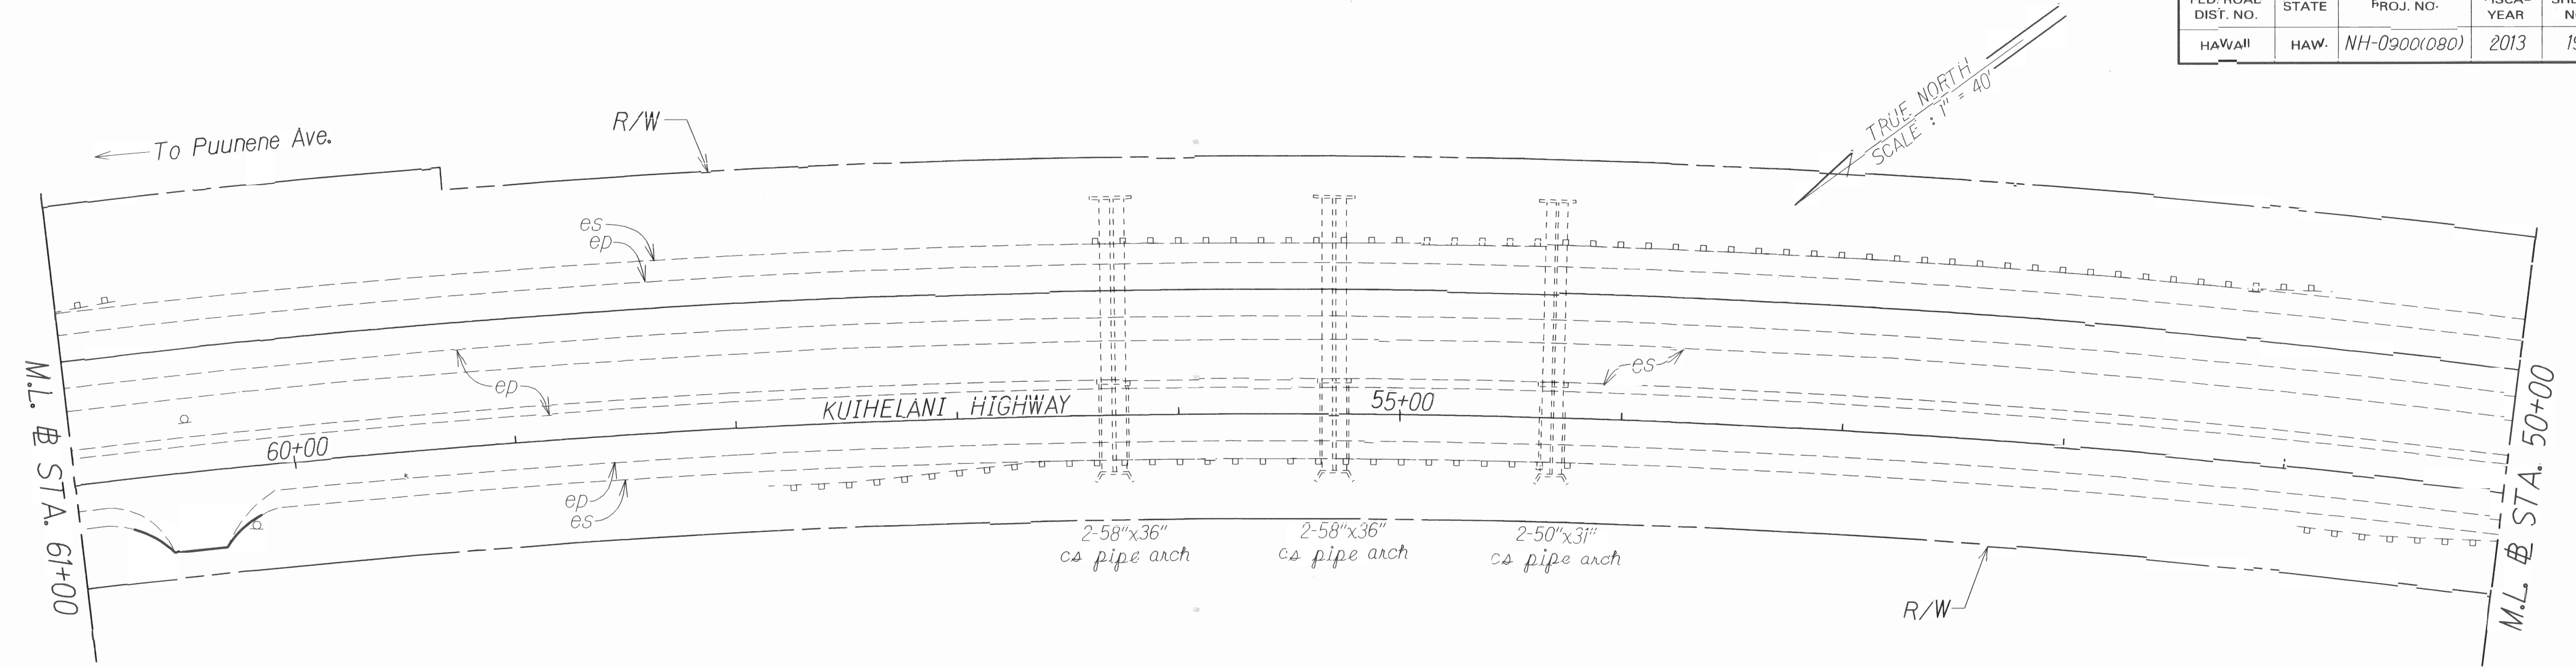



ORIGINAL PLAN	SURVEY PLOTTED BY	DATE
NOTED BY	DRAWN BY	1/12
QUANTITIES BY	TRACED BY	
CHECKED BY	NOTED BY	

STATE OF HAWAII
DEPARTMENT OF TRANSPORTATION
HIGHWAYS DIVISION

ROADWAY PLAN

KUIHELANI HIGHWAY & HONOAPIILANI HIGHWAY
PAVEMENT PREVENTIVE MAINTENANCE
Puunene Avenue to Honoapiilani Highway
and Kuihelani Highway to Kapoli Street
Federal-Aid Project No. NH-0900(080)
Scale: 1" = 40' Date: May, 2012

FED. ROAD DIST. NO.	STATE	FED. AID PROJ. NO.	FISCAL YEAR	SHEET NO.	TOTAL SHEETS
HAWAII	HAW.	NH-0900(080)	2013	20	47

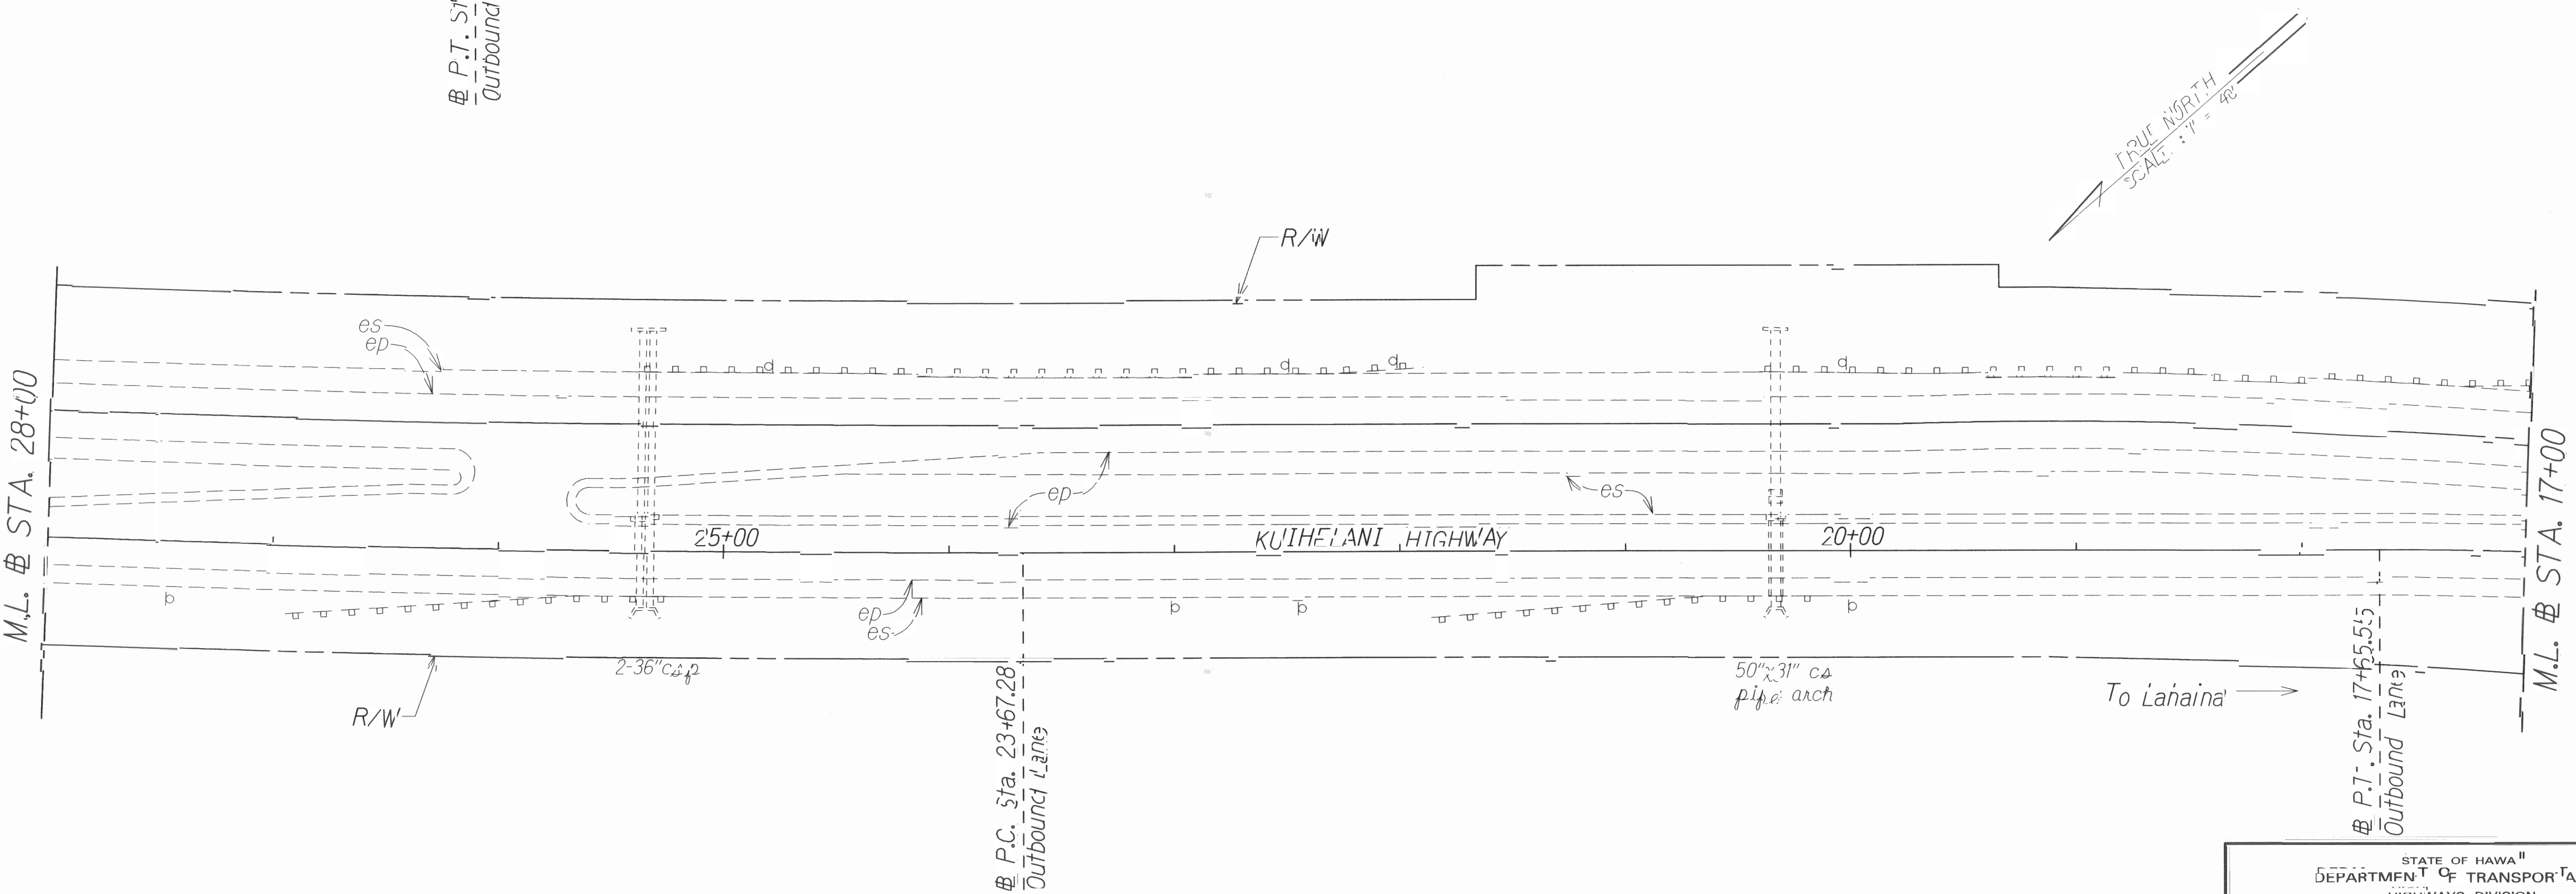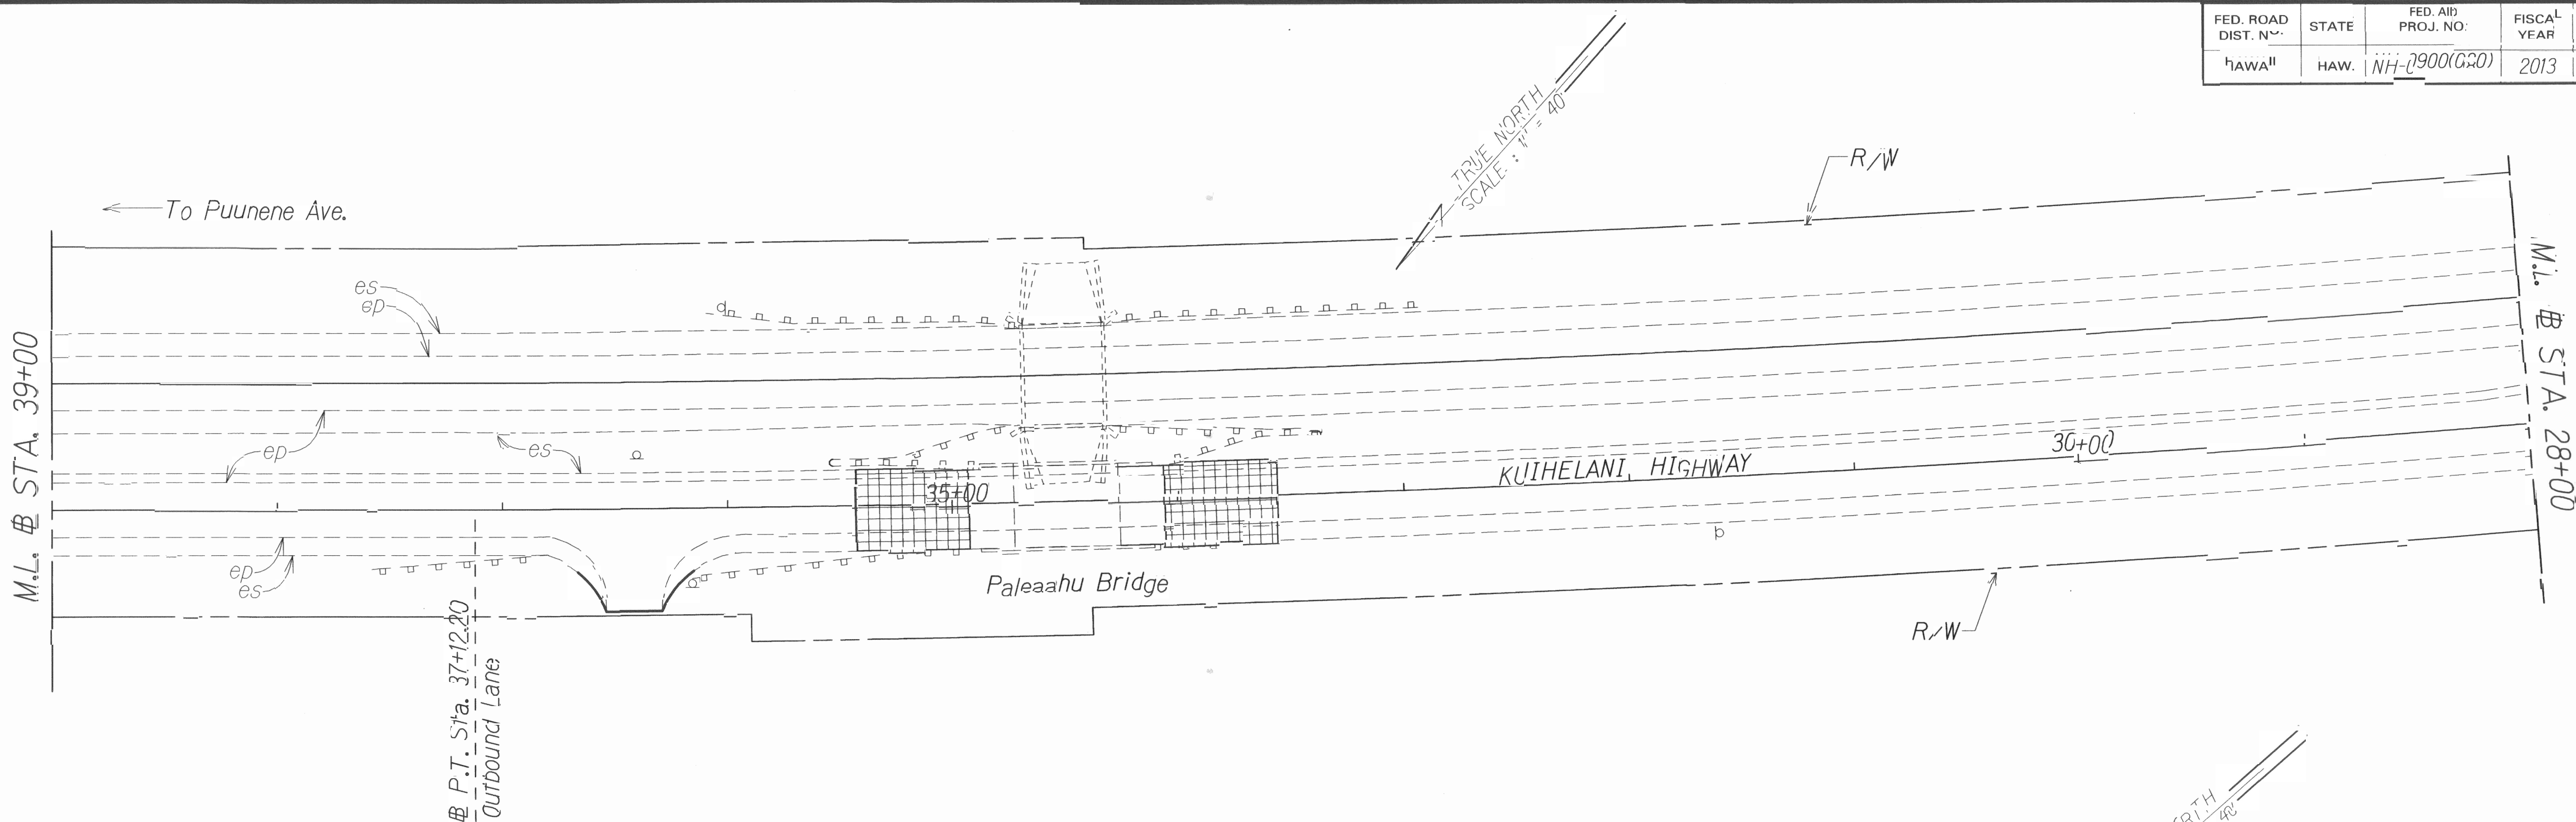


ORIGINAL PLAN	DATE
NOTED	7/12
DESIGNED BY	
CHECKED BY	

STATE OF HAWAII
DEPARTMENT OF TRANSPORTATION
HIGHWAYS DIVISION


ROADWAY PLAN
KUIHELANI HIGHWAY & HONOAPIILANI HIGHWAY
PAVEMENT PREVENTIVE MAINTENANCE
Puunene Avenue to Honoapiilani Highway
and Kuihelani Highway to Kapoli Street
Federal-Aid Project No. NH-0900(080)
Scale: 1" = 40'

Date: May, 2012

FED. ROAD DIST. NO.	STATE	FED. AID PROJ. NO.	FISCAL YEAR	SHEET NO.	TOTAL SHEETS
HAWAII	HAW.	NH-0900(080)	2013	ADD.21	47

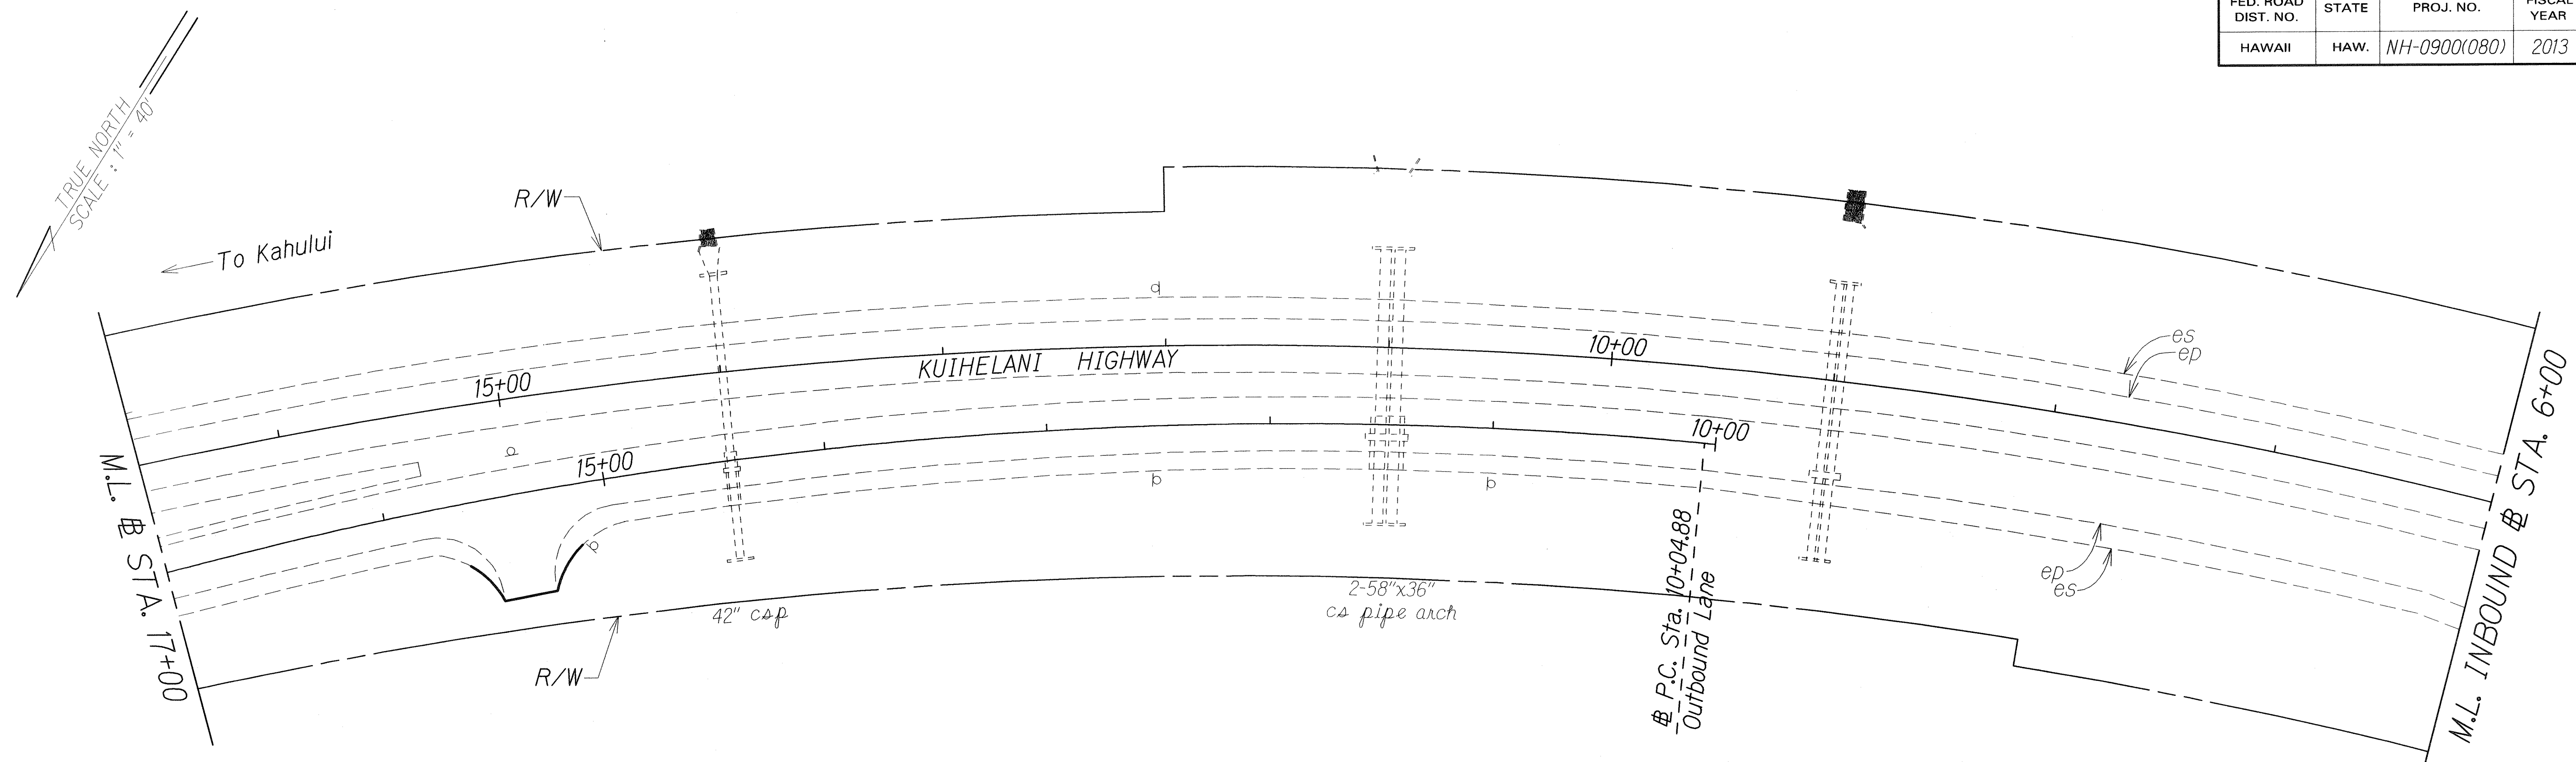

TRUE NORTH
SCALE : 1" = 40'

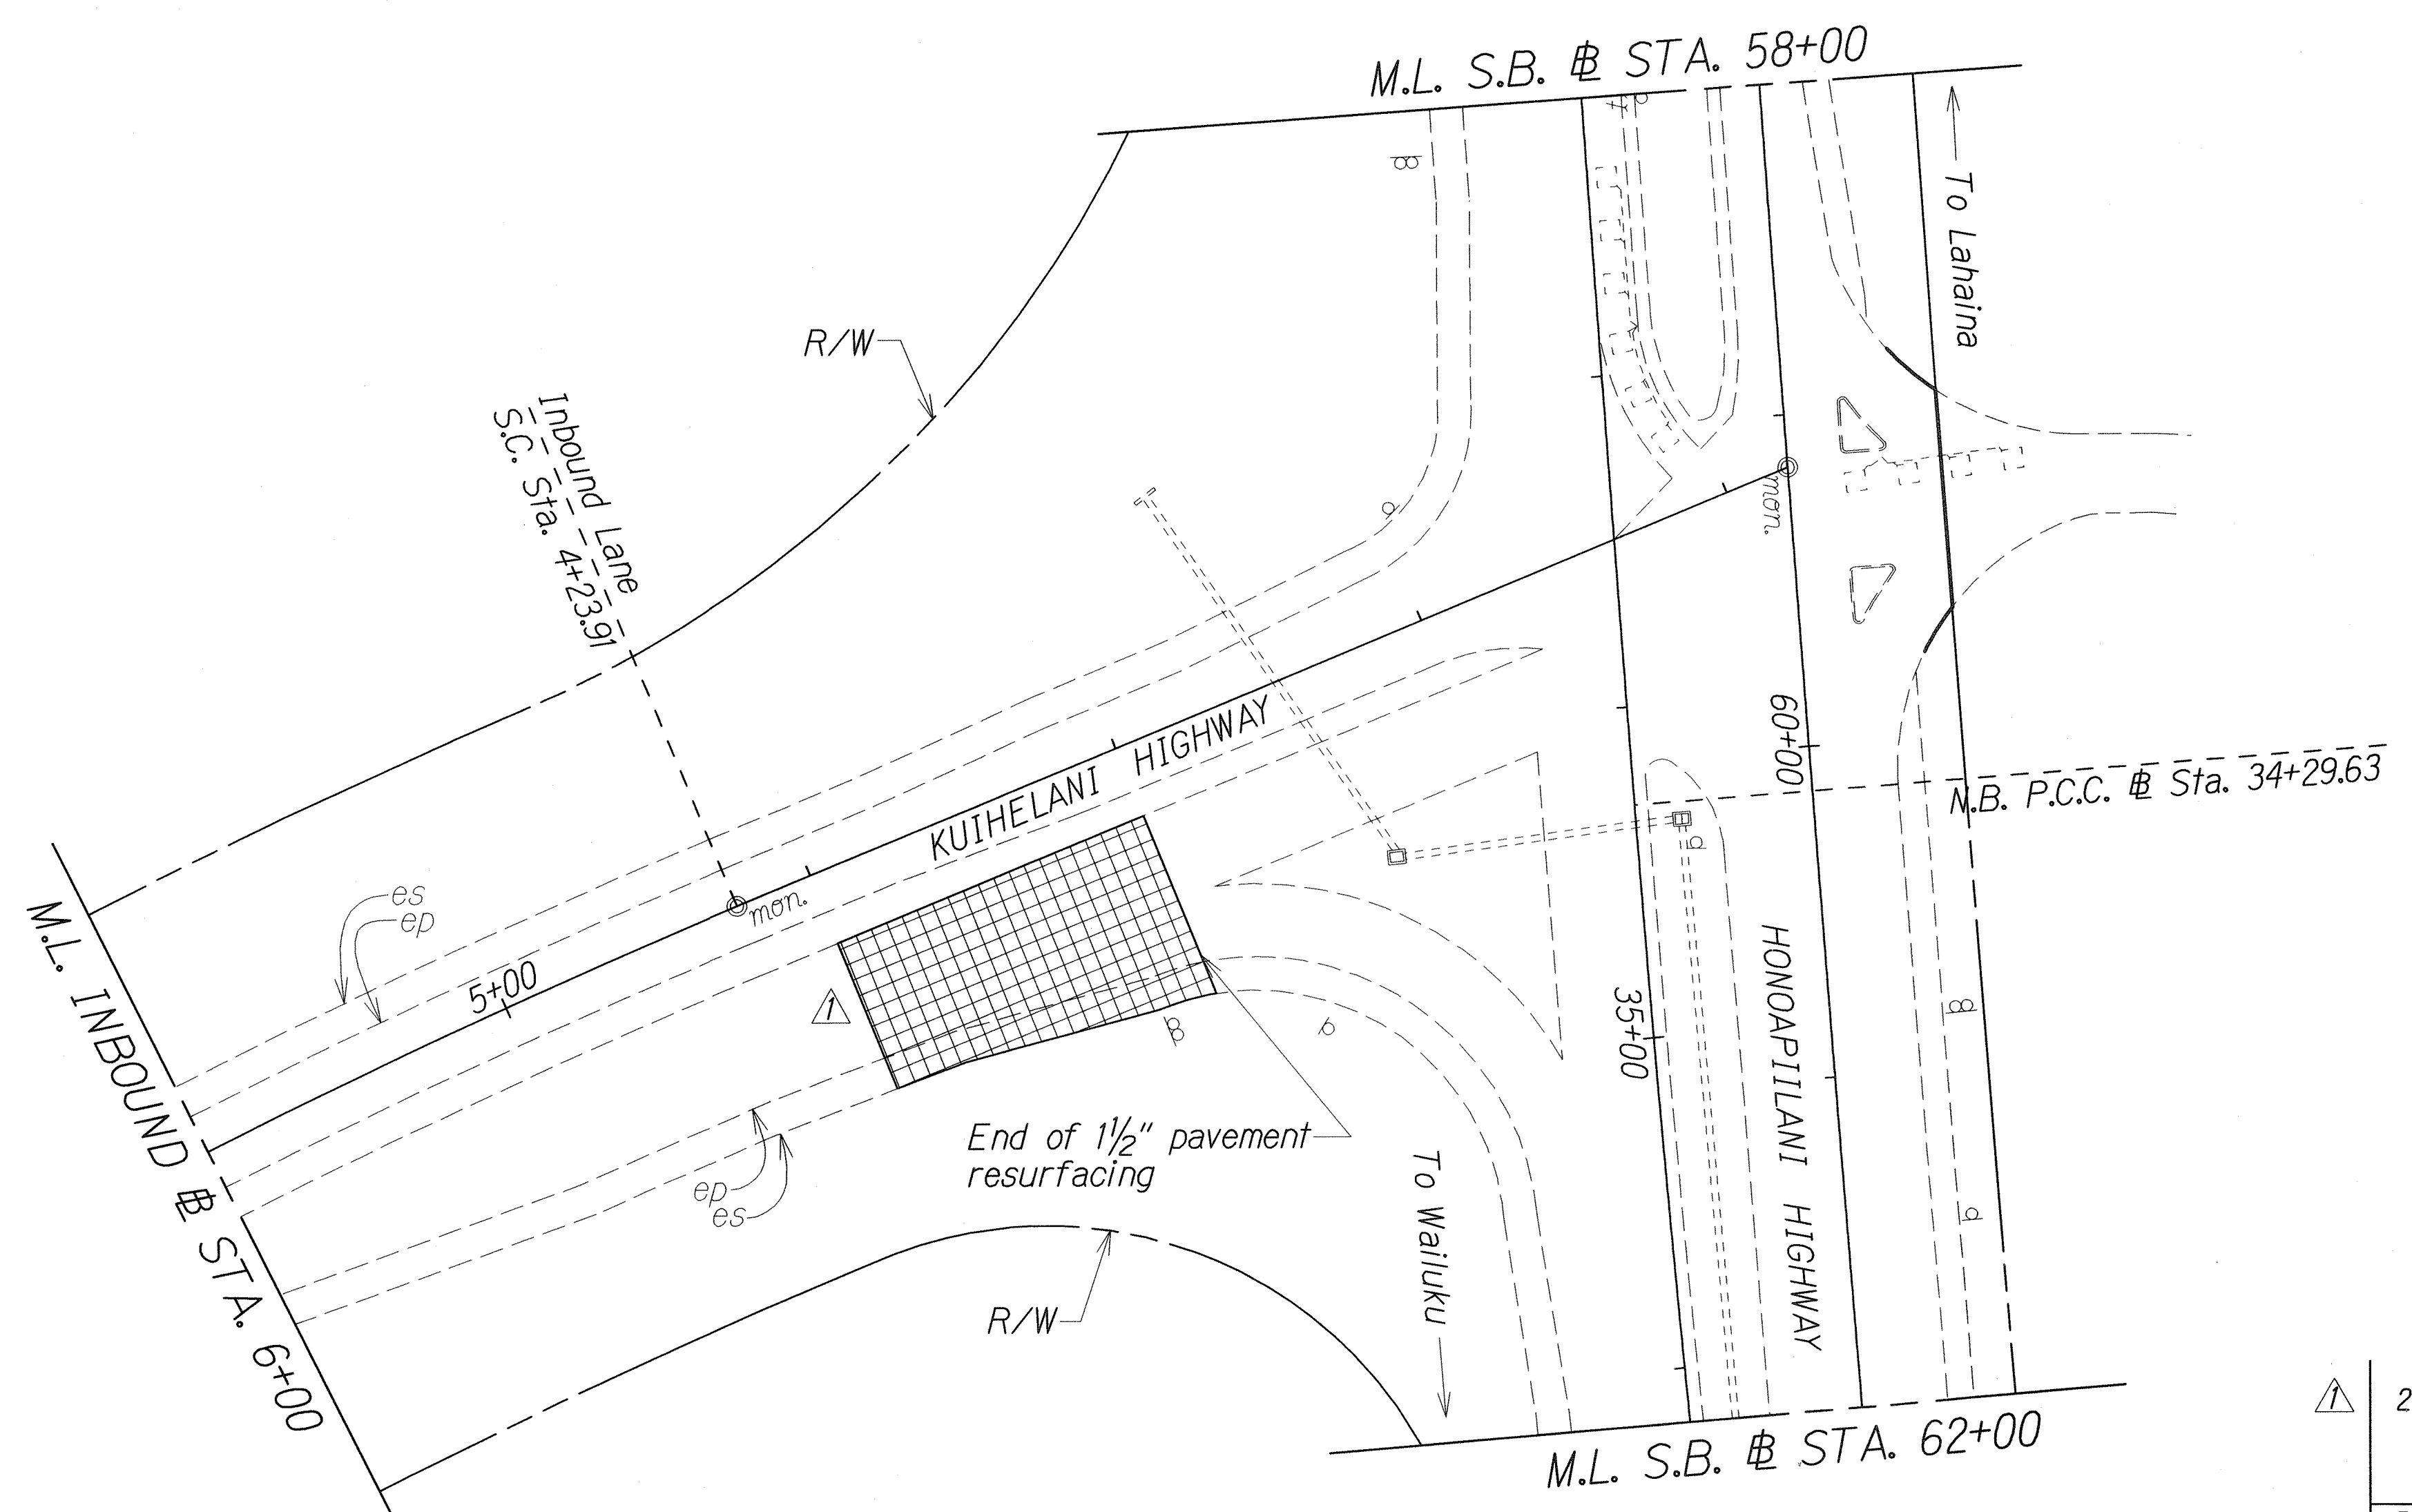

DATE	1/12
SURVEY DICTATED BY	
DRAWN BY	
DESIGNED BY	Edo G.
CHECKED BY	
ORIGINAL PLAN	
NOTE BOOK	
DATE	1/12
CHECKED BY	

DATE	2-11-13	Cold planing required end of 1 1/2" resurfacing.
REVISION		


STATE OF HAWAII
DEPARTMENT OF TRANSPORTATION
HIGHWAYS DIVISION

ROADWAY PLAN

KUIHELANI HIGHWAY & HONOAPIILANI HIGHWAY
PAVEMENT PREVENTIVE MAINTENANCE
Puunene Avenue to Honoapiilani Highway
and Kuihelani Highway to Kapoli Street
Federal-Aid Project No. NH-0900(080)
Scale: 1" = 40' Date: May, 2012

SHEET No. 13 OF 18 SHEETS

FED. ROAD DIST. NO.	STATE	FED. AID PROJ. NO.	FISCAL YEAR	SHEET NO.	TOTAL SHEETS
HAWAII	HAW.	NH-0900(080)	2013	ADD.22	47

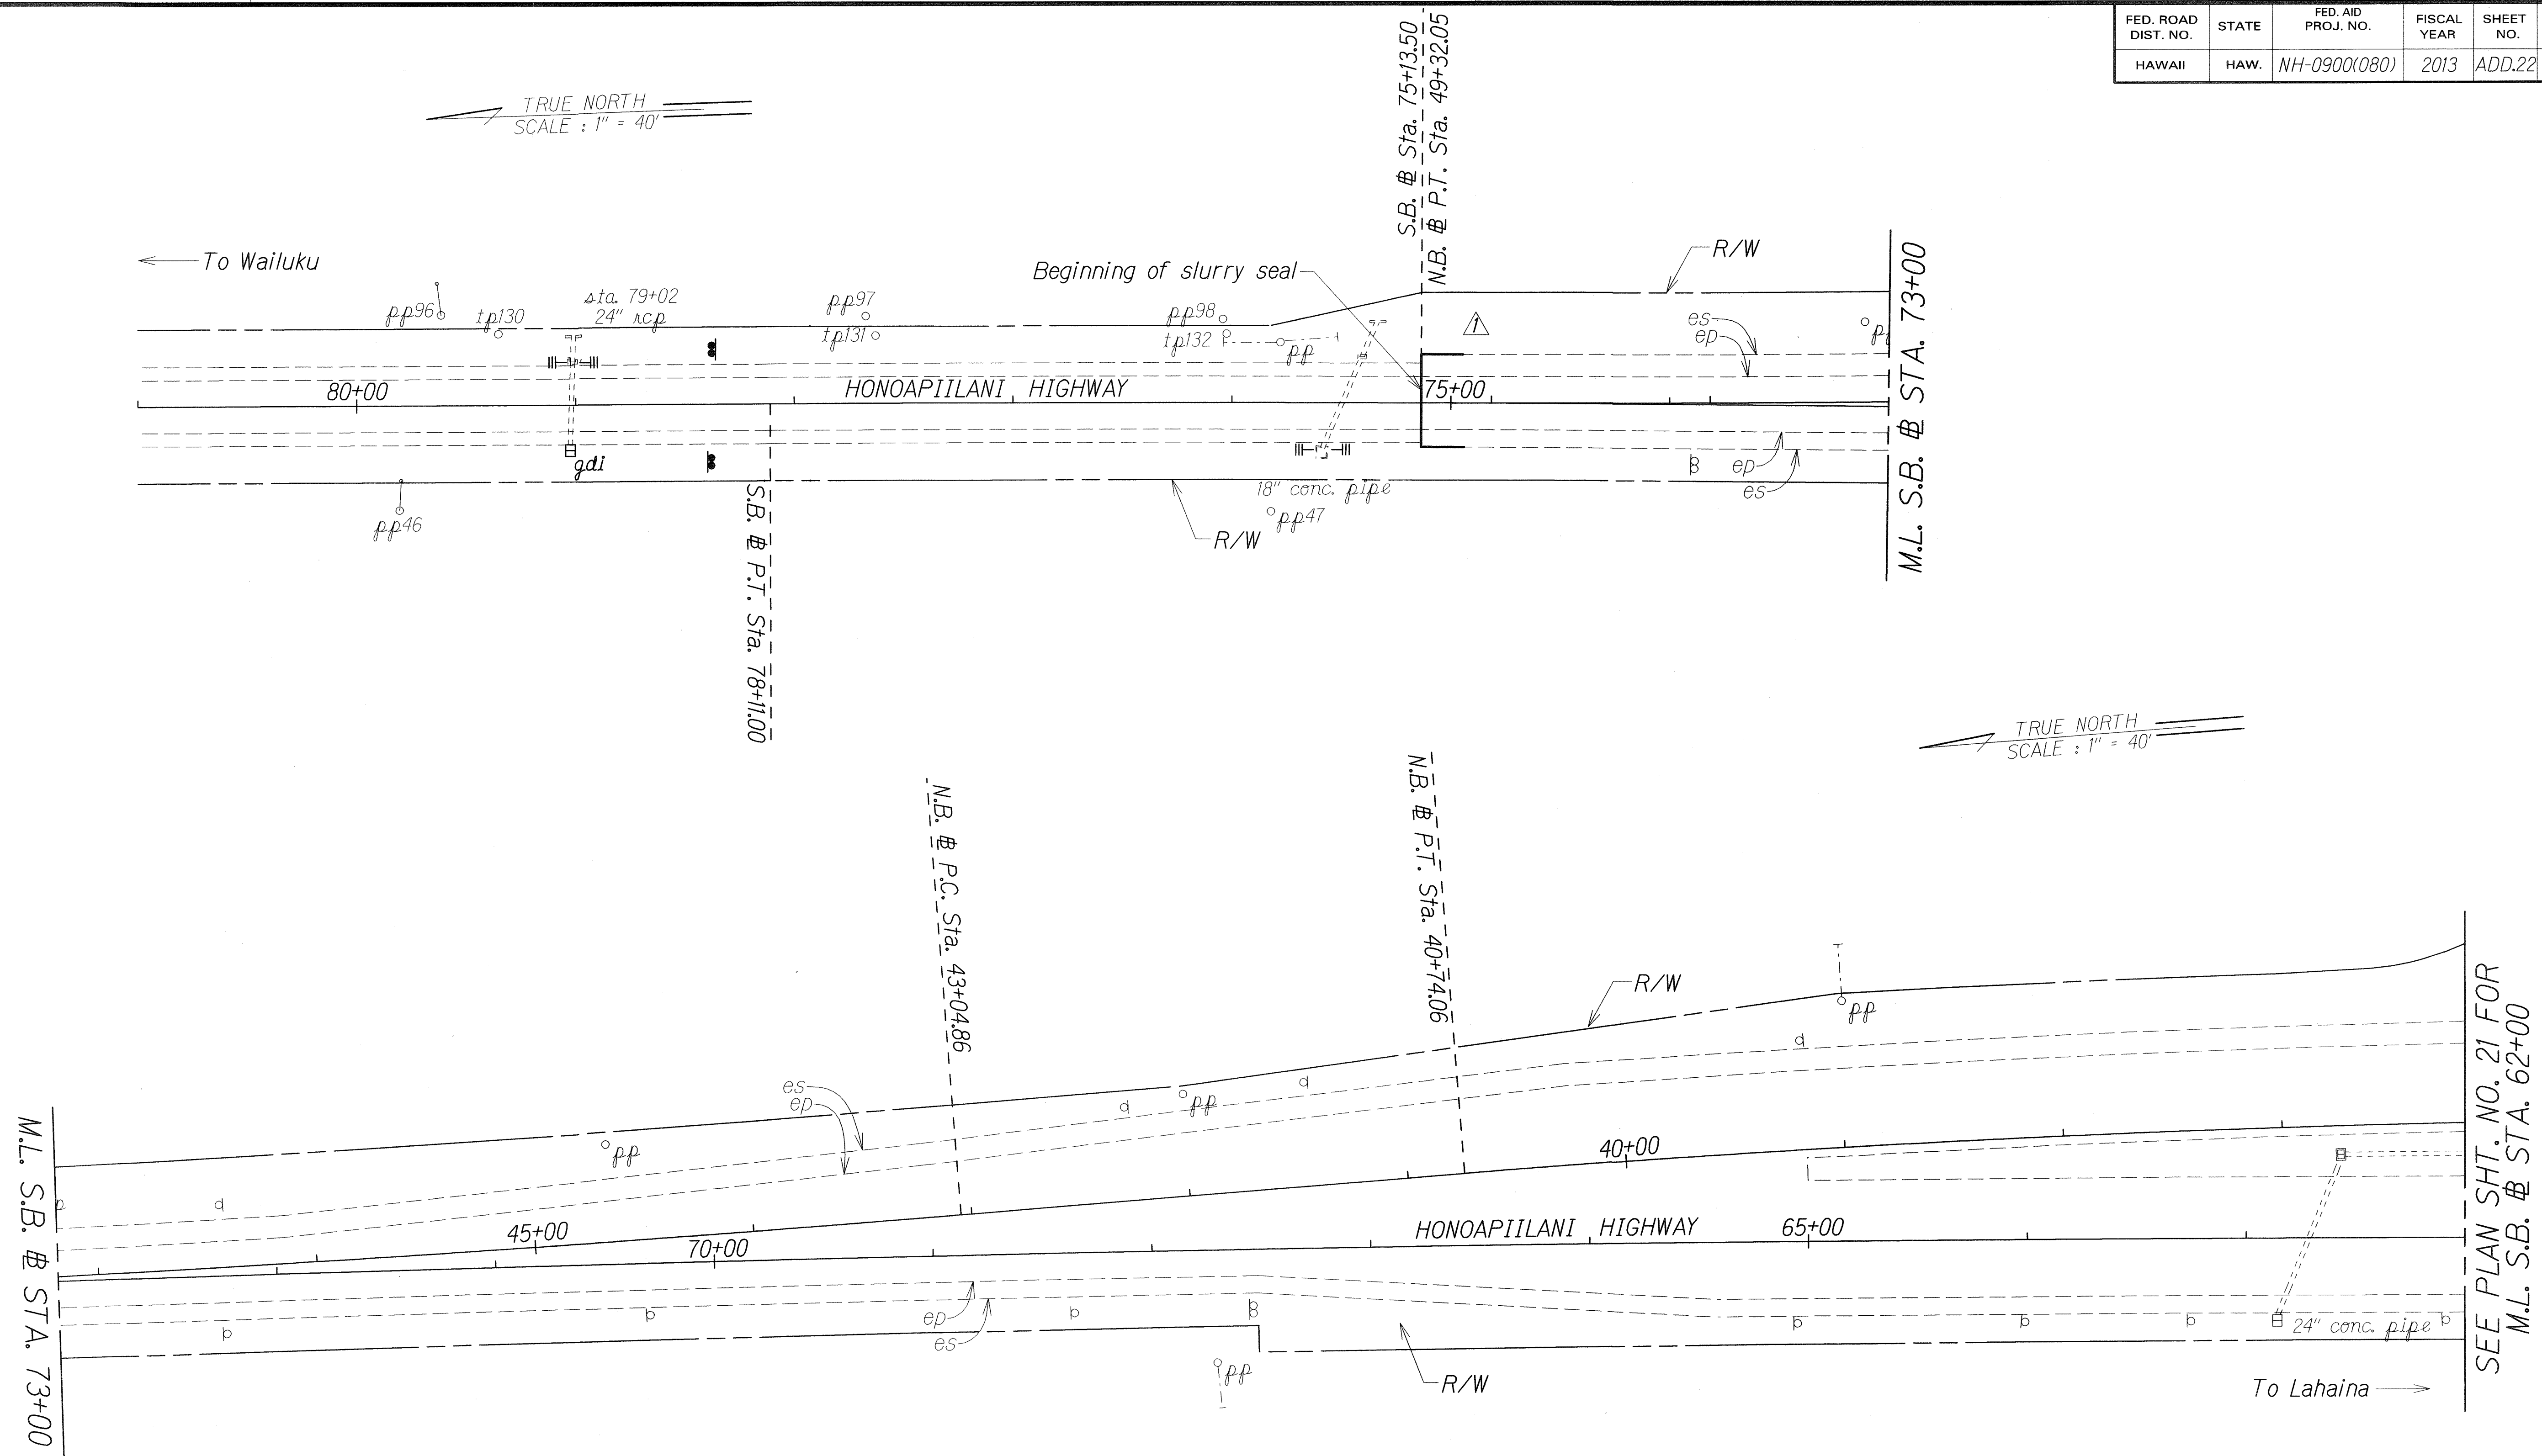


ORIGINAL PLAN	SURVEY PLOTTED BY	DATE
NOTE BOOK	DRAWN BY	1/12
NOTE	TRACED BY	
NOTE	DESIGNED BY	
NOTE	QUANTITIES BY	
NOTE	CHECKED BY	

△	2-11-13	Cold planing deleted - Not required for slurry seal.
△	2-11-13	Added limit of slurry seal.
DATE	REVISION	


STATE OF HAWAII DEPARTMENT OF TRANSPORTATION HIGHWAYS DIVISION ROADWAY PLAN KUIHELANI HIGHWAY & HONOAPIILANI HIGHWAY PAVEMENT PREVENTIVE MAINTENANCE Puunene Avenue to Honoapiilani Highway and Kuihelani Highway to Kapoli Street Federal-Aid Project No. NH-0900(080) Scale: 1" = 40' Date: May, 2012
SHEET No. 14 OF 18 SHEETS

FED. ROAD DIST. NO.	STATE	FED. AID PROJ. NO.	FISCAL YEAR	SHEET NO.	TOTAL SHEETS
HAWAII	HAW.	NH-0900(080)	2013	ADD.23	47

SEE PLAN SHT. NO. 21 FOR
M.L. S.B. # STA. 58+00

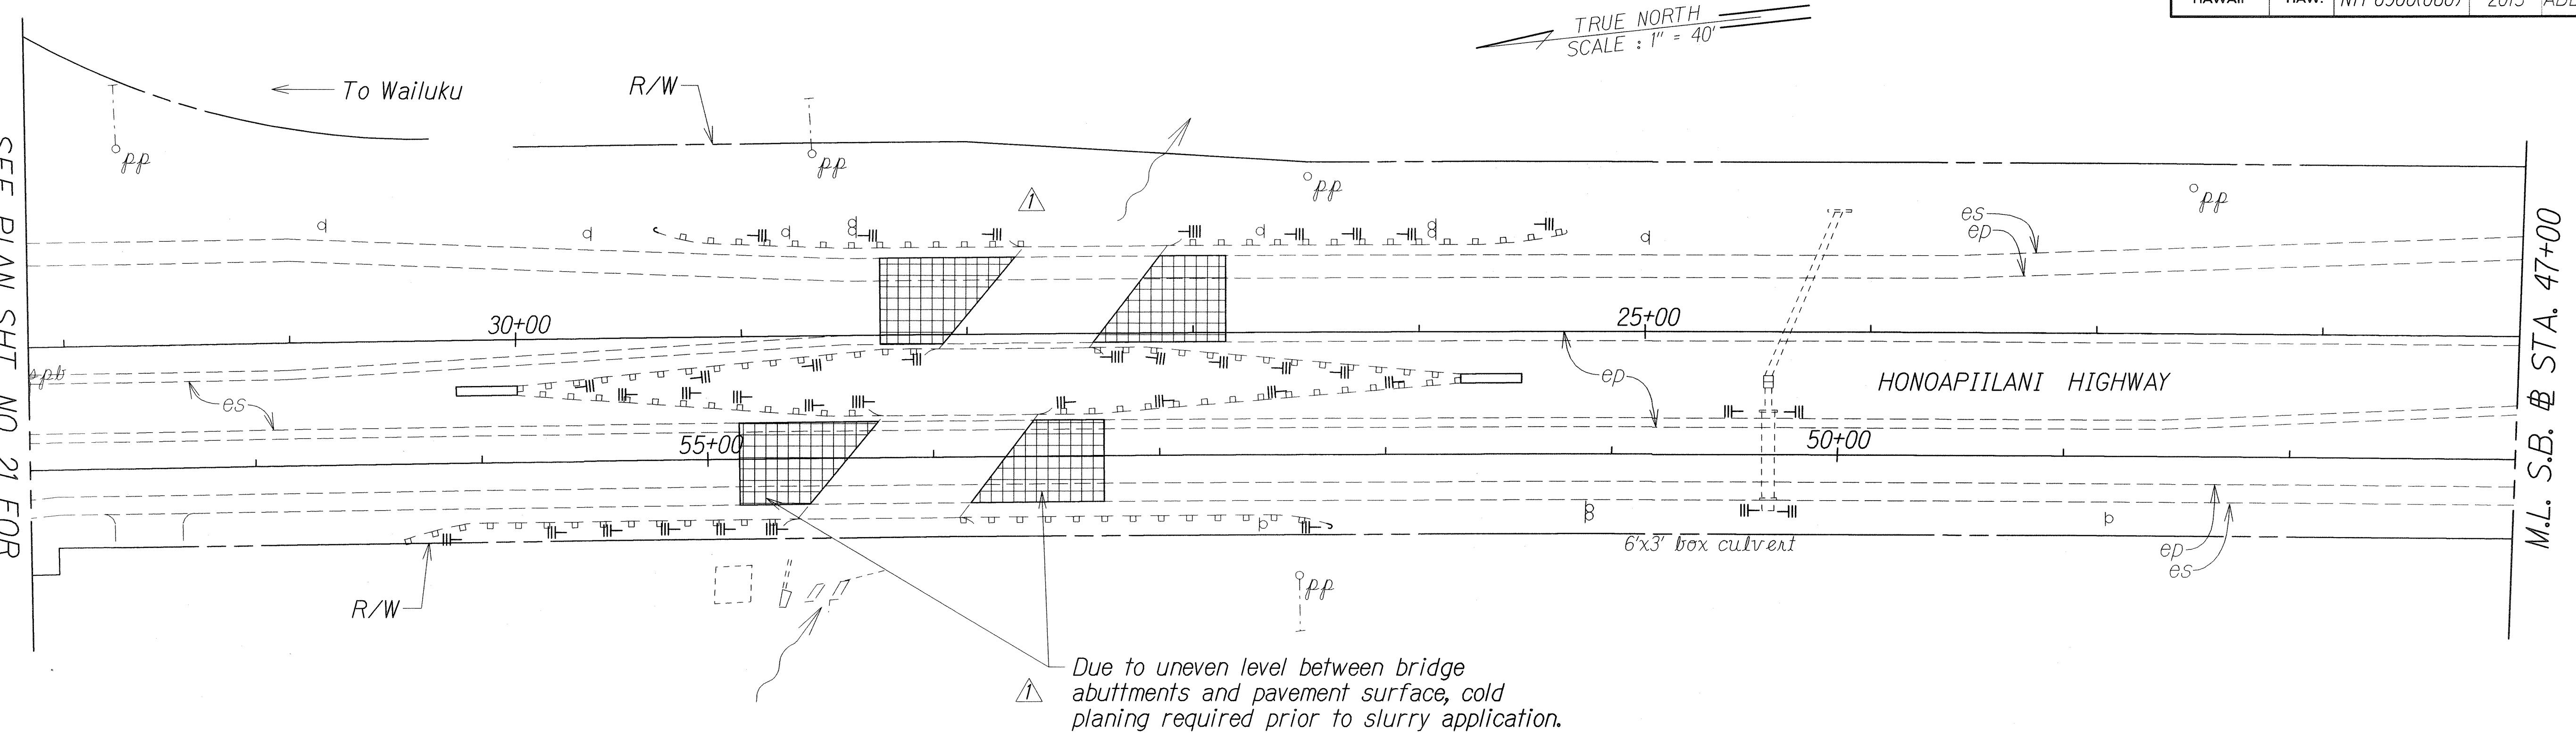

M.L. S.B. # STA. 47+00

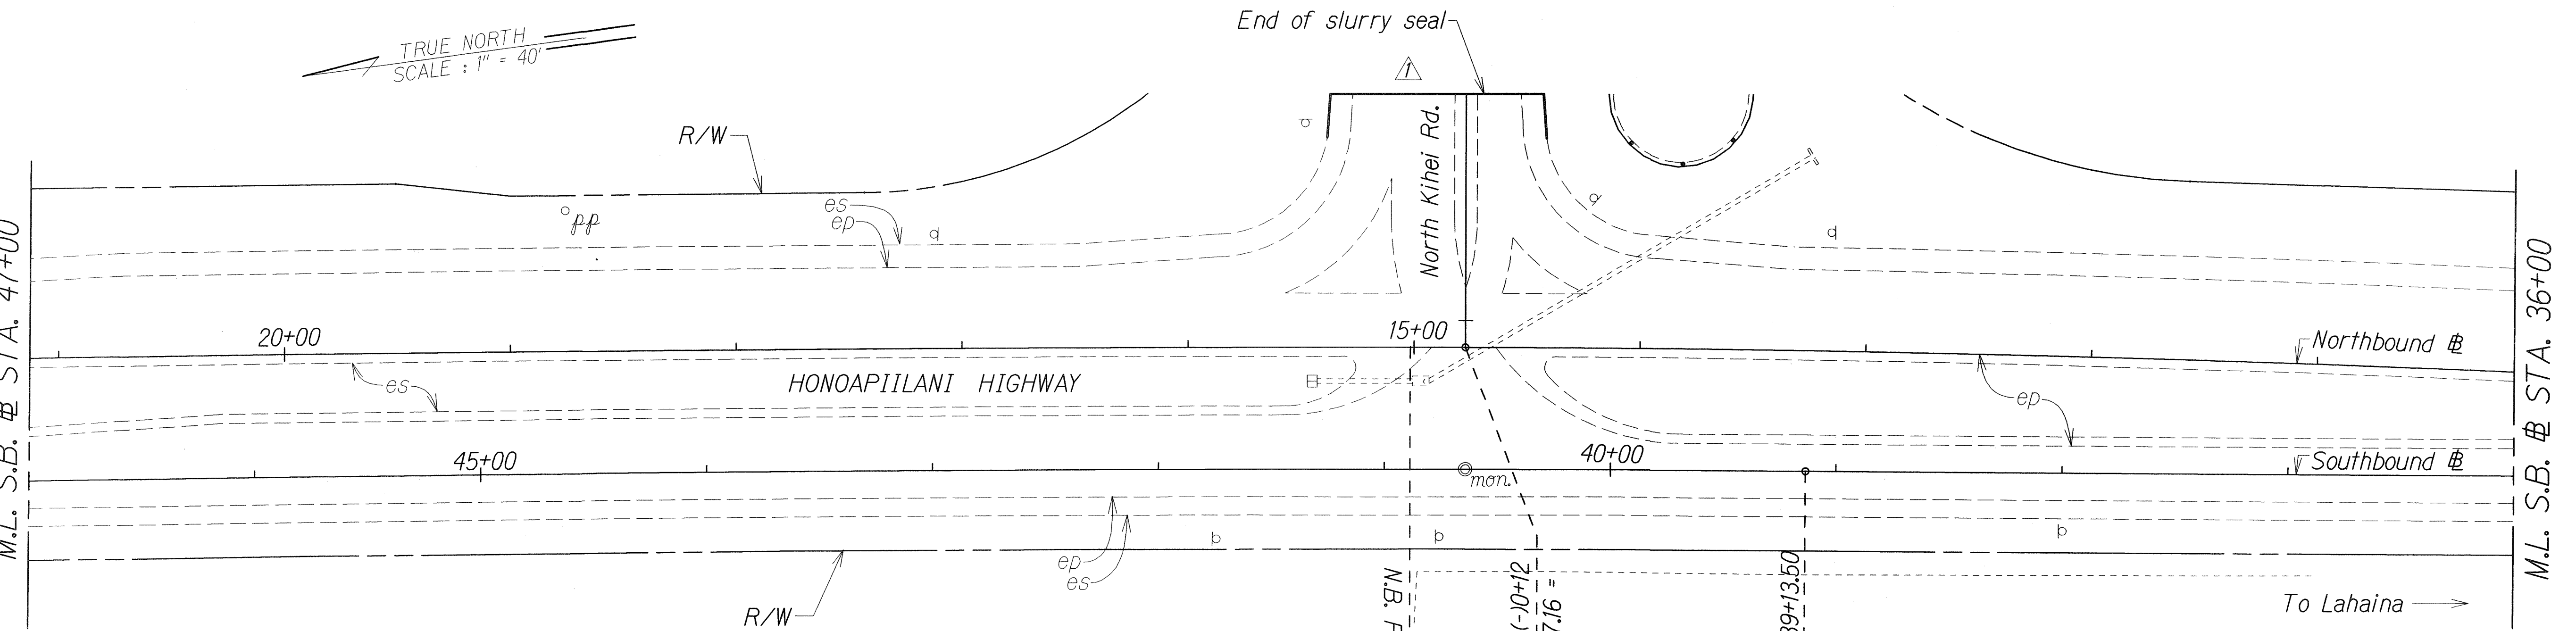

M.L. S.B. # STA. 36+00

DATE	REVISION
2-11-13	Cold planing deleted - Not required for slurry seal.
2-11-13	Added limit of slurry seal.
2-11-13	Added cold planing and note at bridge.

ORIGINAL PLAN	SURVEY PLOTTED BY
NOTE BOOK	DRAWN BY
DESIGNED BY	CHECKED BY
CHECKED BY	


STATE OF HAWAII
DEPARTMENT OF TRANSPORTATION
HIGHWAYS DIVISION

ROADWAY PLAN

KUIHELANI HIGHWAY & HONOAPIILANI HIGHWAY
PAVEMENT PREVENTIVE MAINTENANCE
Puunene Avenue to Honoapiilani Highway
and Kuihelani Highway to Kapoli Street
Federal-Aid Project No. NH-0900(080)
Scale: 1" = 40' Date: May, 2012

SHEET No. 15 OF 18 SHEETS


FED. ROAD DIST. NO.	STATE	FED. AID PROJ. NO.	FISCAL YEAR	SHEET NO.	TOTAL SHEETS
HAWAII	HAW.	NH-0900(080)	2013	24	47

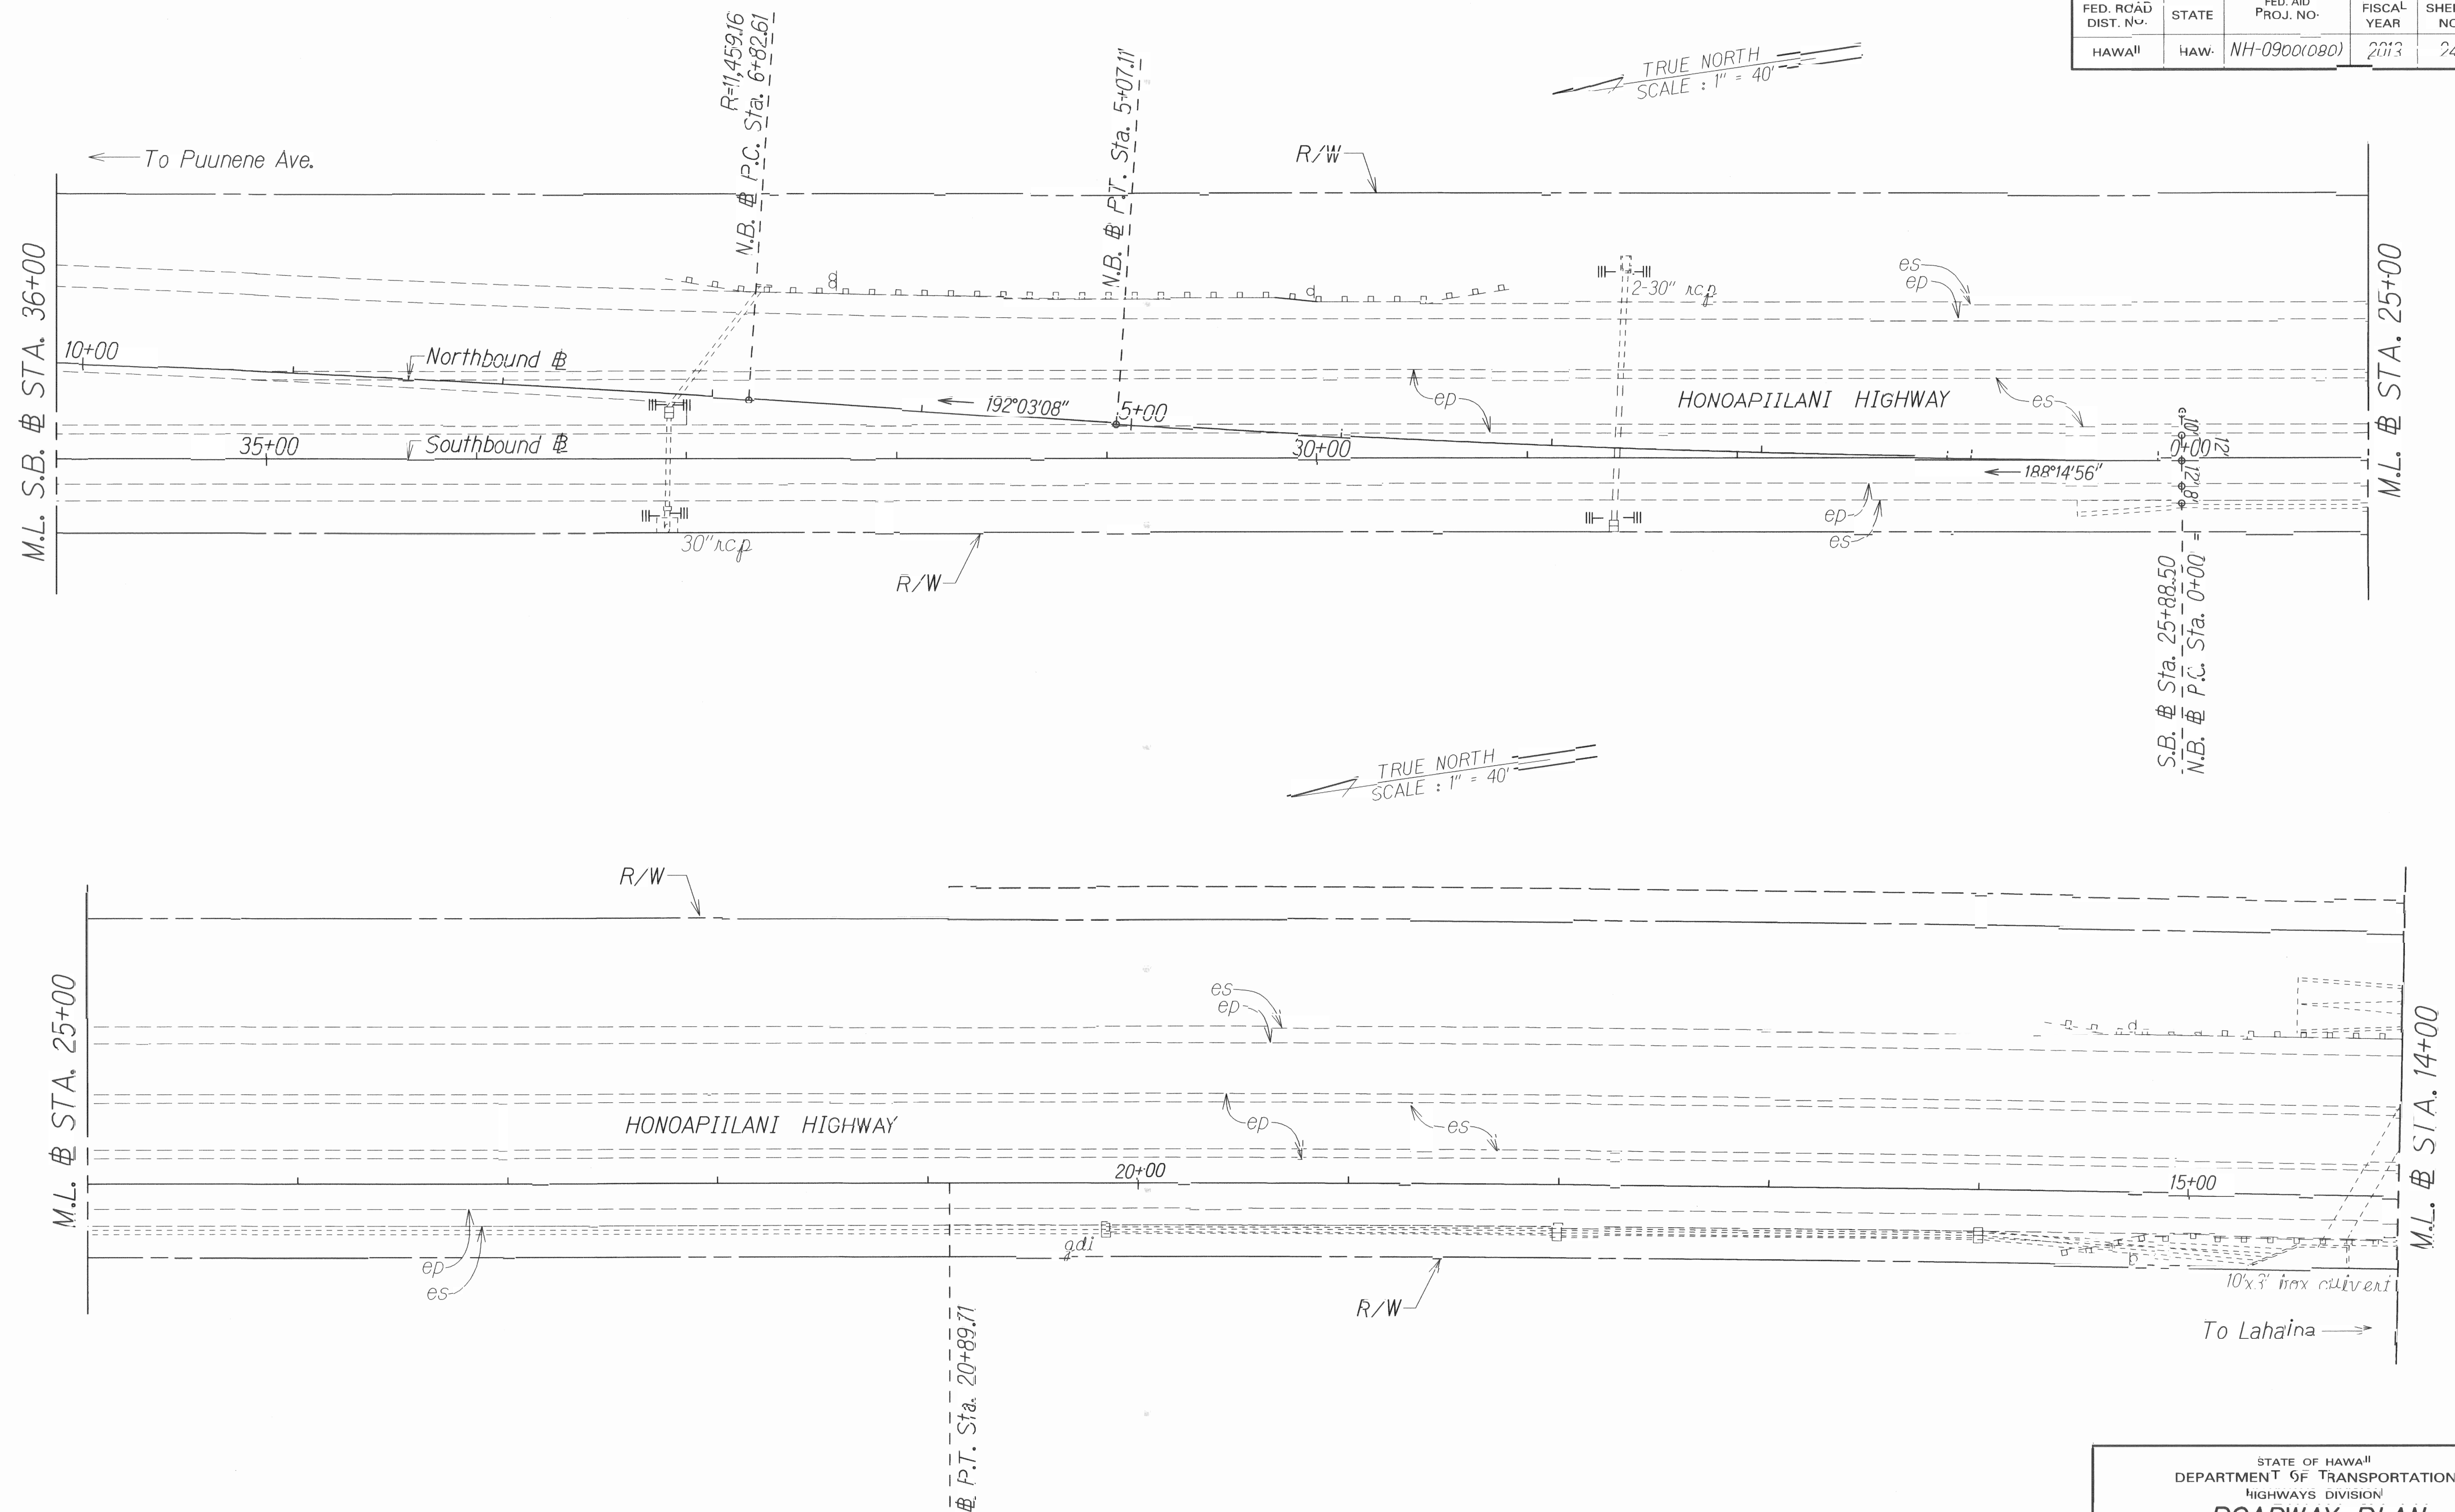

ORIGINAL PLAN	SURVEY PLOTTED BY _____ DATE _____
	DRAWN BY <u>h</u>
	TRACED BY _____
NOTE BOOK	DESIGNED BY <u>Tred G.</u>
<u>mel, lay</u>	QUANTITIES BY _____
<u>slump, b, dgn</u>	CHECKED BY _____

STATE OF HAWAII DEPARTMENT OF TRANSPORTATION HIGHWAYS DIVISION <u>ROADWAY PLAN</u> KUIHELANI HIGHWAY & HONOAPIILANI HIGHWAY PAVEMENT PREVENTIVE MAINTENANCE Puunene Avenue to Honoapiilani Highway and Kuihelani Highway to Kapoli Street Federal-Aid Project No. NH-0900(080) Scale: 1" = 40' Date: May, 2012 SHEET No. 16 OF 18 SHEETS
--

FED. ROAD DIST. NO.	STATE	FED. AID PROJ. NO.	FISCAL YEAR	SHEET NO.	TOTAL SHEETS
HAWAII	HAW.	NH-0900(080)	2013	25	47

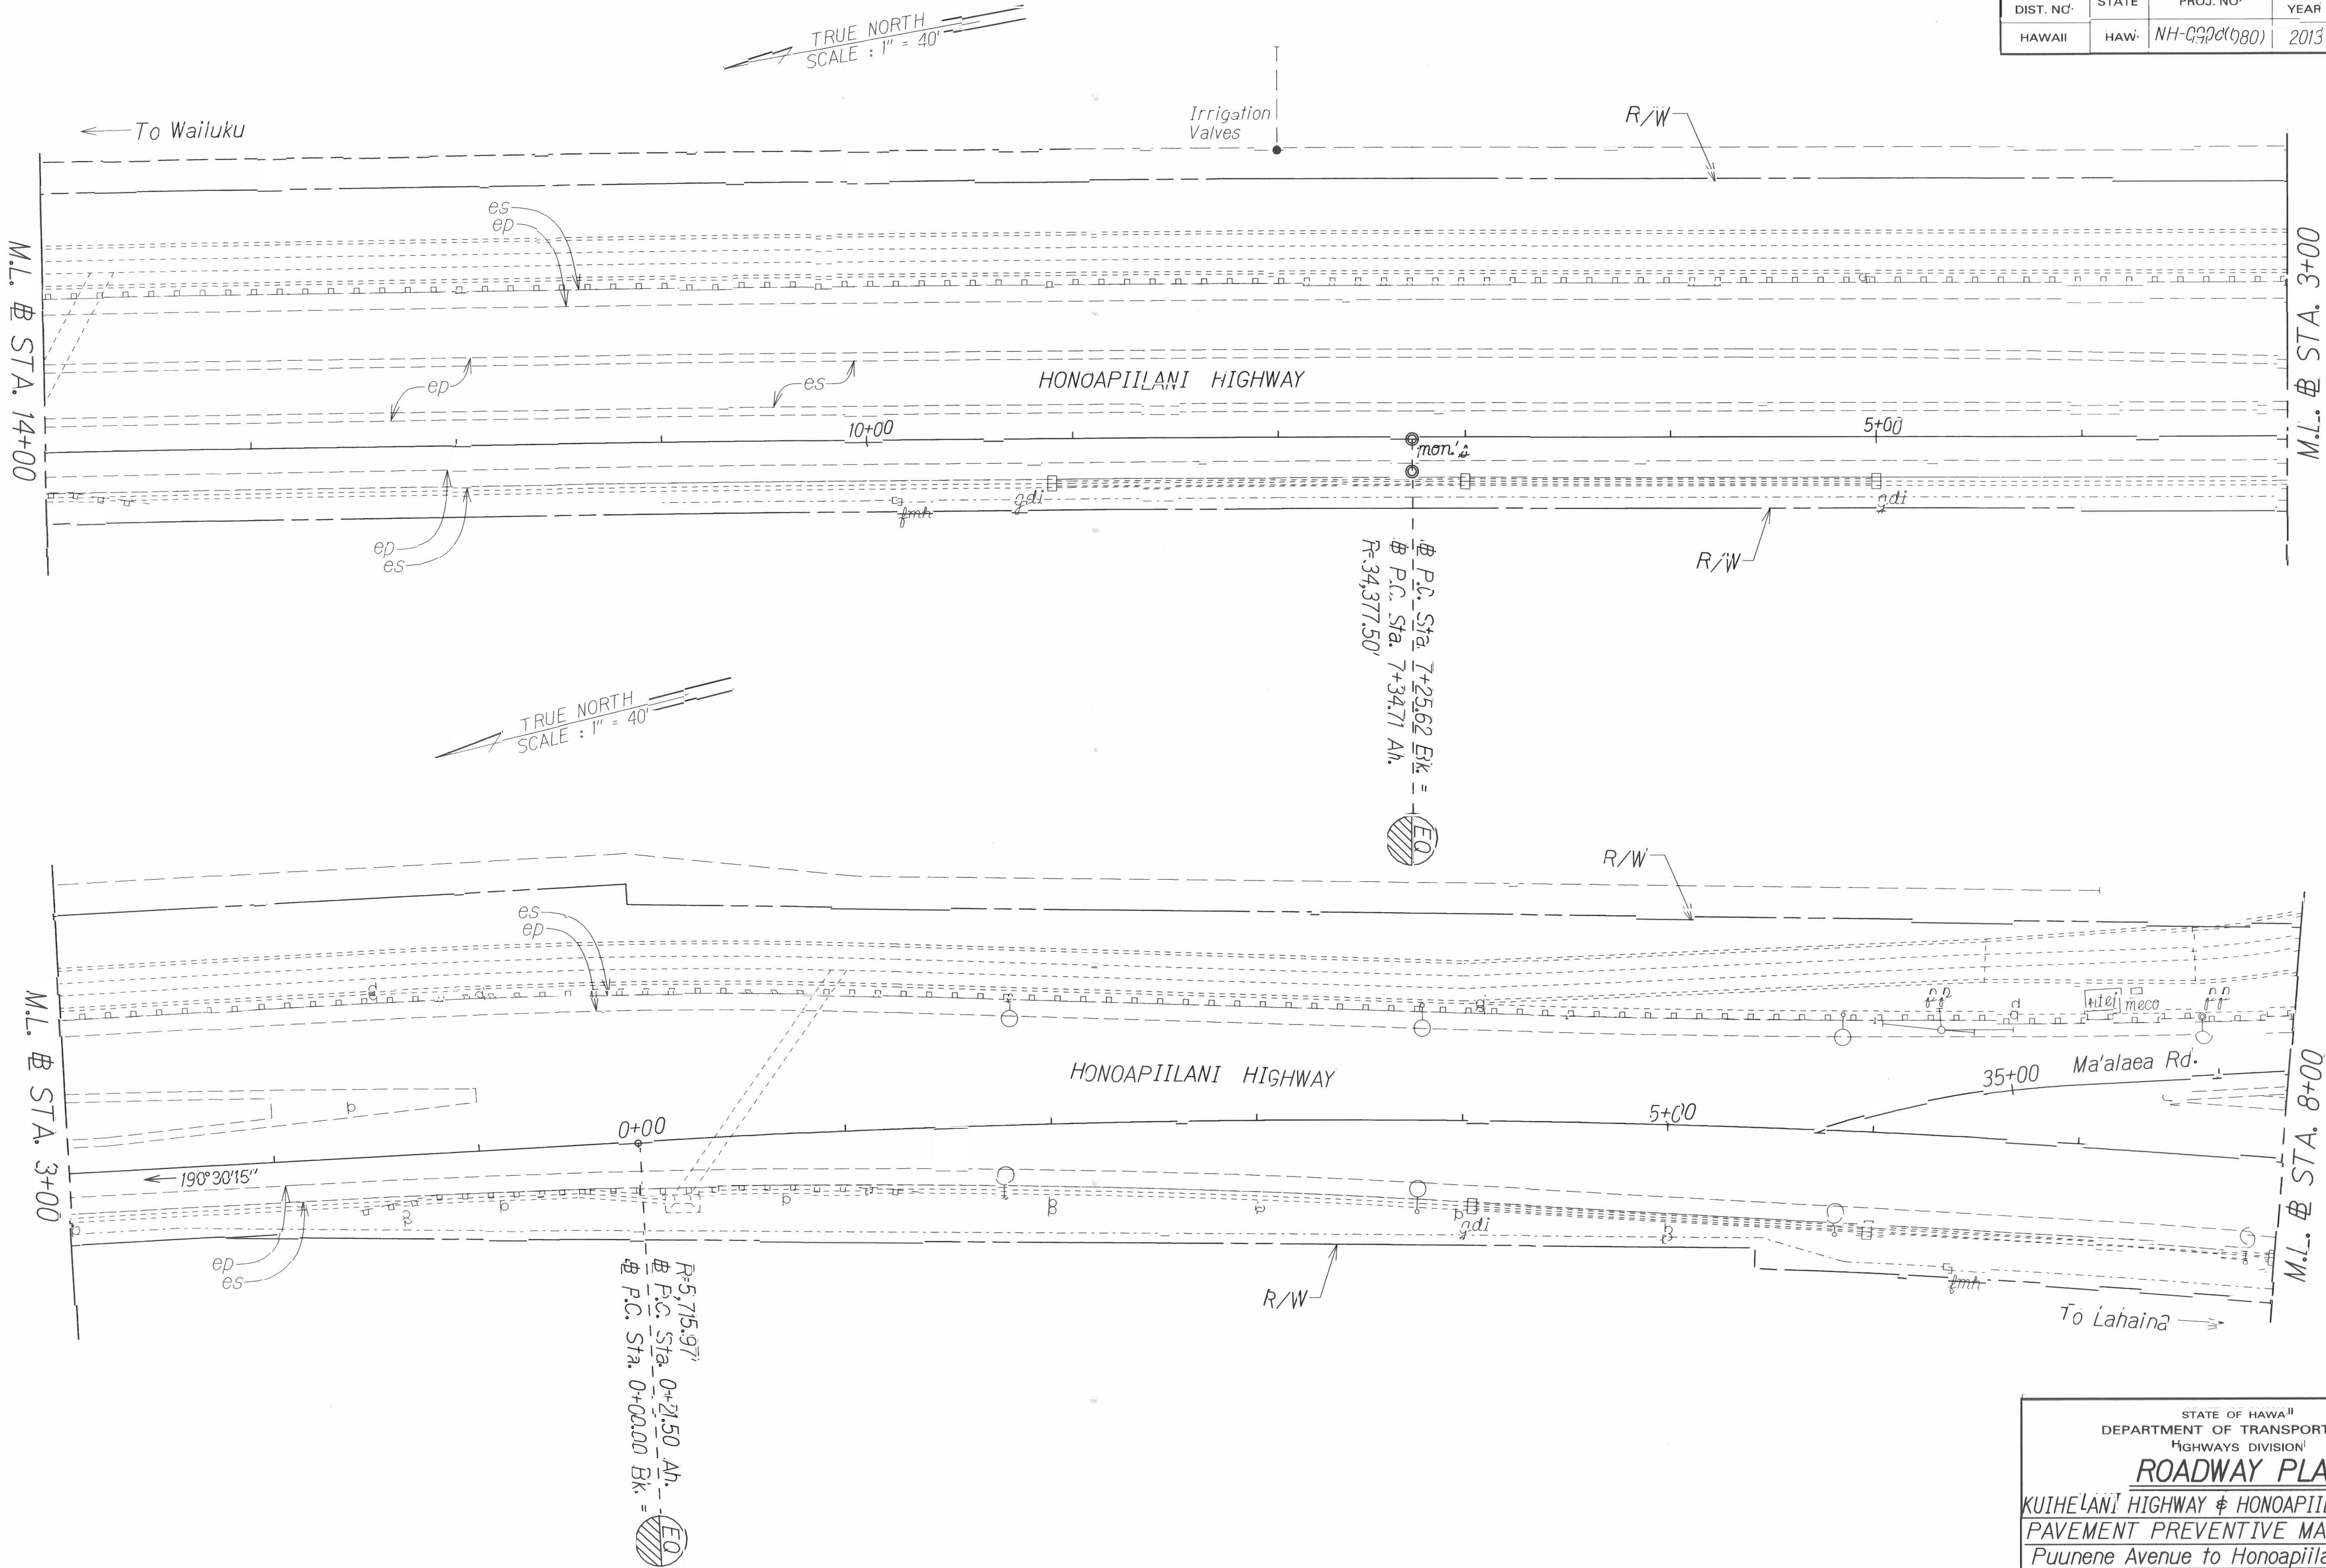


DATE	1/1/12
SURVEY PLOTTED BY	TRP
DESIGNED BY	TRP
TRACED BY	TRP
QUANTITIES BY	TRP
CHECKED BY	TRP
NOTE BOOK	1/1/12
ORIGINAL PLAN	1/1/12

STATE OF HAWAII
DEPARTMENT OF TRANSPORTATION
HIGHWAYS DIVISION

ROADWAY PLAN

KUIHELANI HIGHWAY & HONOAPIILANI HIGHWAY
PAVEMENT PREVENTIVE MAINTENANCE
Puunene Avenue to Honoapiilani Highway
and Kuihelani Highway to Kapoli Street
Federal-Aid Project No. NH-0900(080)
Scale: 1" = 40' Date: May, 2012

FED. ROAD DIST. NO.	STATE	FED. AID PROJ. NO.	FISCAL YEAR	SHEET NO.	TOTAL SHEETS
HAWAII	HAW.	NH-0900(080)	2013	ADD.26	47

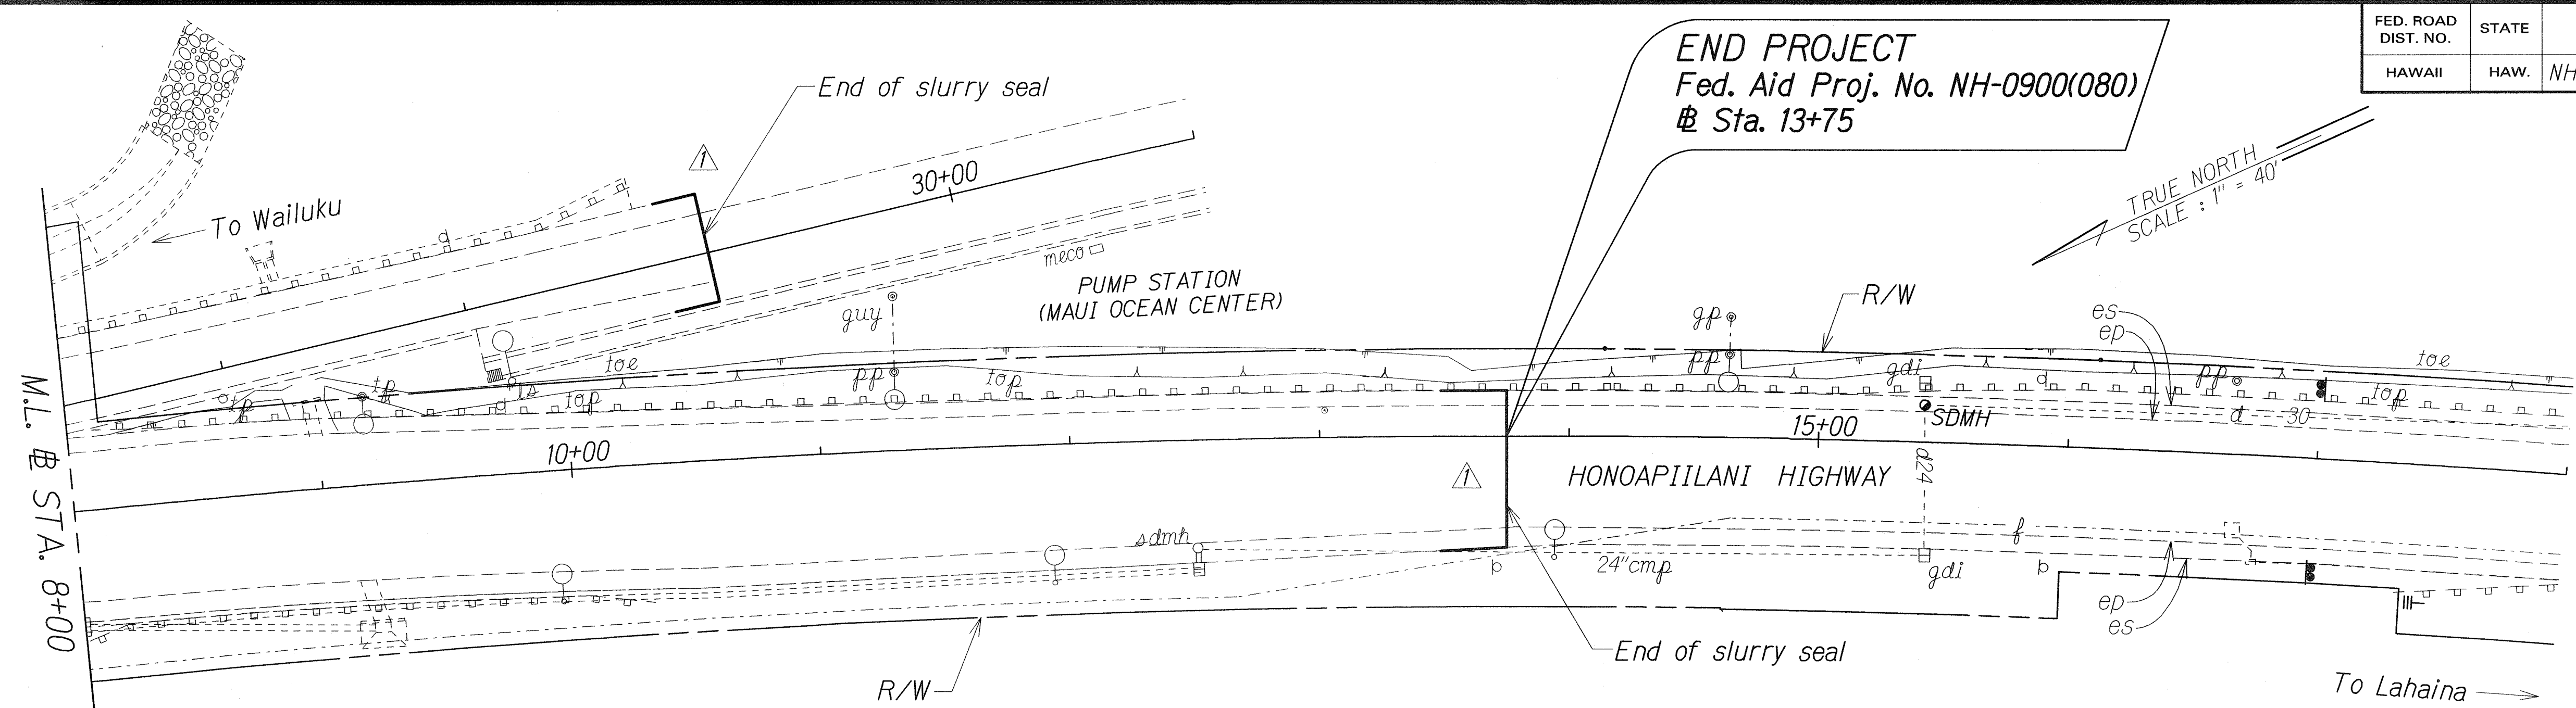

ORIGINAL PLAN	SURVEY PLOTTED BY	DATE
NOTE BOOK	DRAWN BY	1/12
DESIGNED BY	TRACED BY	
CHECKED BY	DESIGNED BY	
	CHECKED BY	

△	2-11-13	Cold planing deleted - Not required for slurry seal.
△	2-11-13	Added limit of slurry seal.
DATE	REVISION	

STATE OF HAWAII DEPARTMENT OF TRANSPORTATION HIGHWAYS DIVISION
ROADWAY PLAN
KUIHELANI HIGHWAY & HONOAPIILANI HIGHWAY PAVEMENT PREVENTIVE MAINTENANCE Puunene Avenue to Honoapiilani Highway and Kuihelani Highway to Kapoli Street Federal-Aid Project No. NH-0900(080) Scale: 1" = 40' Date: May, 2012
SHEET No. 18 OF 18 SHEETS