
LEGEND 4 each Type A Raised Pavement Markers Type C Raised Pavement Markers @ 40'-0" o.c. 4 each Type J Raised Pavement Markers Type D Raised Pavement Markers @ 40'-0" o.c. 8" White Stripe with Type C Raised Pavement Markers @ 20'-0" o.c. (Tape, Type I or Thermoplastic Extrusion) 4" Double Solid Yellow with Type D Raised Pavement Markers @ 20'-0" o.c. (Tape, Type I or Thermoplastic Extrusion)) 4" Double Solid Yellow Stripes with Type H Raised Pavement Markers @ 20'-0" o.c. (Tape, Type II or Thermoplastic Extrusion)) 4" Yellow Edge Stripe with Type H Raised Pavement Markers @ 40'-0" o.c. (Tape, Type II or Thermoplastic Extrusion)) 4" Double Solid White Stripes with Type C Raised Pavement Markers @ 20'-0" o.c. (Tape, Type I or Thermoplastic Extrusion) Lane Change Restriction Marking 4 each Type A Raised Pavement Markers Type C Raised Pavement Markers @ 20'-0" o.c. 4" White Stripe (Tape, Type I or Thermoplastic Extrusion) 4" or 8" White Edge Stripe with Type C Raised Pavement Markers @ 40'-0" o.c. (Tape, Type II or Thermoplastic Extrusion) 4" White Guide Lines (Tape, Type III or Thermoplastic Extrusion except for bus bays) Transverse Median Marking (Tape, Type II or Thermoplastic Extrusion) Transverse Shoulder Marking (Tape, Type II or Thermoplastic Extrusion) Channelizing Island or Deceleration Lane Gore (Tape, Type II or Thermoplastic Extrusion) Crosswalk and Stop Line. All Stop Lines shall be 10'-0" from Crosswalk unless otherwise noted. The circled number indicates the number of lanes for payment (Tape, Type III or Thermoplastic Extrusion) Pavement Arrow (Tape, Type III or Thermoplastic Extrusion) Pavement Word (Tape, Type III or Thermoplastic STOP Extrusion) 4 Each Type J Raised Pavement Markers Type D Raised Pavement Markers @ 40'-0" o.c. Type H Raised Pavement Markers (Reflective Surface facing no-passing direction) 4" Single Solid Yellow Stripe (Tape, Type I or Thermoplastic Extrusion) Extension of Edge Line, 4" Wide x 2'-0" Long White 10' 10' 10' 10' Stripe @ 10'-0" o.c. w/Type C Markers @ 40'-0" o.c. (Tape, Type III or Thermoplastic Extrusion)


SURVEY PLOTTE
DRAWN BY X
TRACED BY
DESIGNED BY FIT
QUANTITIES BY
CHECKED BY

NOTES

- 1. Layout of pavement markings and striping shall be done by the Contractor and approved by the Engineer prior to any installation work.
- 2. Existing pavement markings not incorporated in the final traffic pattern shall be removed as directed by the Engineer. Costs shall be incidental to the various pavement marking items.
- 3. Final locations of all signs shall be approved by the Engineer prior to any installation work.
- 4. Existing signs not shown on these plans shall remain as posted unless otherwise directed by the Engineer. Removal and disposal of existing signs and/or posts as designated on these plans shall be incidental to the various signing items.
- 5. Final locations of all Stop Lines shall be approved by the Engineer prior to installation.
- 6. All pavement striping shall be as noted on the legend or plans.
- 7. All preformed pavement marking tapes over existing pavement shall be applied with an approved primer as recommended by the tape manufacturer and as approved by the Engineer. The primer shall be allowed to dry to the tacky stage prior to tape application.

Shoulder / & Milled Rumble Strip

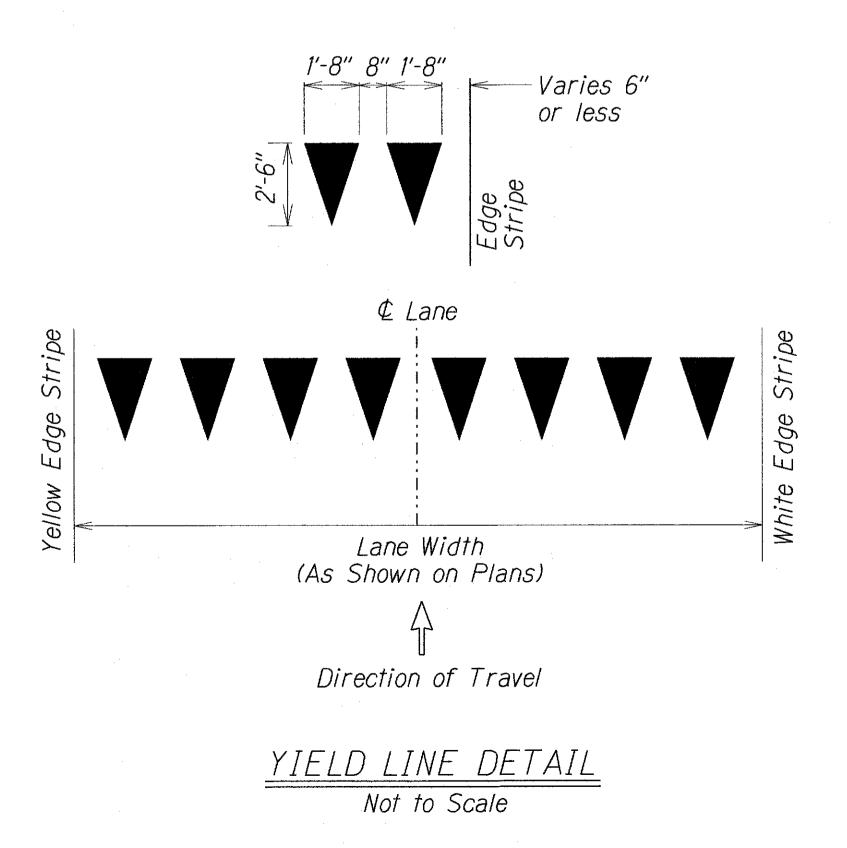

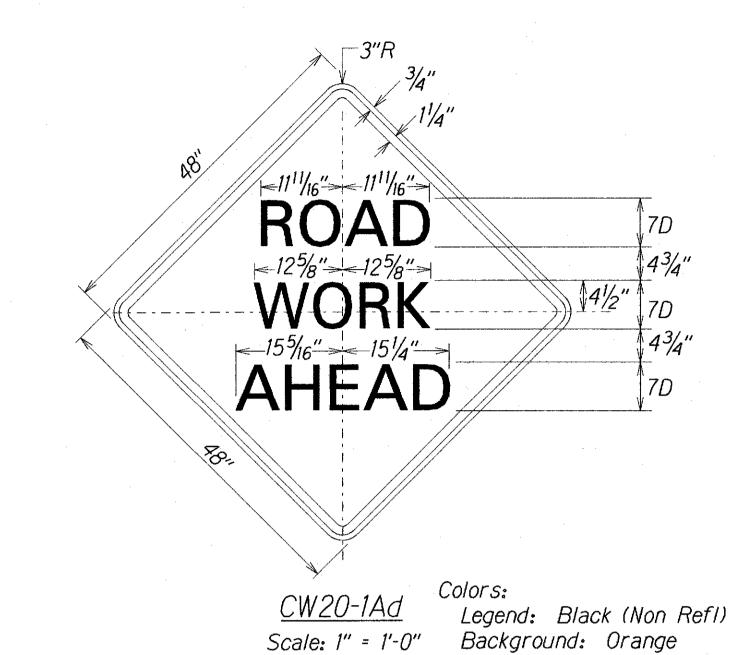

FED. ROAD


DIST. NO.

FISCAL SHEET

25

YEAR

HAW. HWY-M-01-15M 2015

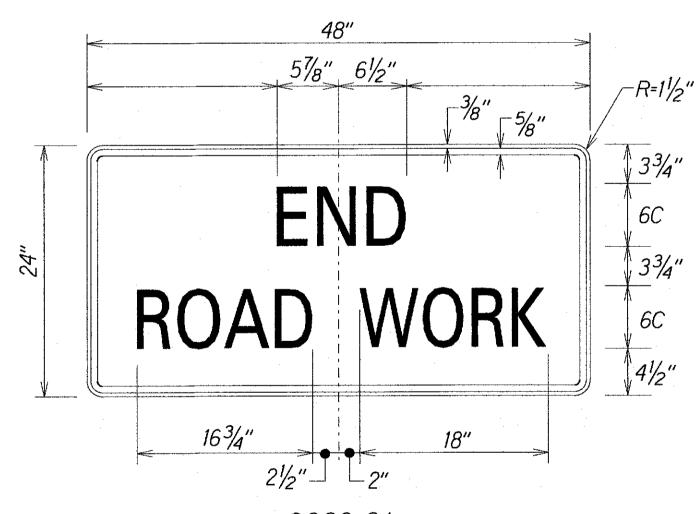

<u>CG20-2A</u> Scale: 1½" = 1'-0"

Legend: Black (Non Refl)
Background: Orange (Relf)

LEGEND FOR AS-BUILT POSTINGS

100.00

Squiggly line for as-built deletion Double line for as-built deletion

Roadway Tex

as-built deletion

Text for as-built

posting

DETAILS, NOTES \$ SIGN PANEL LAYOUT

HANA HWY. RESURFACING, Haleakala Hwy. to Paia and HALEAKALA HIGHWAY RESURFACING Hana Highway to North Firebreak Rd. Project No. HWY-M-01-15M

Scale: As Noted

As Noted Date: March, 2015
SHEET No. 1 OF 1 SHEETS

"AS-BUILT"