
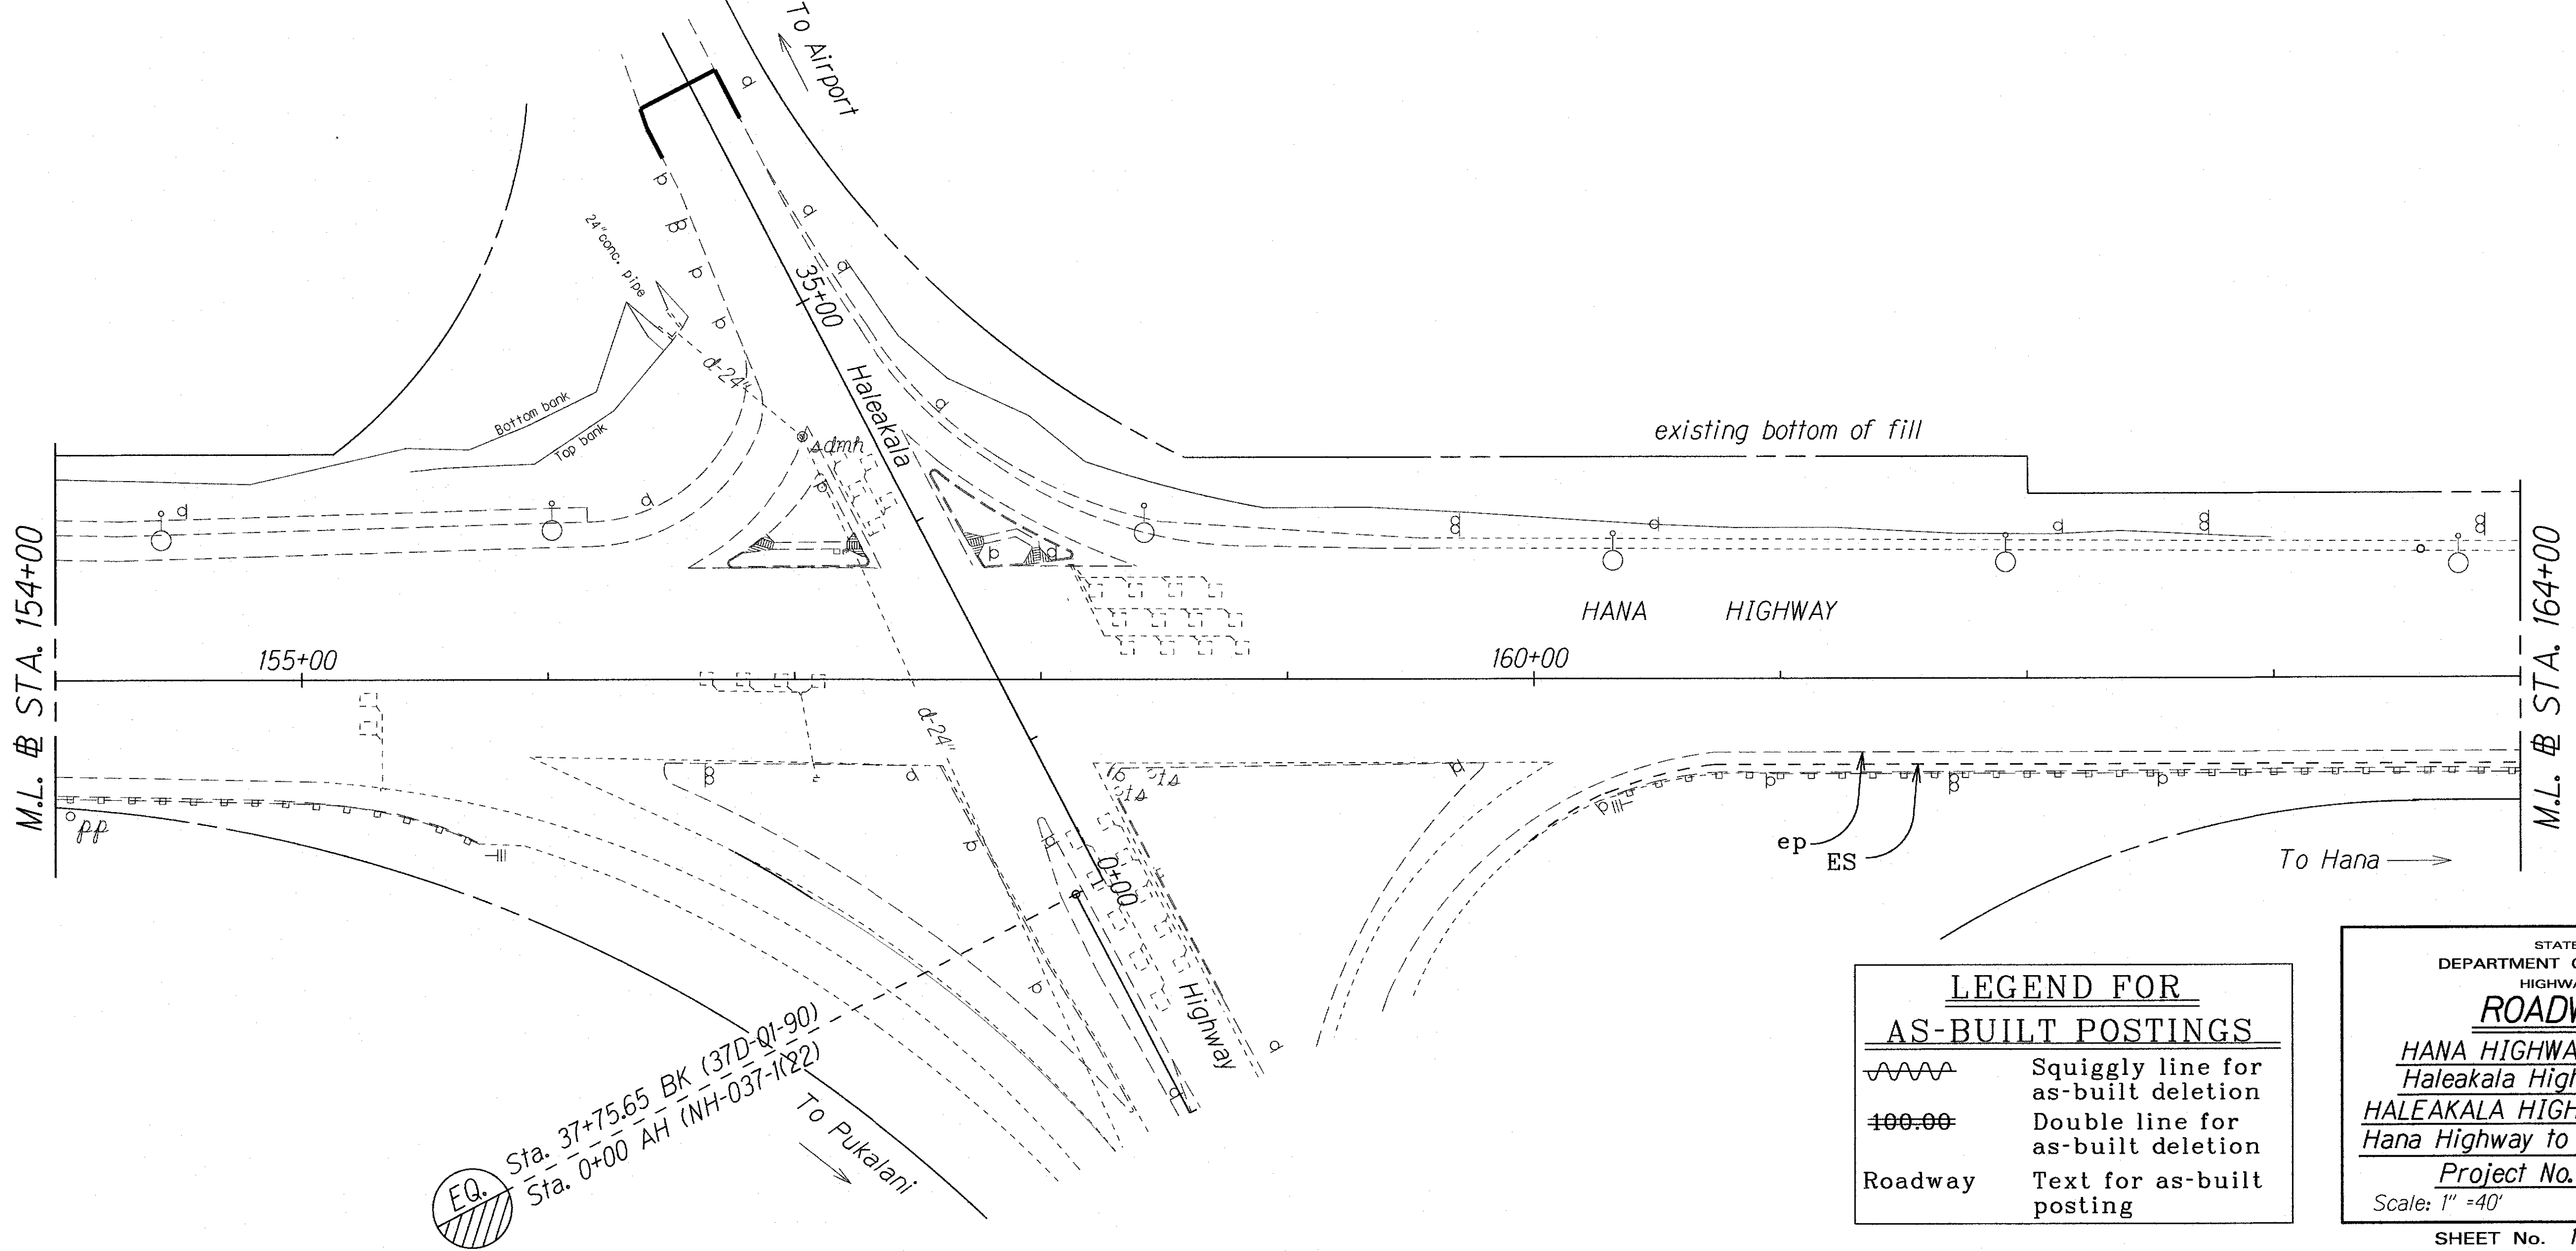


FED. ROAD DIST. NO.	STATE	PROJ. NO.	FISCAL YEAR	SHEET NO.	TOTAL SHEETS
HAWAII	HAW.	HWY-M-01-15M	2015	12	41

BEGIN PROJECT
Project No. HWY-M-01-15M
Sta. 151+00

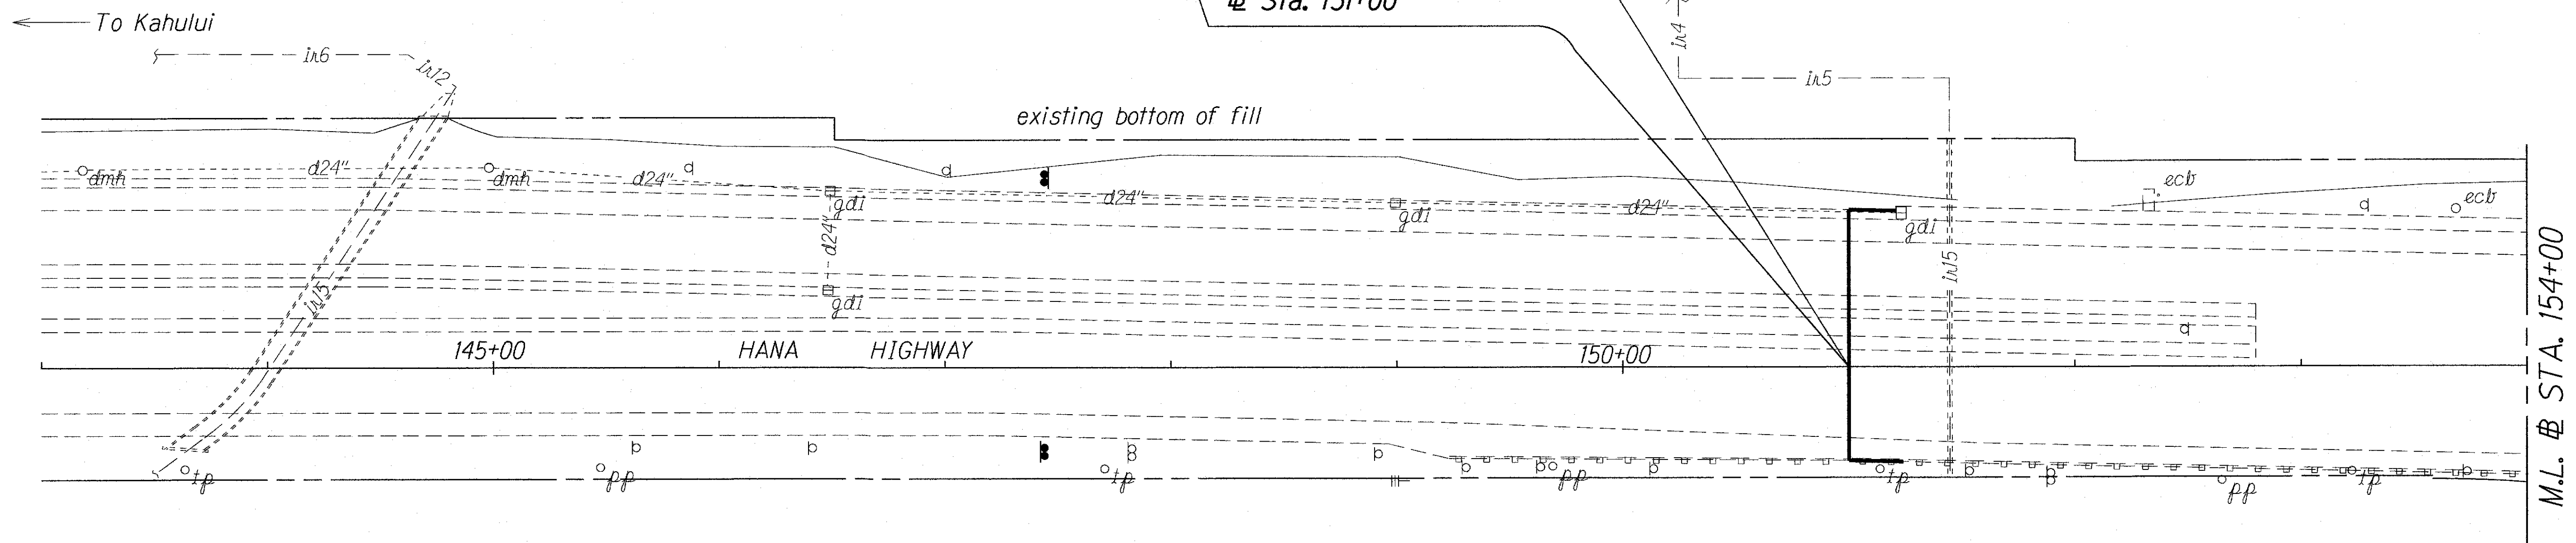

Sta. 37+75.65 BK (37D-01-90)
Sta. 0+00 AH (NH-037-1(22))

LEGEND FOR AS-BUILT POSTINGS	
	Squiggly line for as-built deletion
	Double line for as-built deletion
Roadway	Text for as-built posting

STATE OF HAWAII
DEPARTMENT OF TRANSPORTATION
HIGHWAYS DIVISION

ROADWAY PLAN

HANA HIGHWAY RESURFACING
Haleakala Highway to Paia and
HALEAKALA HIGHWAY RESURFACING
Hana Highway to North Firebreak Rd.


Project No. HWY-M-01-15M
Scale: 1" = 40' Date: March, 2015

SHEET No. 1 OF 13 SHEETS

ORIGINAL PLAN	DATE
DESIGNED BY	
TRACED BY	
NOTE BOOK	
QUANTITIES BY	
CHECKED BY	

"AS-BUILT"

FED. ROAD DIST. NO.	STATE	PROJ. NO.	FISCAL YEAR	SHEET NO.	TOTAL SHEETS
HAWAII	HAW.	HWY-M-01-15M	2015	13	41

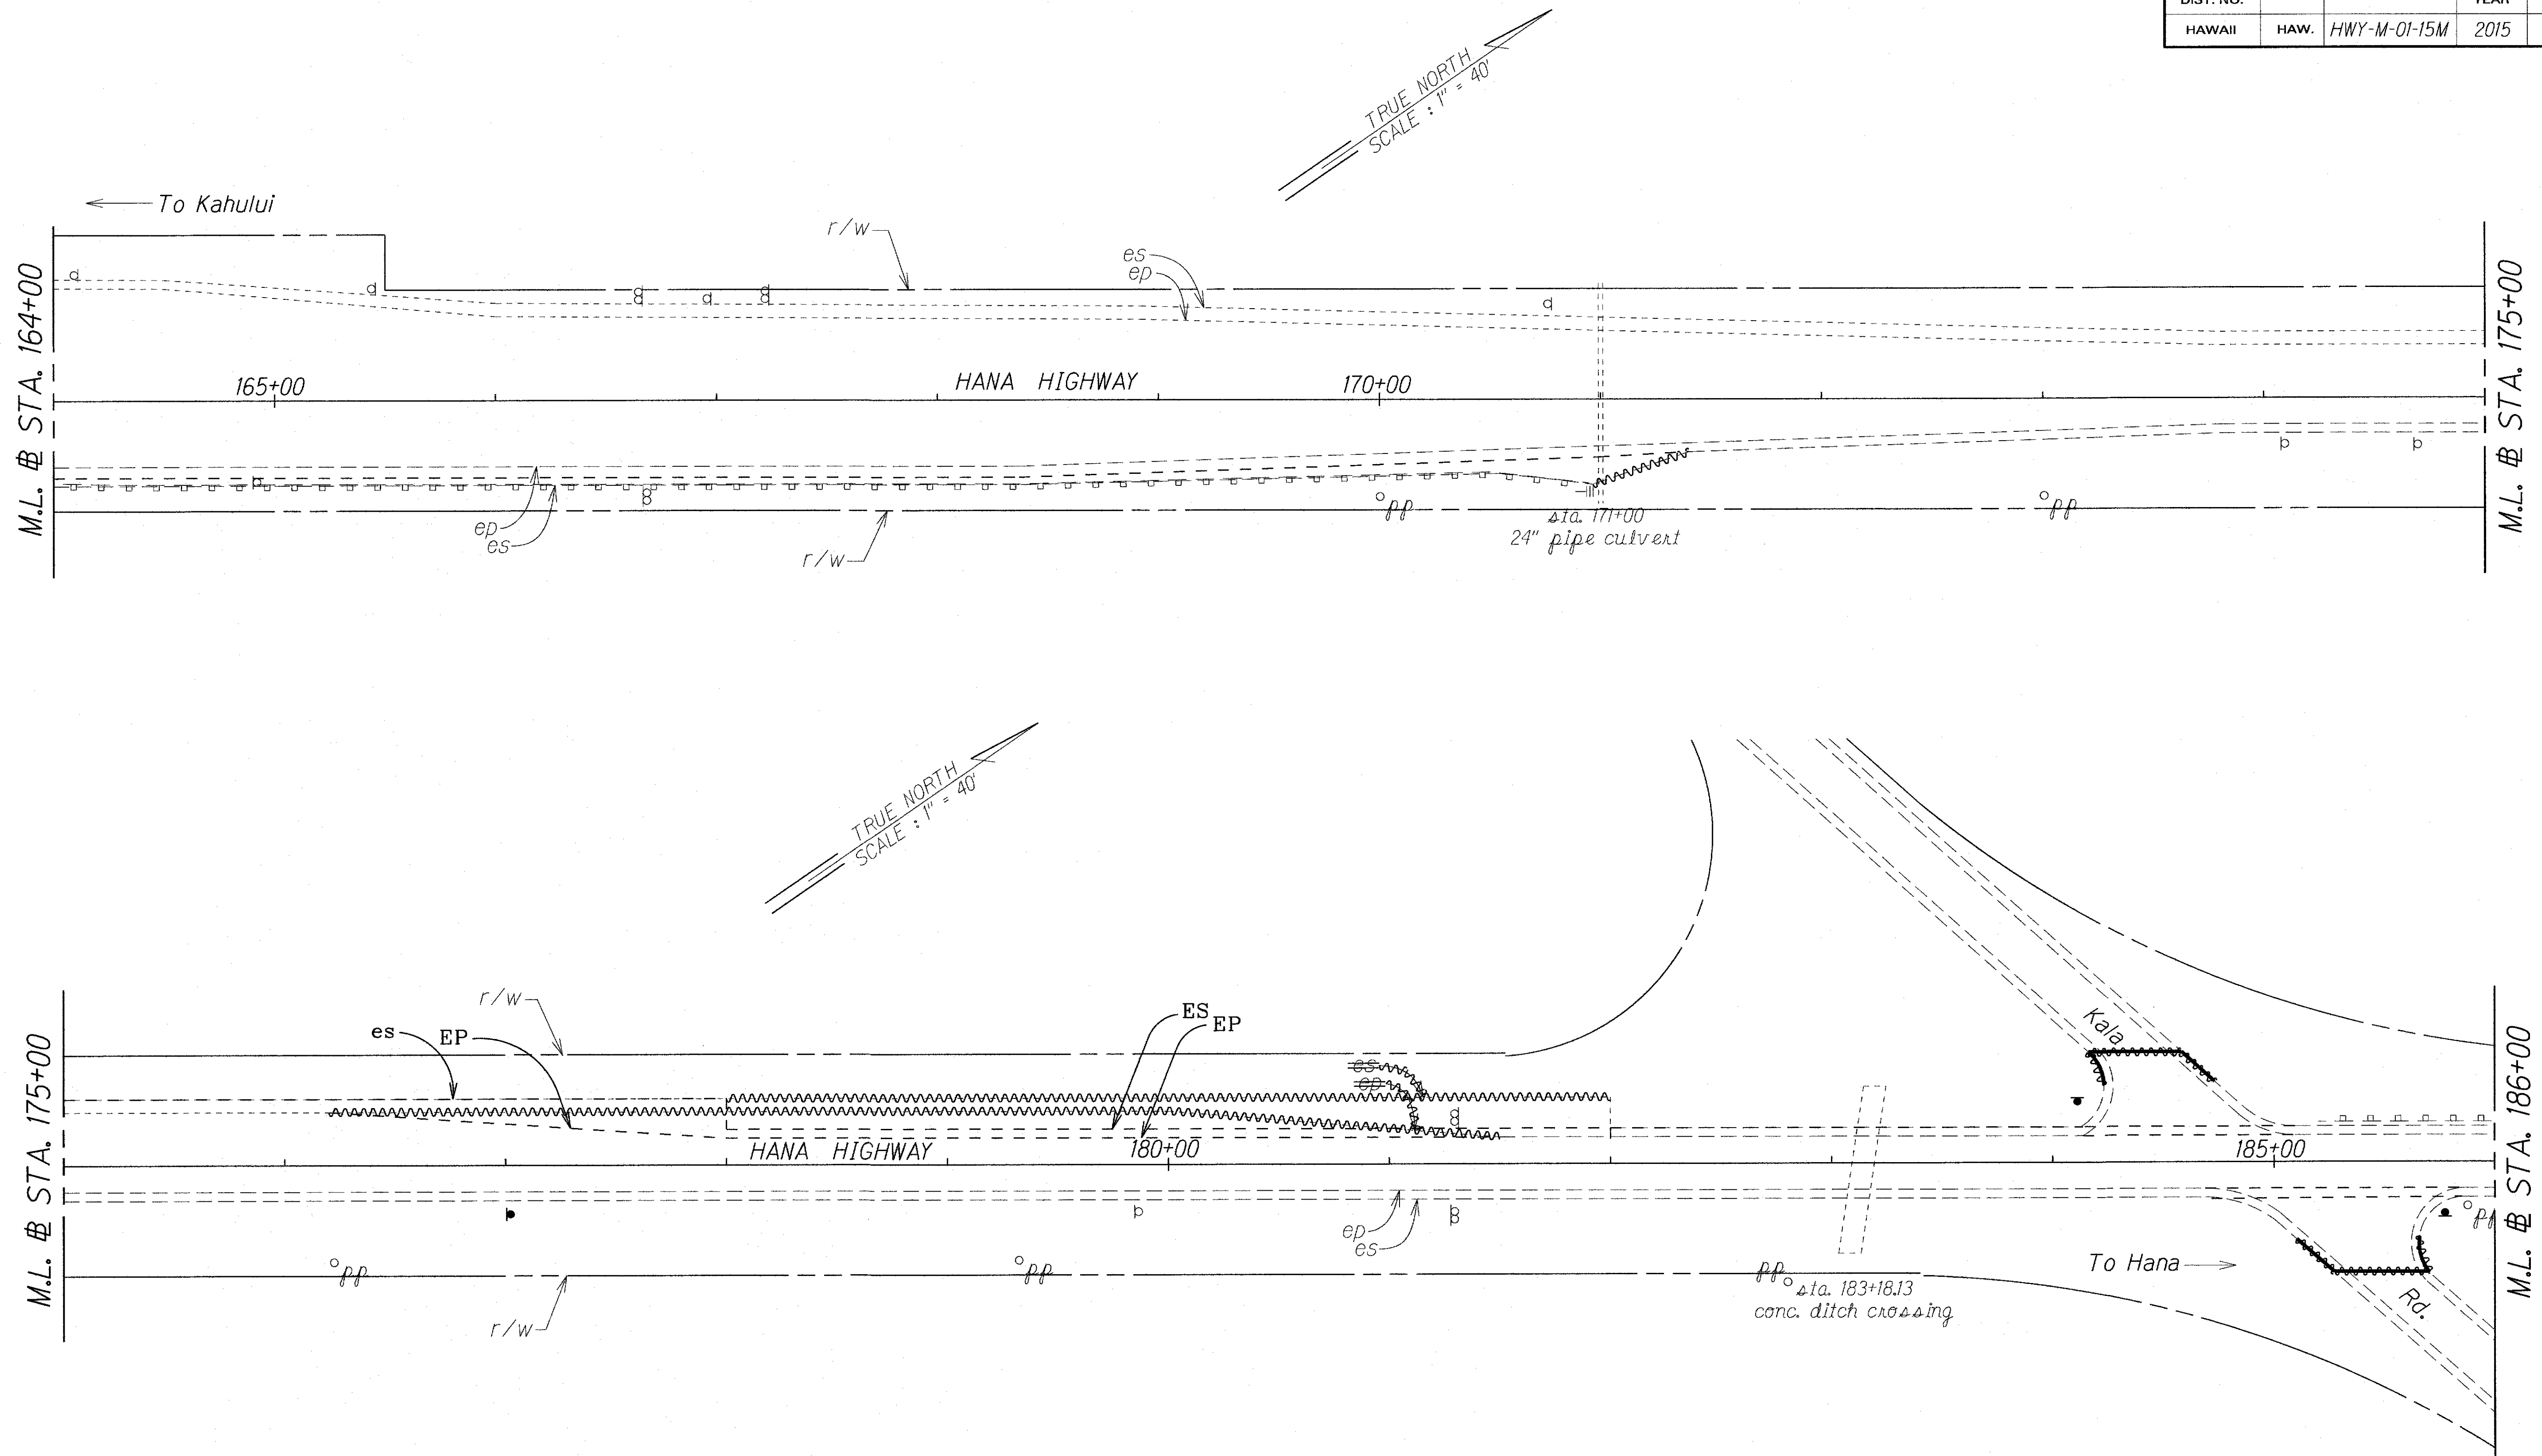


ORIGINAL PLAN	SURVEY PLOTTED BY	DATE
NOTE BOOK	DRAWN BY	12/03
DESIGNED BY	CHECKED BY	
QUANTITIES BY		
CHECKED BY		

LEGEND FOR AS-BUILT POSTINGS	
	Squiggly line for as-built deletion
	Double line for as-built deletion
Roadway	Text for as-built posting

STATE OF HAWAII DEPARTMENT OF TRANSPORTATION HIGHWAYS DIVISION	
ROADWAY PLAN	
HANA HIGHWAY RESURFACING Haleakala Highway to Paia and HALEAKALA HIGHWAY RESURFACING Hana Highway to North Firebreak Rd.	
Project No. HWY-M-01-15M	
Scale: 1" = 40'	Date: March, 2015
SHEET No. 2 OF 13 SHEETS	

"AS-BUILT"

FED. ROAD DIST. NO.	STATE	PROJ. NO.	FISCAL YEAR	SHEET NO.	TOTAL SHEETS
HAWAII	HAW.	HWY-M-01-15M	2015	14	41

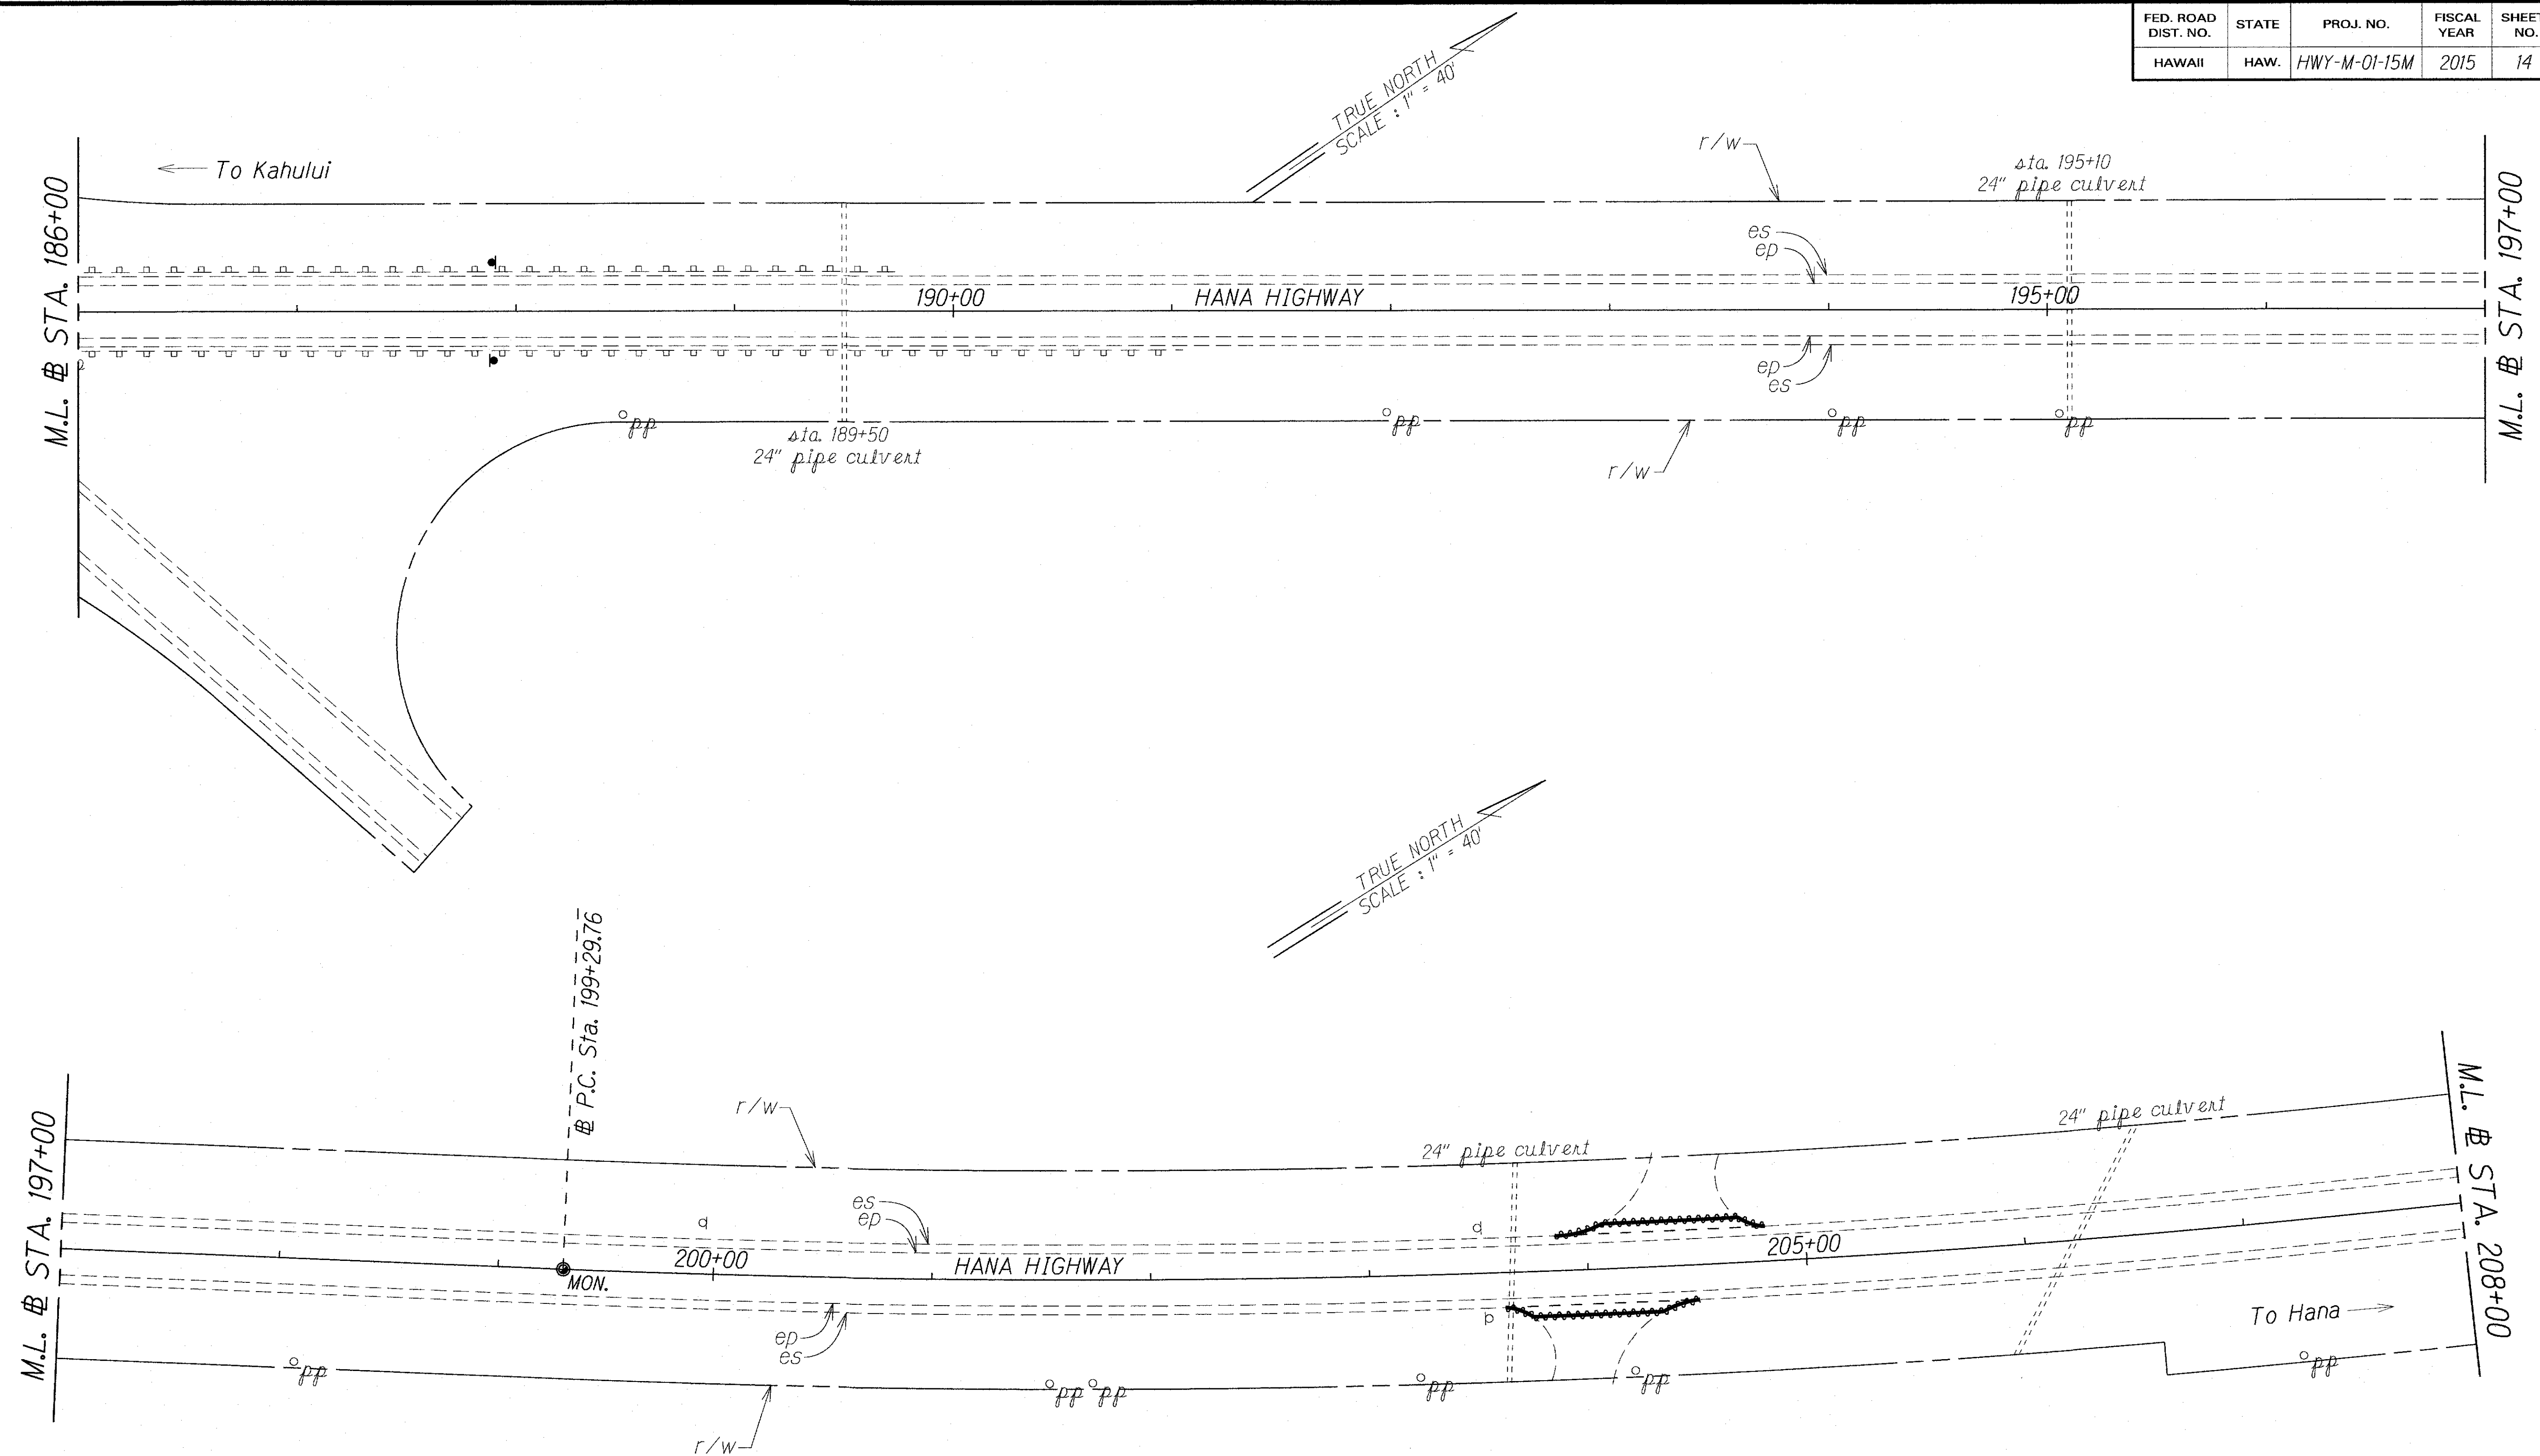

ORIGINAL PLAN	SURVEY PLOTTED BY	DATE
NOTE BOOK	DRAWN BY	12/13
logins, jay	TRACED BY	
Stamm, jay	CHECKED BY	

LEGEND FOR AS-BUILT POSTINGS	
	Squiggly line for as-built deletion
	Double line for as-built deletion
Roadway	Text for as-built posting

STATE OF HAWAII
DEPARTMENT OF TRANSPORTATION
HIGHWAYS DIVISION

ROADWAY PLAN


*HANA HIGHWAY RESURFACING
Haleakala Highway to Paia and
HALEAKALA HIGHWAY RESURFACING
Hana Highway to North Firebreak Rd.*

Project No. HWY-M-01-15M
Scale: 1" = 40' Date: March, 2015

SHEET No. 3 OF 13 SHEETS

"AS-BUILT"

FED. ROAD DIST. NO.	STATE	PROJ. NO.	FISCAL YEAR	SHEET NO.	TOTAL SHEETS
HAWAII	HAW.	HWY-M-01-15M	2015	15	41

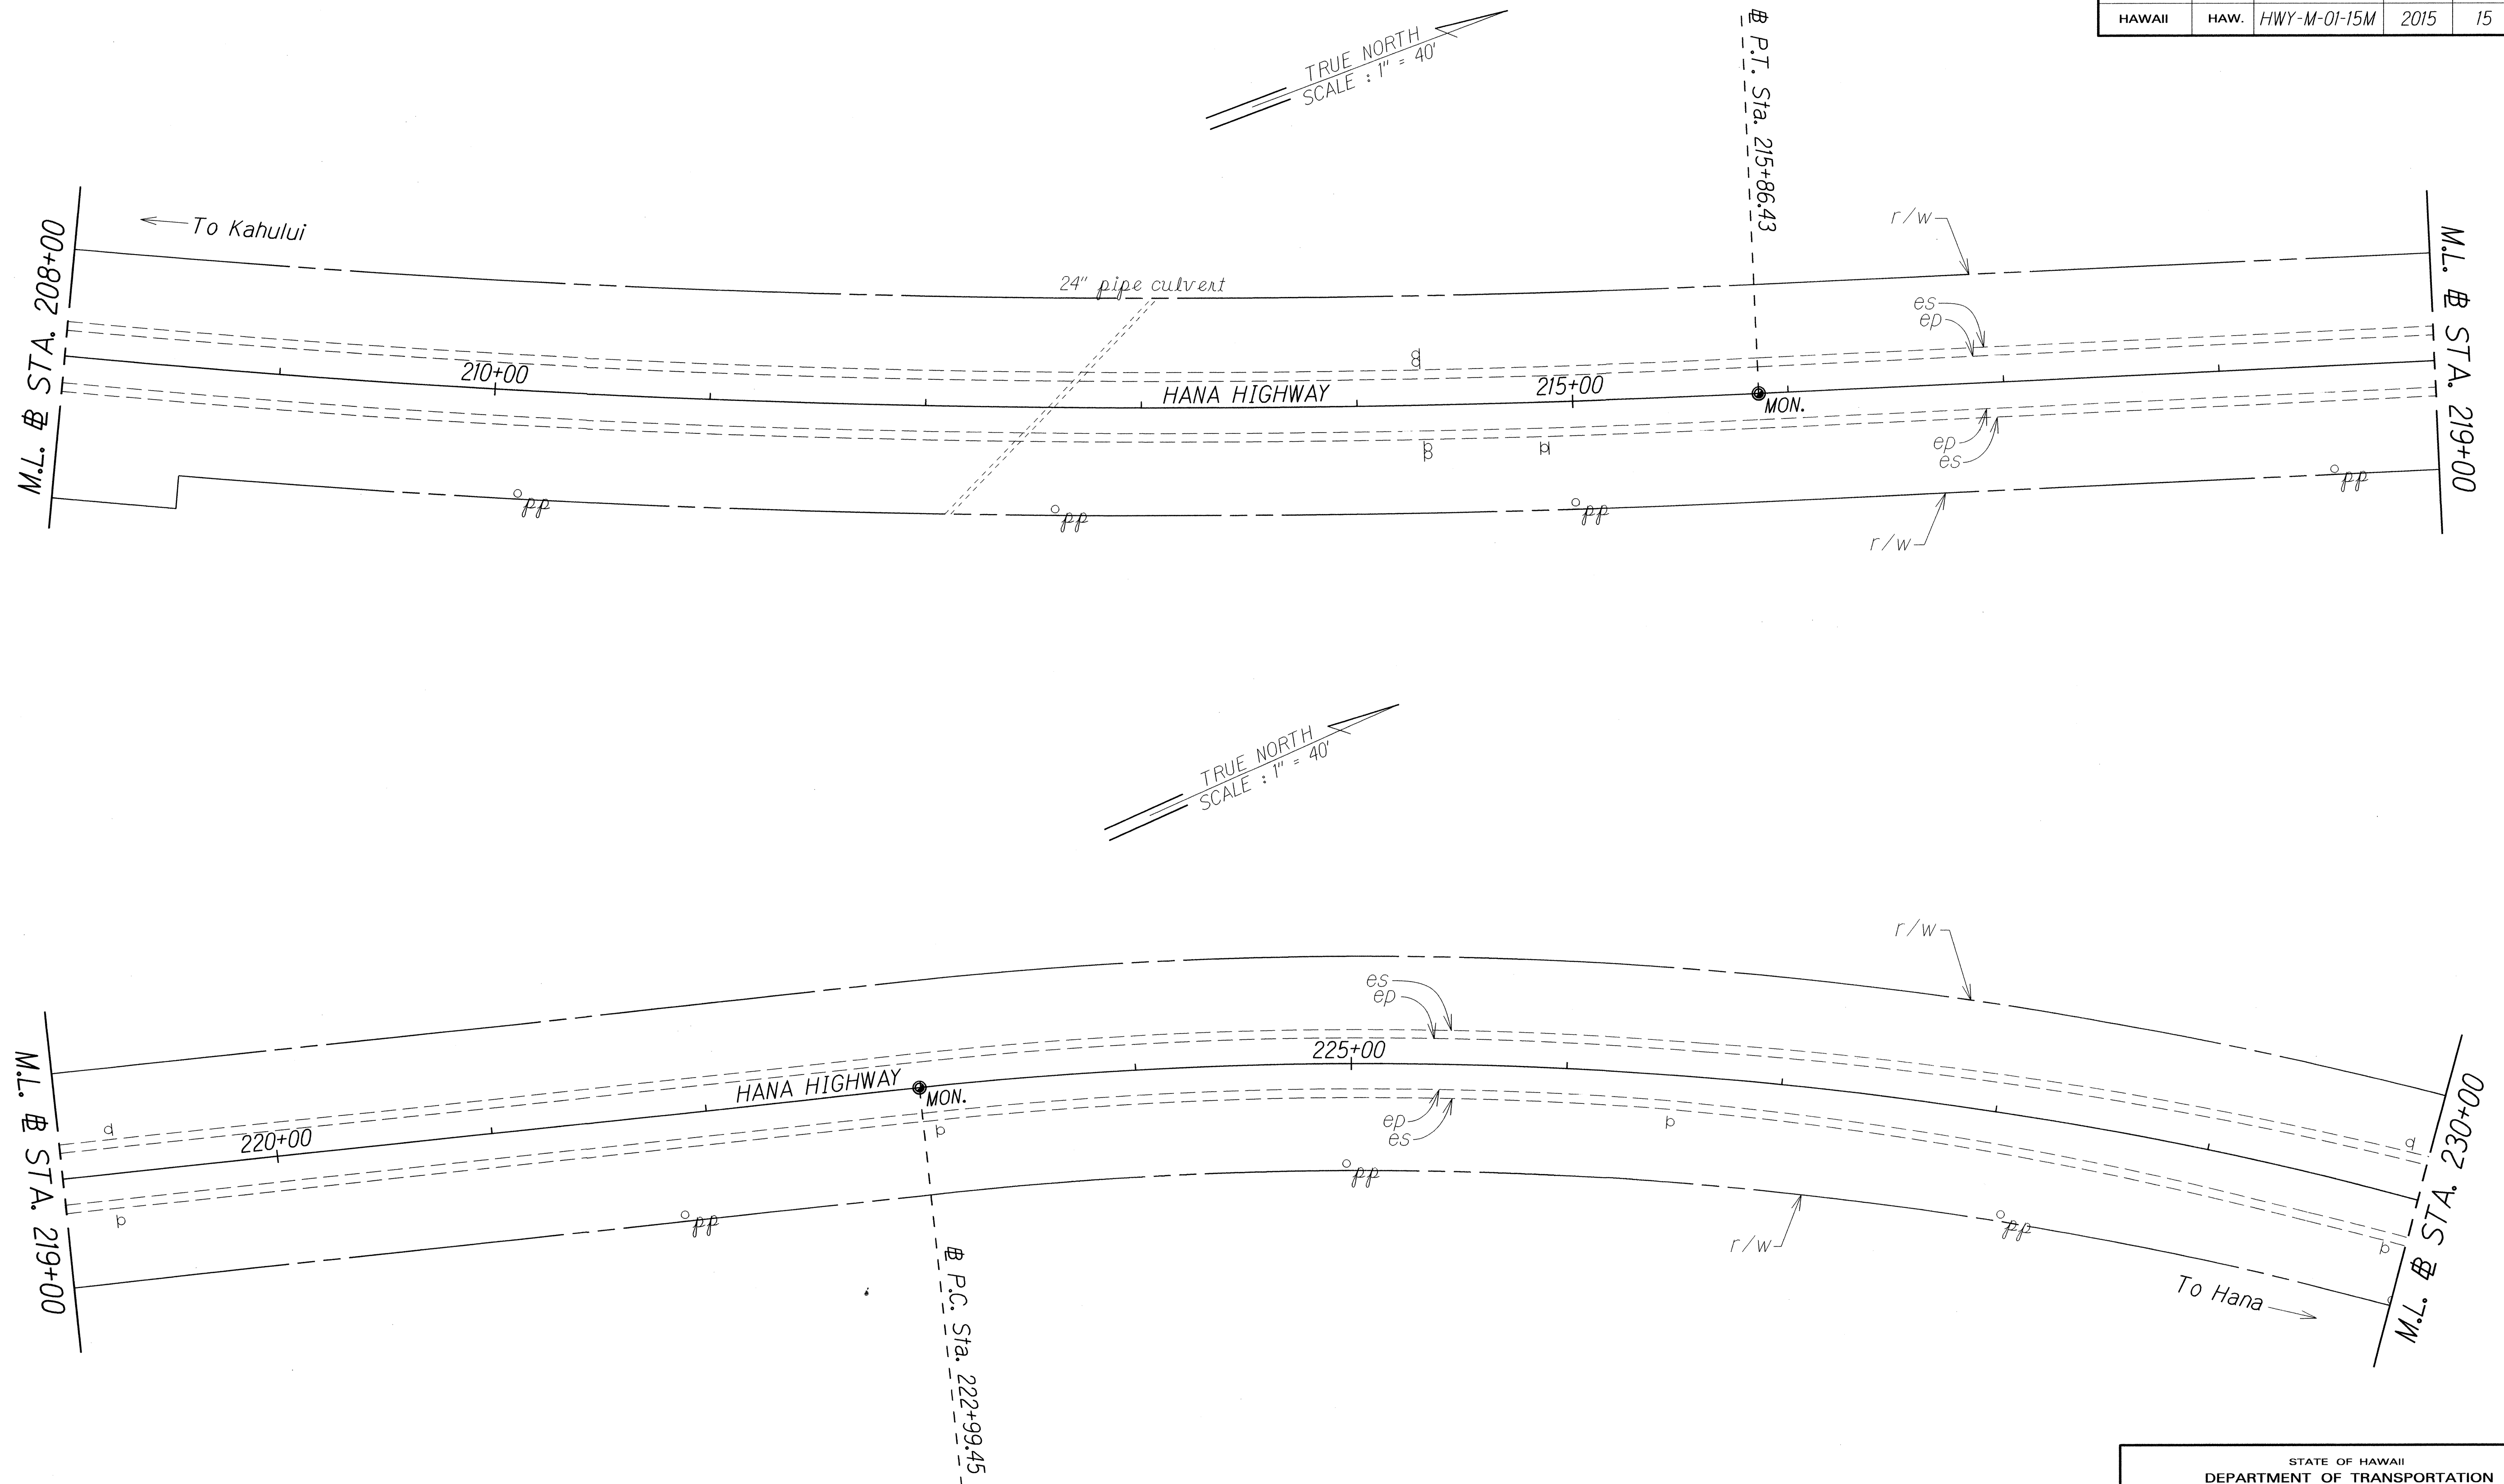

DATE	12/02
SURVEY PLOTTED BY	
DRAWN BY	JP
DESIGNED BY	JP
CHECKED BY	JP
ORIGINAL PLAN	10/15/15

STATE OF HAWAII
DEPARTMENT OF TRANSPORTATION
HIGHWAYS DIVISION


ROADWAY PLAN

HANA HIGHWAY RESURFACING
Haleakala Highway to Paia and
HALEAKALA HIGHWAY RESURFACING
Hana Highway to North Firebreak Rd.

Project No. HWY-M-01-15M
Scale: 1" = 40' Date: March, 2015

SHEET No. 4 OF 13 SHEETS

FED. ROAD DIST. NO.	STATE	PROJ. NO.	FISCAL YEAR	SHEET NO.	TOTAL SHEETS
HAWAII	HAW.	HWY-M-01-15M	2015	16	41

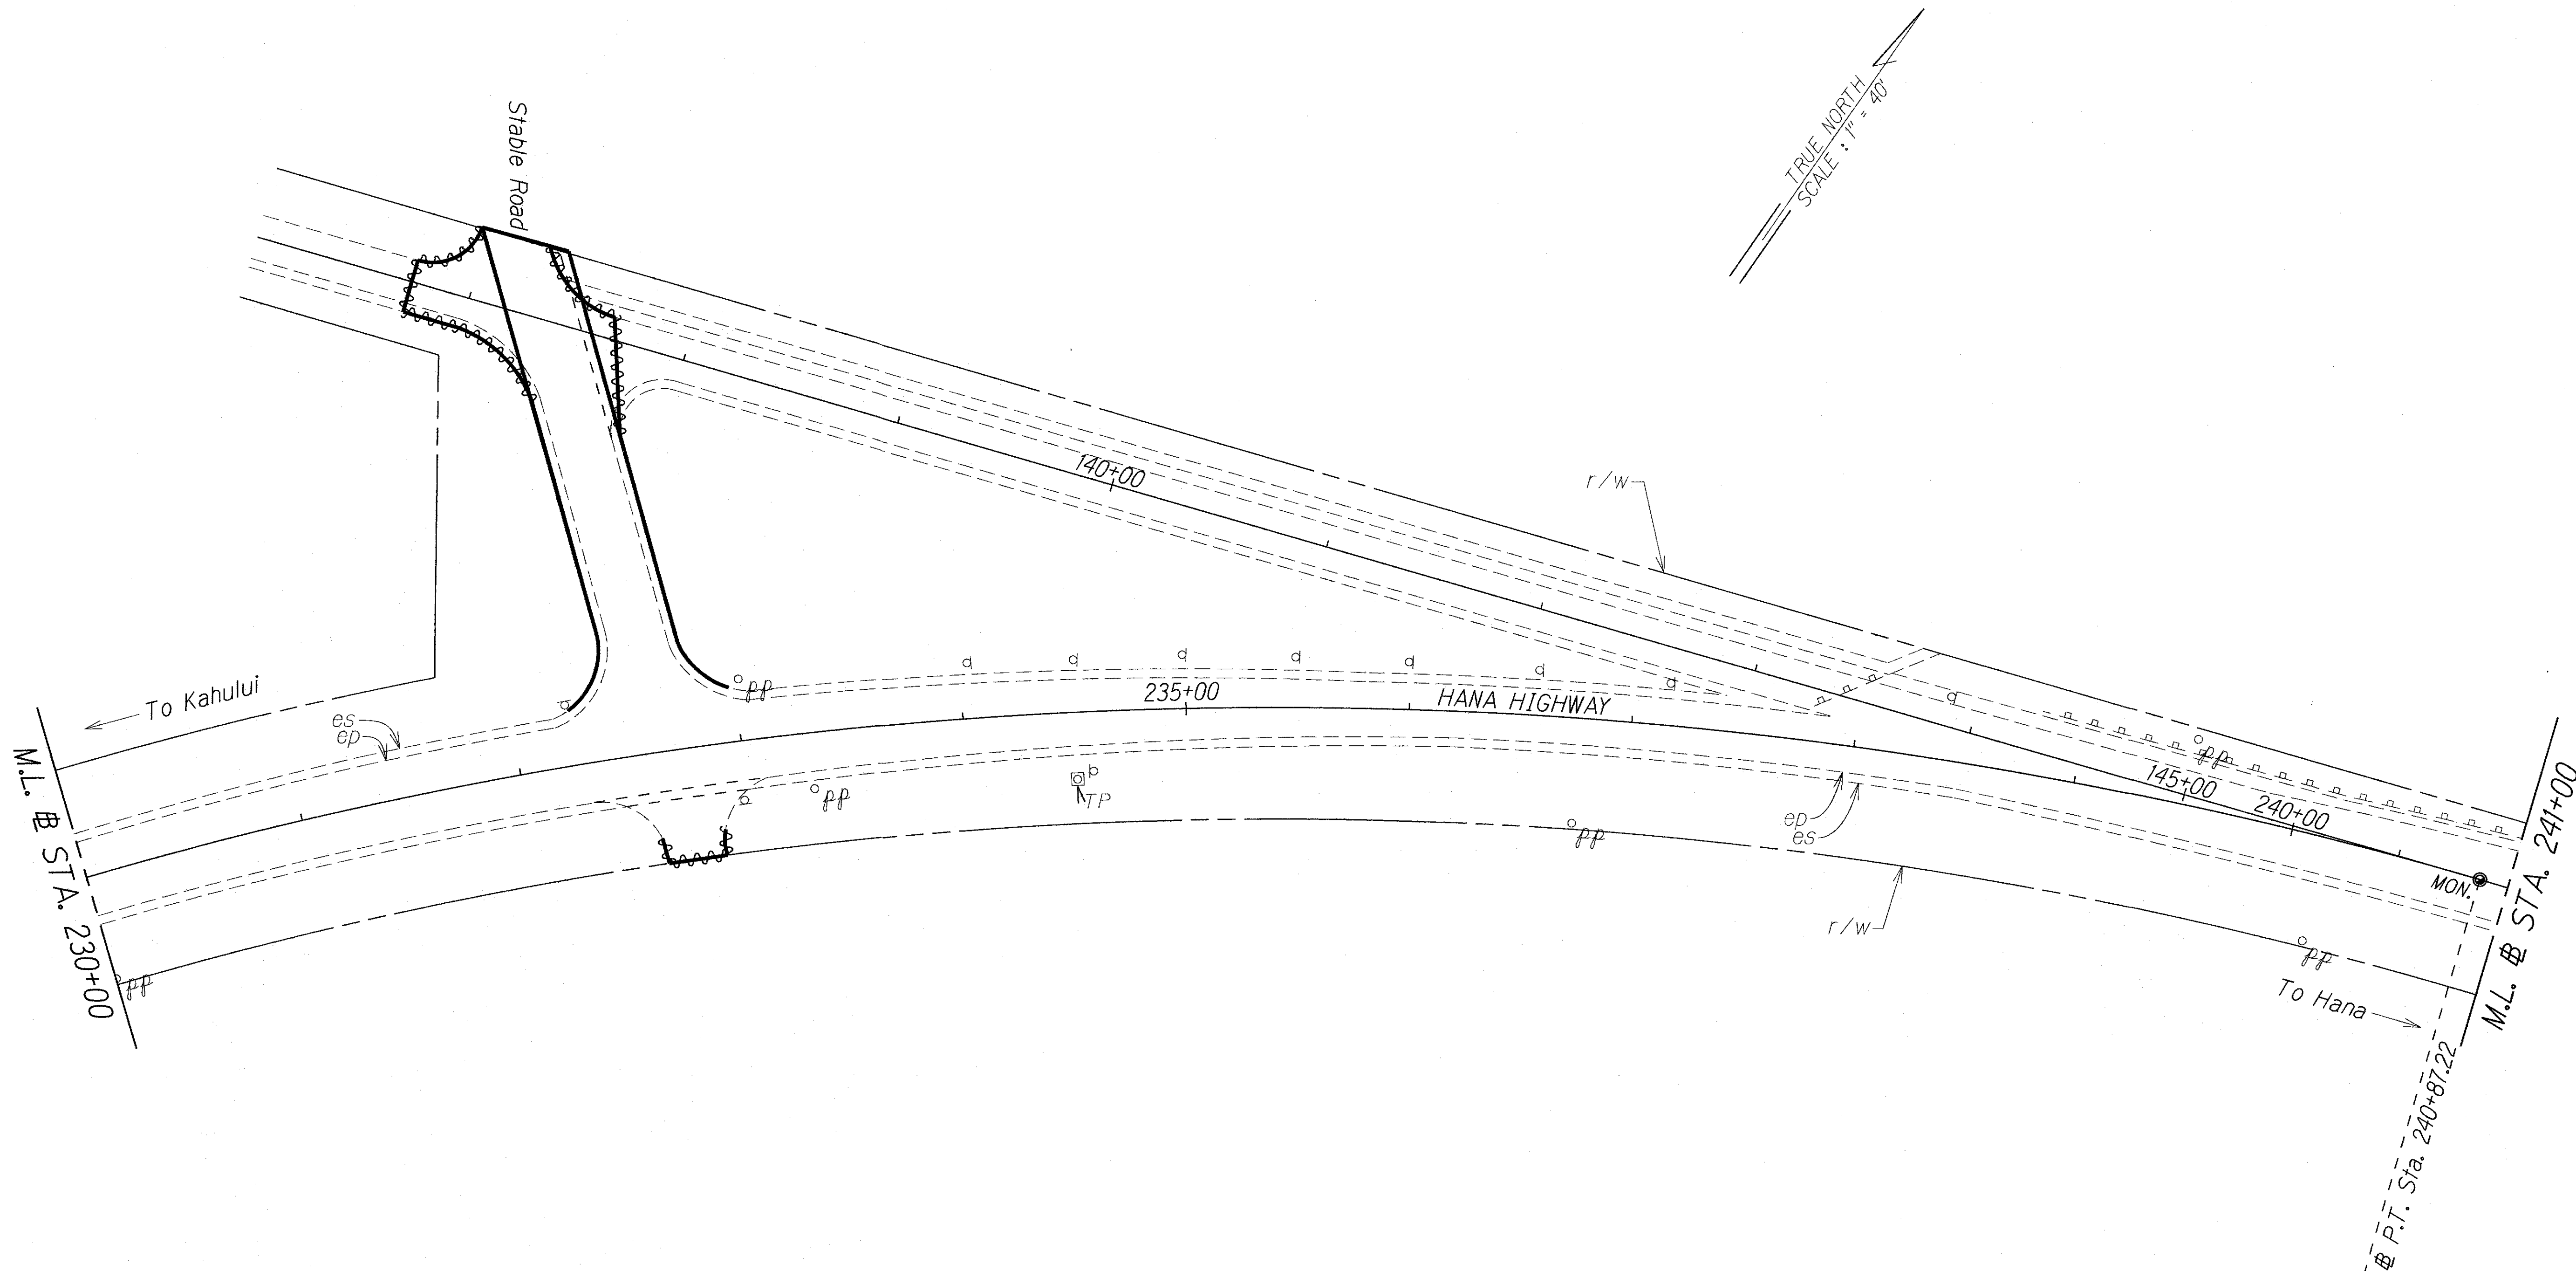


ORIGINAL PLAN	SURVEY PLOTTED BY	DATE
PLAN	DRAWN BY	12/03
NOTE BOOK	TRACED BY	
logins_jay	QUANTITIES BY	
checked_by	CHECKED BY	

LEGEND FOR AS-BUILT POSTINGS	
	Squiggly line for as-built deletion
	Double line for as-built deletion
Roadway	Text for as-built posting

STATE OF HAWAII
DEPARTMENT OF TRANSPORTATION
HIGHWAYS DIVISION
ROADWAY PLAN
HANA HIGHWAY RESURFACING
Haleakala Highway to Paia and
HALEAKALA HIGHWAY RESURFACING
Hana Highway to North Firebreak Rd.
Project No. HWY-M-01-15M
Scale: 1" = 40' Date: March, 2015
SHEET No. 5 OF 13 SHEETS

FED. ROAD DIST. NO.	STATE	PROJ. NO.	FISCAL YEAR	SHEET NO.	TOTAL SHEETS
HAWAII	HAW.	HWY-M-01-15M	2015	ADD.17	41

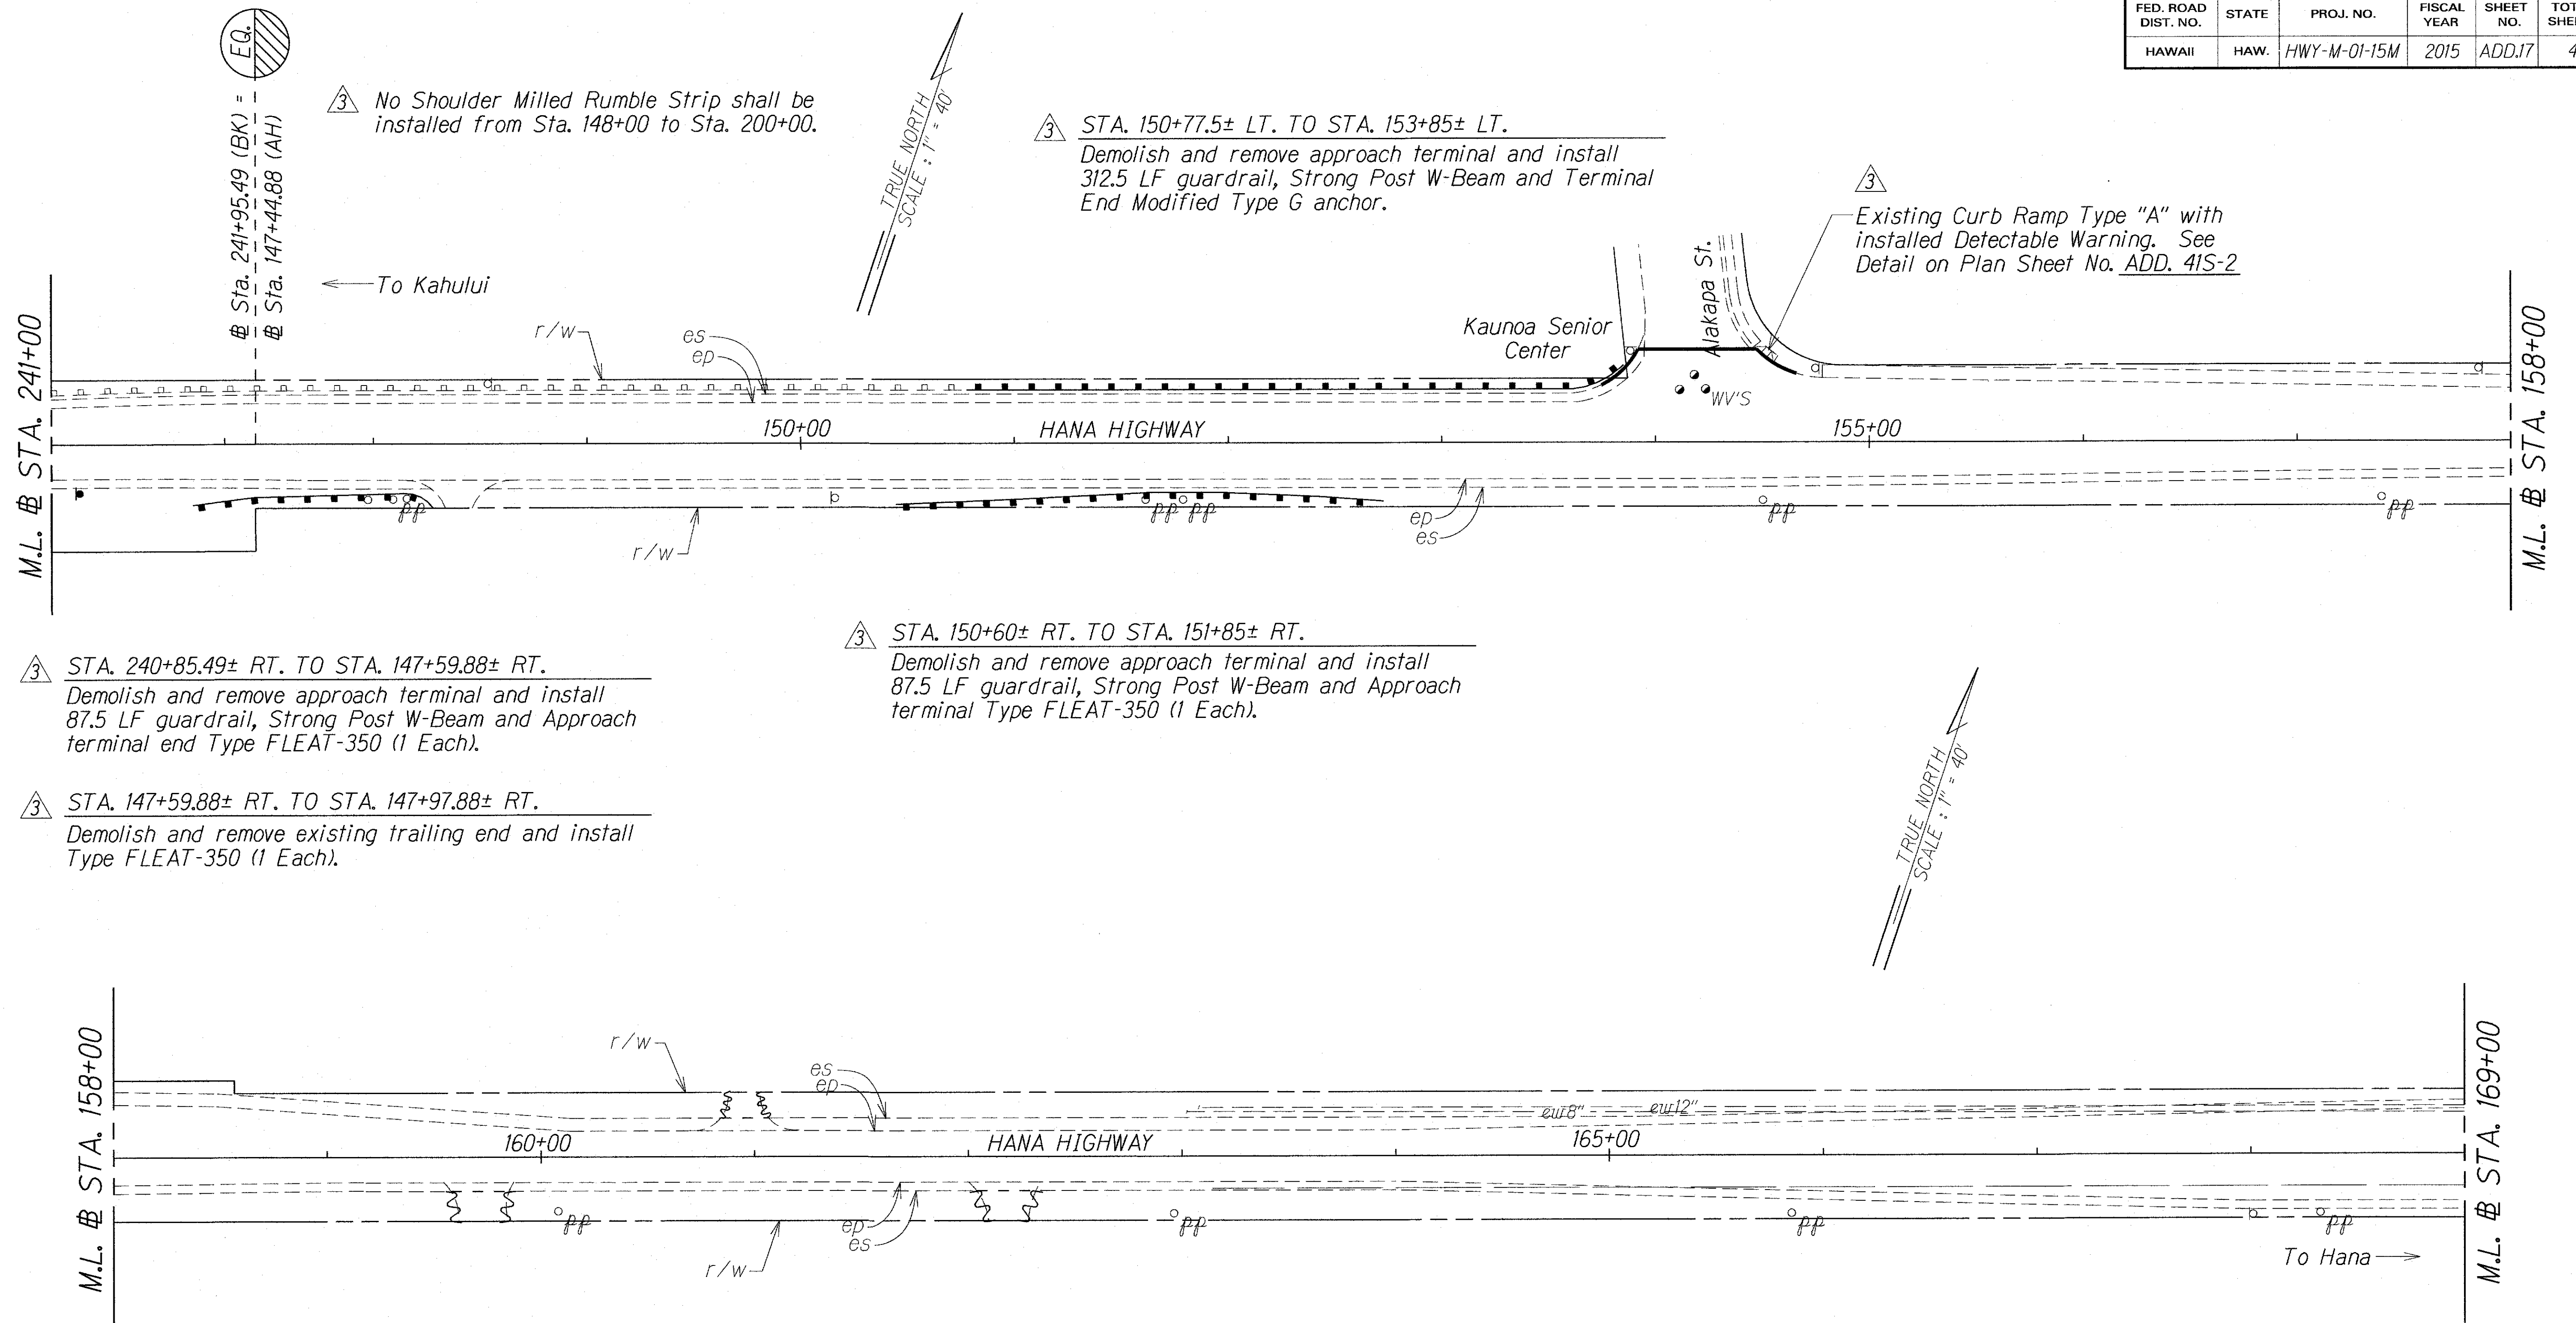

ORIGINAL	SURVEY PLOTTED BY	DATE
PLAN	DRAWN BY	12/03
NOTE BOOK	DESIGNED BY	
	CHECKED BY	
	CHECKED BY	

LEGEND FOR AS-BUILT POSTINGS	
	Squiggly line for as-built deletion
	Double line for as-built deletion
Roadway	Text for as-built posting


4-12-16	Additional Guardrail.
4-28-16	Add Notes.
DATE	REVISION

STATE OF HAWAII DEPARTMENT OF TRANSPORTATION HIGHWAYS DIVISION	
ROADWAY PLAN	
HANA HIGHWAY RESURFACING Haleakala Highway to Paia and HALEAKALA HIGHWAY RESURFACING Hana Highway to North Firebreak Rd.	
Project No. HWY-M-01-15M	
Scale: 1" = 40'	Date: March, 2015
SHEET No. 6 OF 13 SHEETS	

"AS-BUILT"

ADD. 17

FED. ROAD DIST. NO.	STATE	PROJ. NO.	FISCAL YEAR	SHEET NO.	TOTAL SHEETS
HAWAII	HAW.	HWY-M-01-15M	2015	18	41

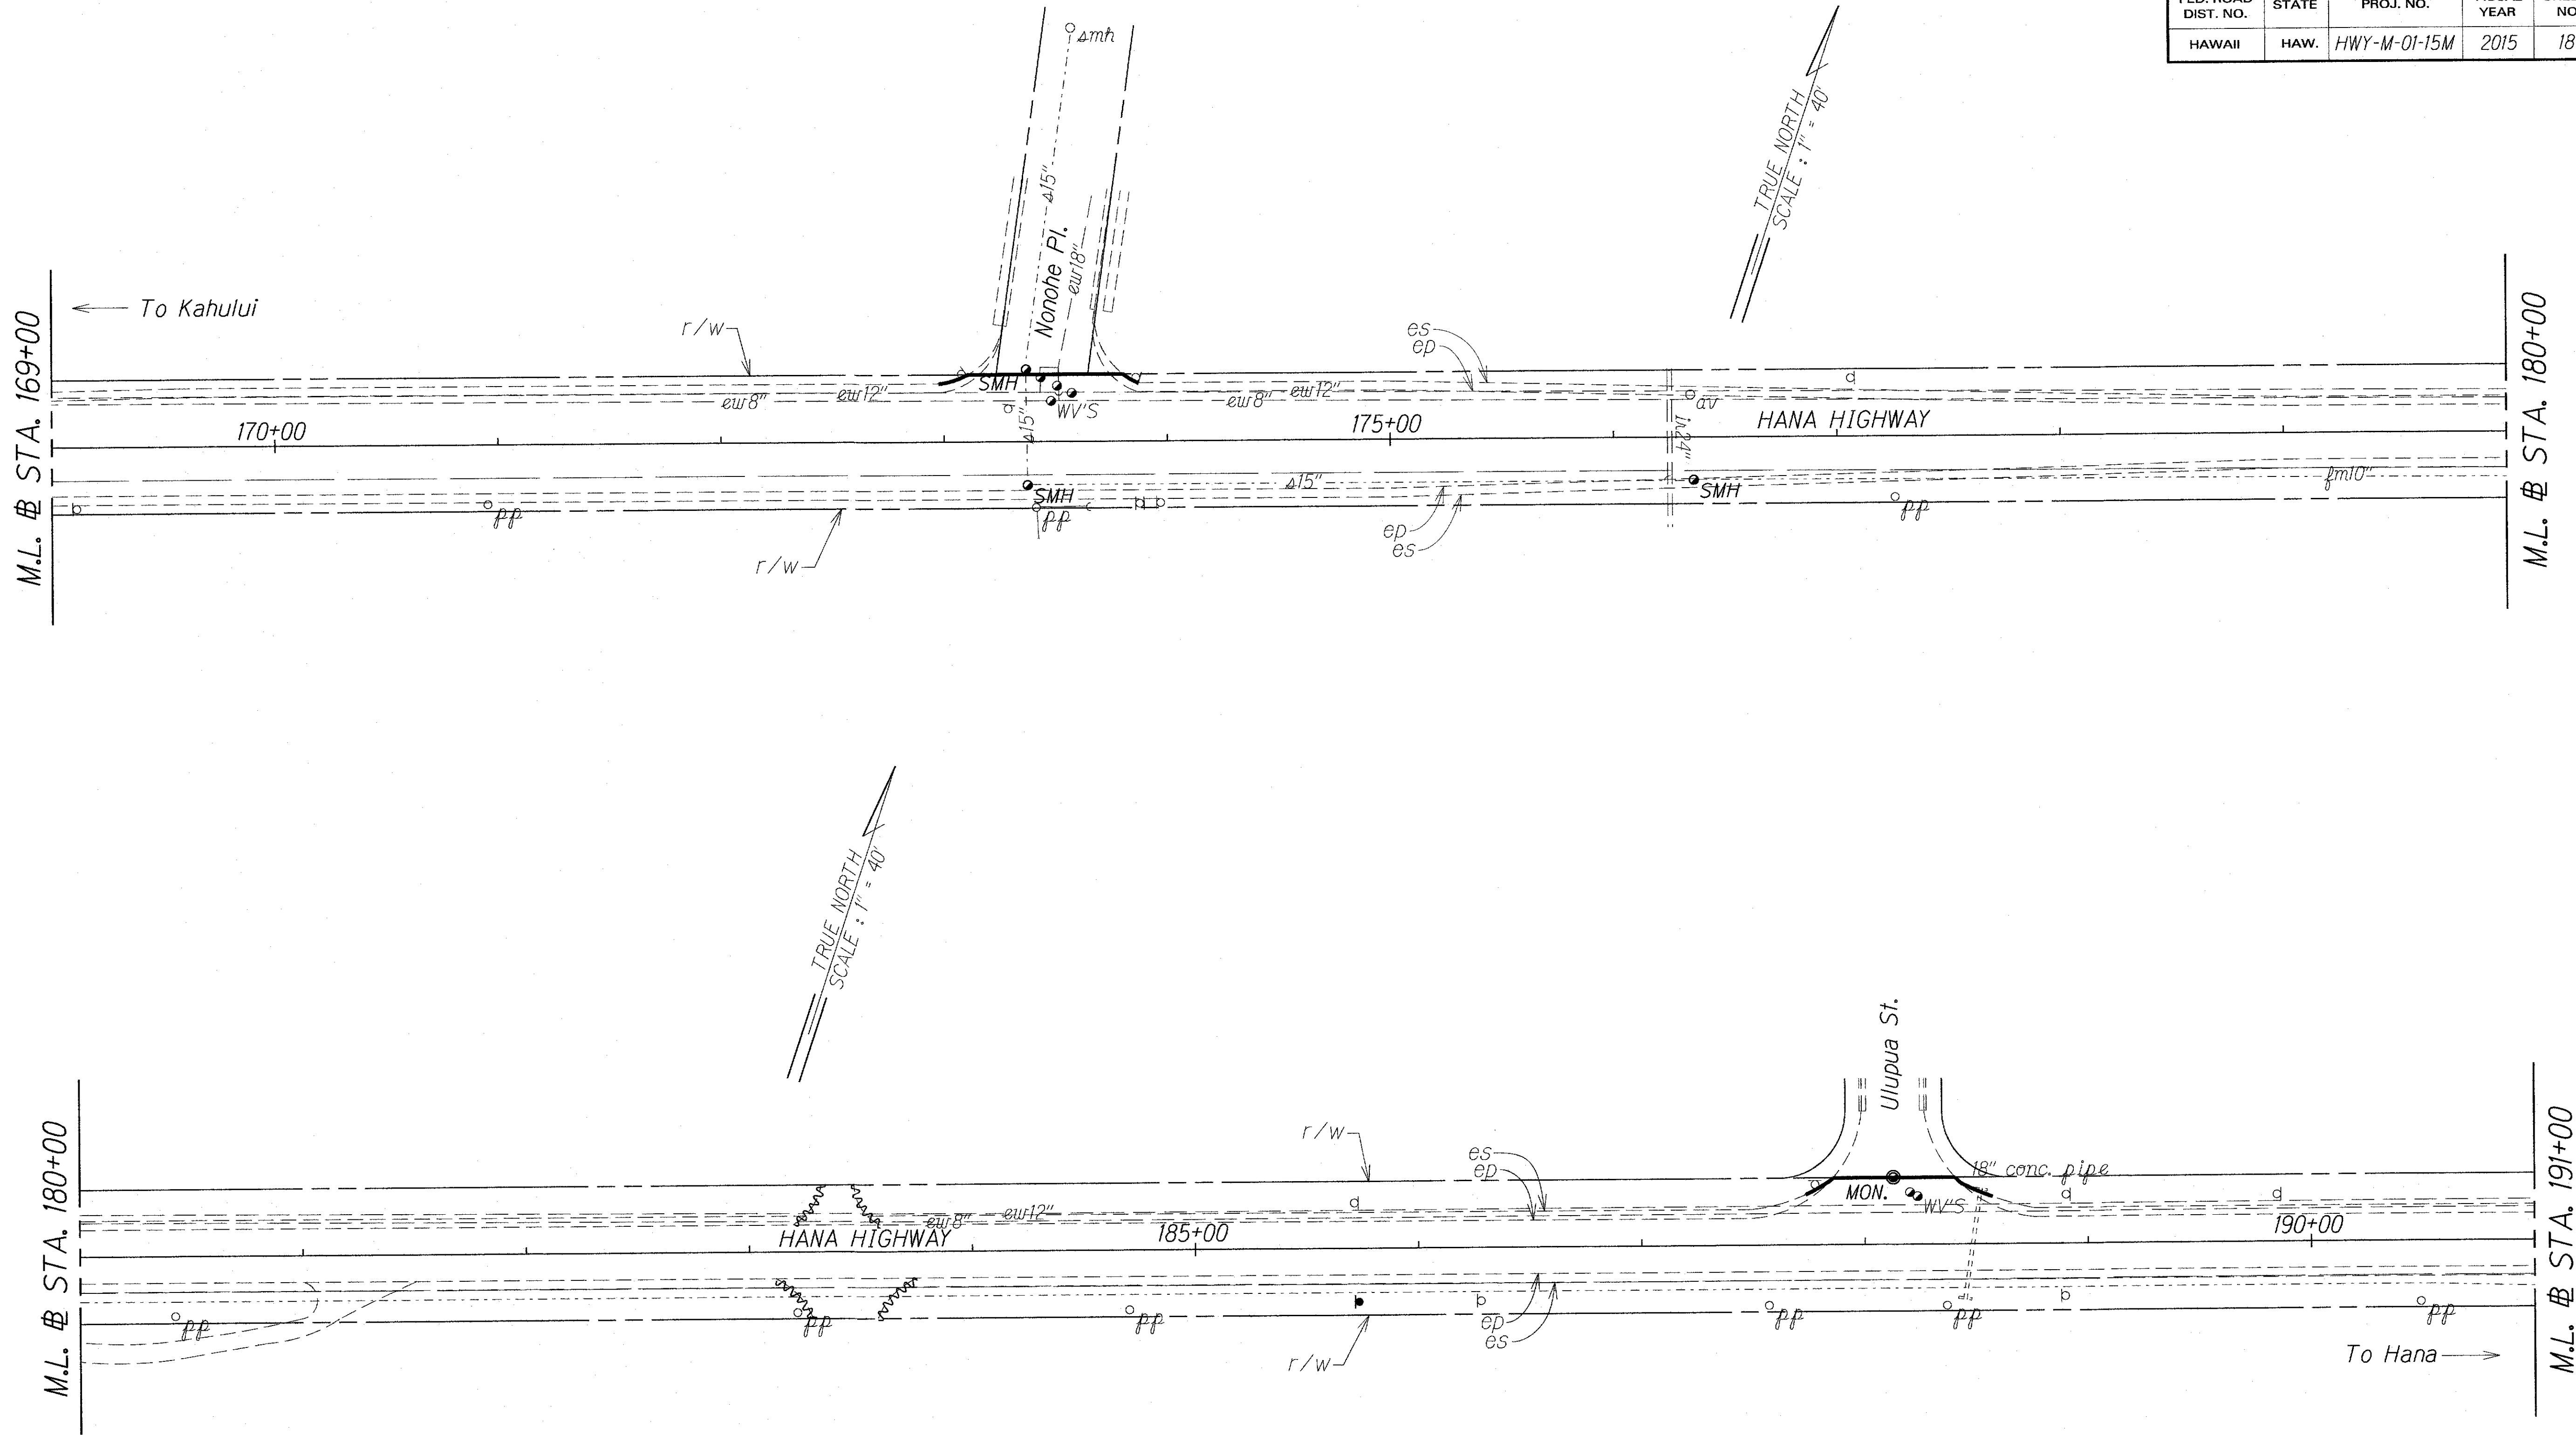


ORIGINAL PLAN	SURVEY PLOTTED BY	DATE
NOTE BOOK	DESIGNED BY	
QUANTITIES BY	CHECKED BY	

LEGEND FOR AS-BUILT POSTINGS	
	Squiggly line for as-built deletion
	Double line for as-built deletion
Roadway	Text for as-built posting

STATE OF HAWAII
DEPARTMENT OF TRANSPORTATION
HIGHWAYS DIVISION
ROADWAY PLAN
HANA HIGHWAY RESURFACING
Haleakala Highway to Paia and
HALEAKALA HIGHWAY RESURFACING
Hana Highway to North Firebreak Rd.
Project No. HWY-M-01-15M
Scale: 1" = 40' Date: March, 2015
SHEET No. 7 OF 13 SHEETS

"AS-BUILT"

FED. ROAD DIST. NO.	STATE	PROJ. NO.	FISCAL YEAR	SHEET NO.	TOTAL SHEETS
HAWAII	HAW.	HWY-M-01-15M	2015	19	41

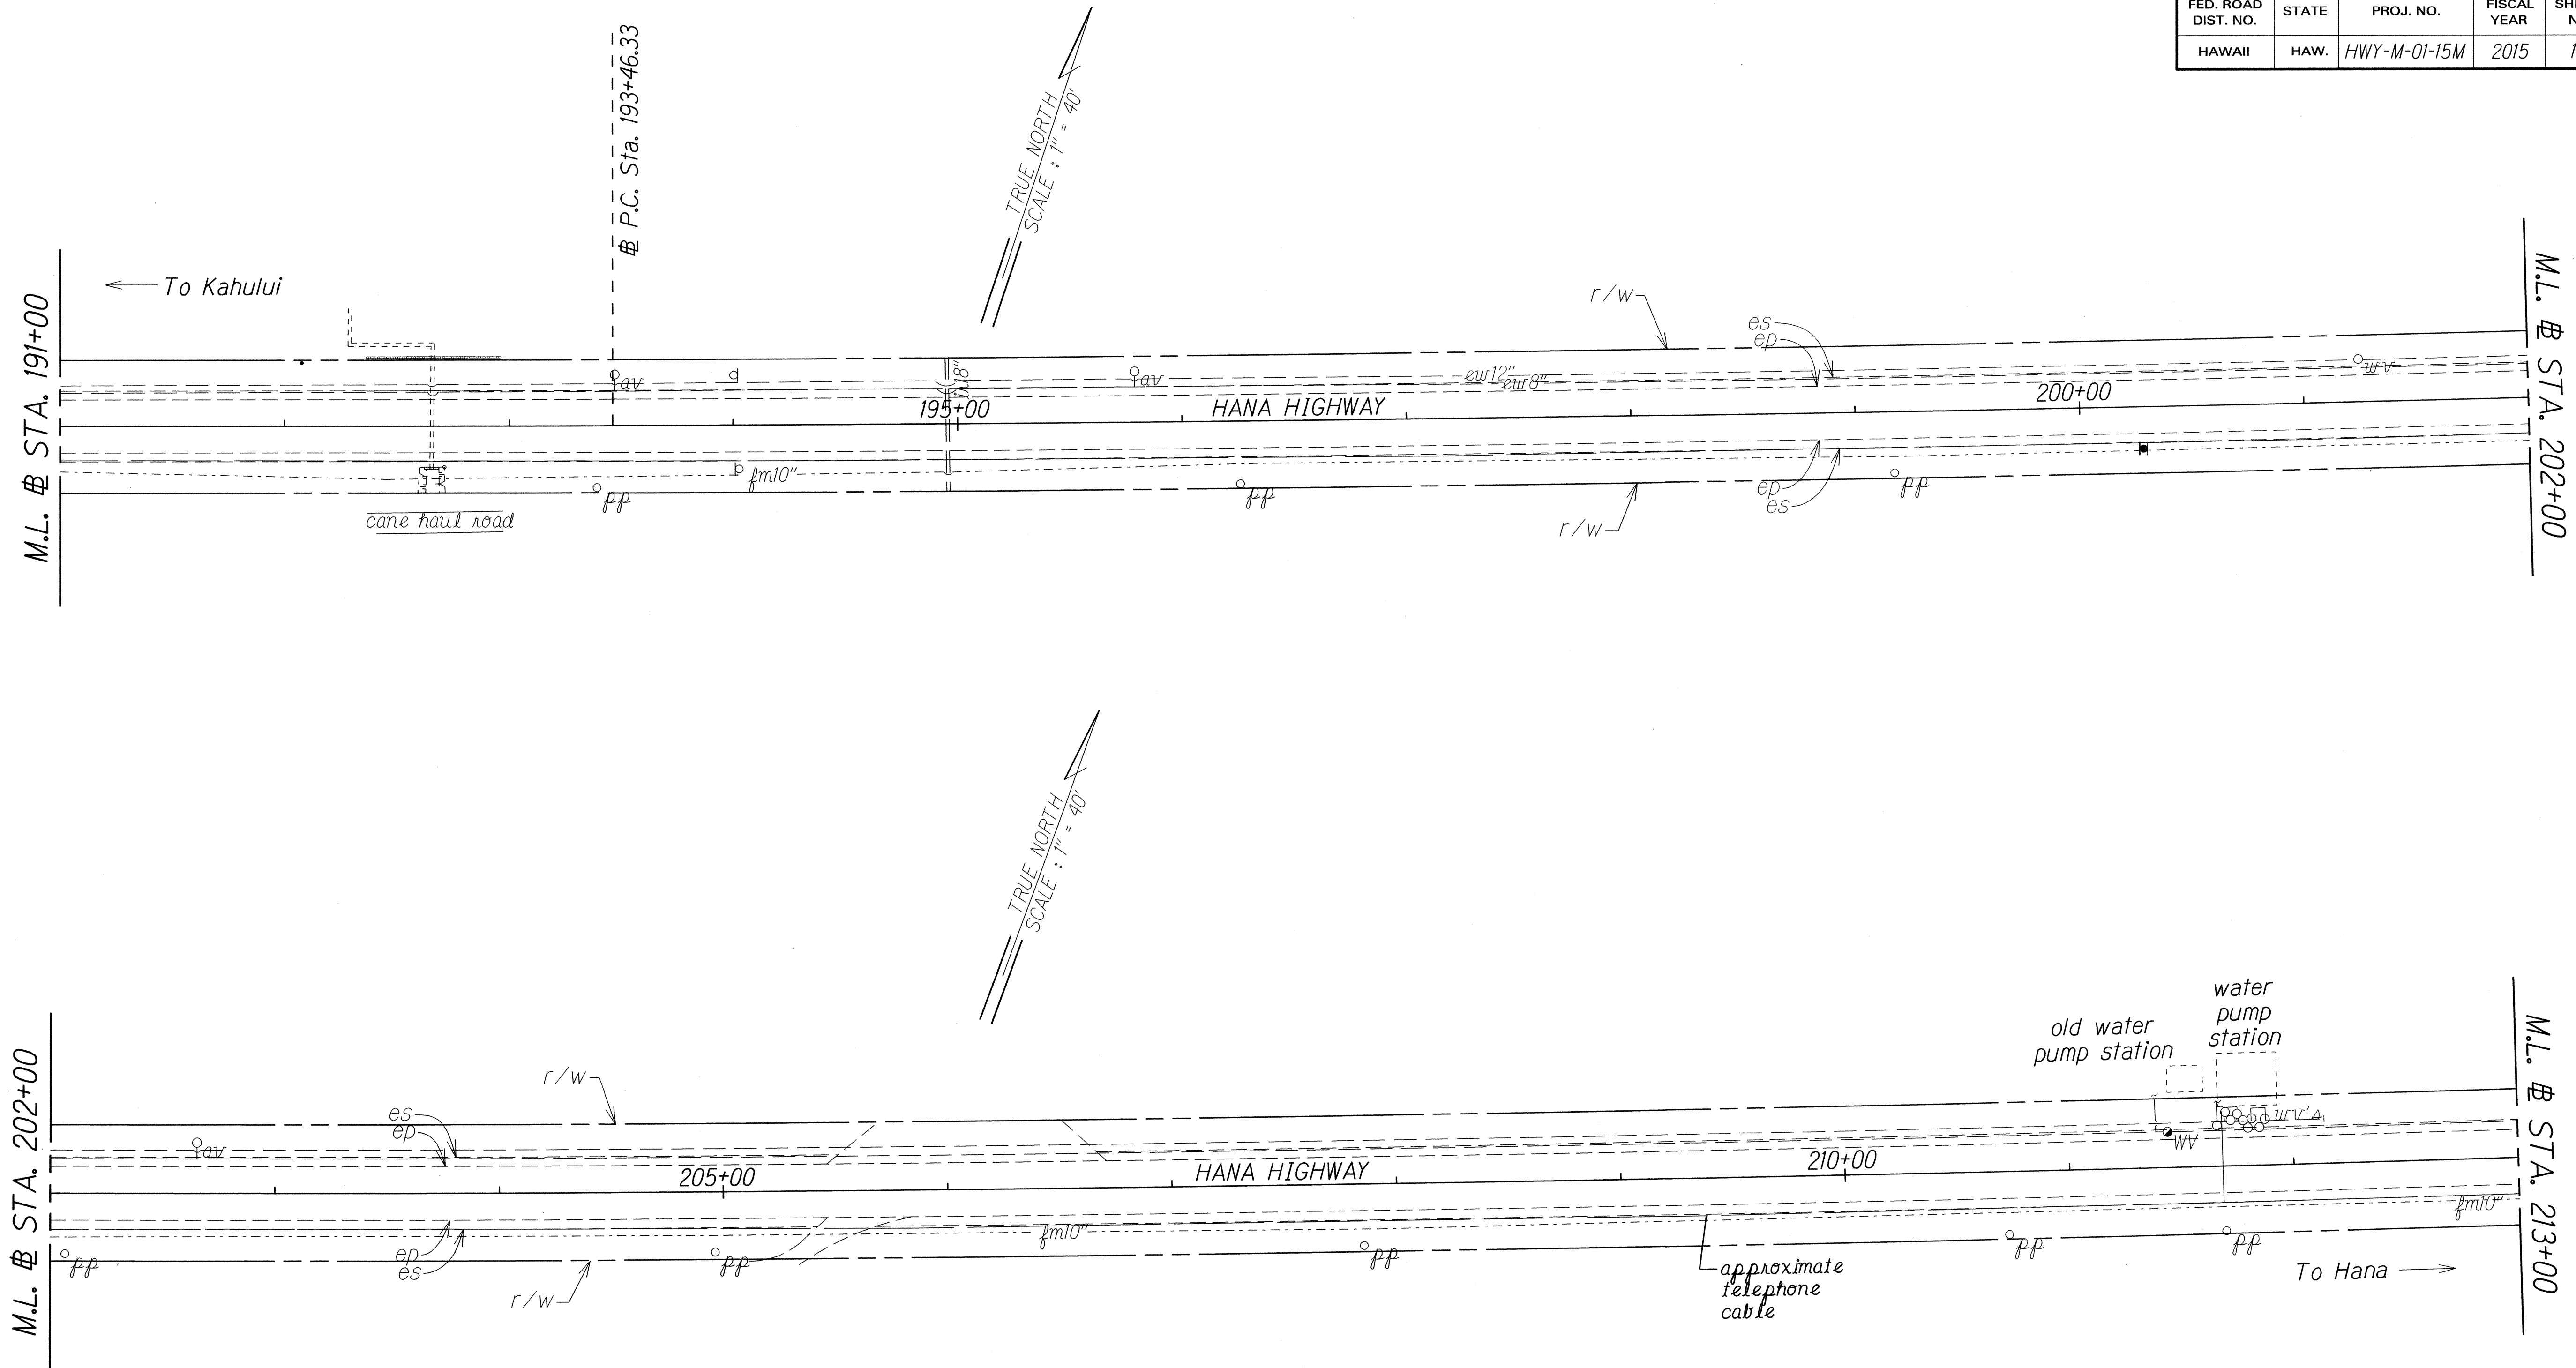

ORIGINAL PLAN	SURVEY PLOTTED BY	DATE
NOTE BOOK	DRAWN BY	4-10-1998
DESIGNED BY	TRACED BY	
CHECKED BY	CHECKED BY	

STATE OF HAWAII
DEPARTMENT OF TRANSPORTATION
HIGHWAYS DIVISION


ROADWAY PLAN

HANA HIGHWAY RESURFACING
Haleakala Highway to Paia and
HALEAKALA HIGHWAY RESURFACING
Hana Highway to North Firebreak Rd.

Project No. HWY-M-01-15M
Scale: 1" = 40' Date: March, 2015

SHEET No. 8 OF 13 SHEETS

FED. ROAD DIST. NO.	STATE	PROJ. NO.	FISCAL YEAR	SHEET NO.	TOTAL SHEETS
HAWAII	HAW.	HWY-M-01-15M	2015	20	41

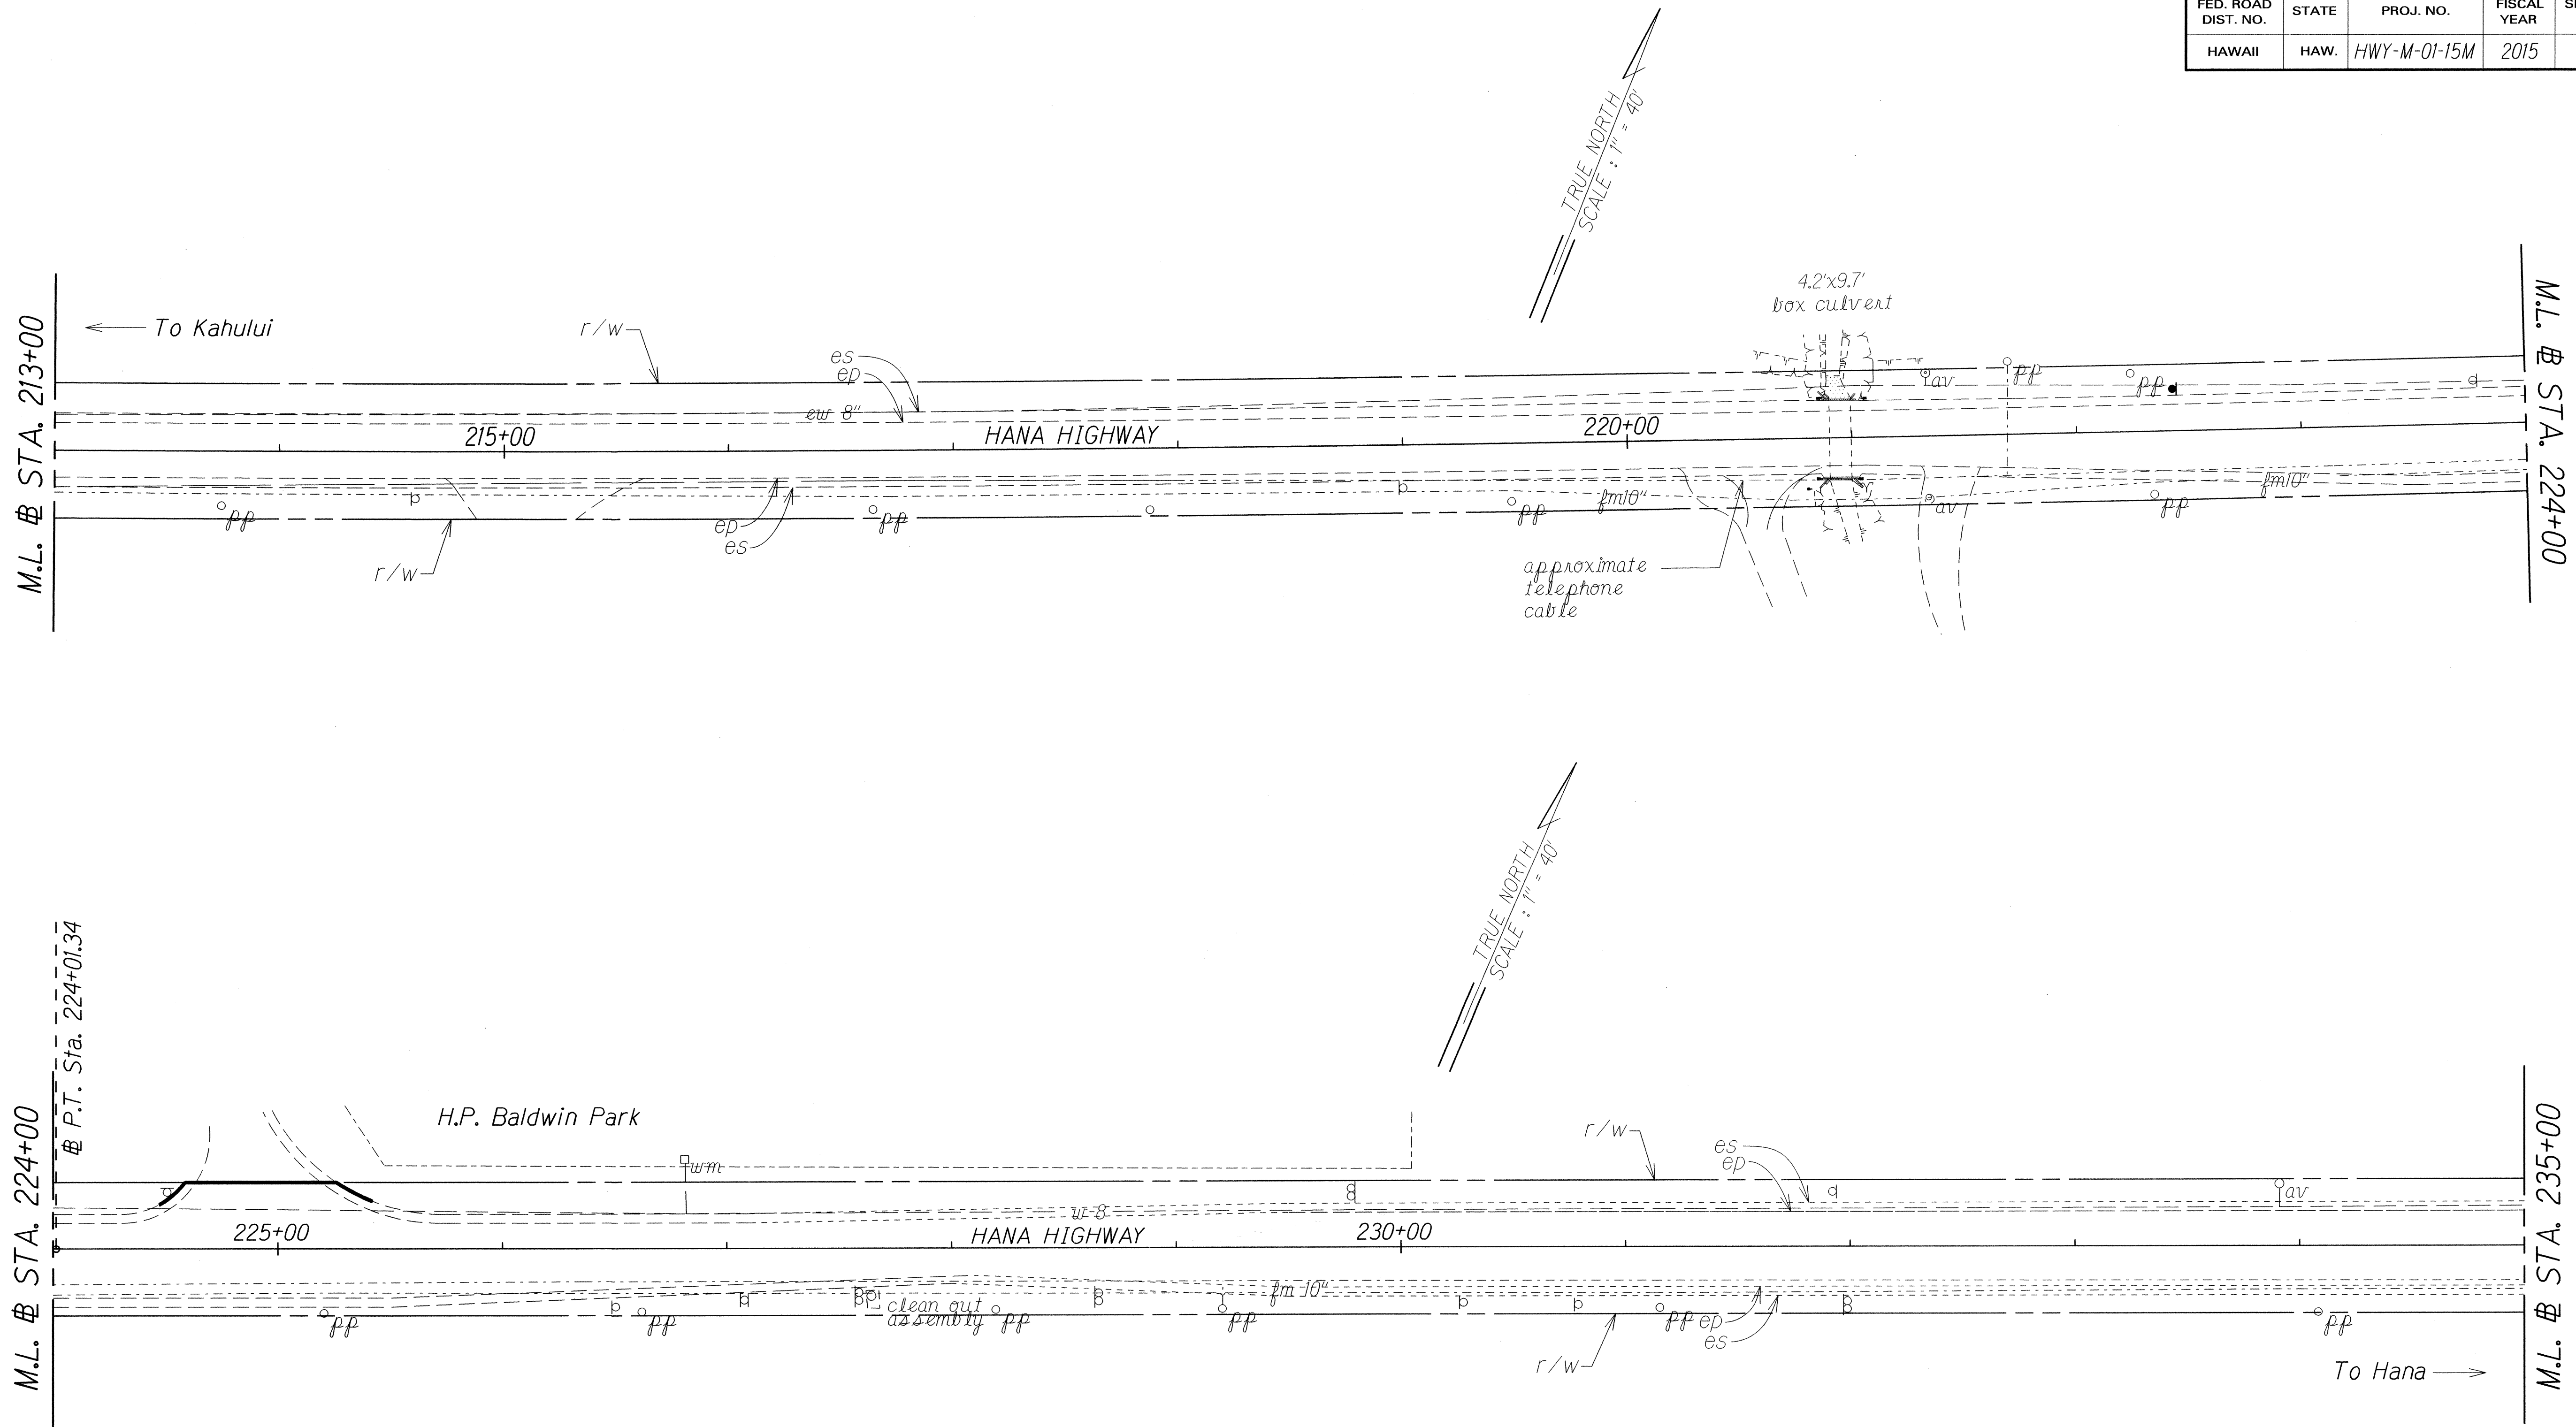

ORIGINAL PLAN	SURVEY PLOTTED BY	DATE
NOTE BOOK	DRAWN BY	4/10/1988
DESIGNED BY	TRACED BY	
CHECKED BY	CHECKED BY	

STATE OF HAWAII
DEPARTMENT OF TRANSPORTATION
HIGHWAYS DIVISION


ROADWAY PLAN

HANA HIGHWAY RESURFACING
Haleakala Highway to Paia and
HALEAKALA HIGHWAY RESURFACING
Hana Highway to North Firebreak Rd.

Project No. HWY-M-01-15M
Scale: 1" = 40' Date: March, 2015

SHEET No. 9 OF 13 SHEETS


FED. ROAD DIST. NO.	STATE	PROJ. NO.	FISCAL YEAR	SHEET NO.	TOTAL SHEETS
HAWAII	HAW.	HWY-M-01-15M	2015	ADD.21	41

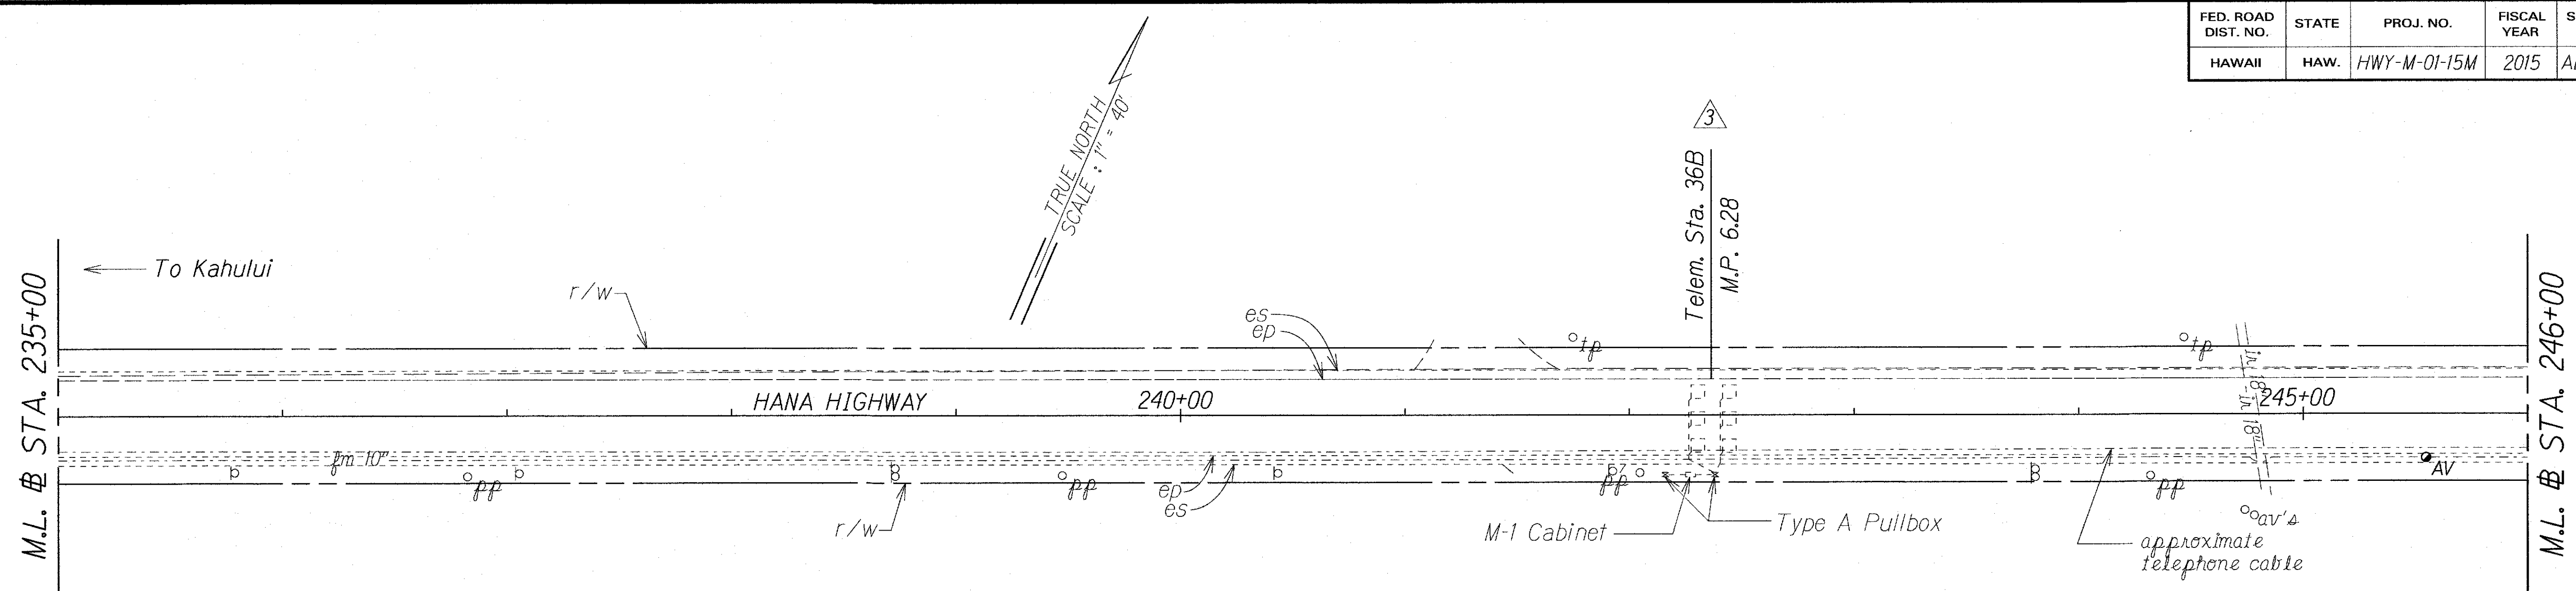

3 STA. 251+00± LT. TO STA. 253+40± LT.
Construct 6'± wide pavement concrete sidewalk with curb and gutter and a curb ramp Type "D" with detectable warning. Payment shall be paid under contract Item No. 411.1000. See Detail on Plan Sheet No. ADD. 41S-3

END PROJECT
Project No. HWY-M-01-15M
Sta. 254+00

Sta. 251+49± to Sta. 252+37± Lt
Install 24" GDI and 18"x88' perforated HDPE drain pipe.

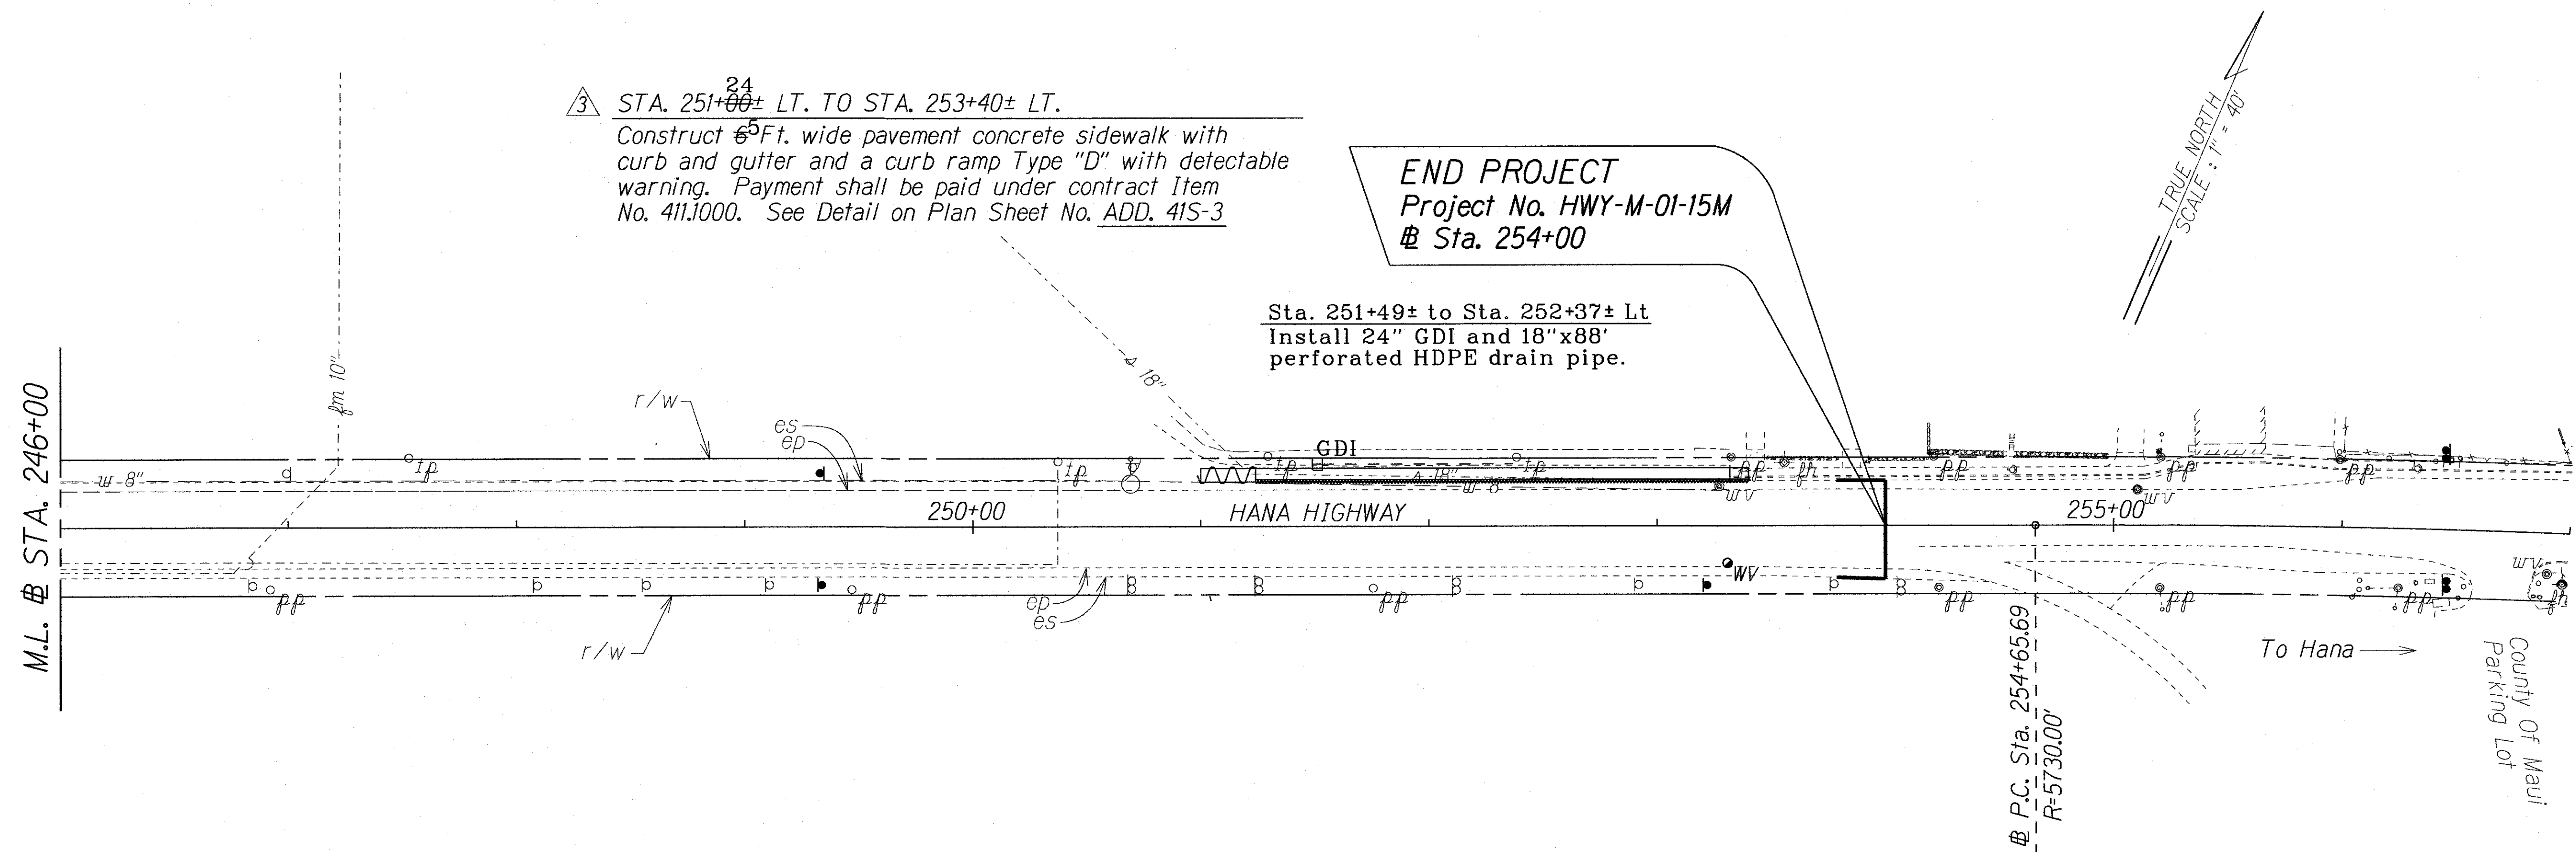

LEGEND FOR AS-BUILT POSTINGS	
	Squiggly line for as-built deletion
	Double line for as-built deletion
Roadway	Text for as-built posting

3	4-12-16	Additional Concrete Sidewalk.
3	4-28-16	Added Counting Station.
DATE	REVISION	

STATE OF HAWAII DEPARTMENT OF TRANSPORTATION HIGHWAYS DIVISION	
ROADWAY PLAN	
HANA HIGHWAY RESURFACING Haleakala Highway to Paia and HALEAKALA HIGHWAY RESURFACING Hana Highway to North Firebreak Rd.	
Project No. HWY-M-01-15M	
Scale: 1" = 40'	Date: March, 2015
SHEET No. 10 OF 13 SHEETS	

ORIGINAL PLAN	SURVEY PLOTTED BY	DATE
NOTE BOOK	DRAWN BY	DATE
QUANTITIES BY	TRACED BY	DATE
CHECKED BY	NOTED BY	DATE


"AS-BUILT"

ADD. 21

FED. ROAD DIST. NO.	STATE	PROJ. NO.	FISCAL YEAR	SHEET NO.	TOTAL SHEETS
HAWAII	HAW.	HWY-M-01-15M	2015	22	41

TRUE NORTH
SCALE: 1" = 40'

BEGIN PROJECT
Project No. HWY-M-01-15M
@ Sta. 34+00

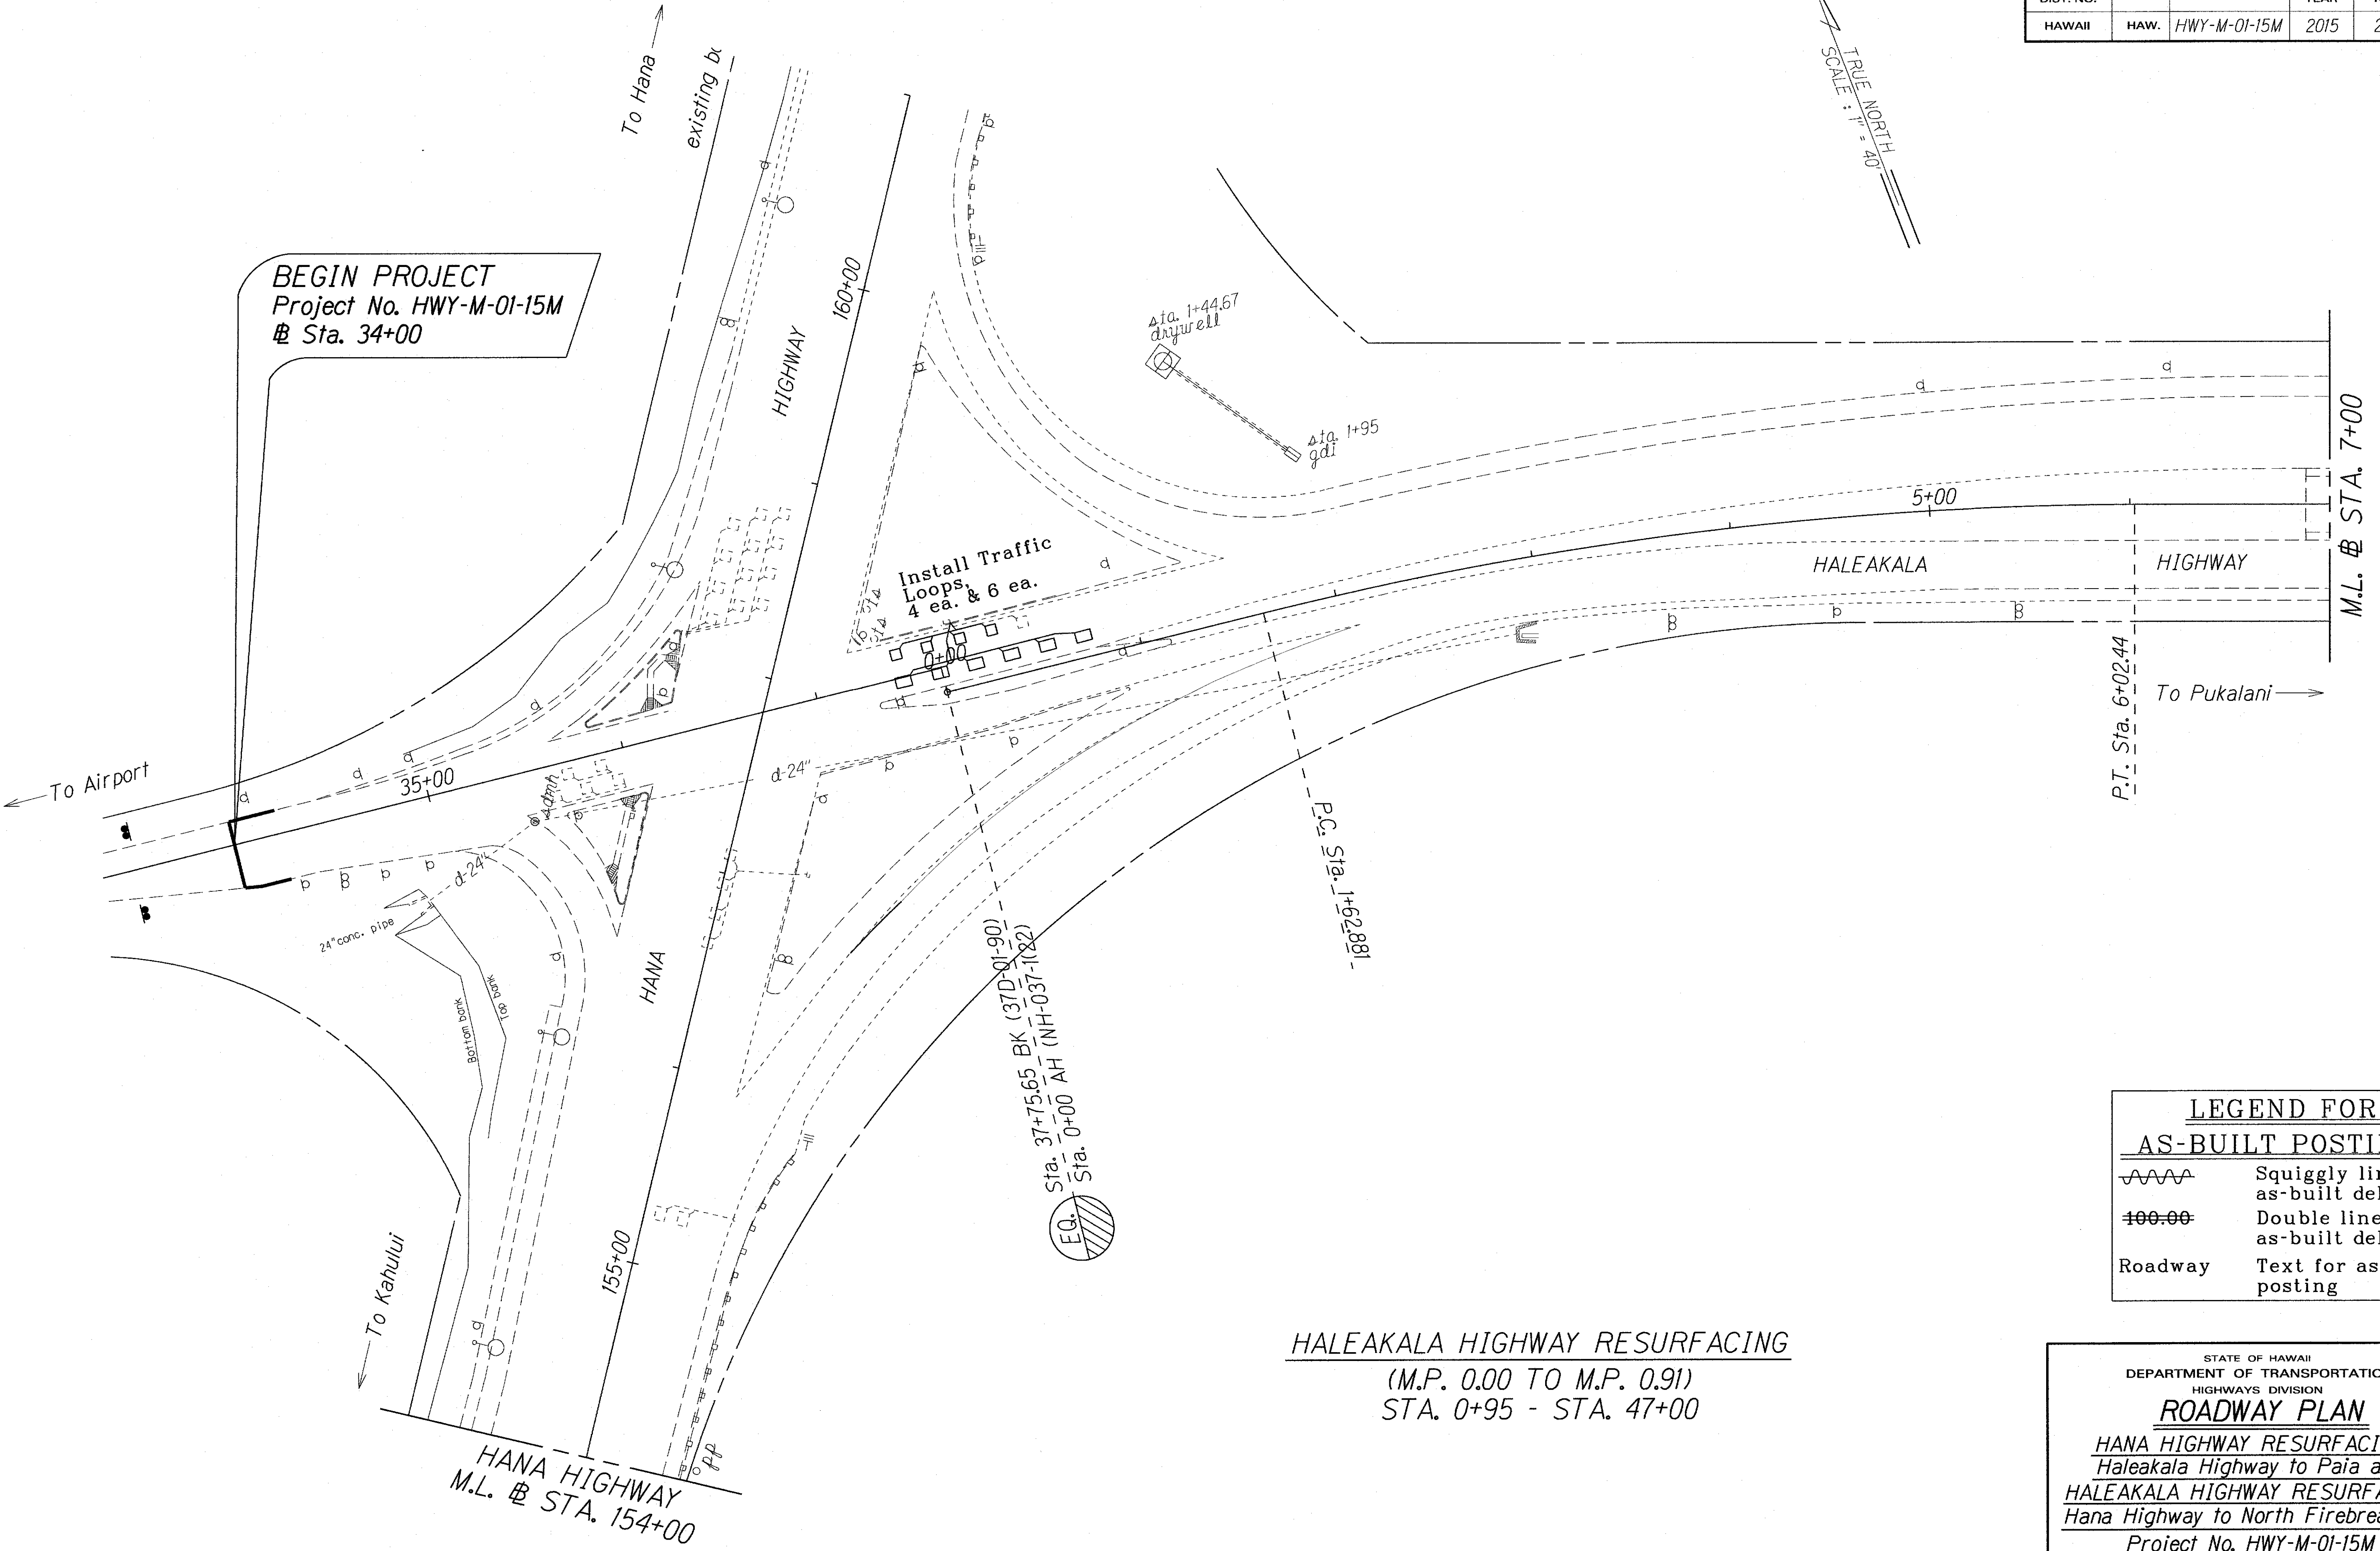


HALEAKALA HIGHWAY RESURFACING
(M.P. 0.00 TO M.P. 0.91)
STA. 0+95 - STA. 47+00

LEGEND FOR AS-BUILT POSTINGS	
	Squiggly line for as-built deletion
	Double line for as-built deletion
Roadway	Text for as-built posting

STATE OF HAWAII
DEPARTMENT OF TRANSPORTATION
HIGHWAYS DIVISION
ROADWAY PLAN
HANA HIGHWAY RESURFACING
Haleakala Highway to Paia and
Haleakala Highway Resurfacing
Hana Highway to North Firebreak Rd.
Project No. HWY-M-01-15M
Scale: 1" = 40' Date: March, 2015

ORIGINAL PLAN	SURVEY PLOTTED BY	DATE
NOTE BOOK	DRAWN BY	10/05
DESIGNED BY	CHECKED BY	
QUANTITIES BY		
CHECKED BY		

FED. ROAD DIST. NO.	STATE	PROJ. NO.	FISCAL YEAR	SHEET NO.	TOTAL SHEETS
HAWAII	HAW.	HWY-M-01-15M	2015	23	41

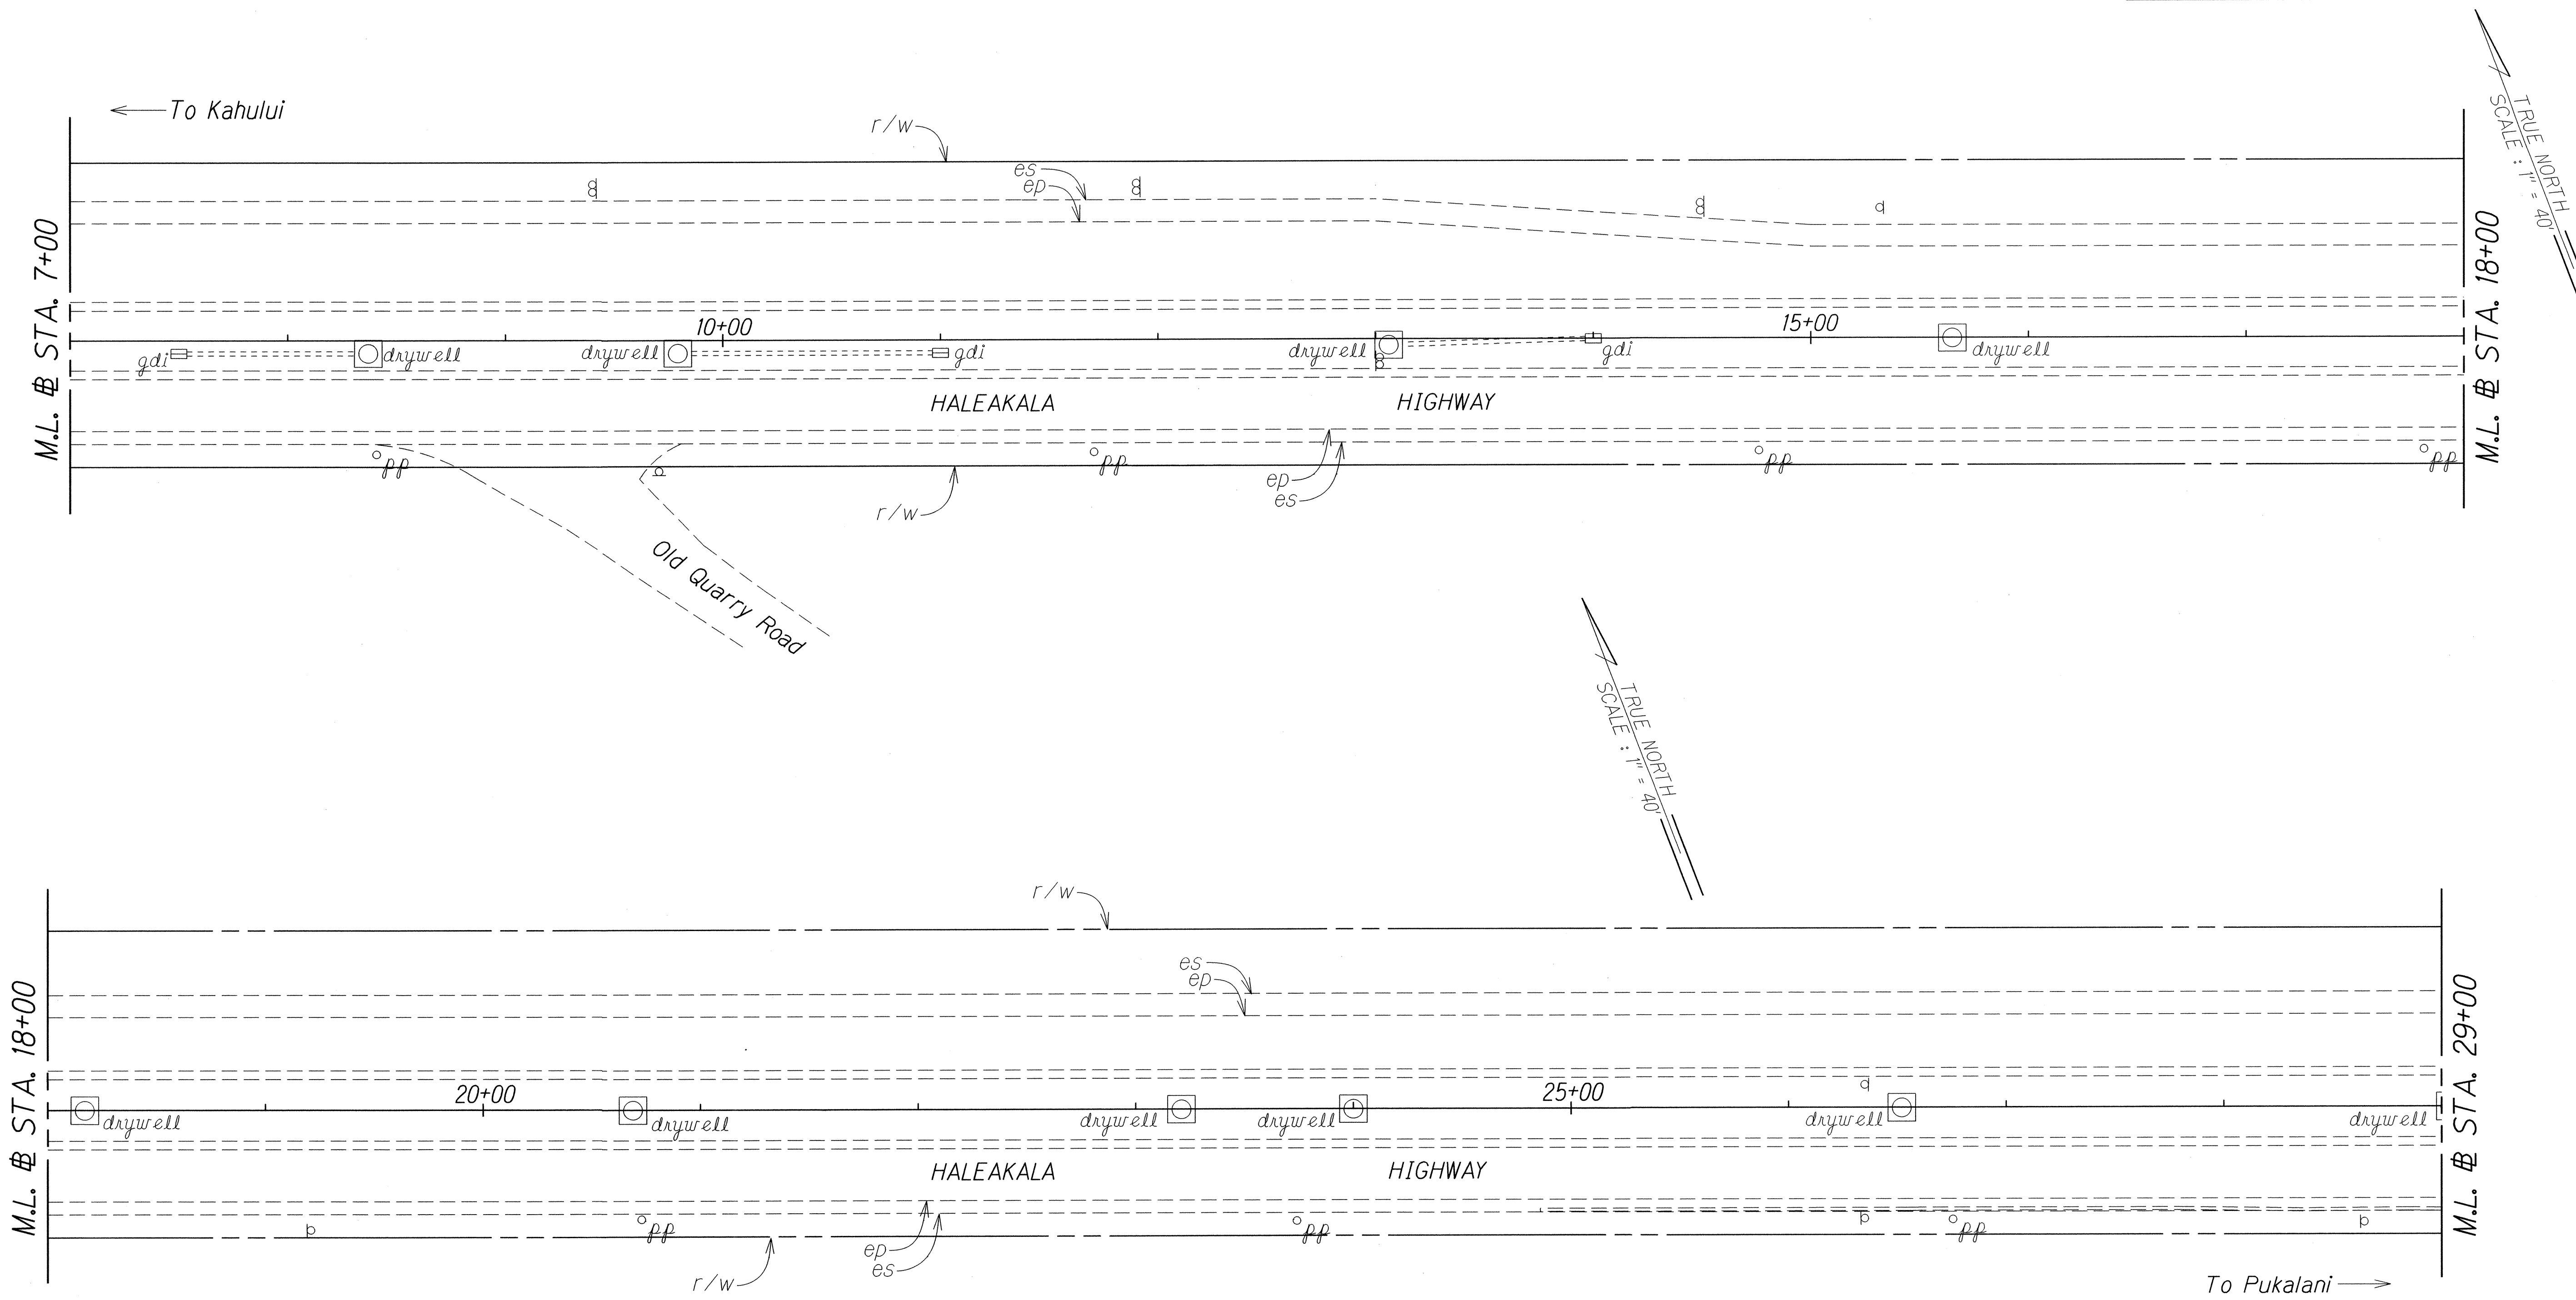

ORIGINAL PLAN	SURVEY PLOTTED BY	DATE
NOTE BOOK	DRAWN BY	10/05
DESIGNED BY	TRACED BY	
QUANTITIES BY		
CHECKED BY		

STATE OF HAWAII
DEPARTMENT OF TRANSPORTATION
HIGHWAYS DIVISION


ROADWAY PLAN

HANA HIGHWAY RESURFACING
Haleakala Highway to Paia and
HALEAKALA HIGHWAY RESURFACING
Hana Highway to North Firebreak Rd.

Project No. HWY-M-01-15M
Scale: 1" = 40' Date: March, 2015

SHEET No. 12 OF 13 SHEETS

FED. ROAD DIST. NO.	STATE	PROJ. NO.	FISCAL YEAR	SHEET NO.	TOTAL SHEETS
HAWAII	HAW.	HWY-M-01-15M	2015	ADD.24	41

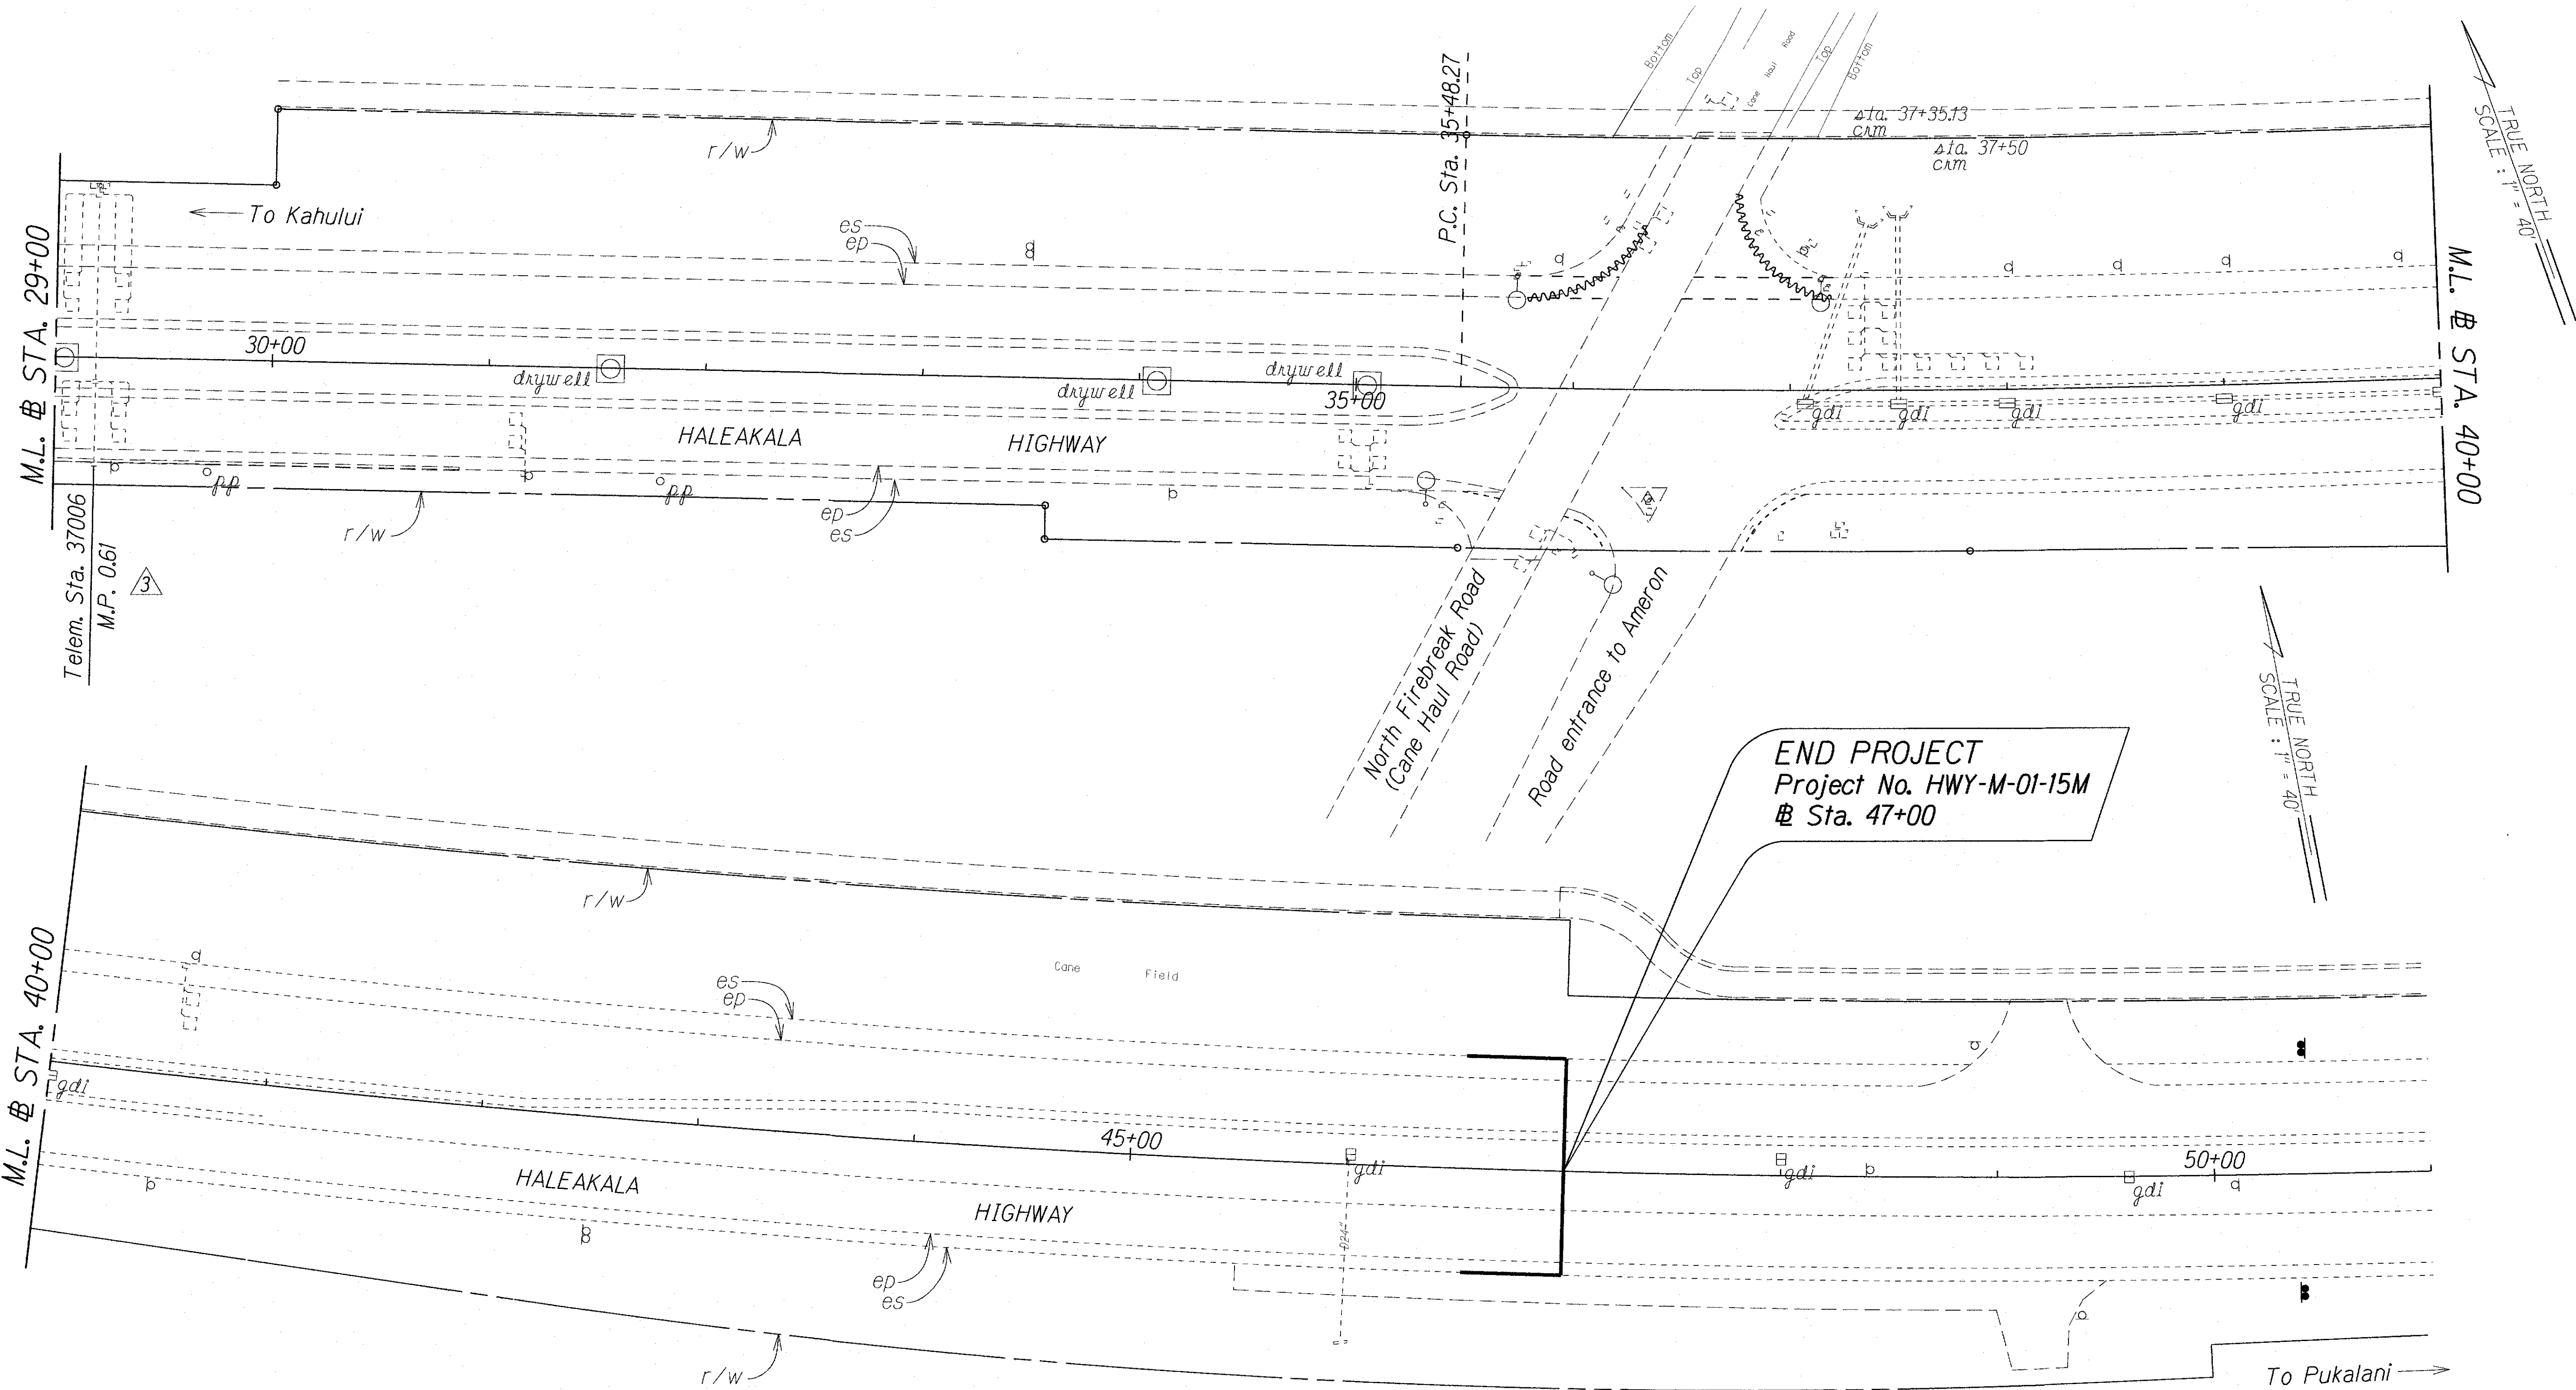

ORIGINAL PLAN	SURVEY PLOTTED BY	DATE
NOTE BOOK	DRAWN BY	10/05
DESIGNED BY	TRACED BY	
CHECKED BY	DESIGNED BY	
	CHECKED BY	

LEGEND FOR AS-BUILT POSTINGS	
	Squiggly line for as-built deletion
	Double line for as-built deletion
Roadway	Text for as-built posting

3	4-28-16	Added Counting Station.
DATE	REVISION	

STATE OF HAWAII
DEPARTMENT OF TRANSPORTATION
HIGHWAYS DIVISION

ROADWAY PLAN

HANA HIGHWAY RESURFACING
Haleakala Highway to Paia and
HALEAKALA HIGHWAY RESURFACING
Hana Highway to North Firebreak Rd.

Project No. HWY-M-01-15M

Scale: 1" = 40' Date: March, 2015

SHEET No. 13 OF 13 SHEETS