
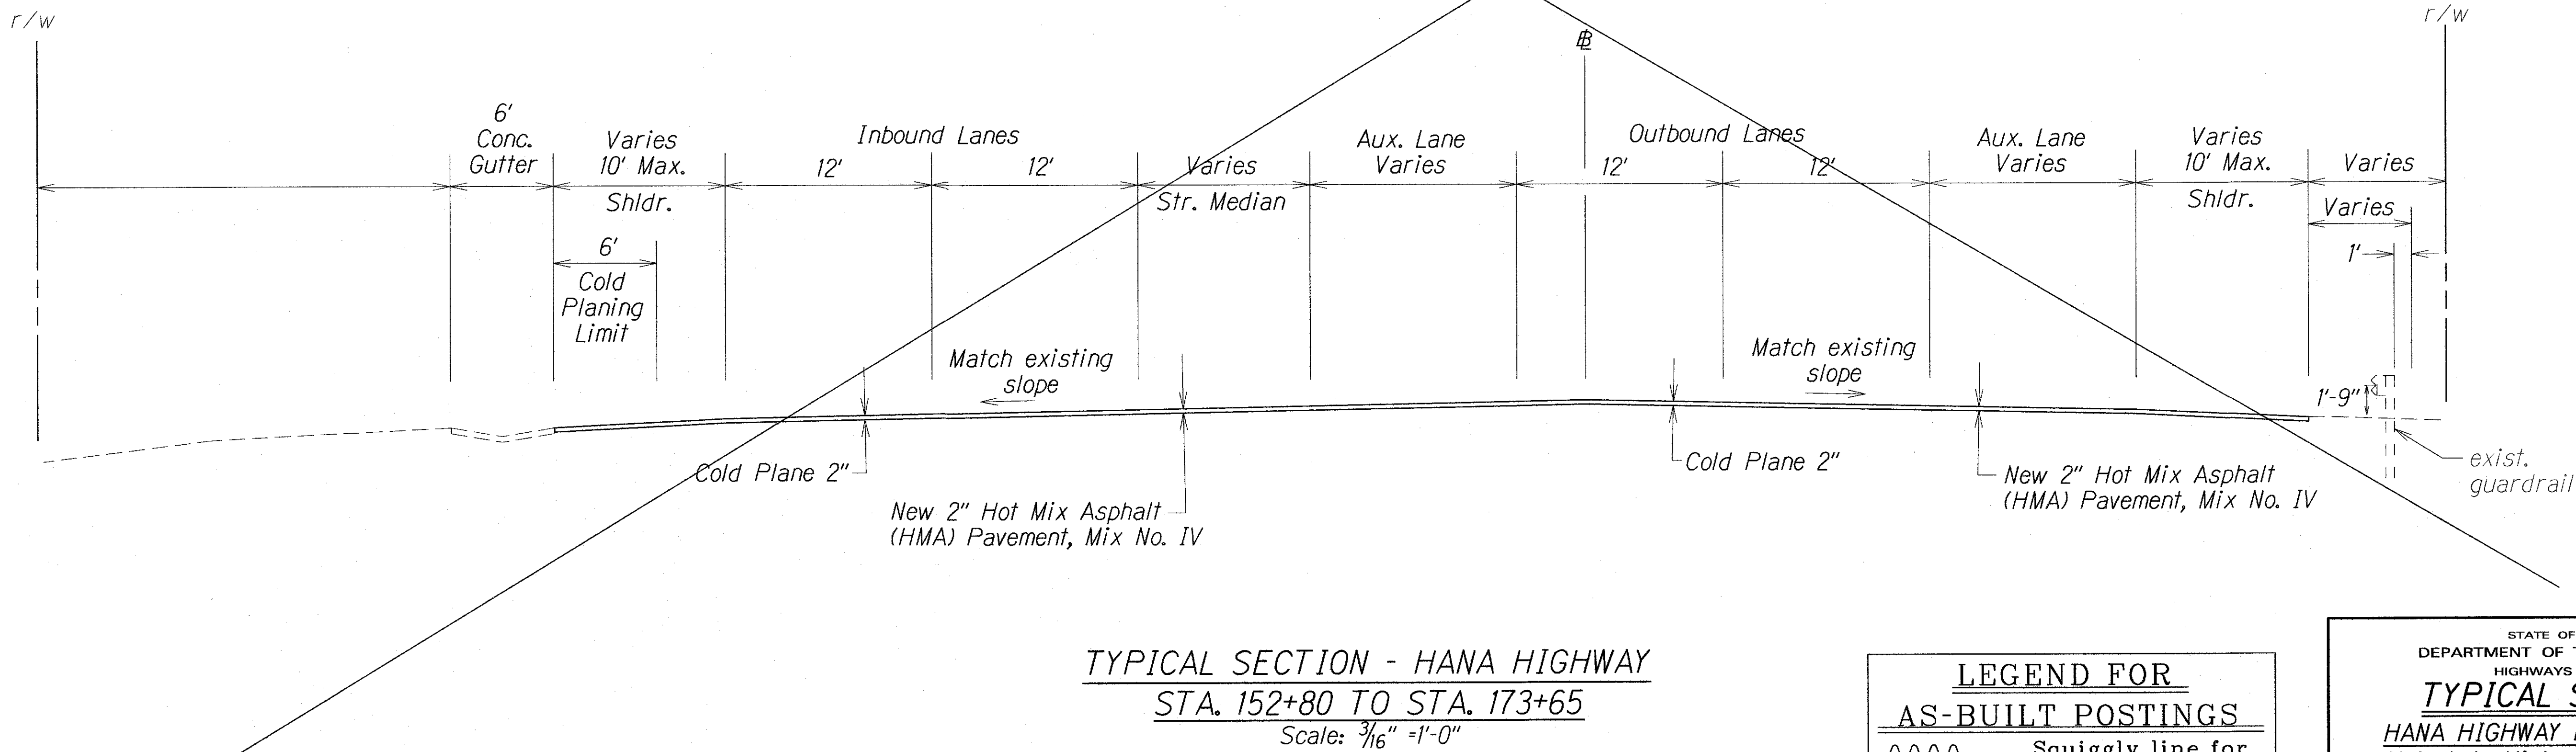


FED. ROAD DIST. NO.	STATE	PROJ. NO.	FISCAL YEAR	SHEET NO.	TOTAL SHEETS
HAWAII	HAW.	HWY-M-01-15M	2015	7	41

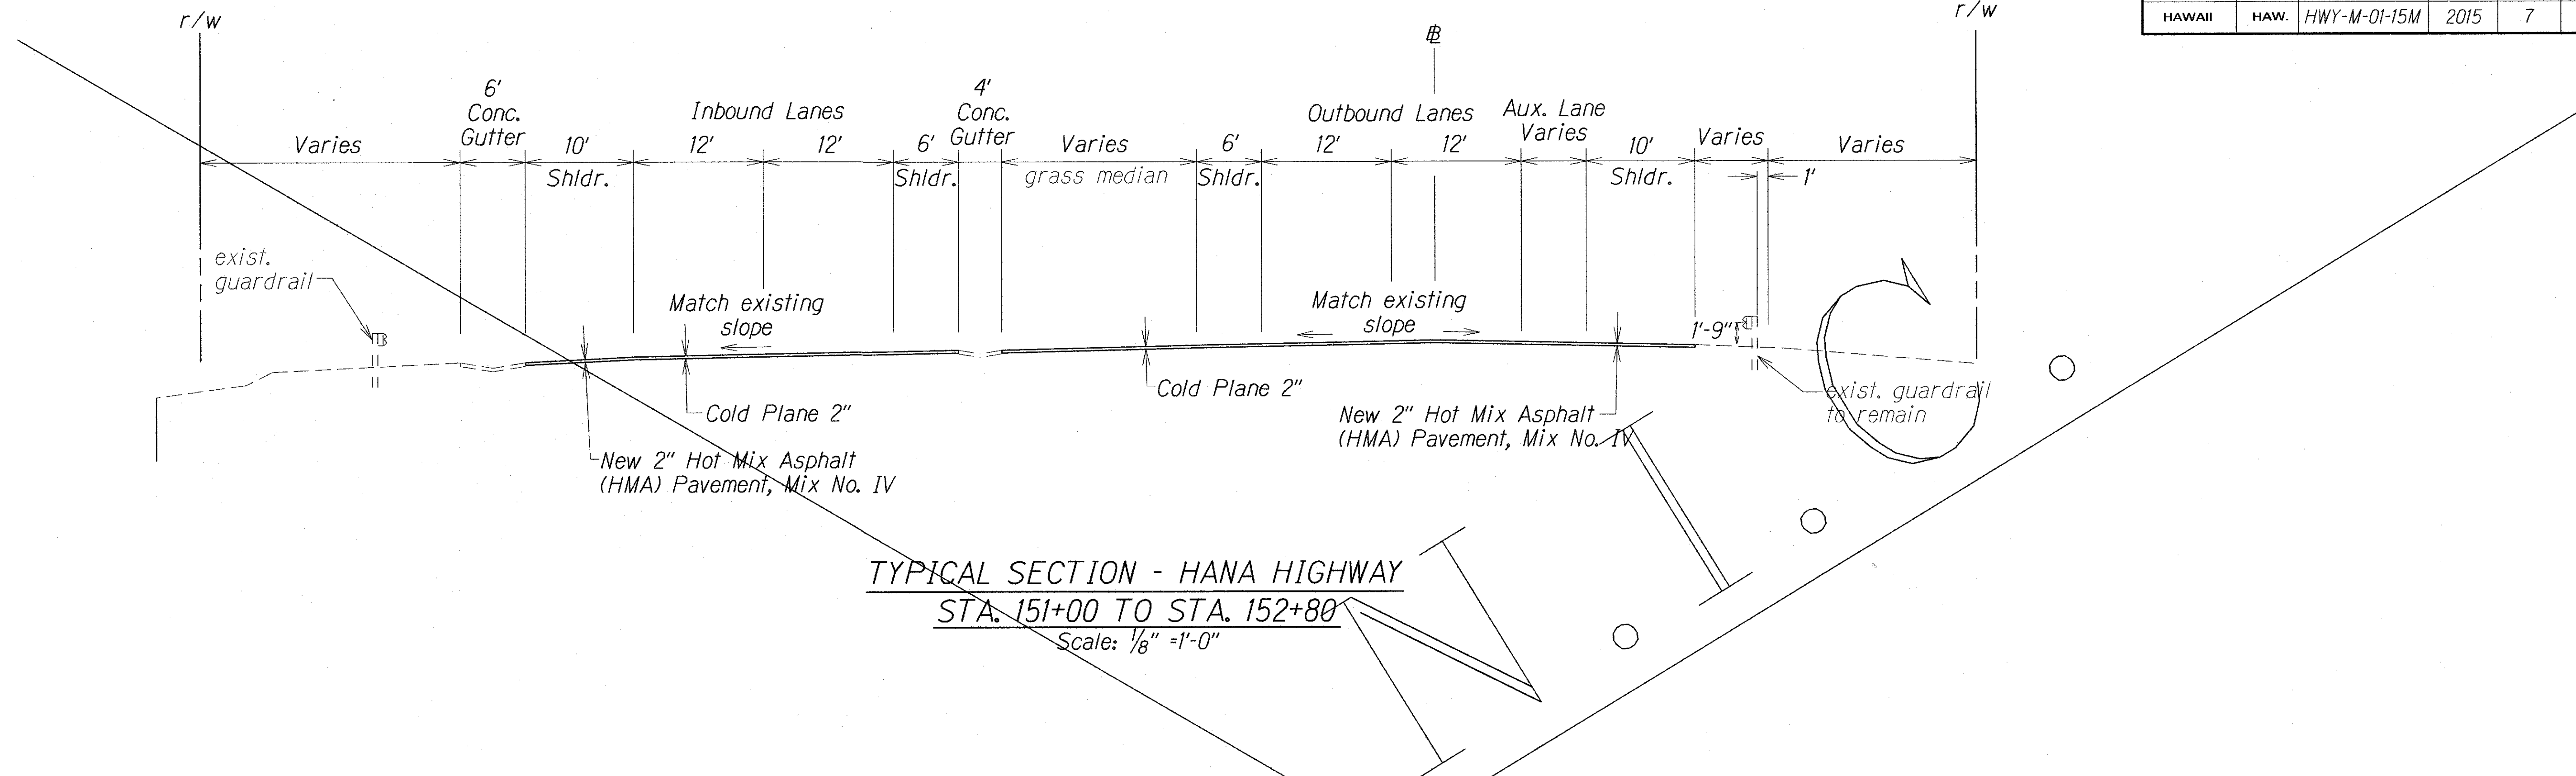

SURVEY PLOTTED BY	DATE
DESIGNED BY	
TRACED BY	
NOTED BY	
CHECKED BY	
ORIGINAL PLAN	
NOTE BOOK	
NO.	



LEGEND FOR AS-BUILT POSTINGS	
	Squiggly line for as-built deletion
	Double line for as-built deletion
Roadway	Text for as-built posting

STATE OF HAWAII  
DEPARTMENT OF TRANSPORTATION  
HIGHWAYS DIVISION  
**TYPICAL SECTIONS**  
HANA HIGHWAY RESURFACING  
Haleakala Highway to Paia and  
HALEAKALA HIGHWAY RESURFACING  
Hana Highway to North Firebreak Rd.  
Project No. HWY-M-01-15M  
Scale: As Shown      Date: March, 2015


SHEET No. 1 OF 5 SHEETS

"AS-BUILT"

FED. ROAD DIST. NO.	STATE	PROJ. NO.	FISCAL YEAR	SHEET NO.	TOTAL SHEETS
HAWAII	HAW.	HWY-M-01-15M	2015	8	41

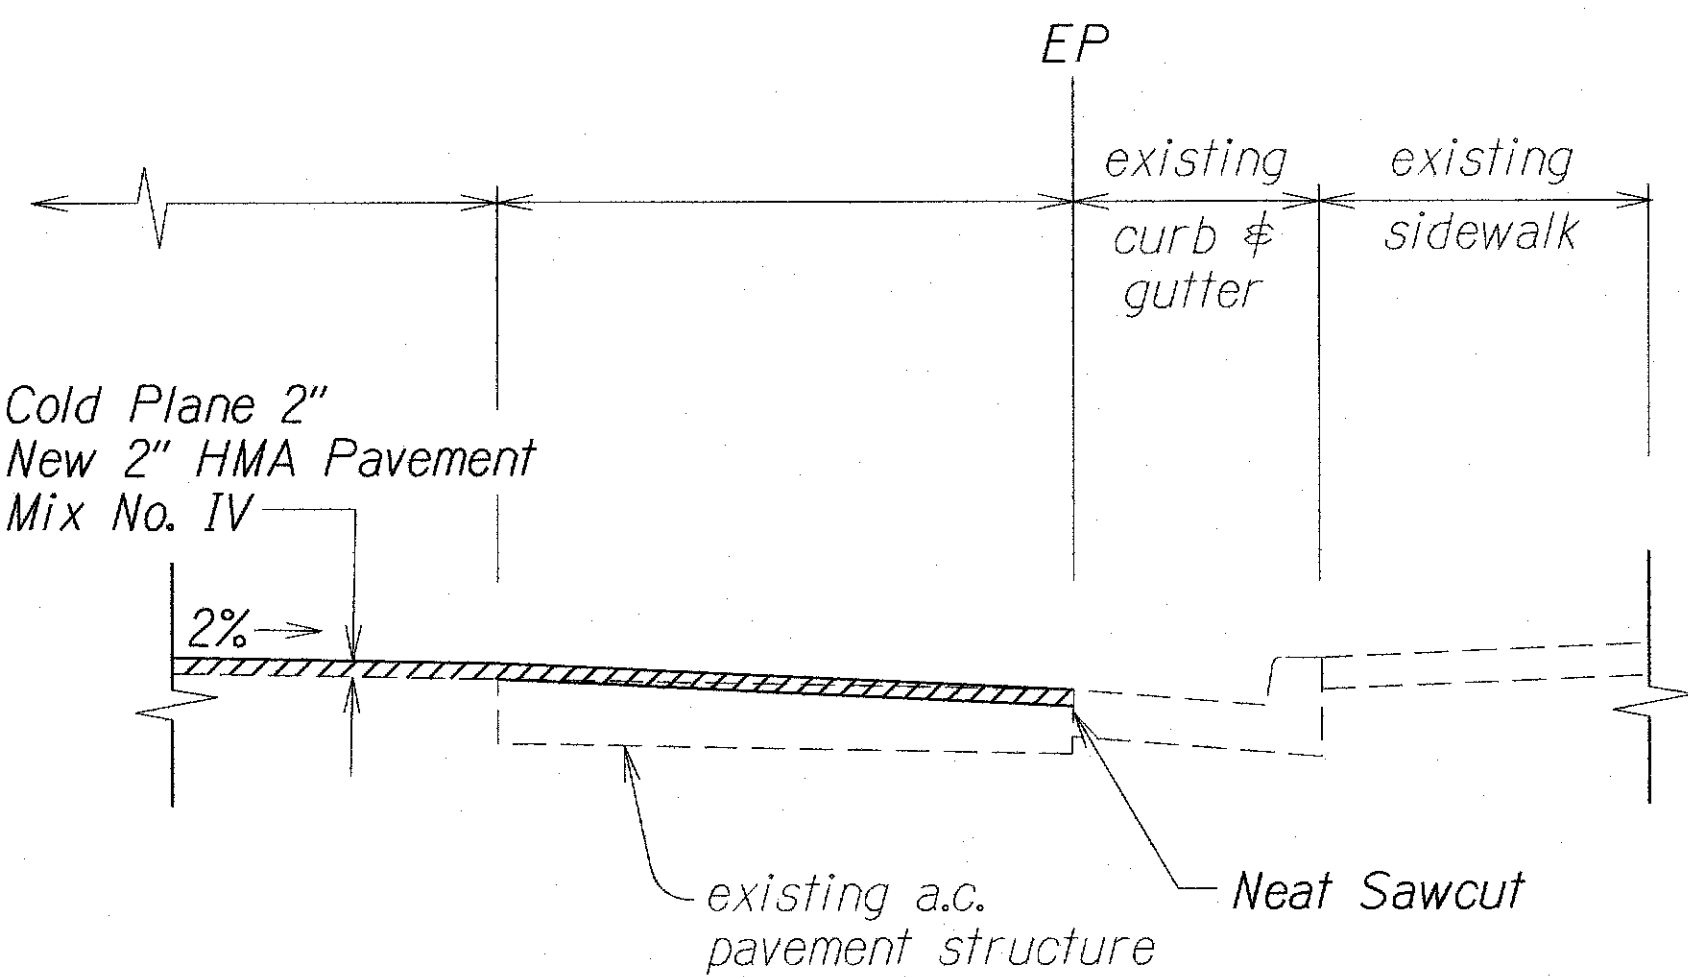
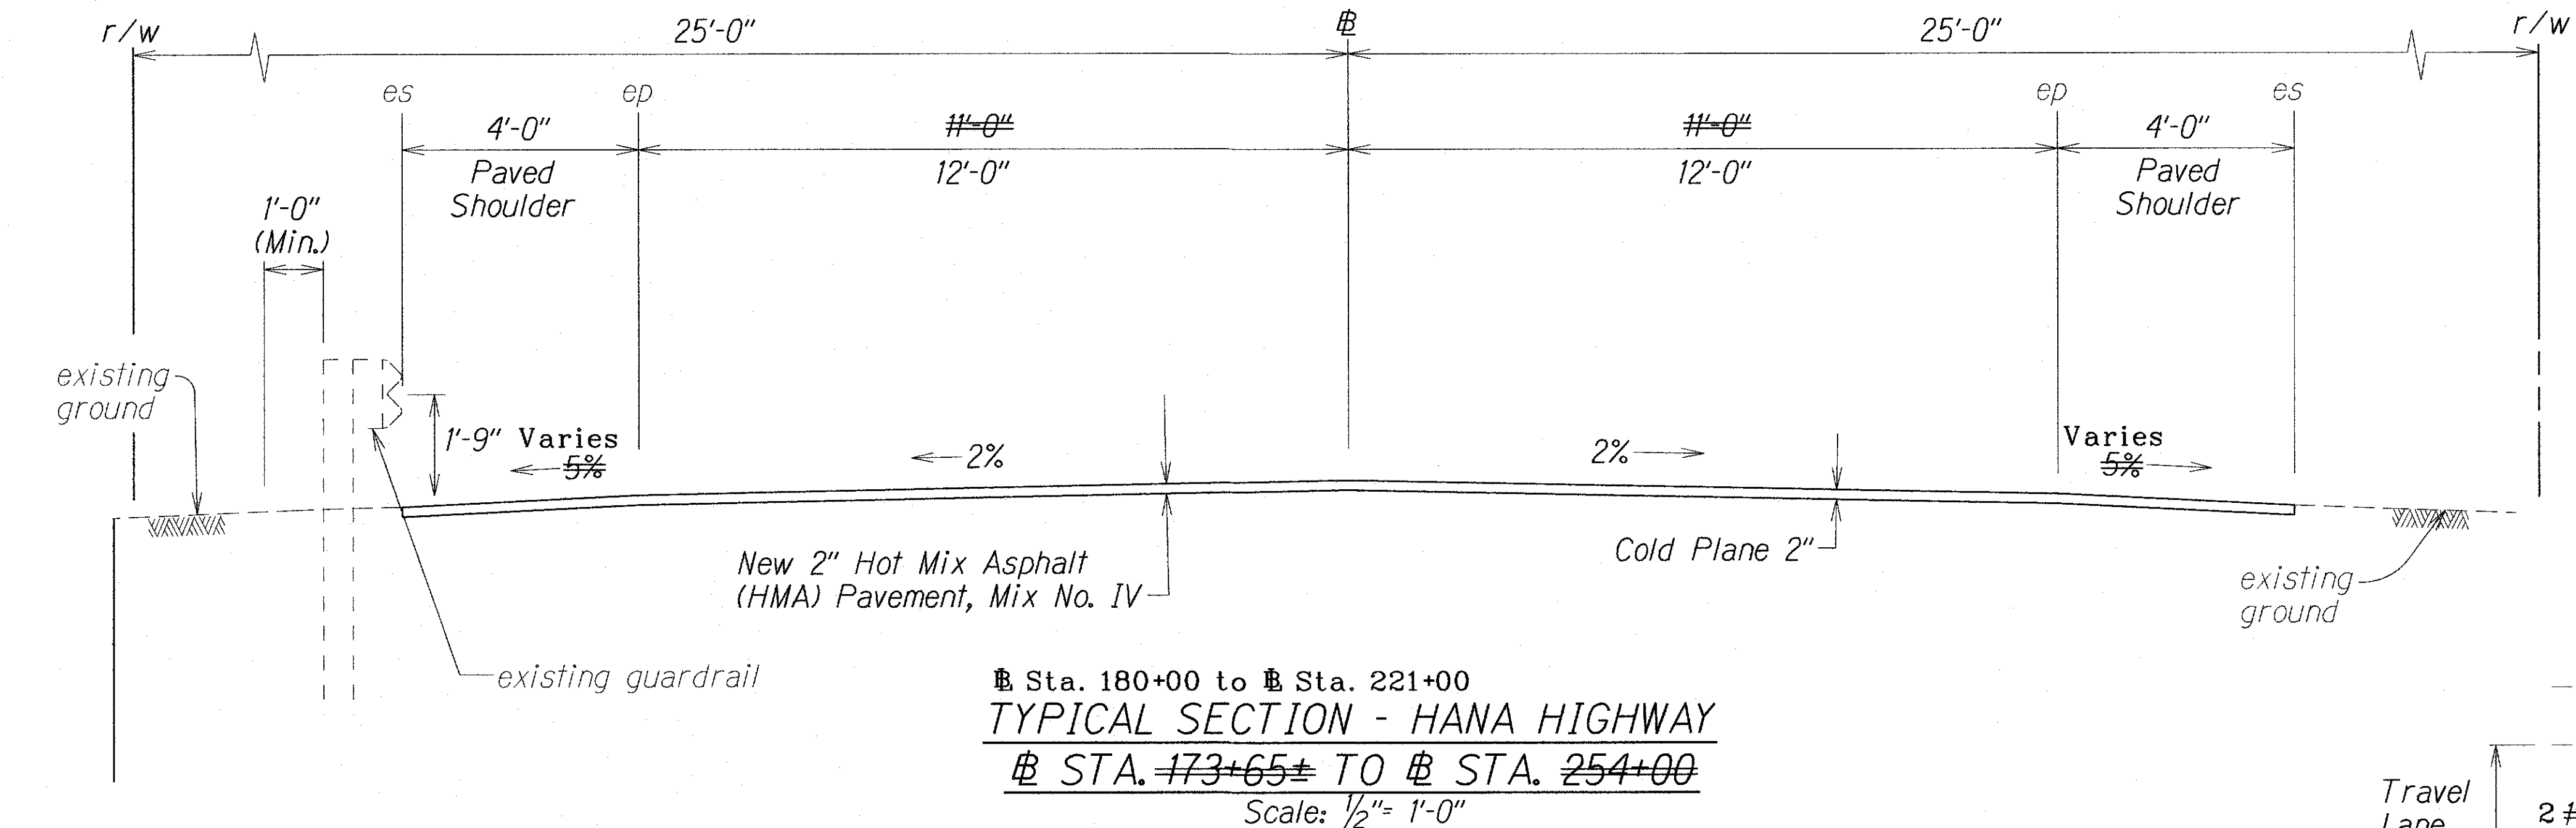


Note: In cold planing the pavement over the structure, the Contractor shall exercise care not to damage any portion of the structure, especially the slab, joints, drainage pipes or reinforcement. Any damage to the structure during the cold planing operations shall be repaired by the Contractor at his expense. Repair work shall be directed by the Engineer. The Contractor shall verify the thickness of the pavement by taking several measurements throughout the structure.

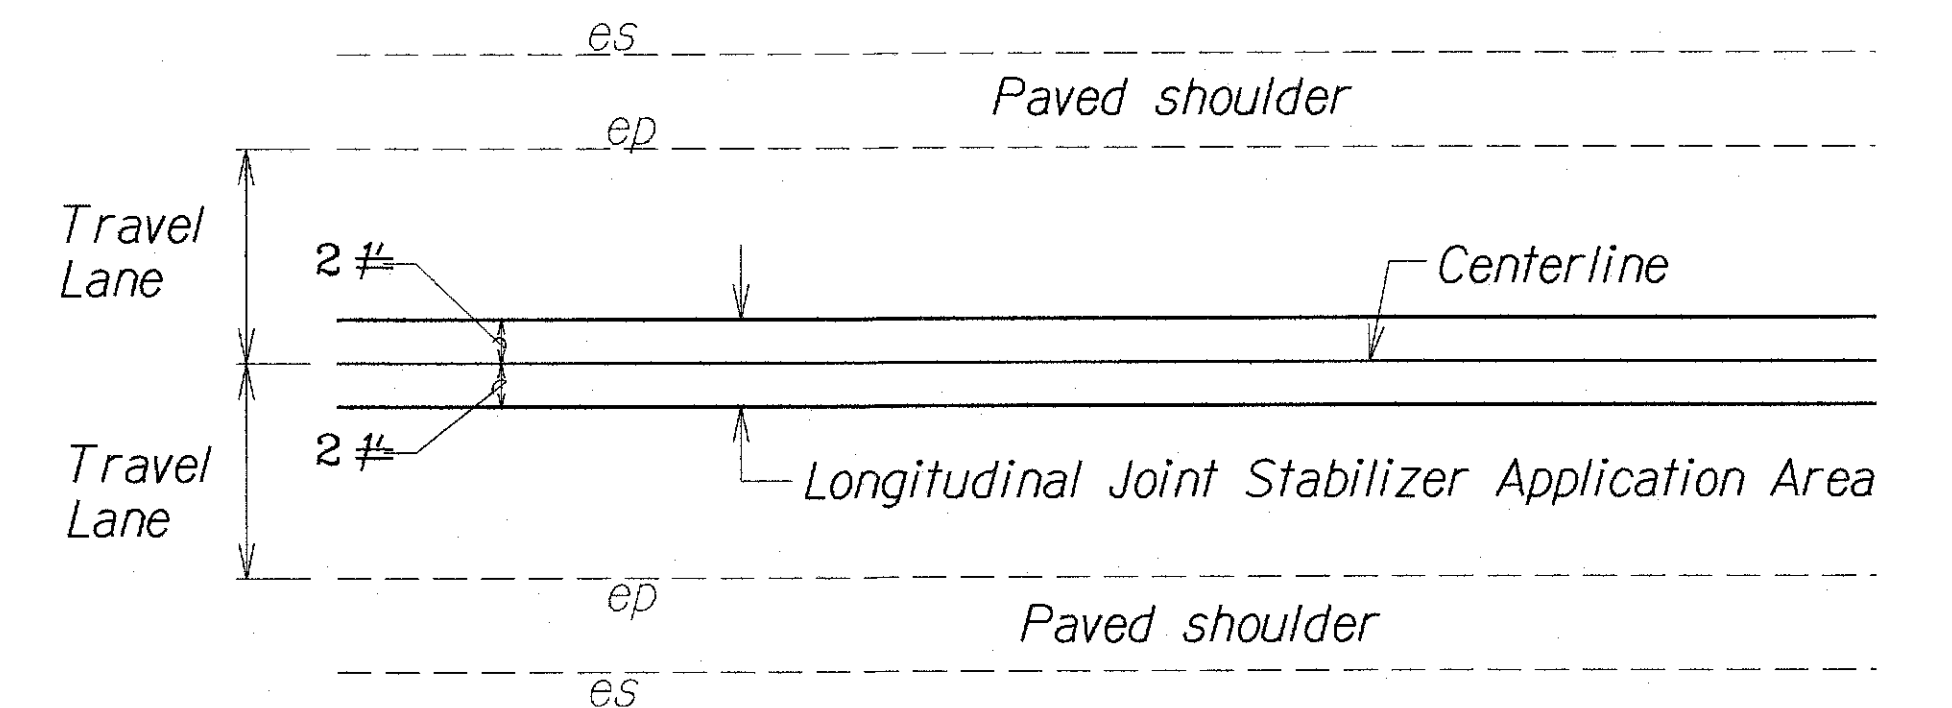

TYPICAL SECTION FOR  
LONGITUDINAL JOINT STABILIZER  
Not To Scale



LEGEND FOR AS-BUILT POSTINGS	
	Squiggly line for as-built deletion
	Double line for as-built deletion
	Text for as-built posting

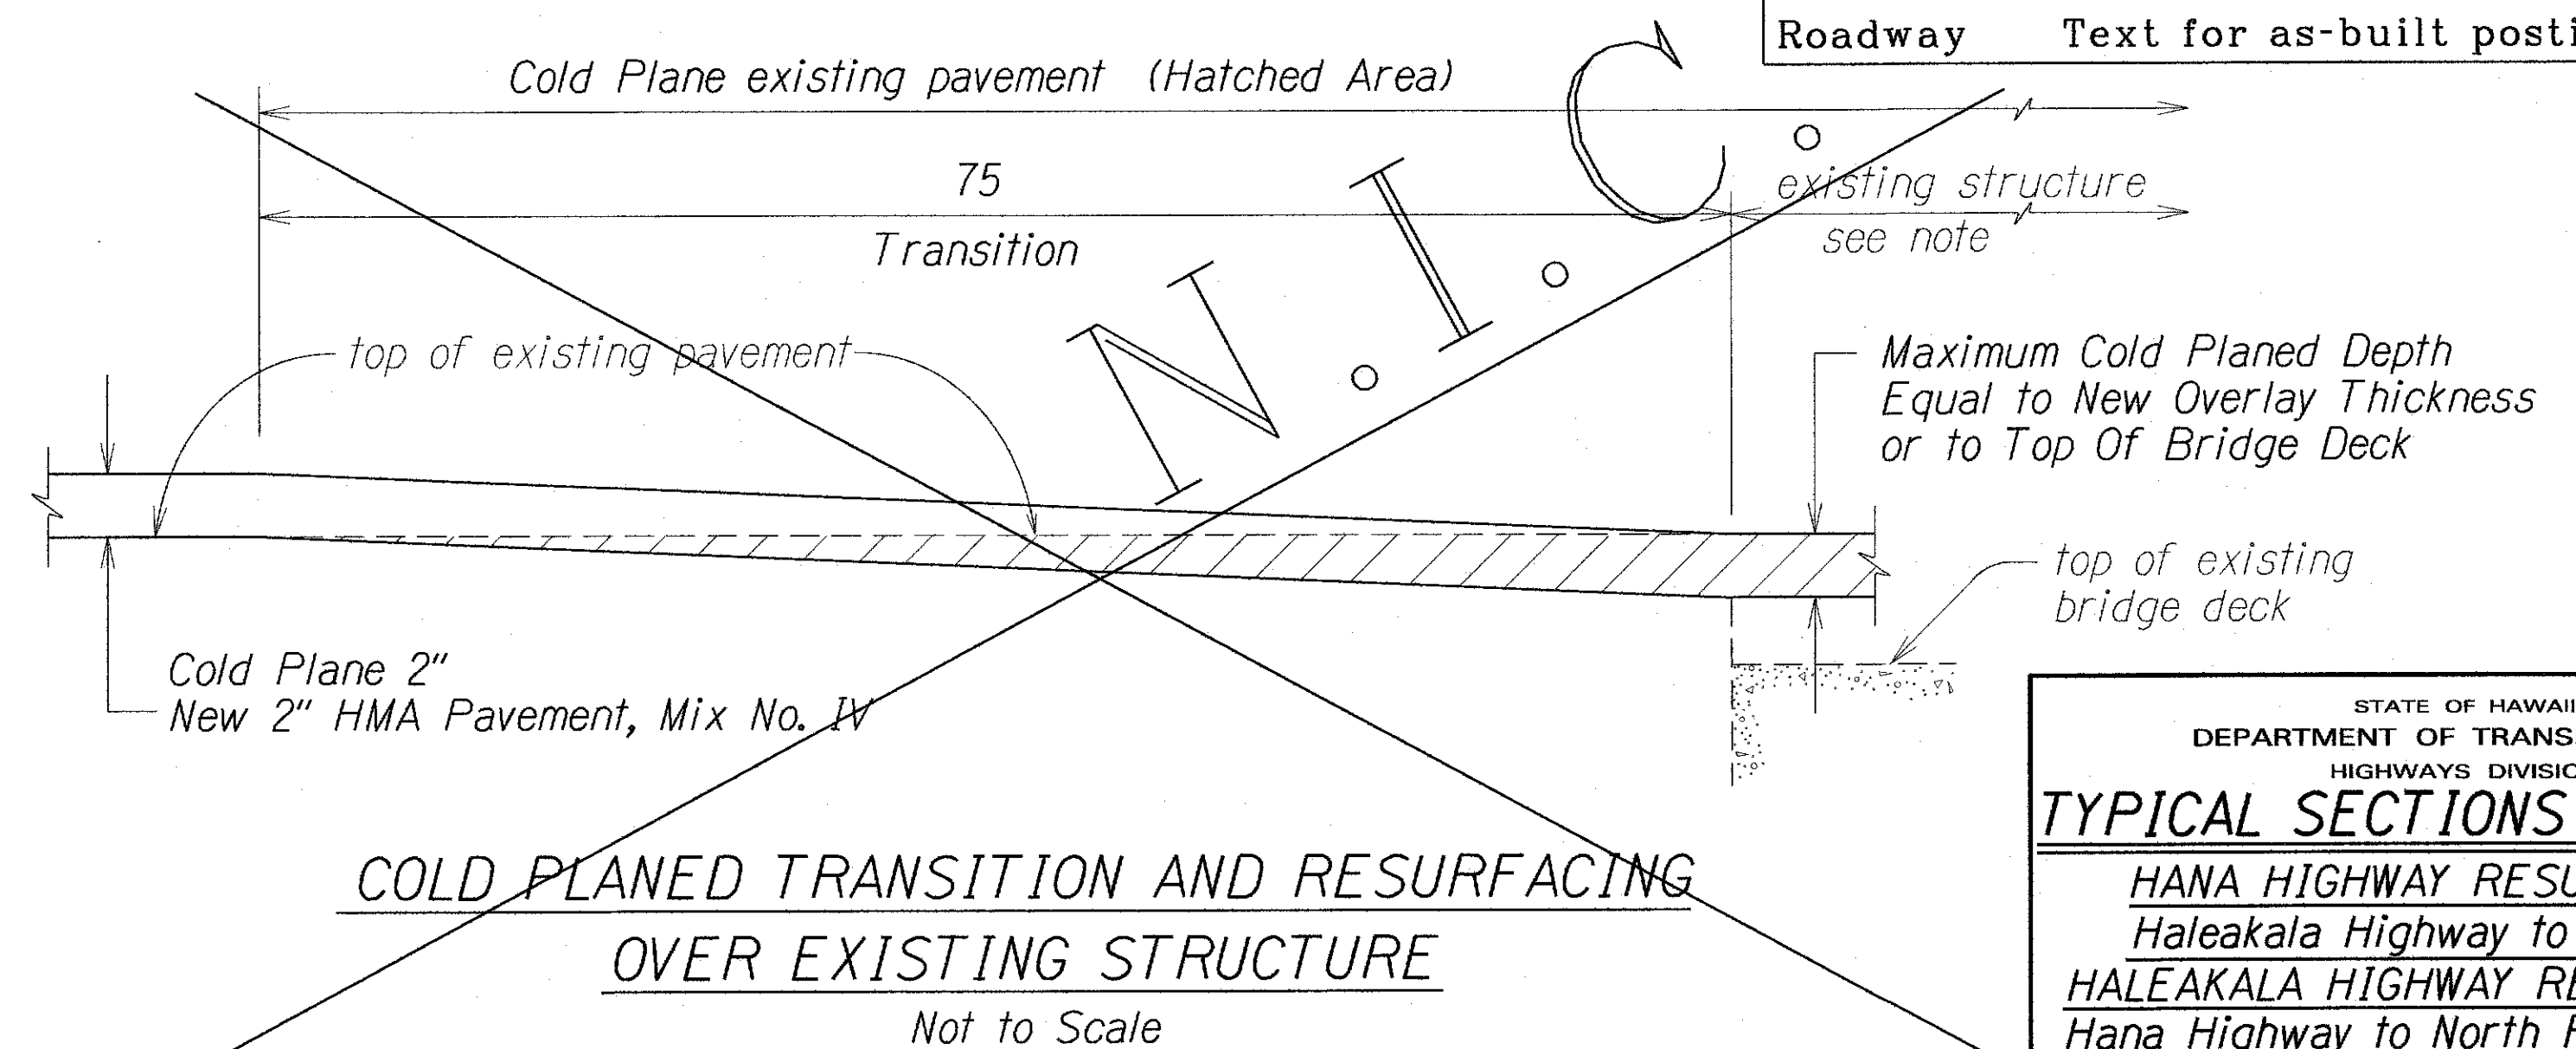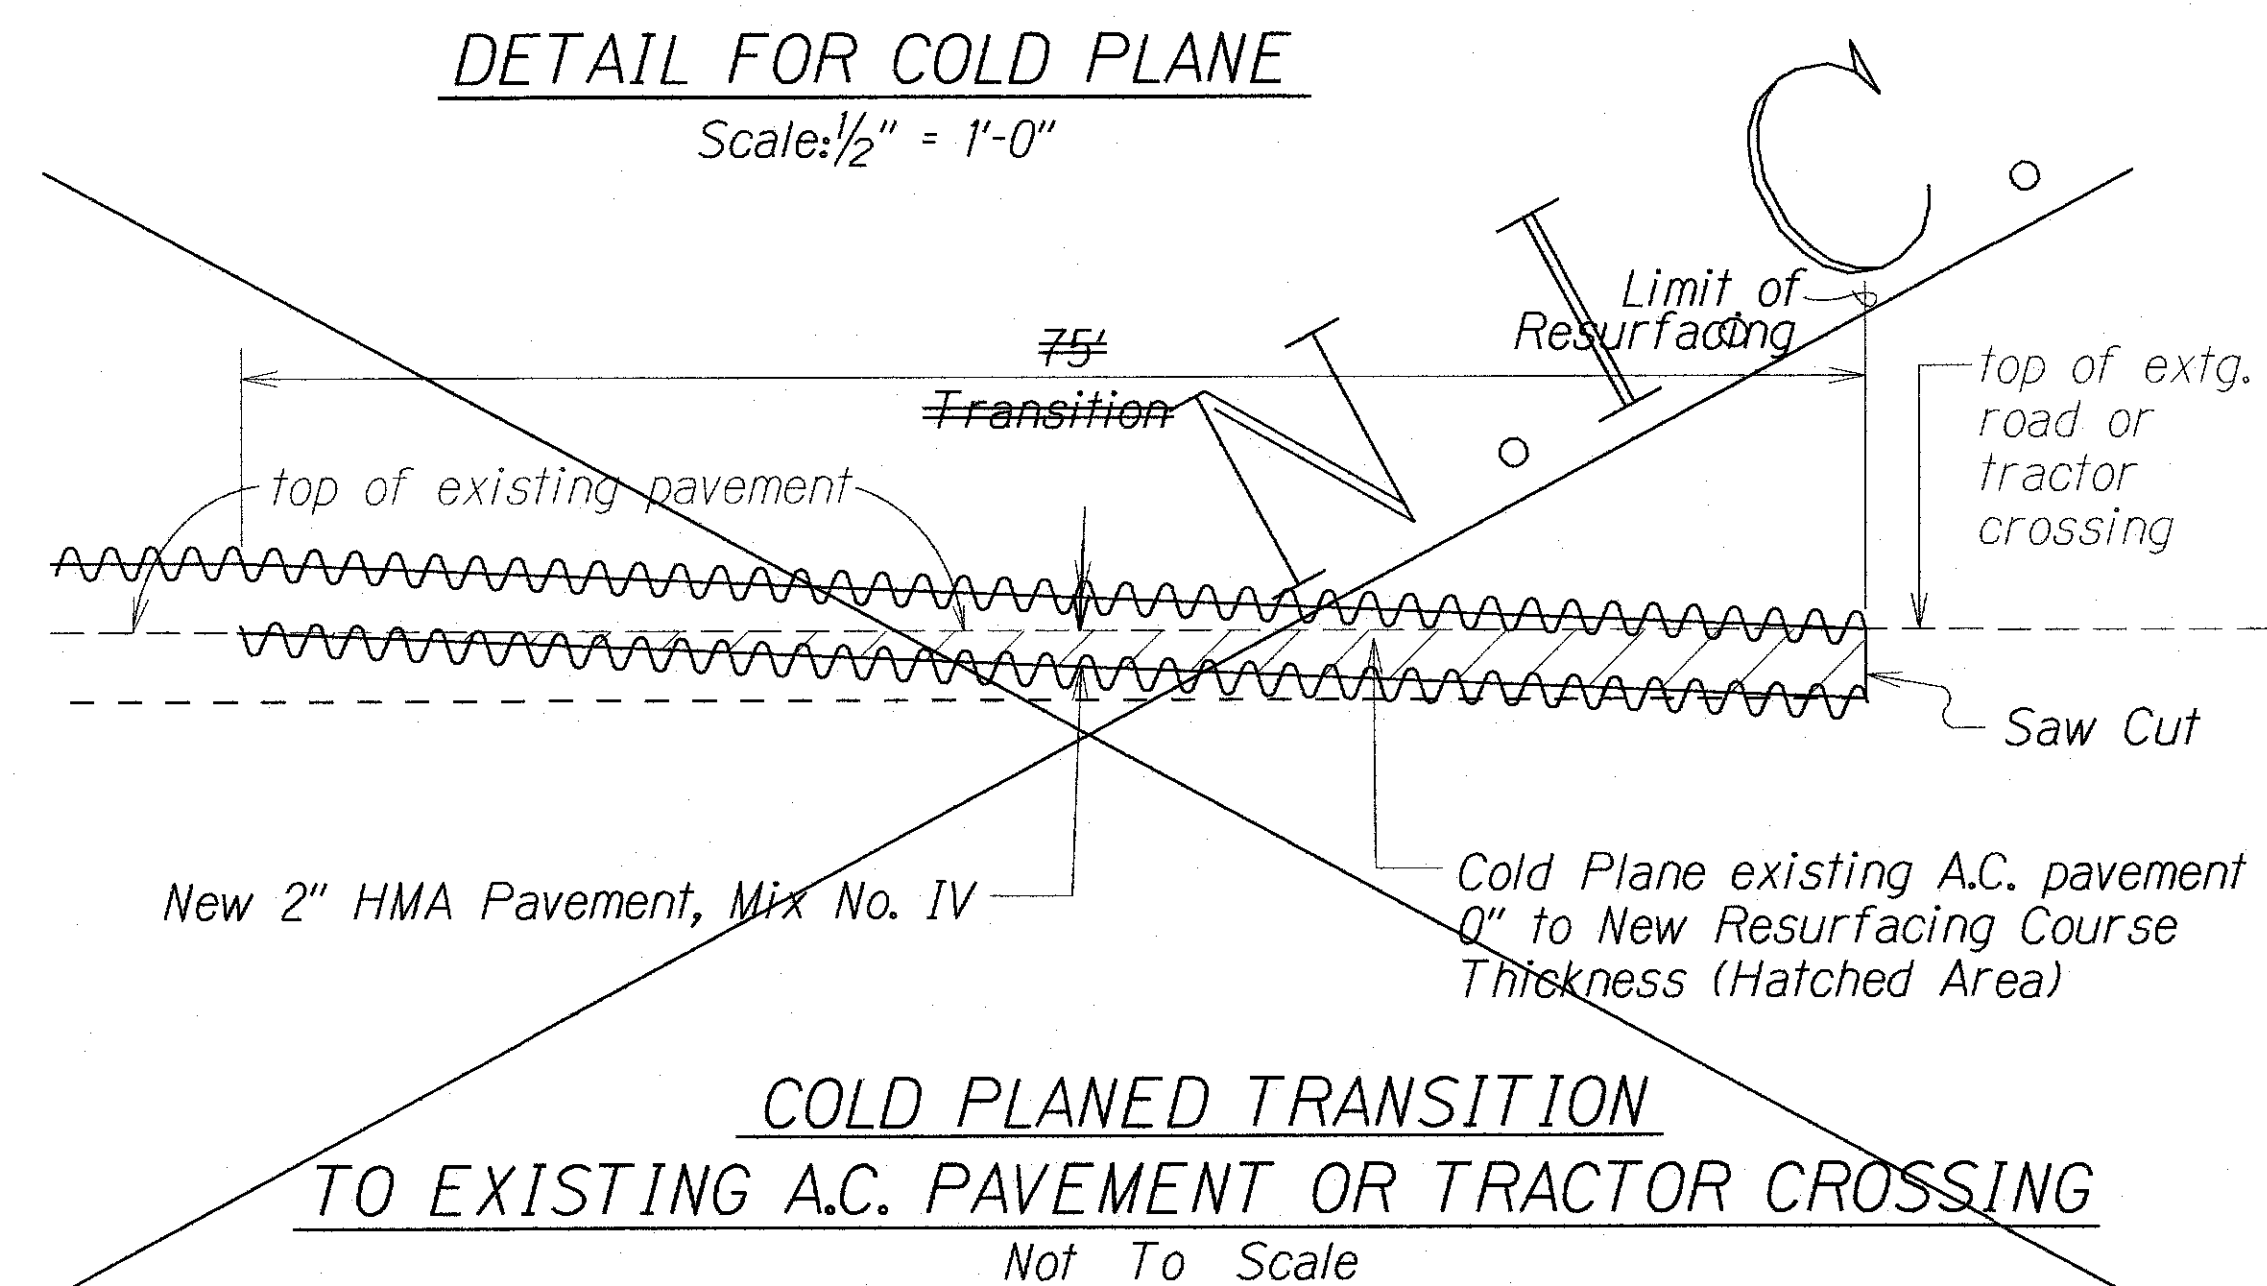

STATE OF HAWAII DEPARTMENT OF TRANSPORTATION HIGHWAYS DIVISION	
<b>TYPICAL SECTIONS &amp; DETAILS</b>	
HANA HIGHWAY RESURFACING Haleakala Highway to Paia and HALEAKALA HIGHWAY RESURFACING Hana Highway to North Firebreak Rd. Project No. HWY-M-01-15M	
Scale: As Shown	Date: March, 2015
SHEET No. 2 OF 5 SHEETS	

"AS-BUILT"

FED. ROAD DIST. NO.	STATE	PROJ. NO.	FISCAL YEAR	SHEET NO.	TOTAL SHEETS
HAWAII	HAW.	HWY-M-01-15M	2015	9	41

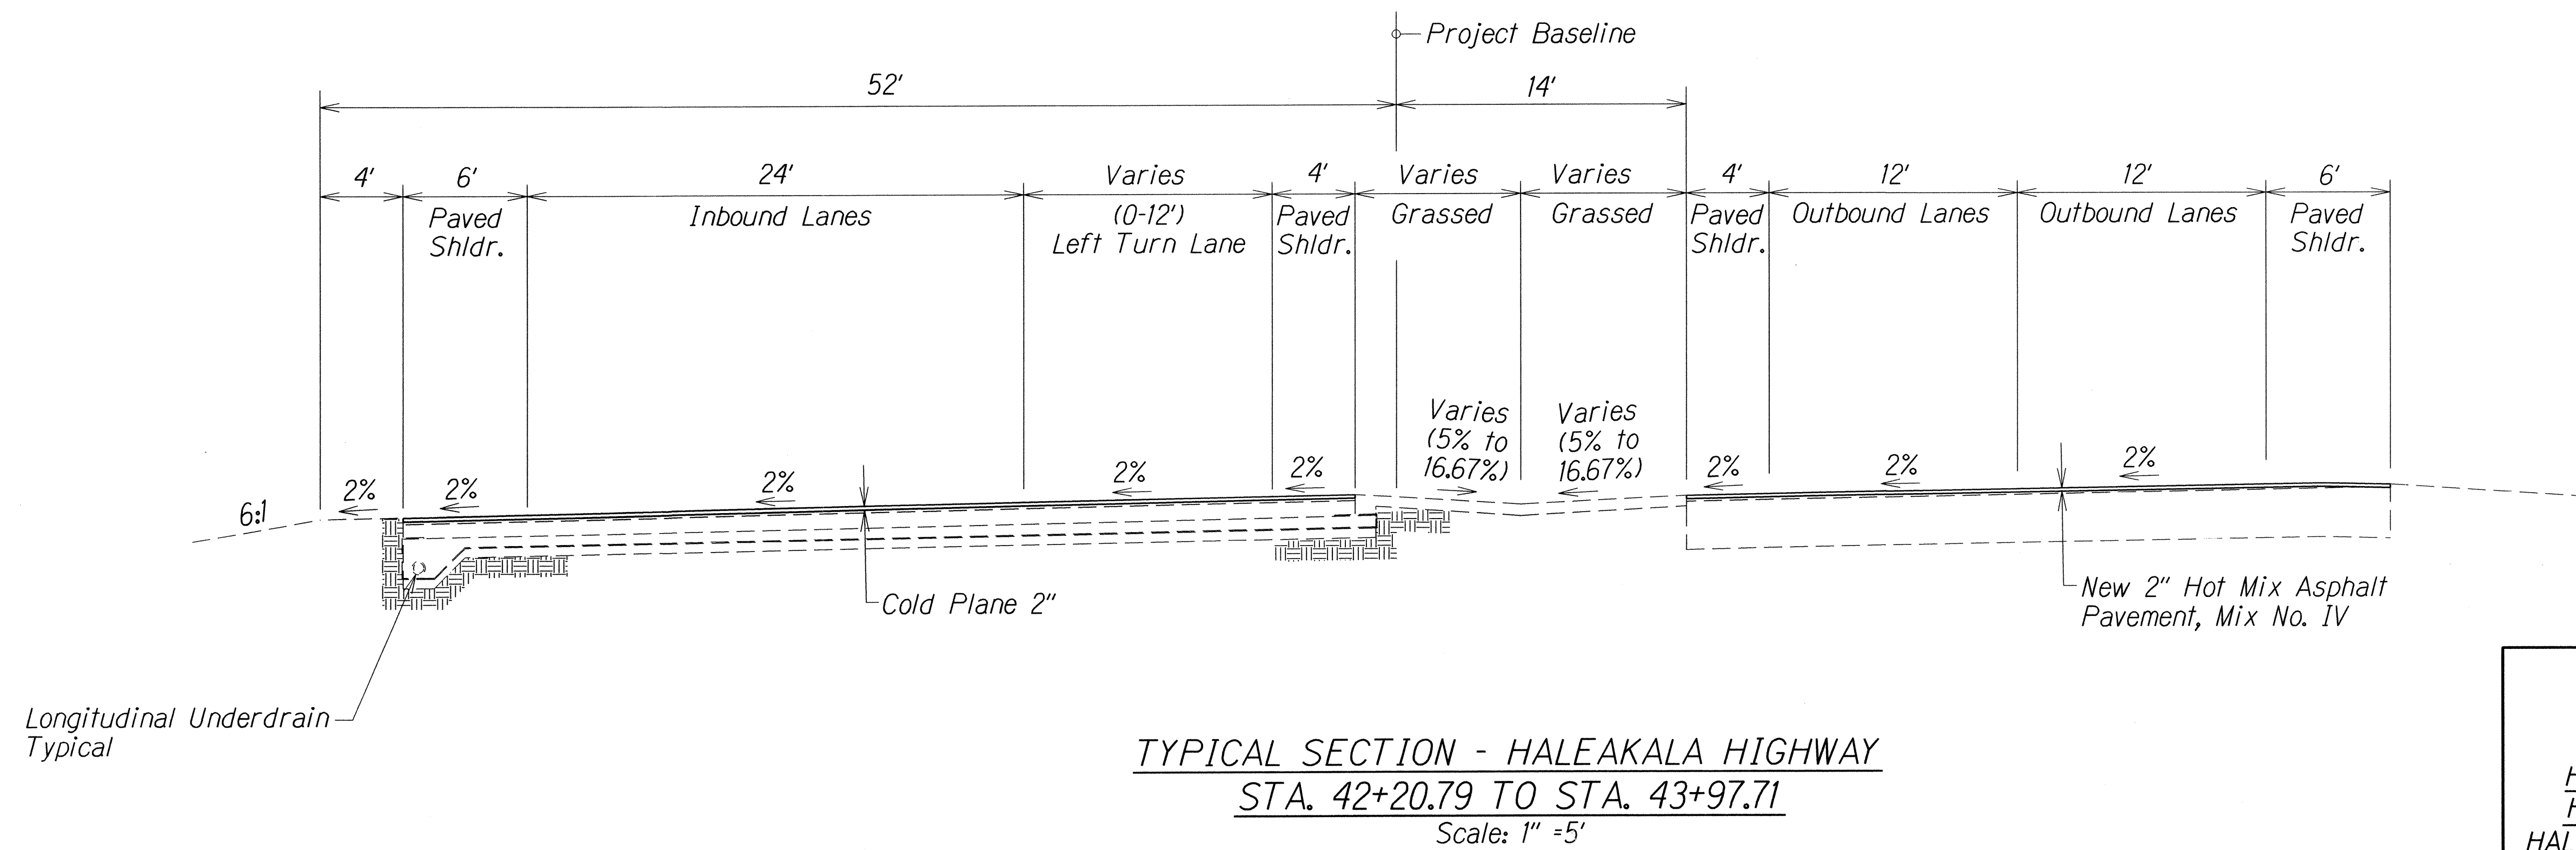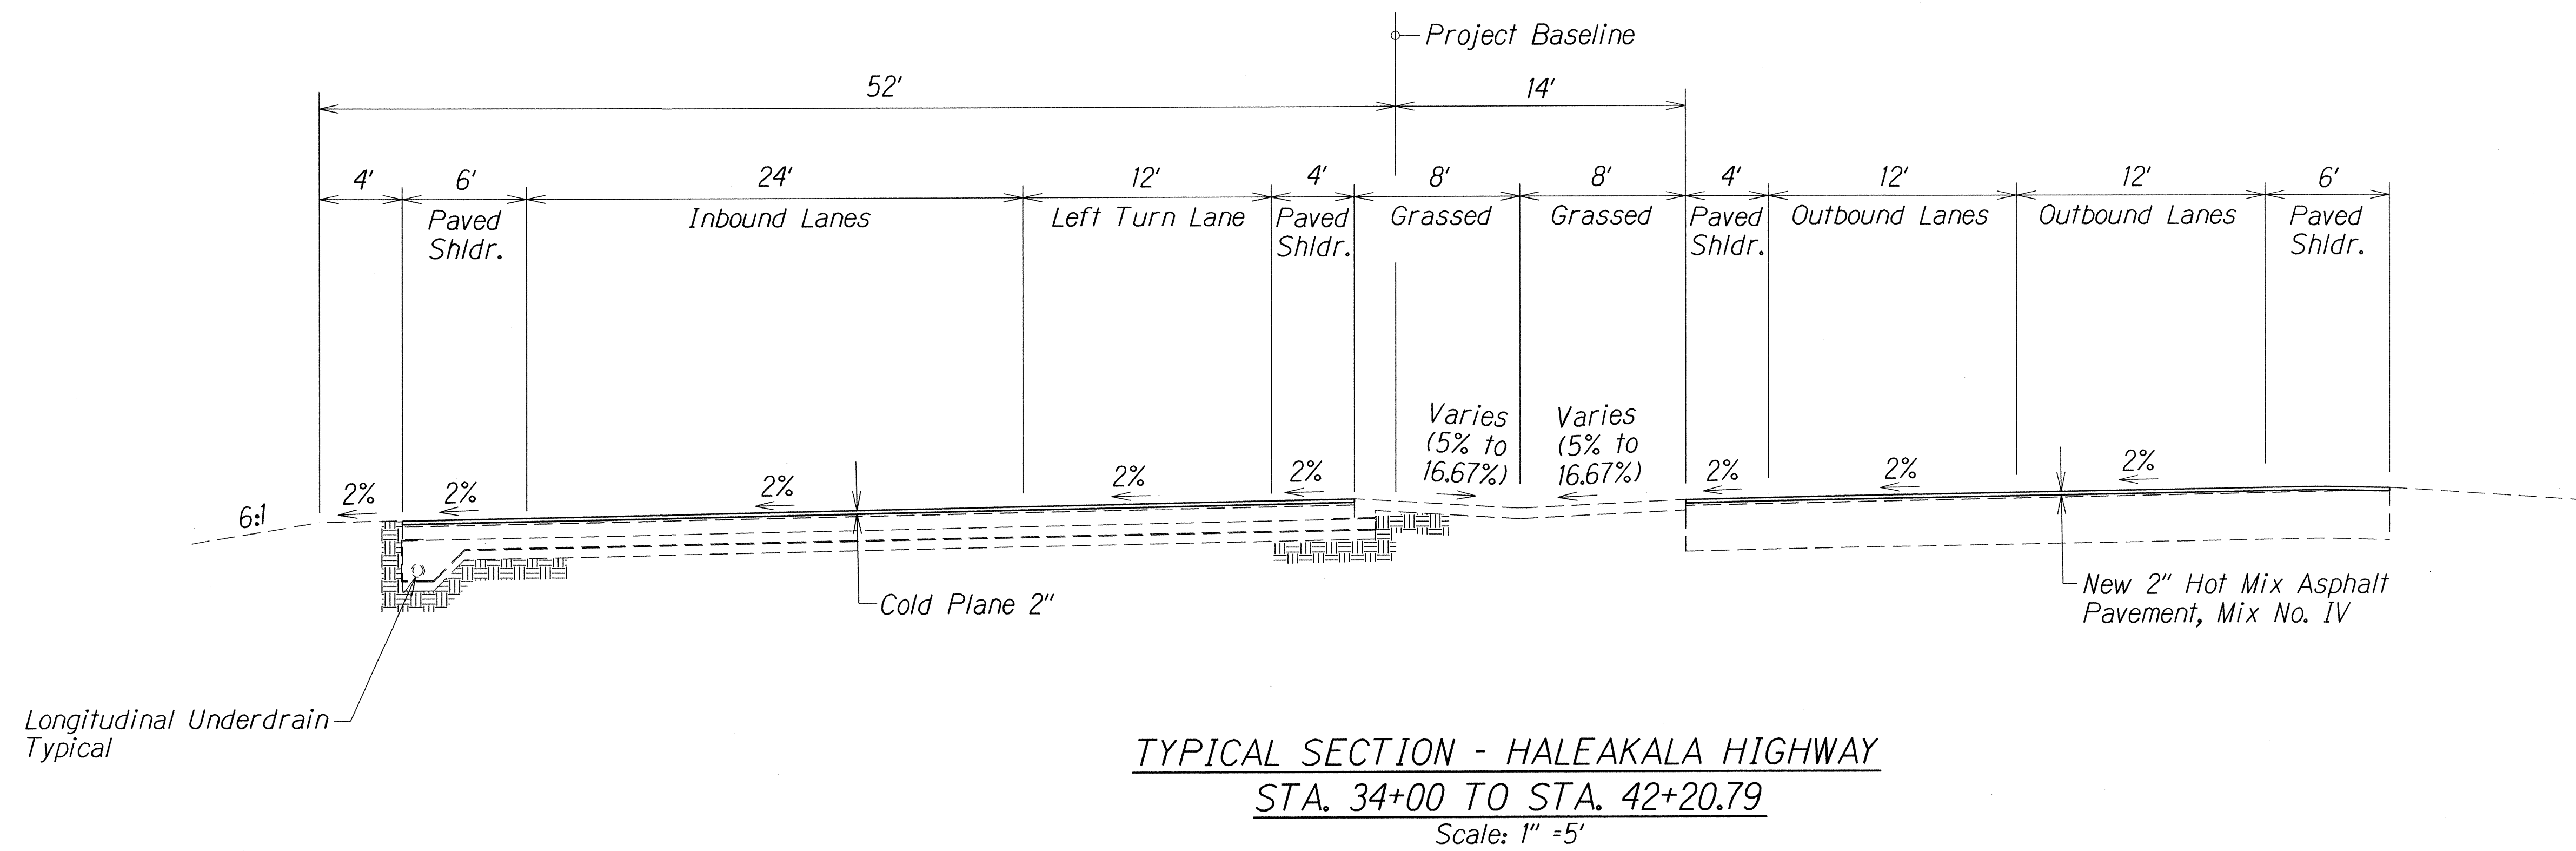

SURVEY PLOTTED BY	DATE
DRAWN BY	
DESIGNED BY	
CHECKED BY	
ORIGINAL PLAN	
NOTE BOOK	
NO.	

STATE OF HAWAII  
 DEPARTMENT OF TRANSPORTATION  
 HIGHWAYS DIVISION

**TYPICAL SECTIONS**

HANA HIGHWAY RESURFACING  
 Haleakala Highway to Paia and  
 HALEAKALA HIGHWAY RESURFACING  
 Hana Highway to North Firebreak Rd.  
 Project No. HWY-M-01-15M


Scale: As Shown Date: March, 2015

SHEET No. 3 OF 5 SHEETS






FED. ROAD DIST. NO.	STATE	PROJ. NO.	FISCAL YEAR	SHEET NO.	TOTAL SHEETS
HAWAII	HAW.	HWY-M-01-15M	2015	11	41

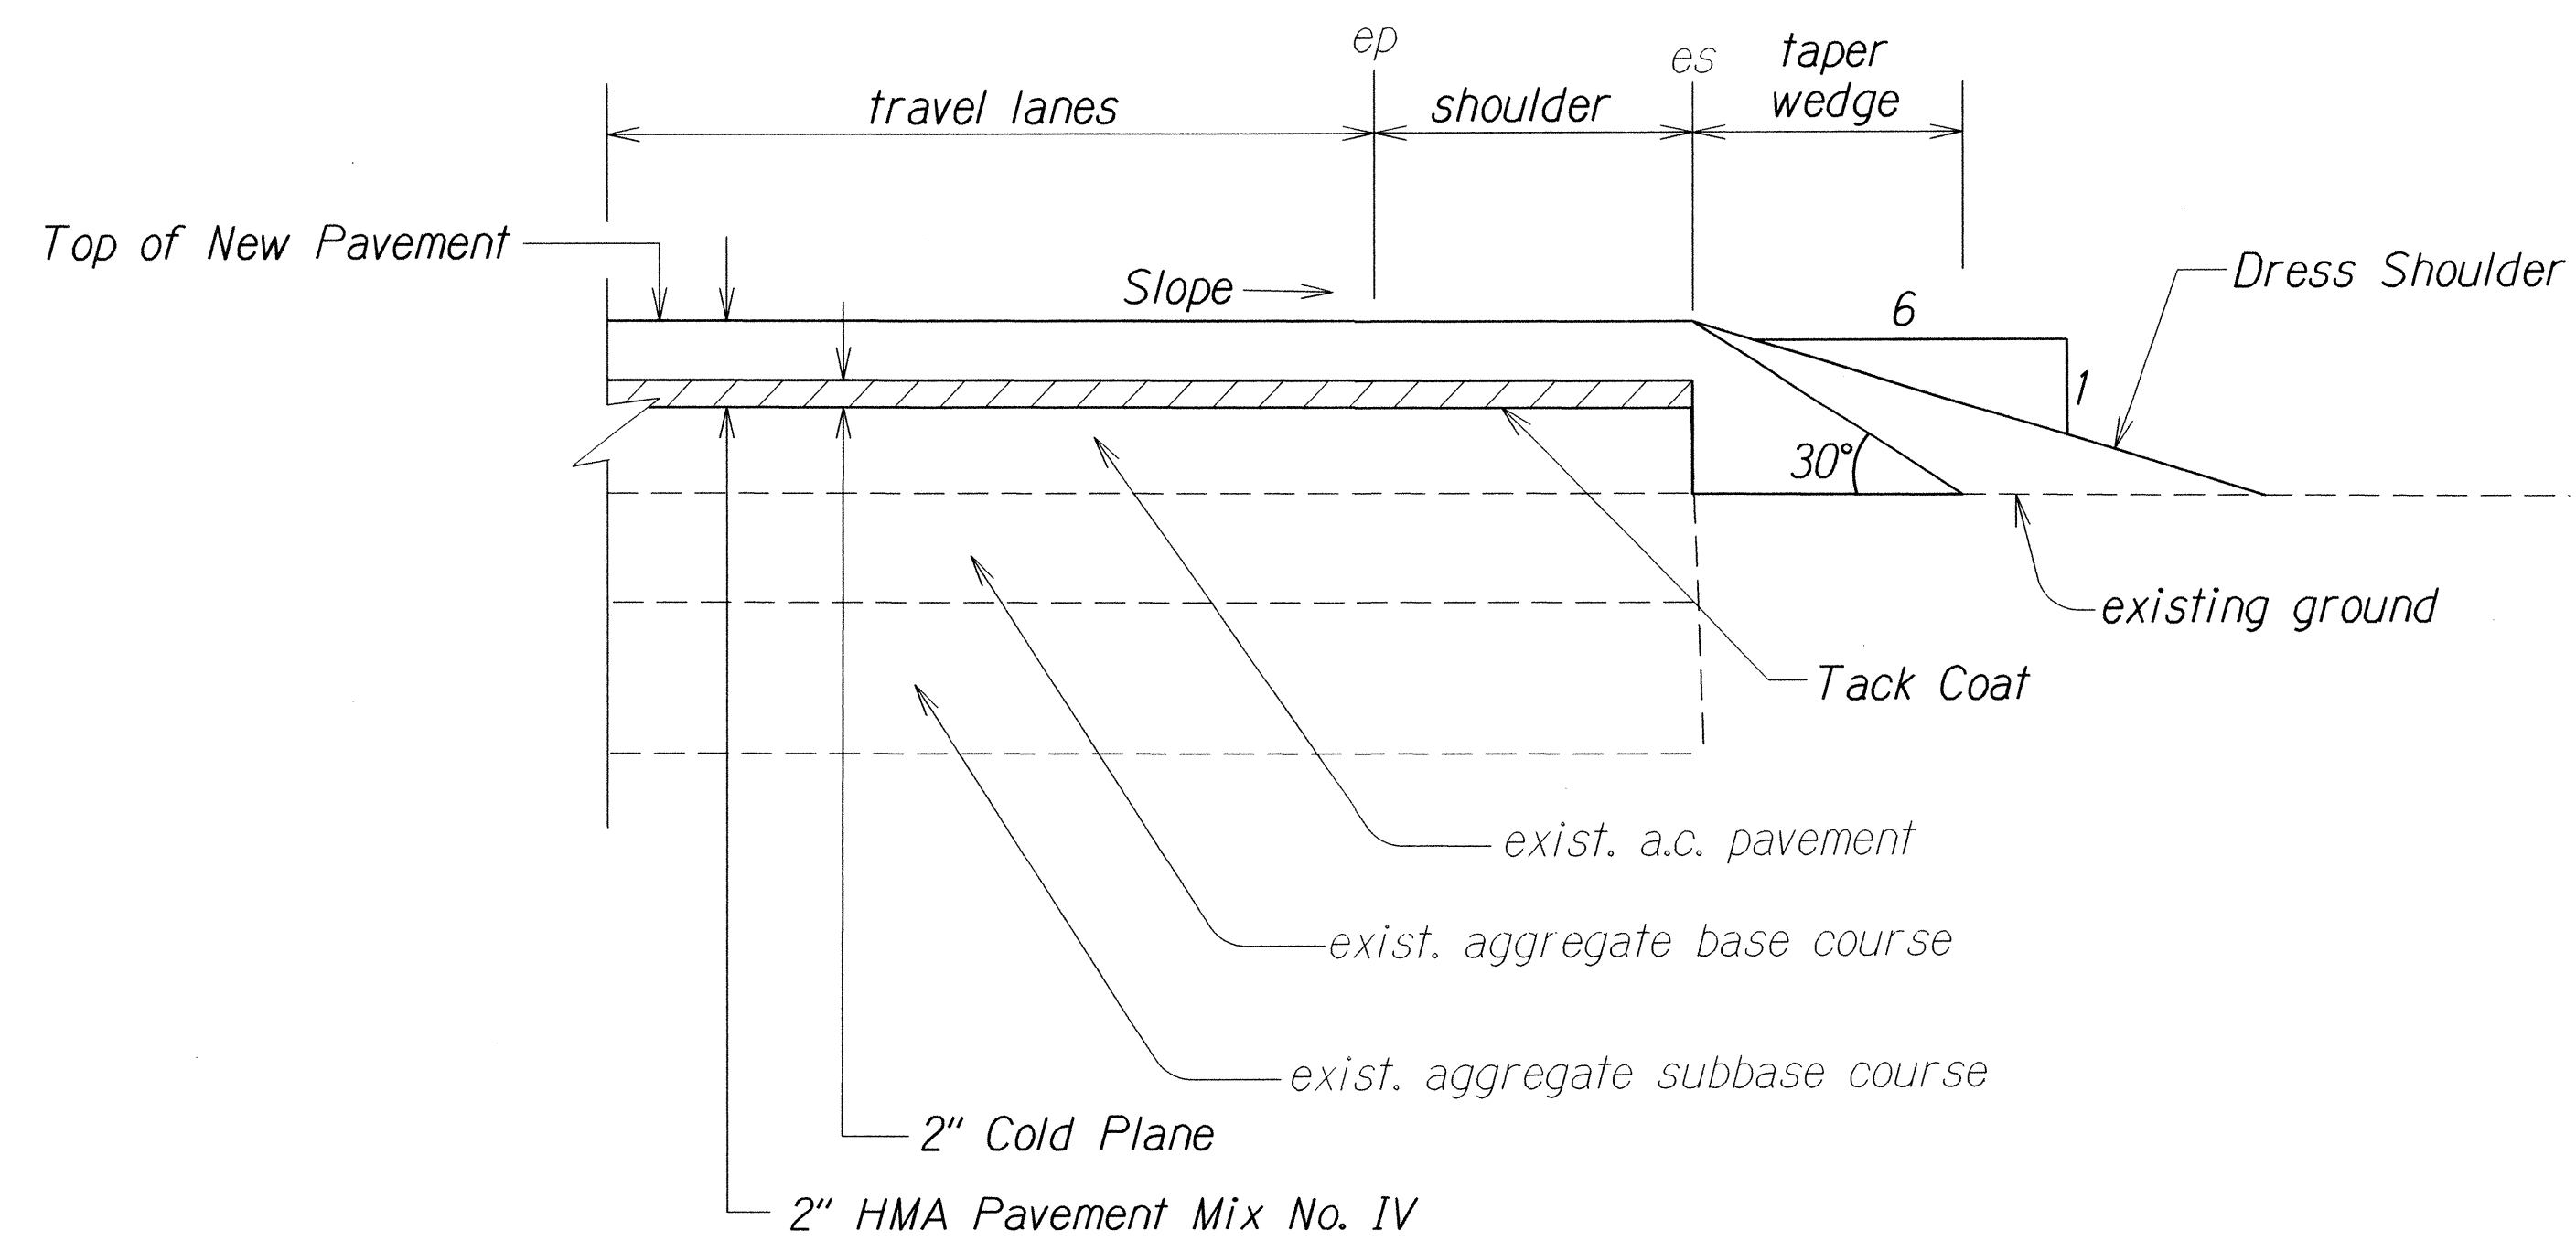

Note: Contractor shall mount a device directly on the paver screed extension to provide a 30° beveled shoulder edge.

TYPICAL PAVEMENT EDGE DETAIL  
Not To Scale

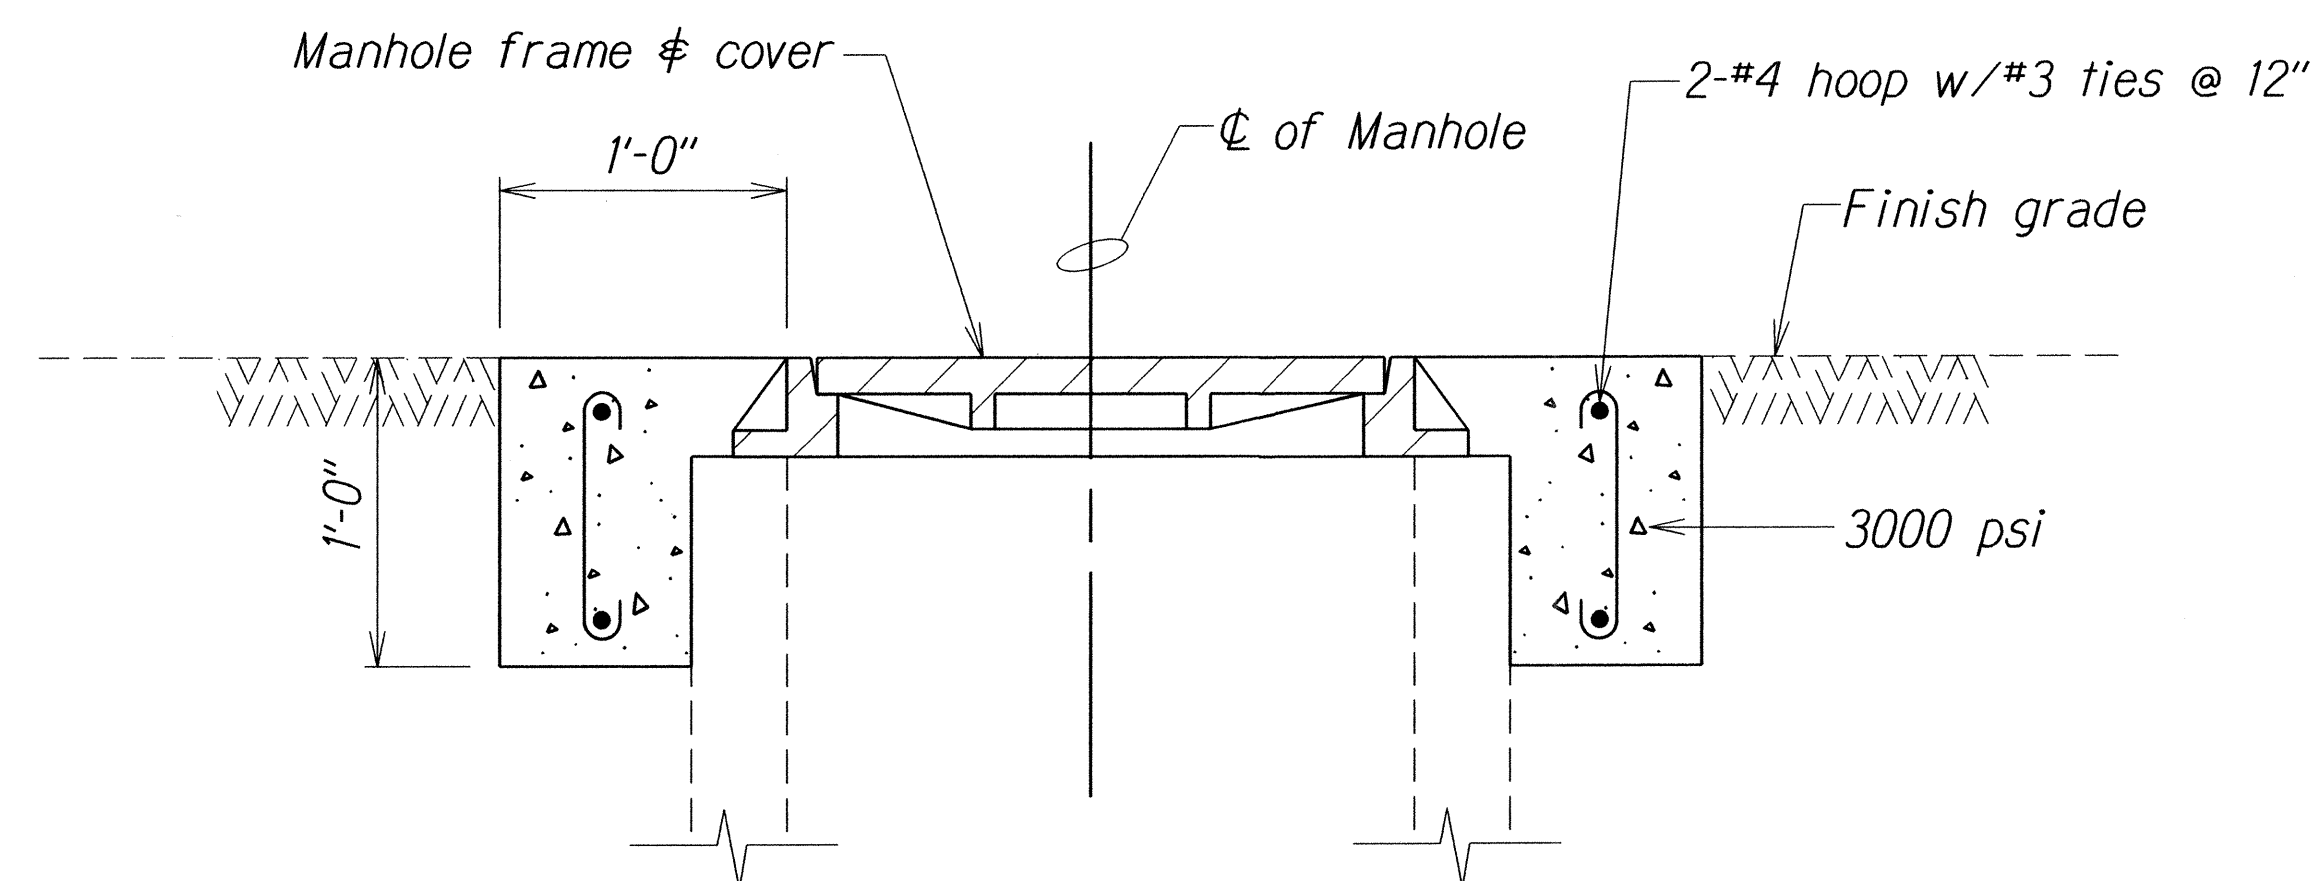

DETAIL - CONCRETE COLLAR FOR  
ADJUSTMENTS OF MANHOLES AND VALVE BOX  
Not To Scale



ORIGINAL PLAN	SURVEY PLOTTED BY	DATE
NOTE BOOK	DRAWN BY	
	DESIGNED BY	
	CHECKED BY	

STATE OF HAWAII  
DEPARTMENT OF TRANSPORTATION  
HIGHWAYS DIVISION  
**TYPICAL SECTIONS & DETAILS**  
HANA HIGHWAY RESURFACING  
Haleakala Highway to Paia and  
HALEAKALA HIGHWAY RESURFACING  
Hana Highway to North Firebreak Rd.  
Project No. HWY-M-01-15M  
Scale: As Shown Date: March, 2015  
SHEET No. 5 OF 5 SHEETS






FED. ROAD DIST. NO.	STATE	PROJ. NO.	FISCAL YEAR	SHEET NO.	TOTAL SHEETS
HAWAII	HAW.	HWY-M-01-15M	2016	ADD.11S-2	41

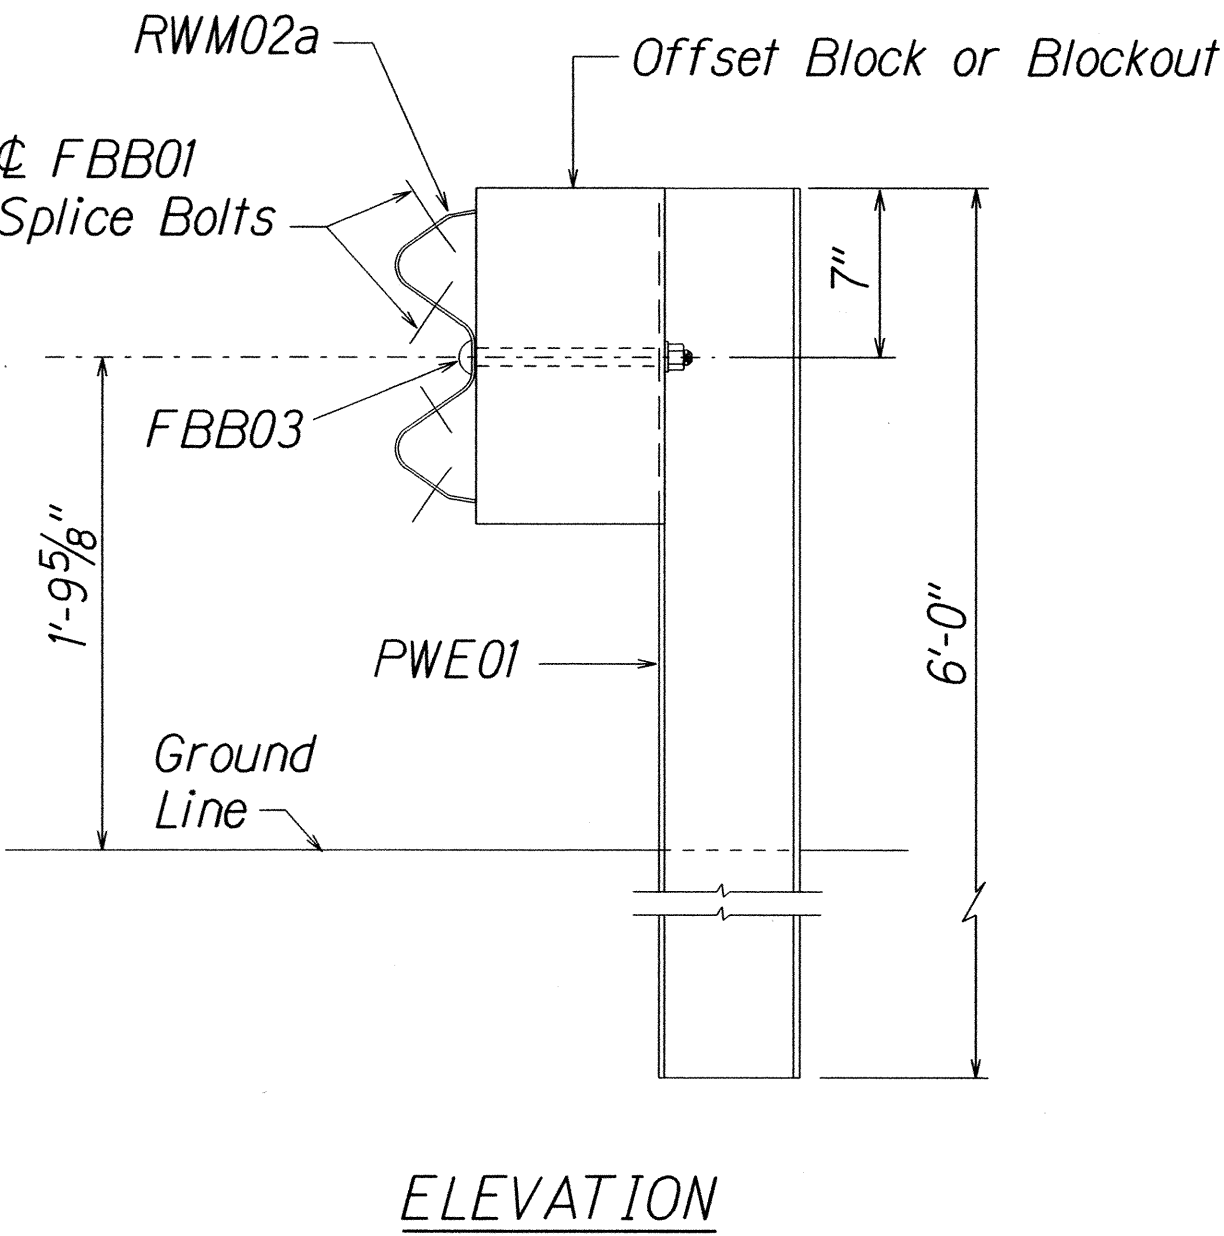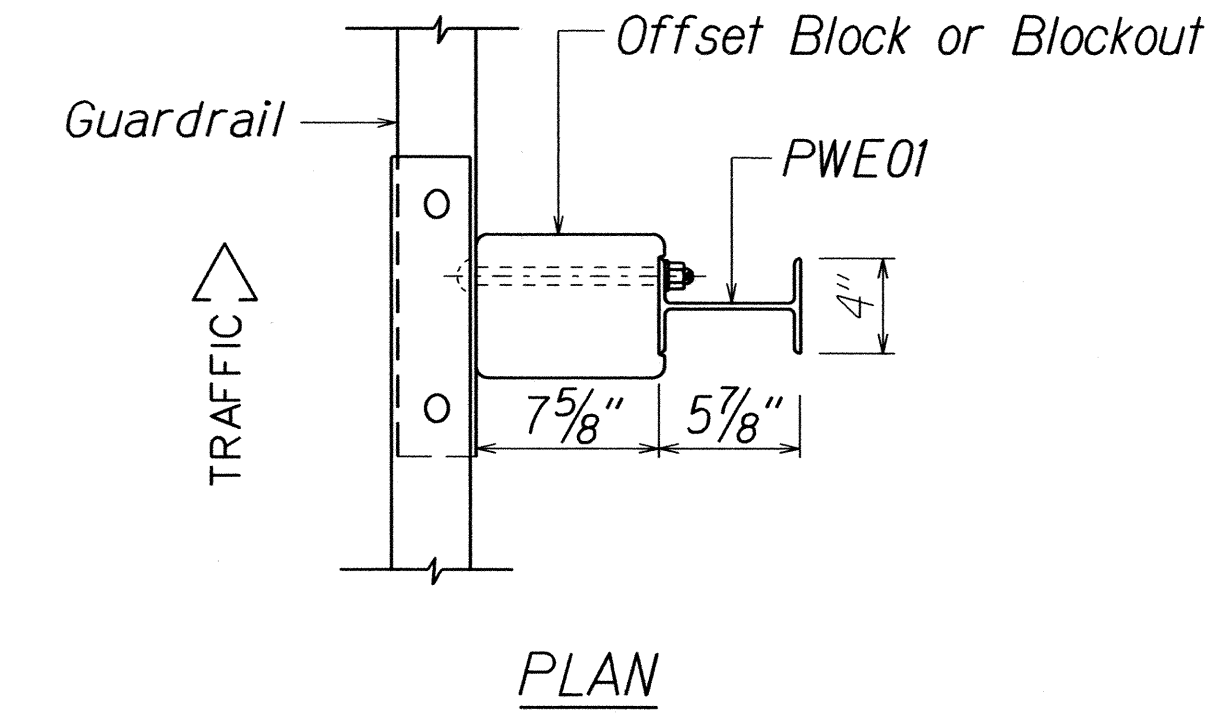


**STRONG POST W-BEAM GUARDRAIL**  
**(SGR04a)**

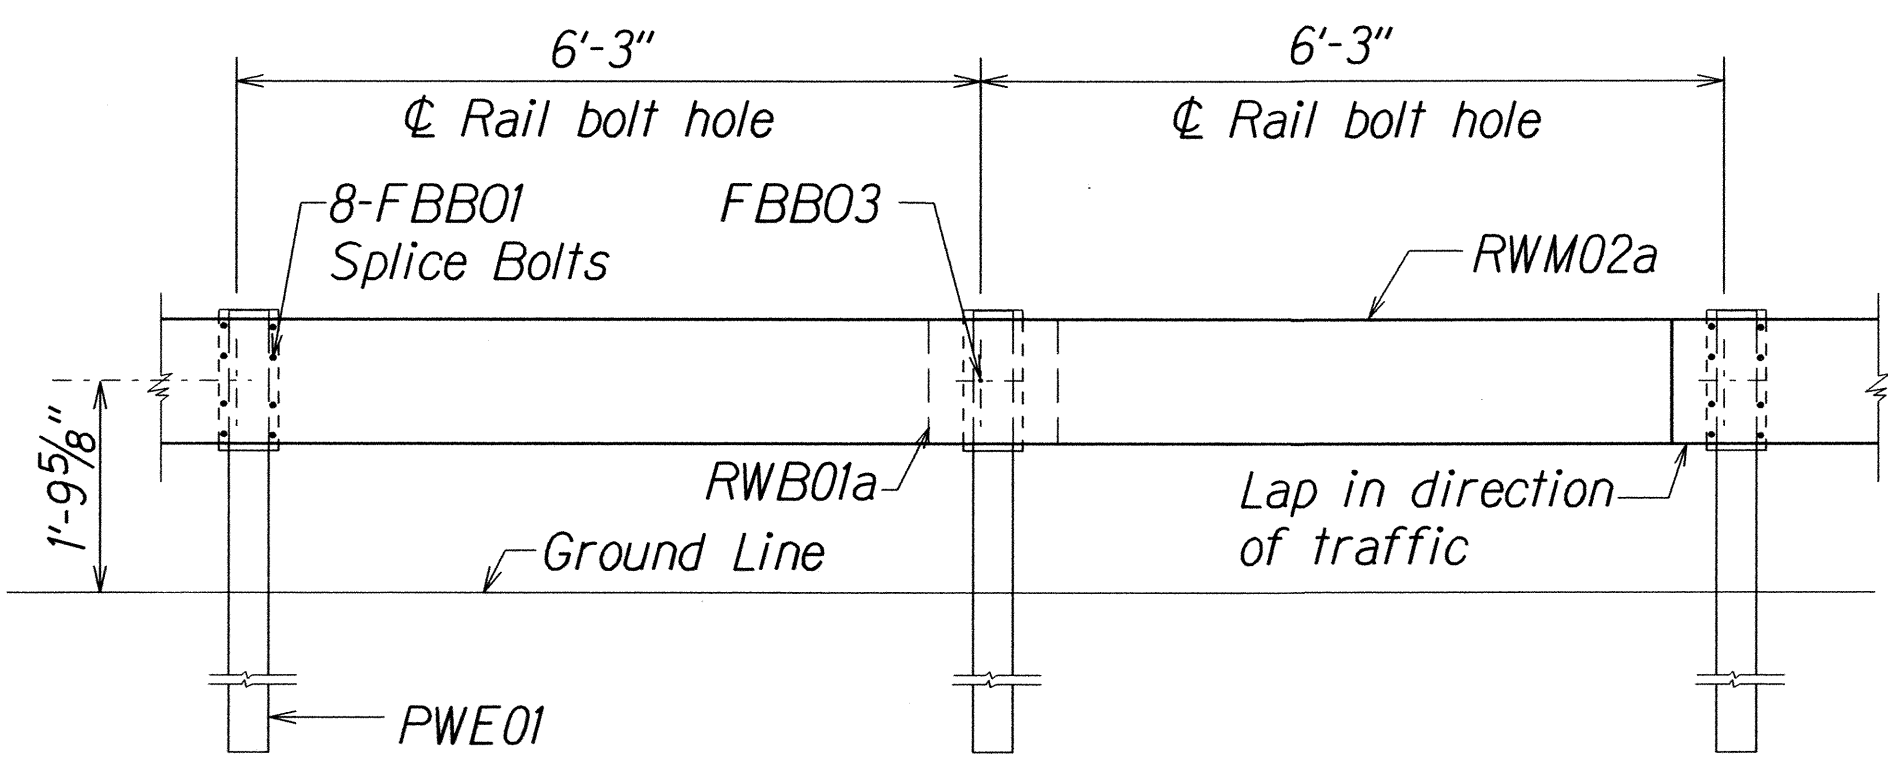


**STRONG POST W-BEAM GUARDRAIL WITH**  
**RECYCLED OFFSET BLOCK OR PLASTIC BLOCKOUT**


NOTE:  
All Holes are  
3/4" Dia.  
W6x8.5  
Structural  
Shape

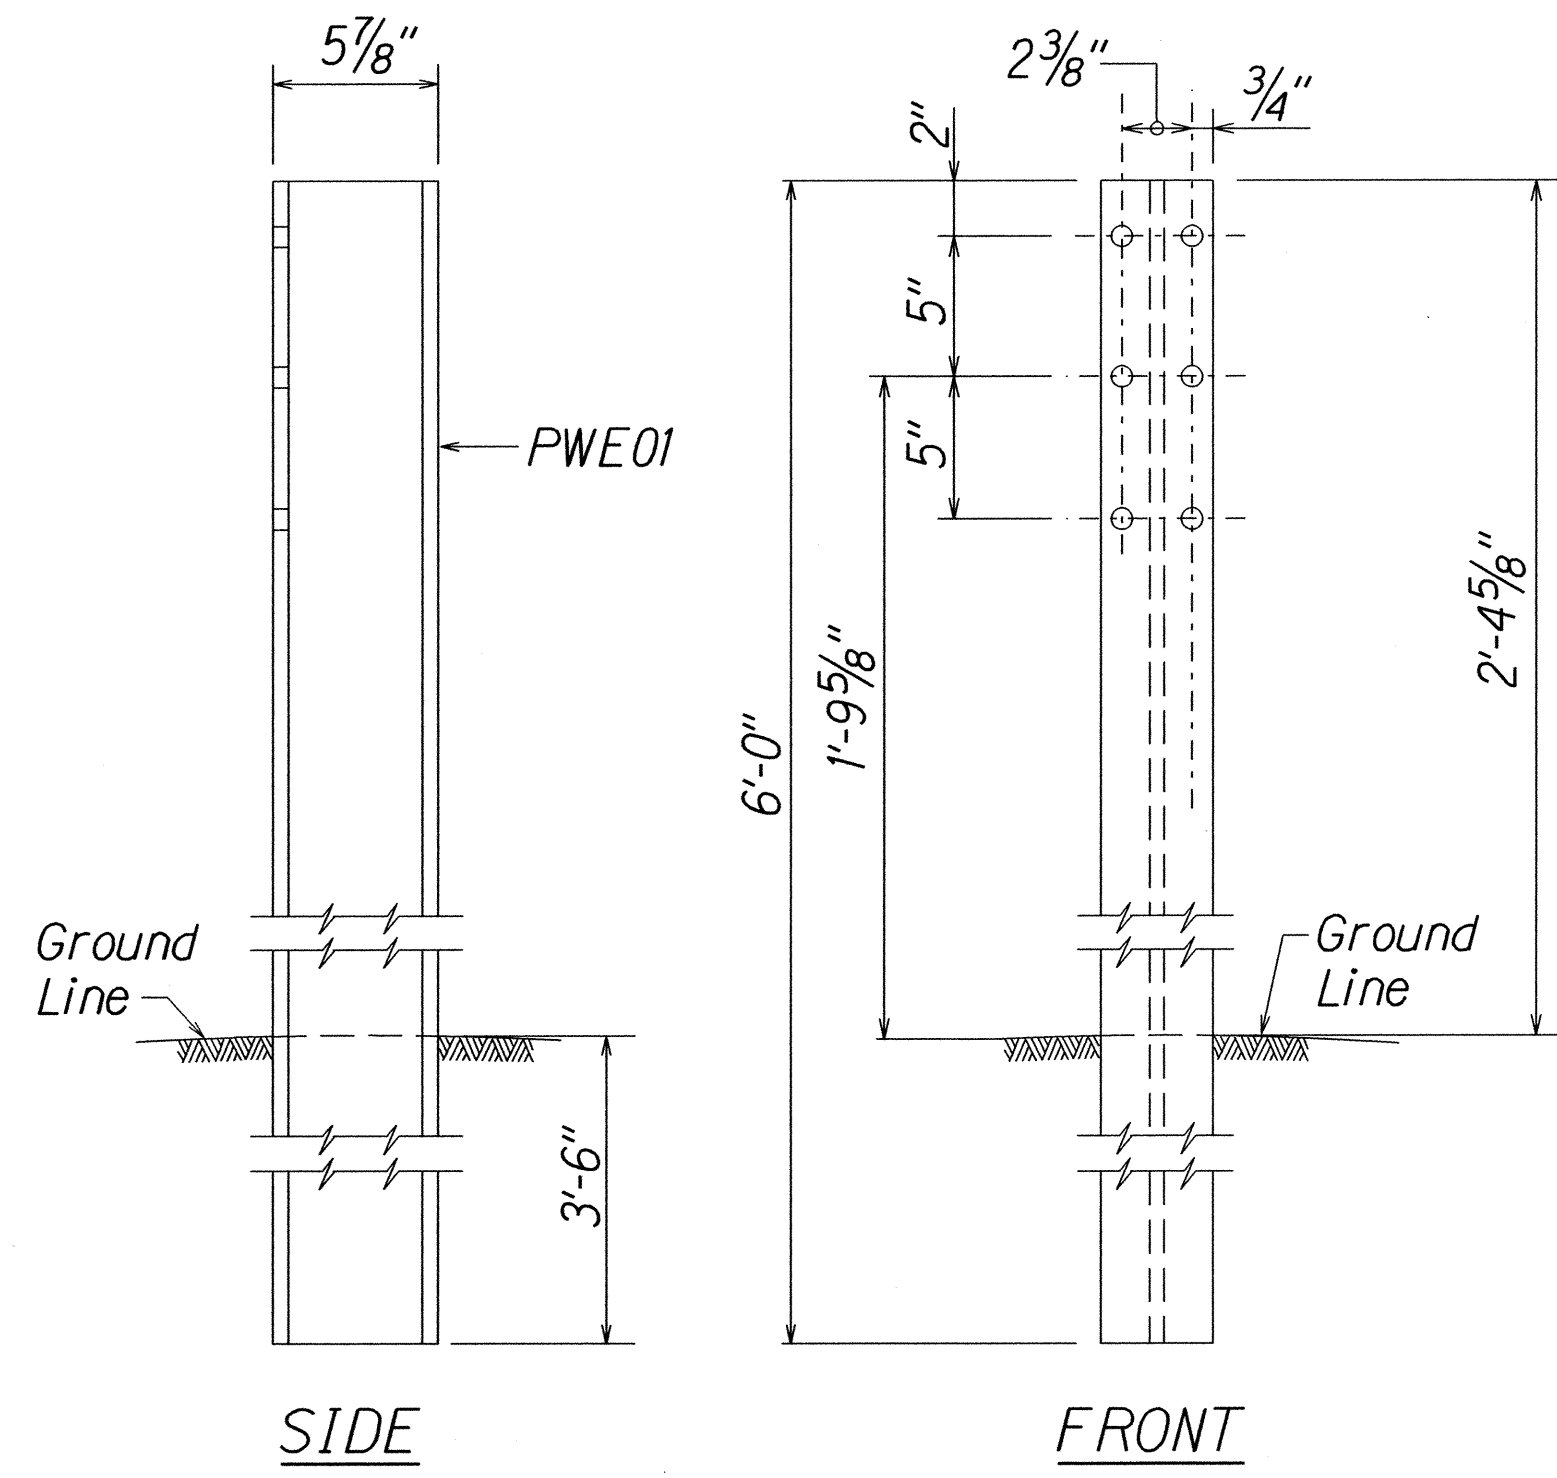


**W-BEAM STRONG POST (PWE01)**

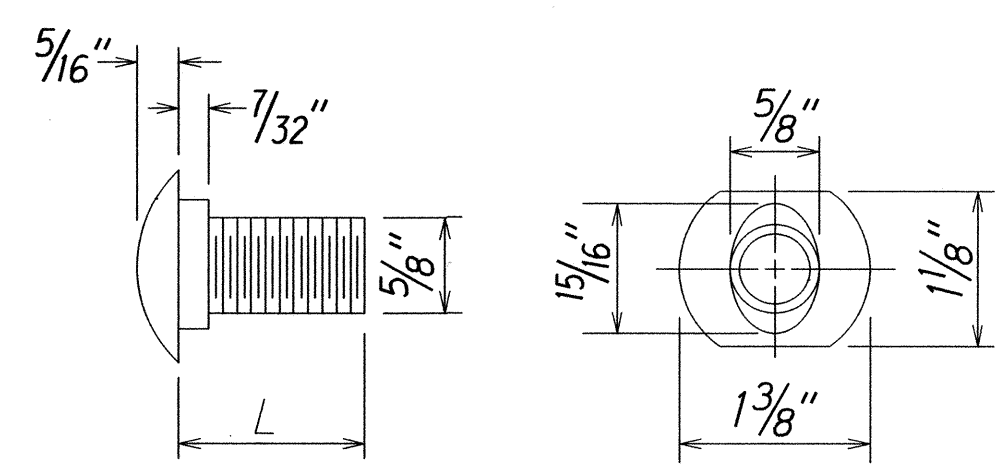

DESIGNATOR	L
FBB01	1 3/8"
FBB02	2"
FBB03	10"

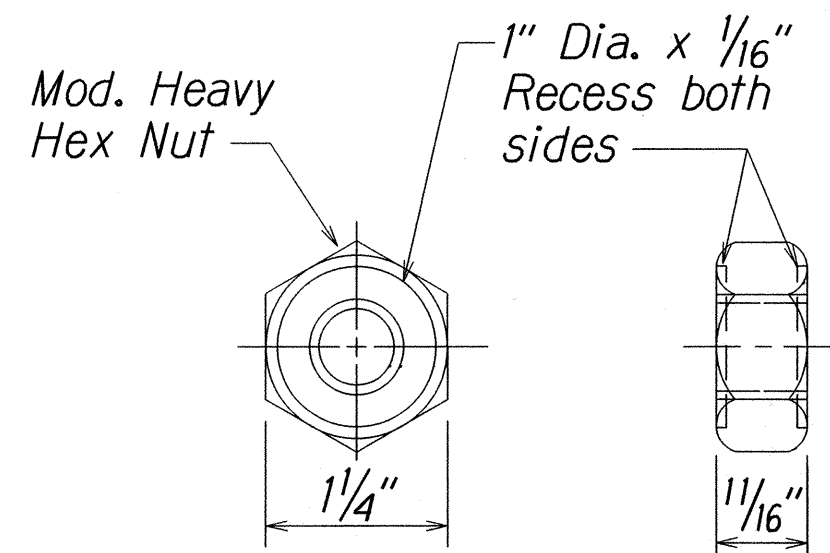

**GUARDRAIL BOLTS AND RECESSED NUT**

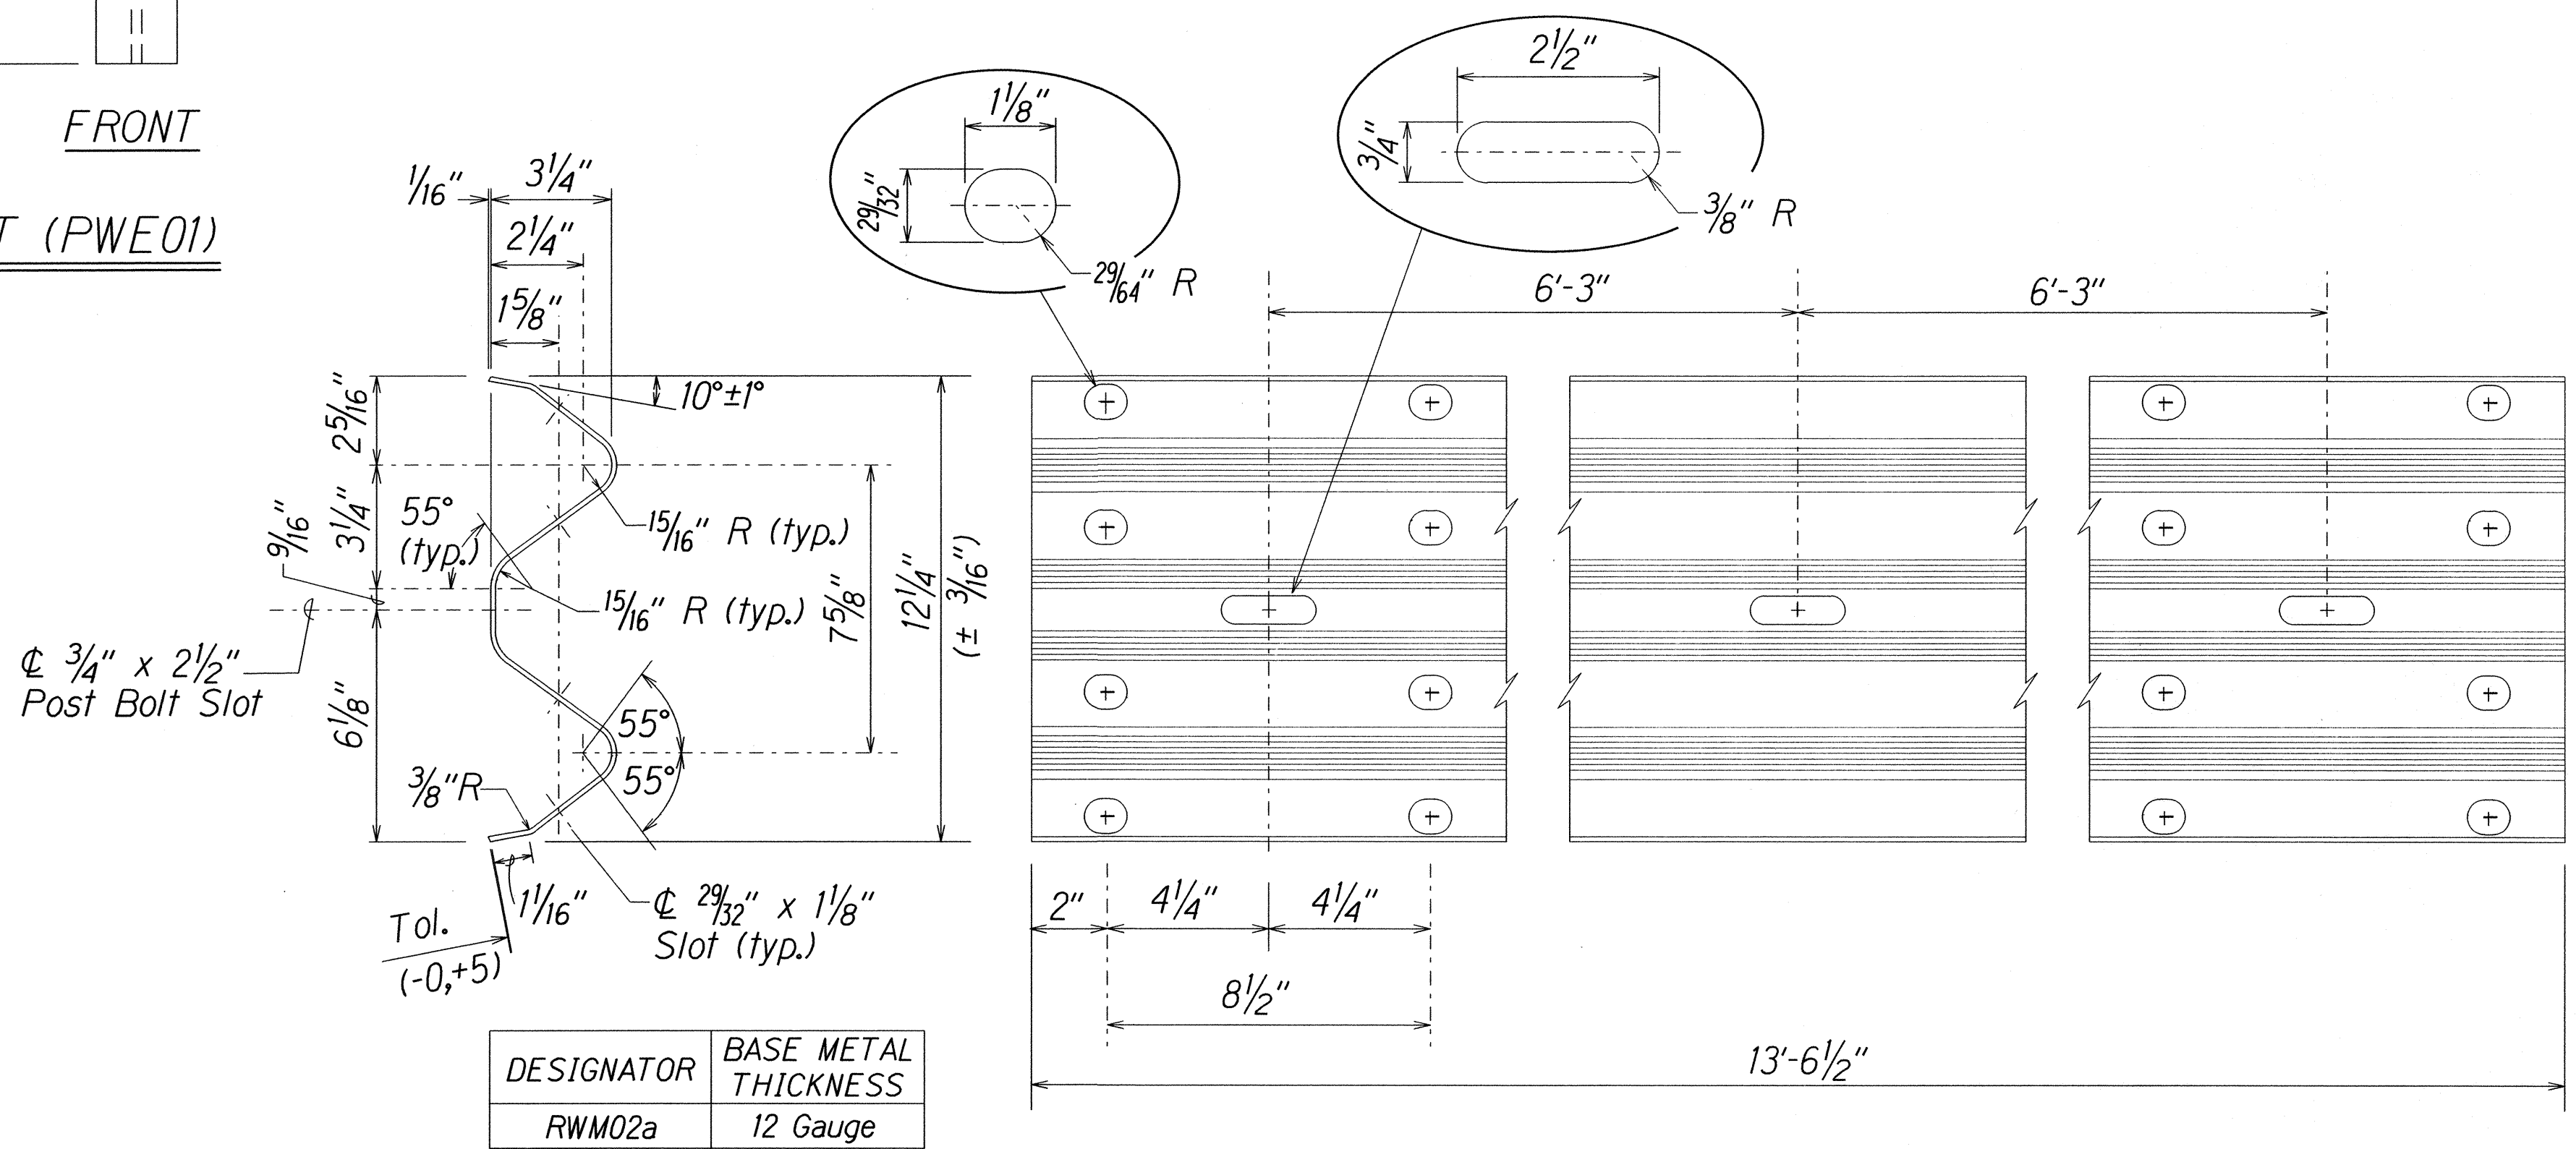

**2 SPACE W-BEAM GUARDRAIL (RWM02a)**

4-12-16 Additional Details of Guardrail.

DATE	REVISION
------	----------

STATE OF HAWAII

DEPARTMENT OF TRANSPORTATION

HIGHWAYS DIVISION

**STRONG POST W-BEAM GUARDRAIL**

HANA HIGHWAY RESURFACING

Haleakala Highway to Paia and

HALEAKALA HIGHWAY RESURFACING

Hana Highway to North Firebreak Rd.

Project No. HWY-M-01-15M

Scale: As Shown


Date: April, 2016

SHEET No. 2


OF 5

SHEETS


FED. ROAD DIST. NO.	STATE	PROJ. NO.	FISCAL YEAR	SHEET NO.	TOTAL SHEETS
HAWAII	HAW.	HWY-M-01-15M	2016	ADD.11S-3	41

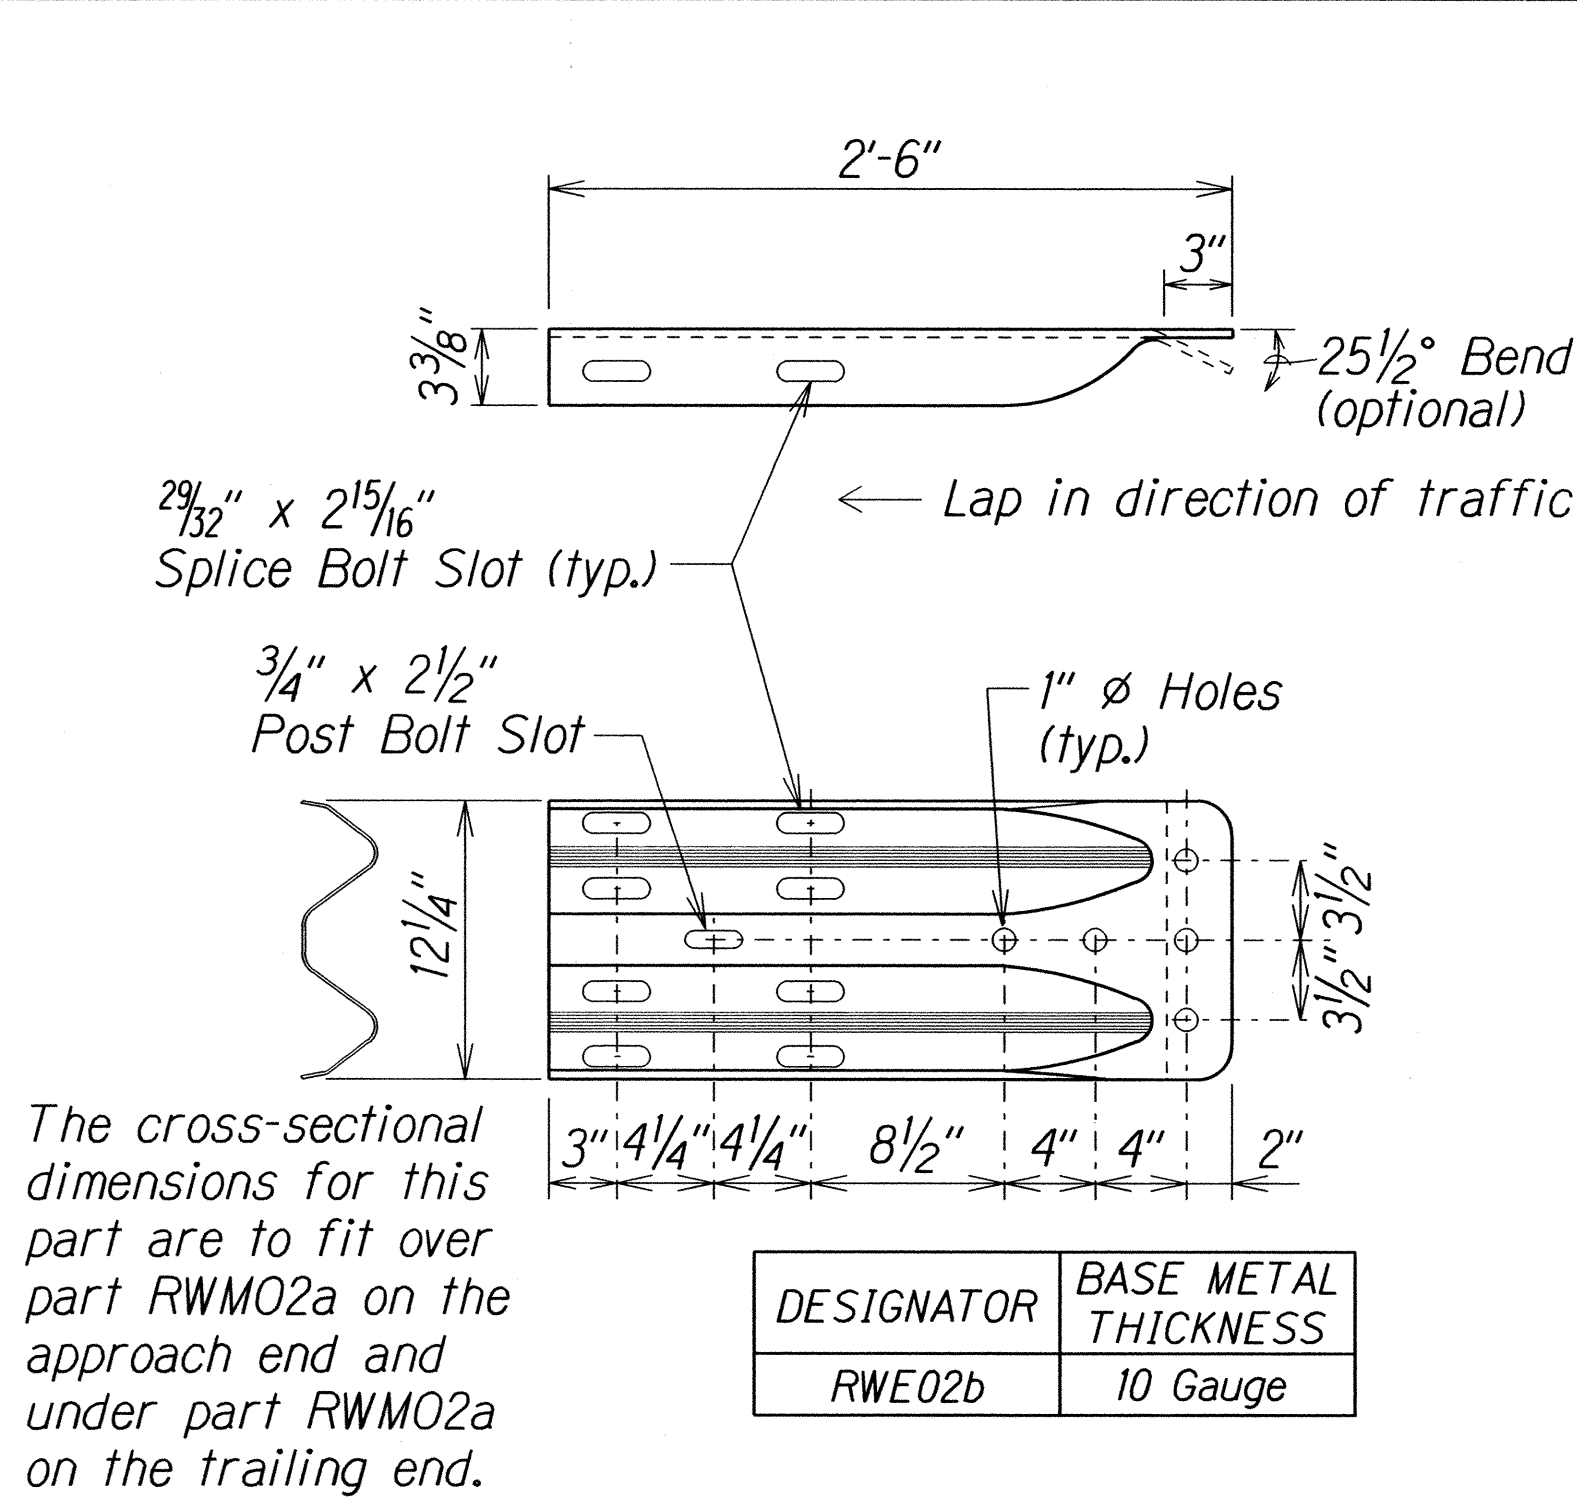


W-BEAM TERMINAL CONNECTOR (RWE02b)

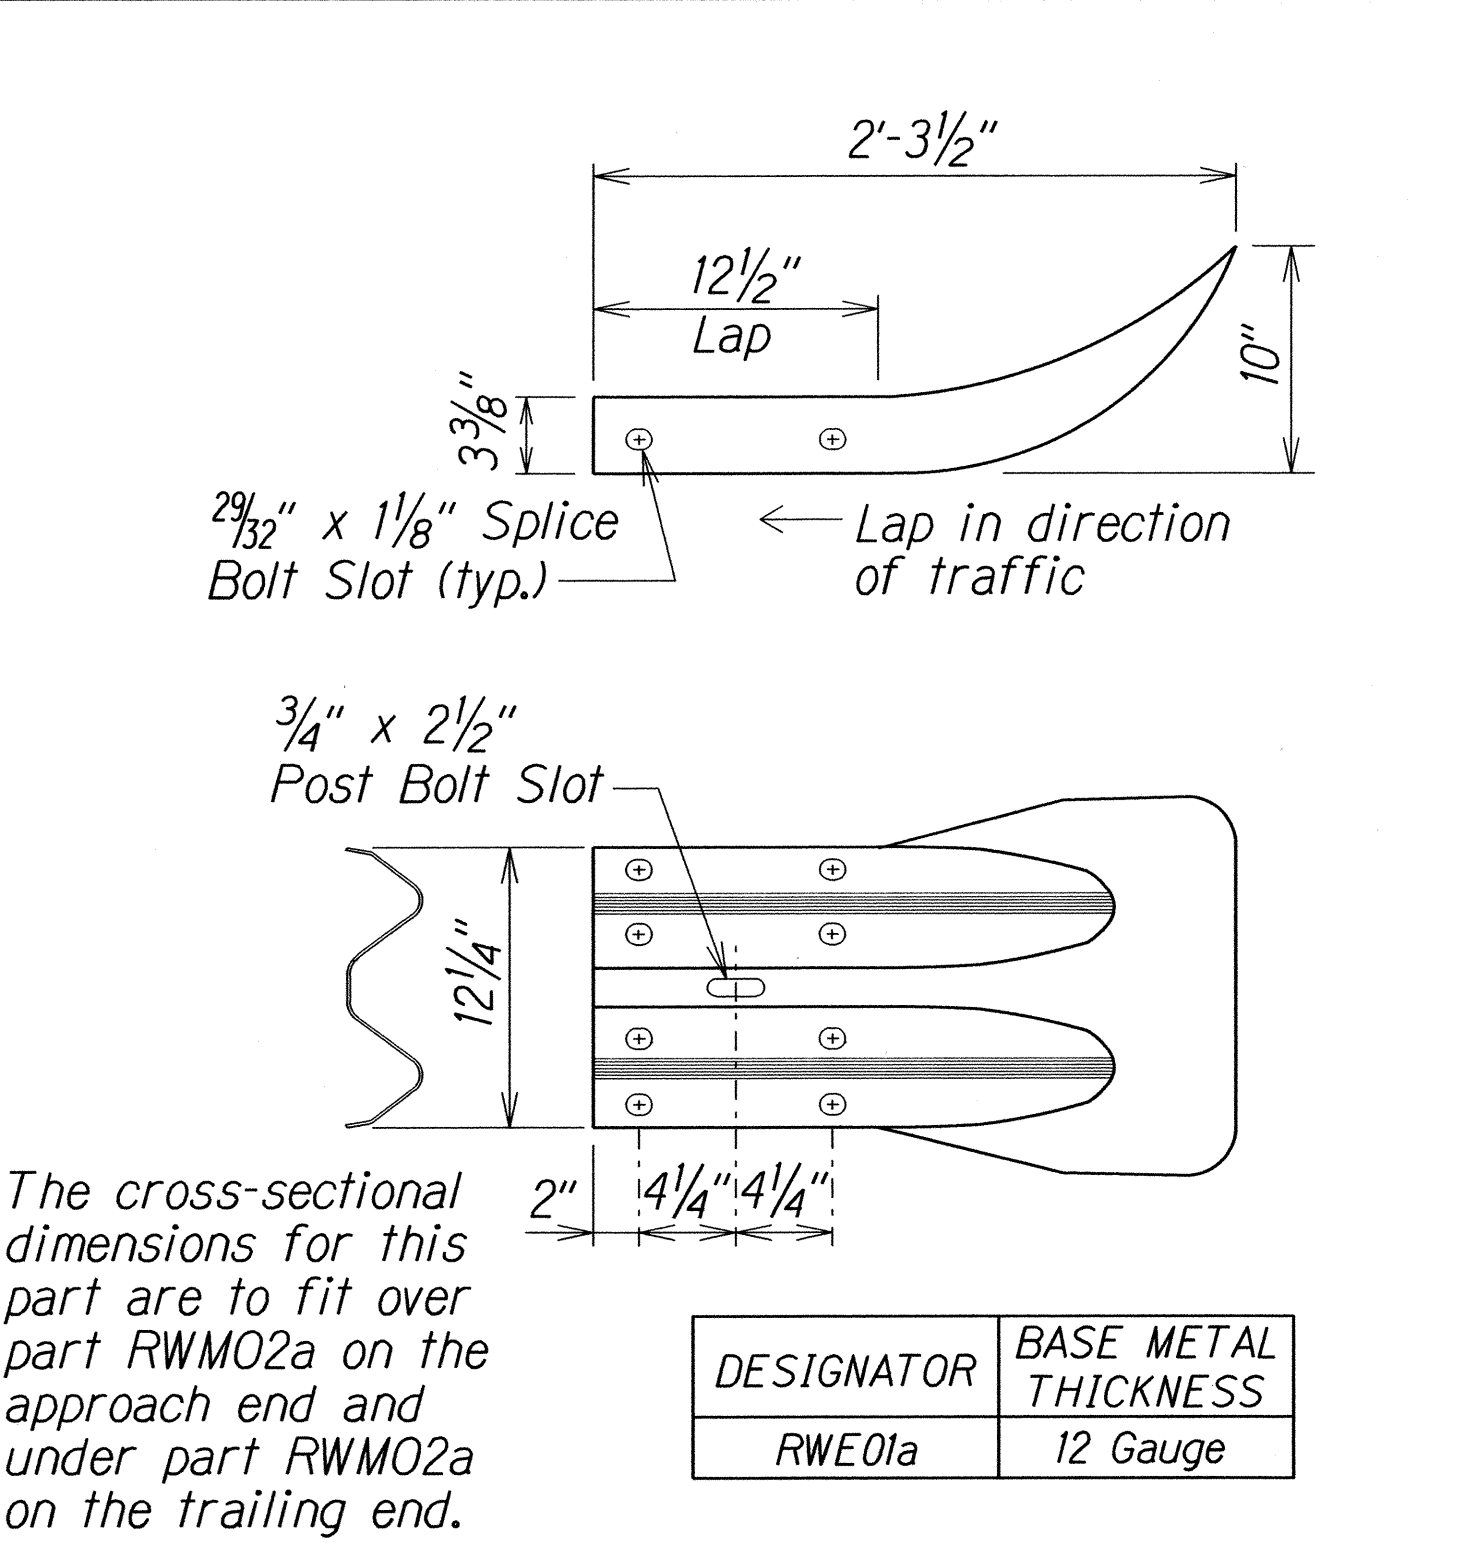


W-BEAM END SECTION (FLARED RWE01a)

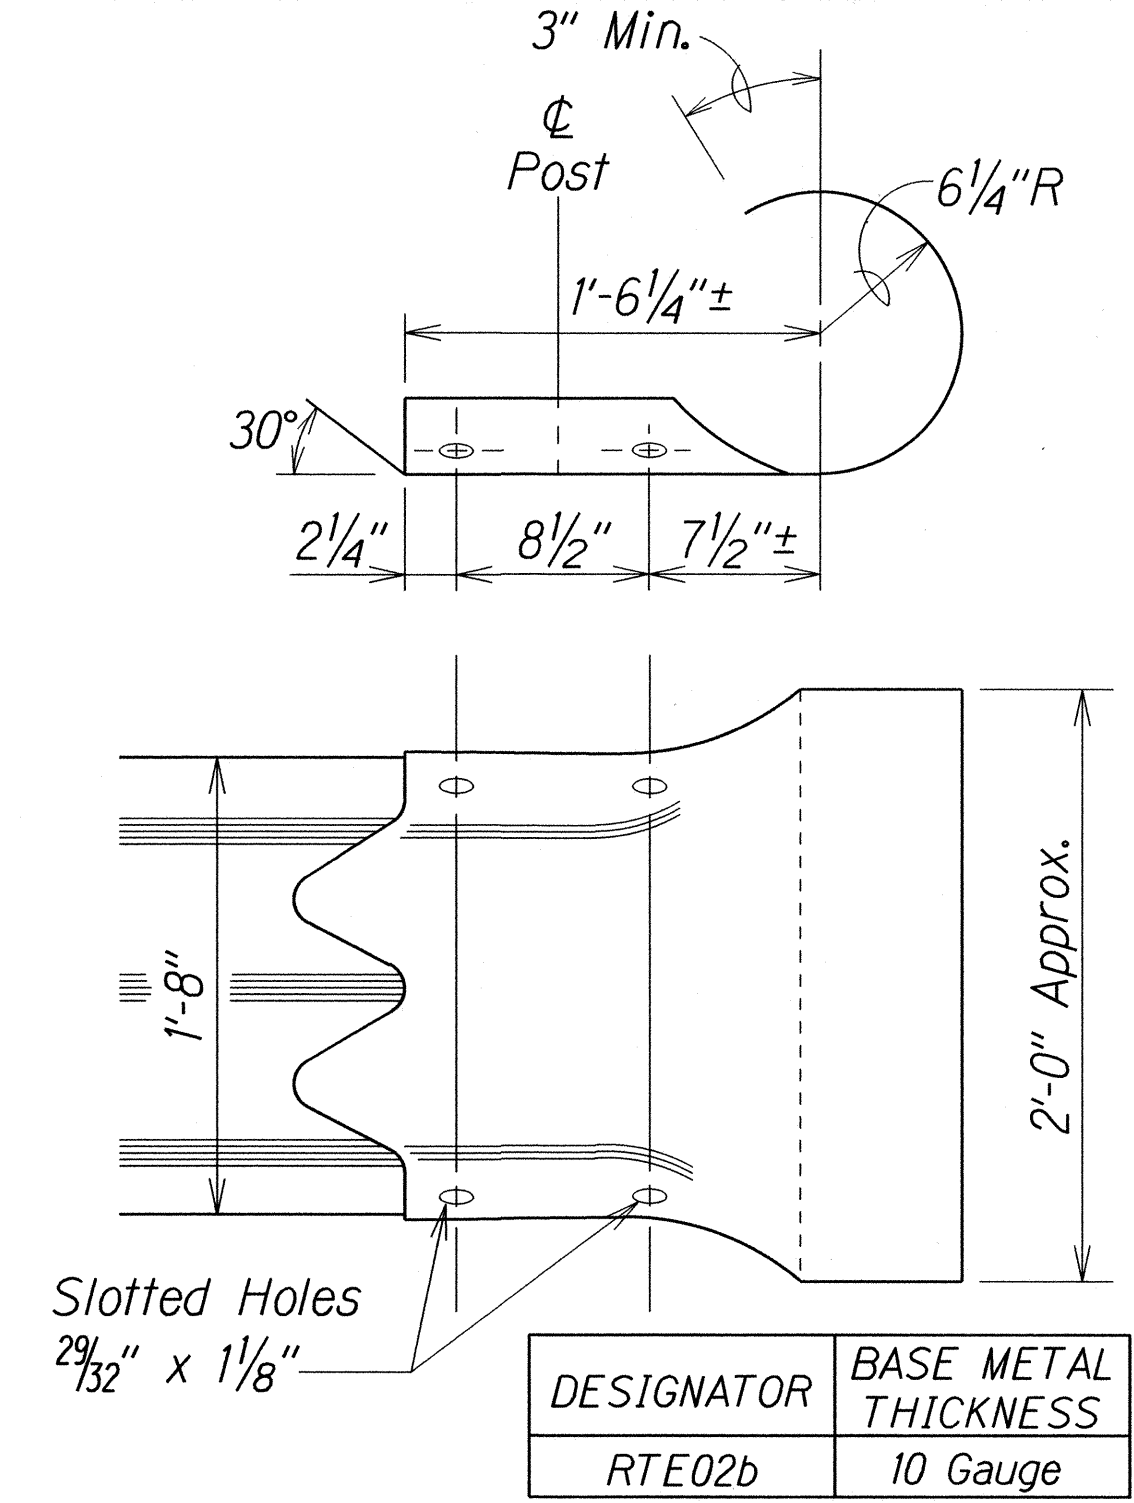


THRIE-BEAM SECTION (ROUNDED) (RTE02b)

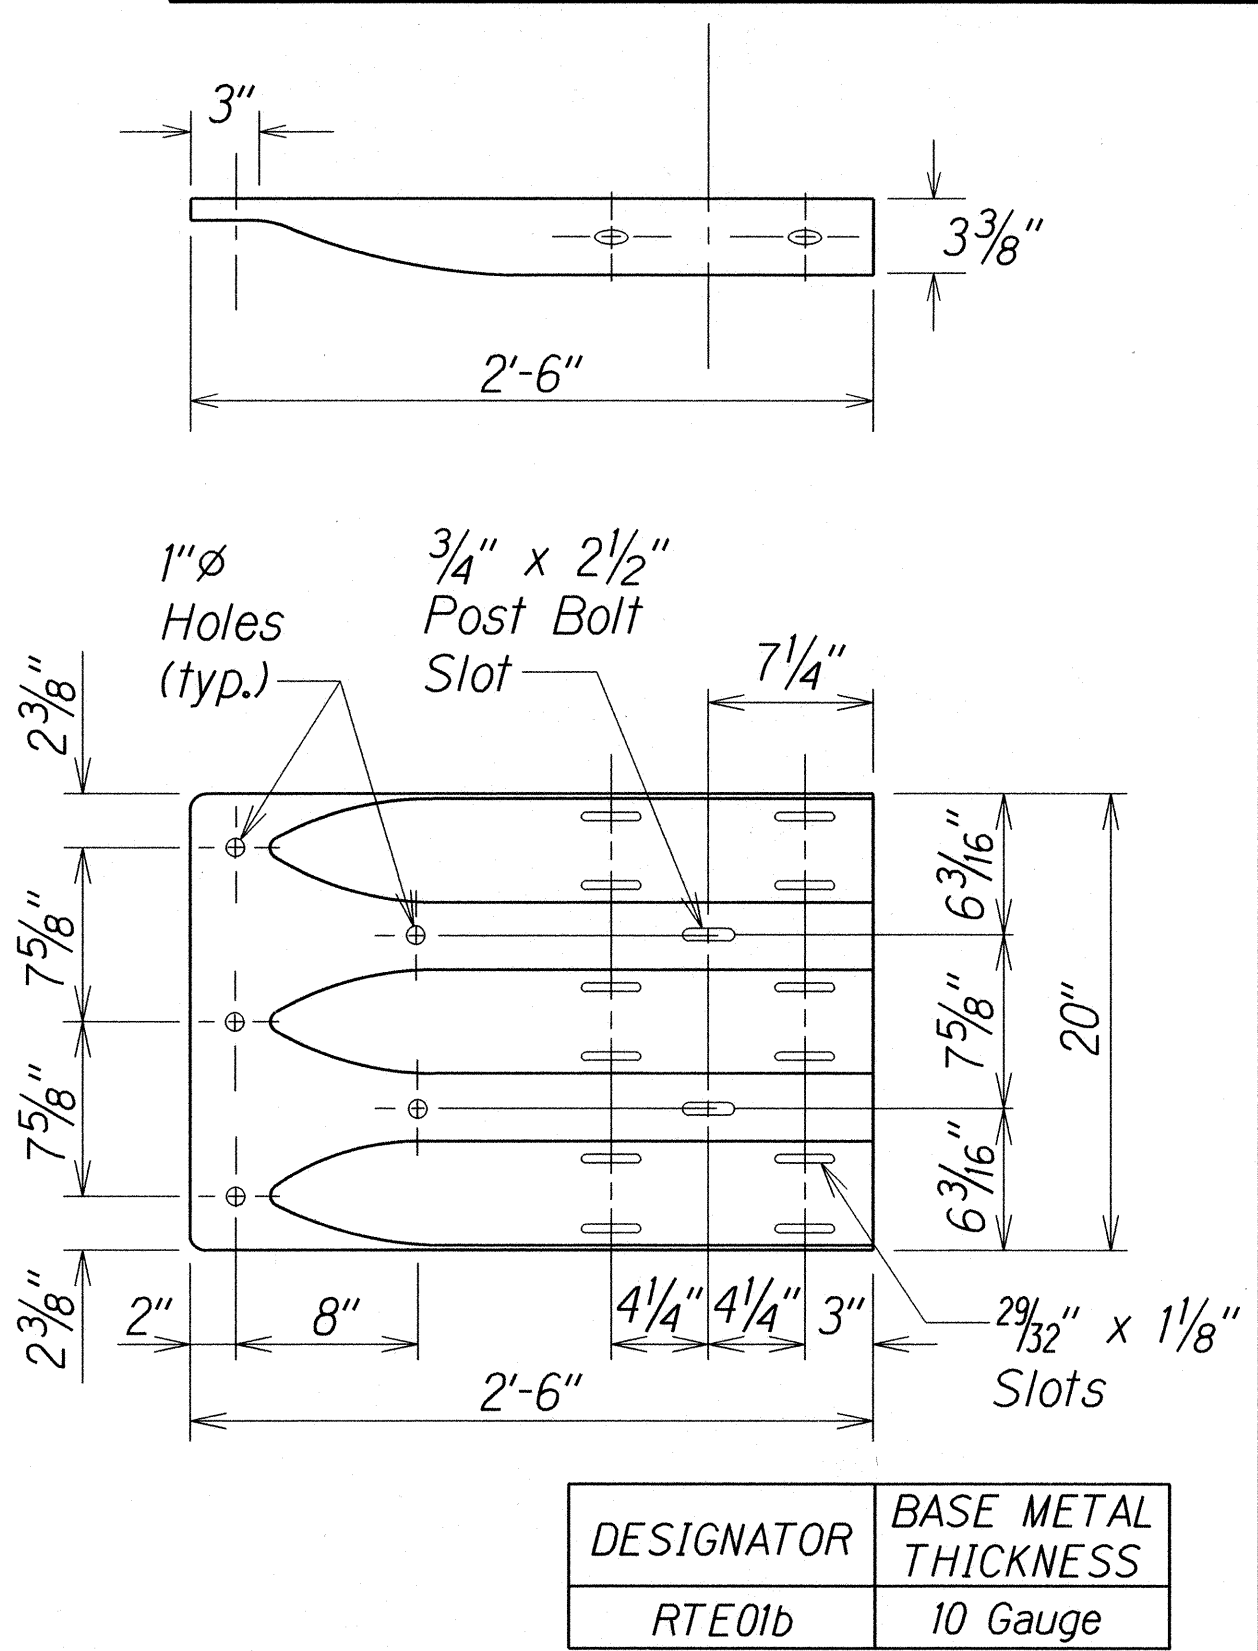


THRIE-BEAM TERMINAL CONNECTOR (RTE01b)

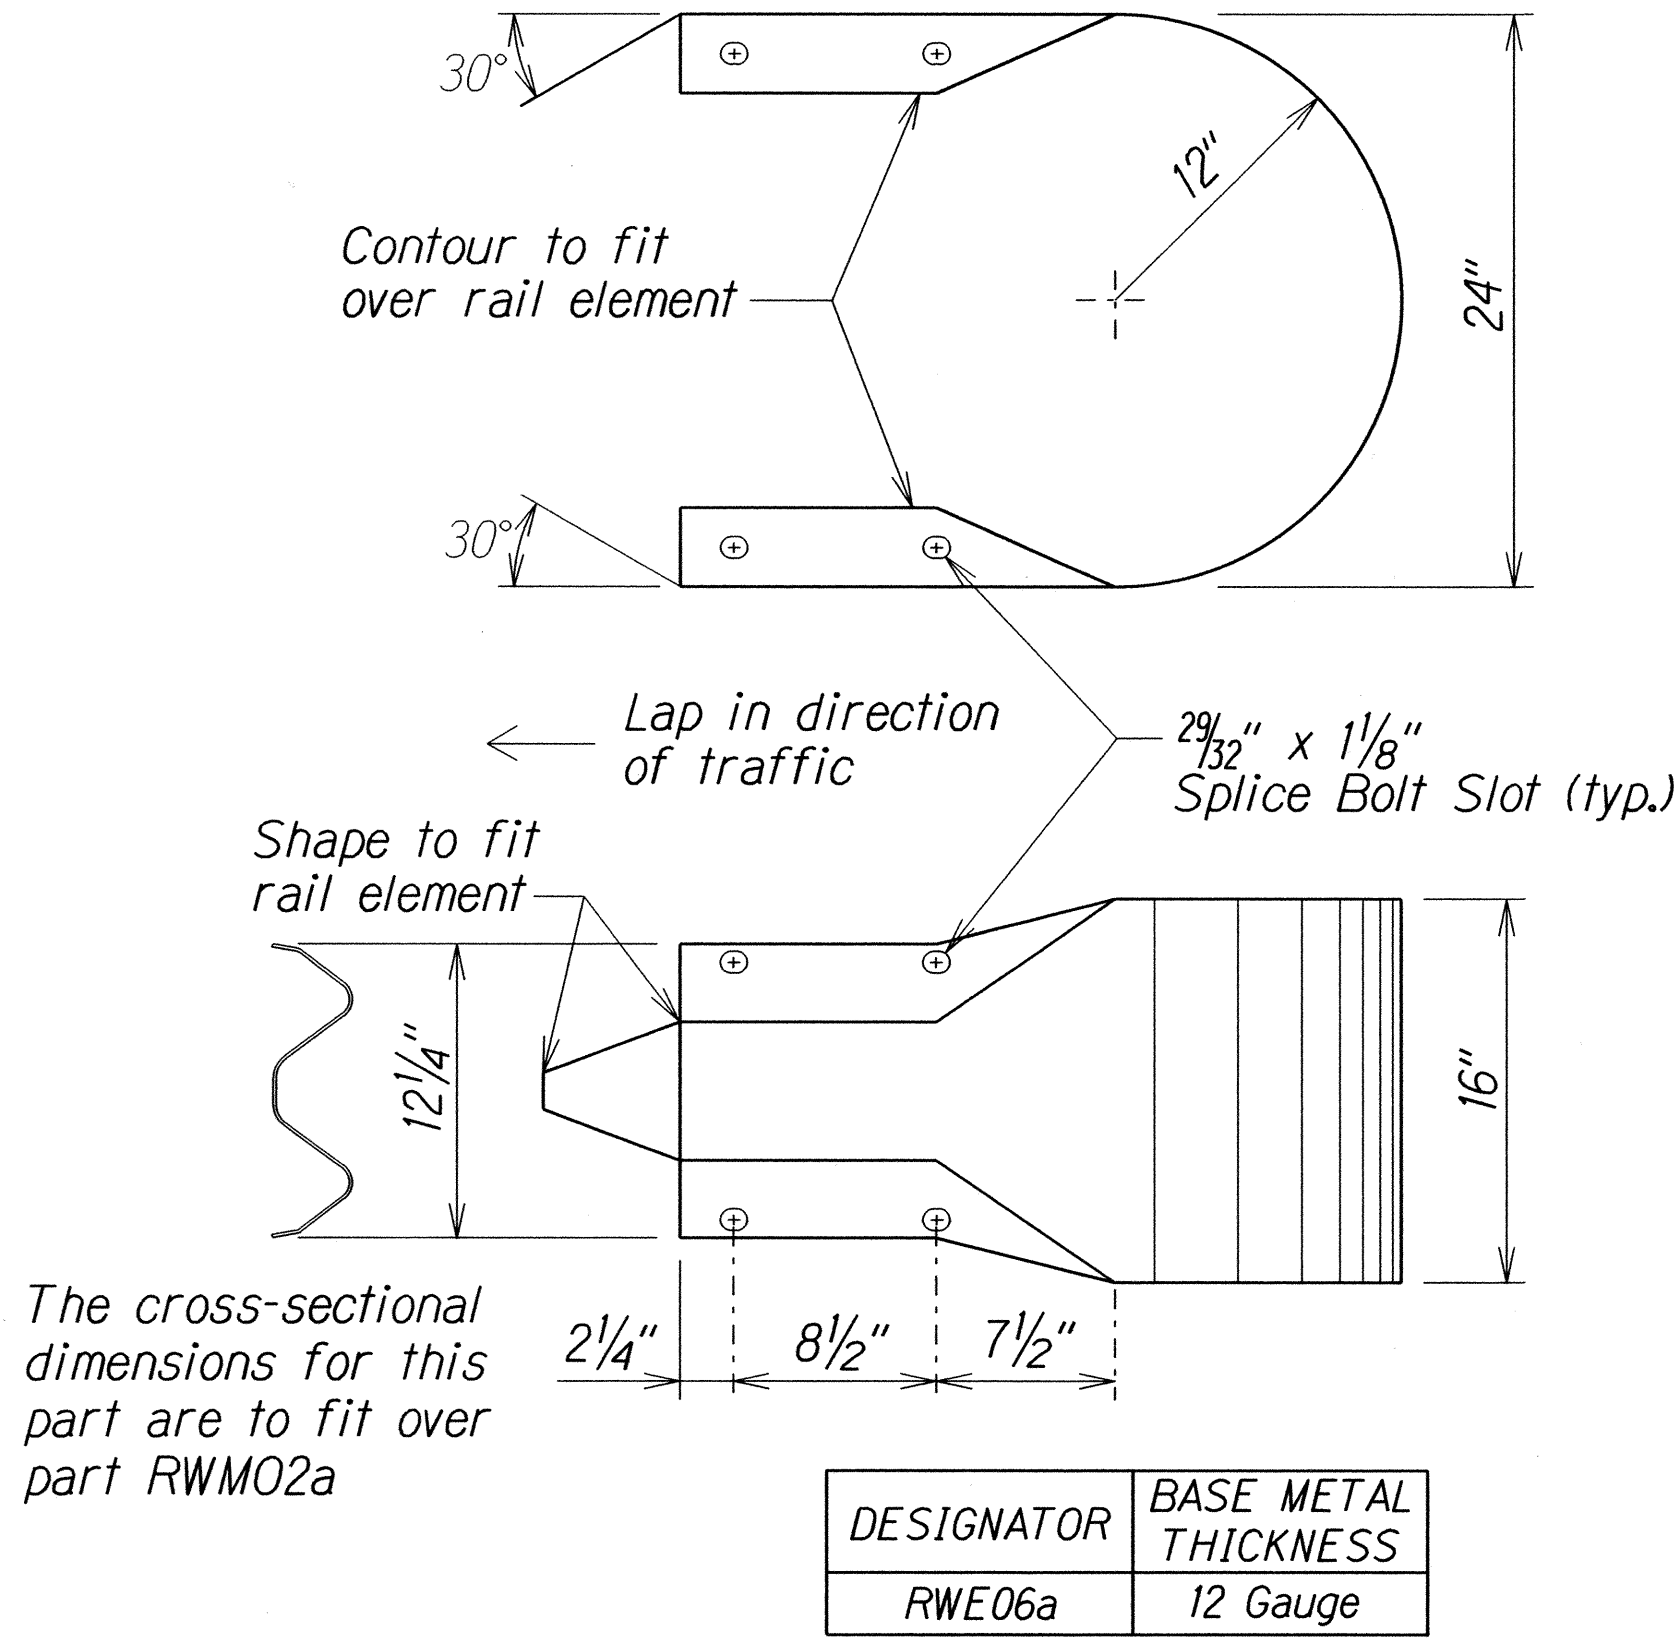

W-BEAM END SECTION (BUFFER RWE06a)

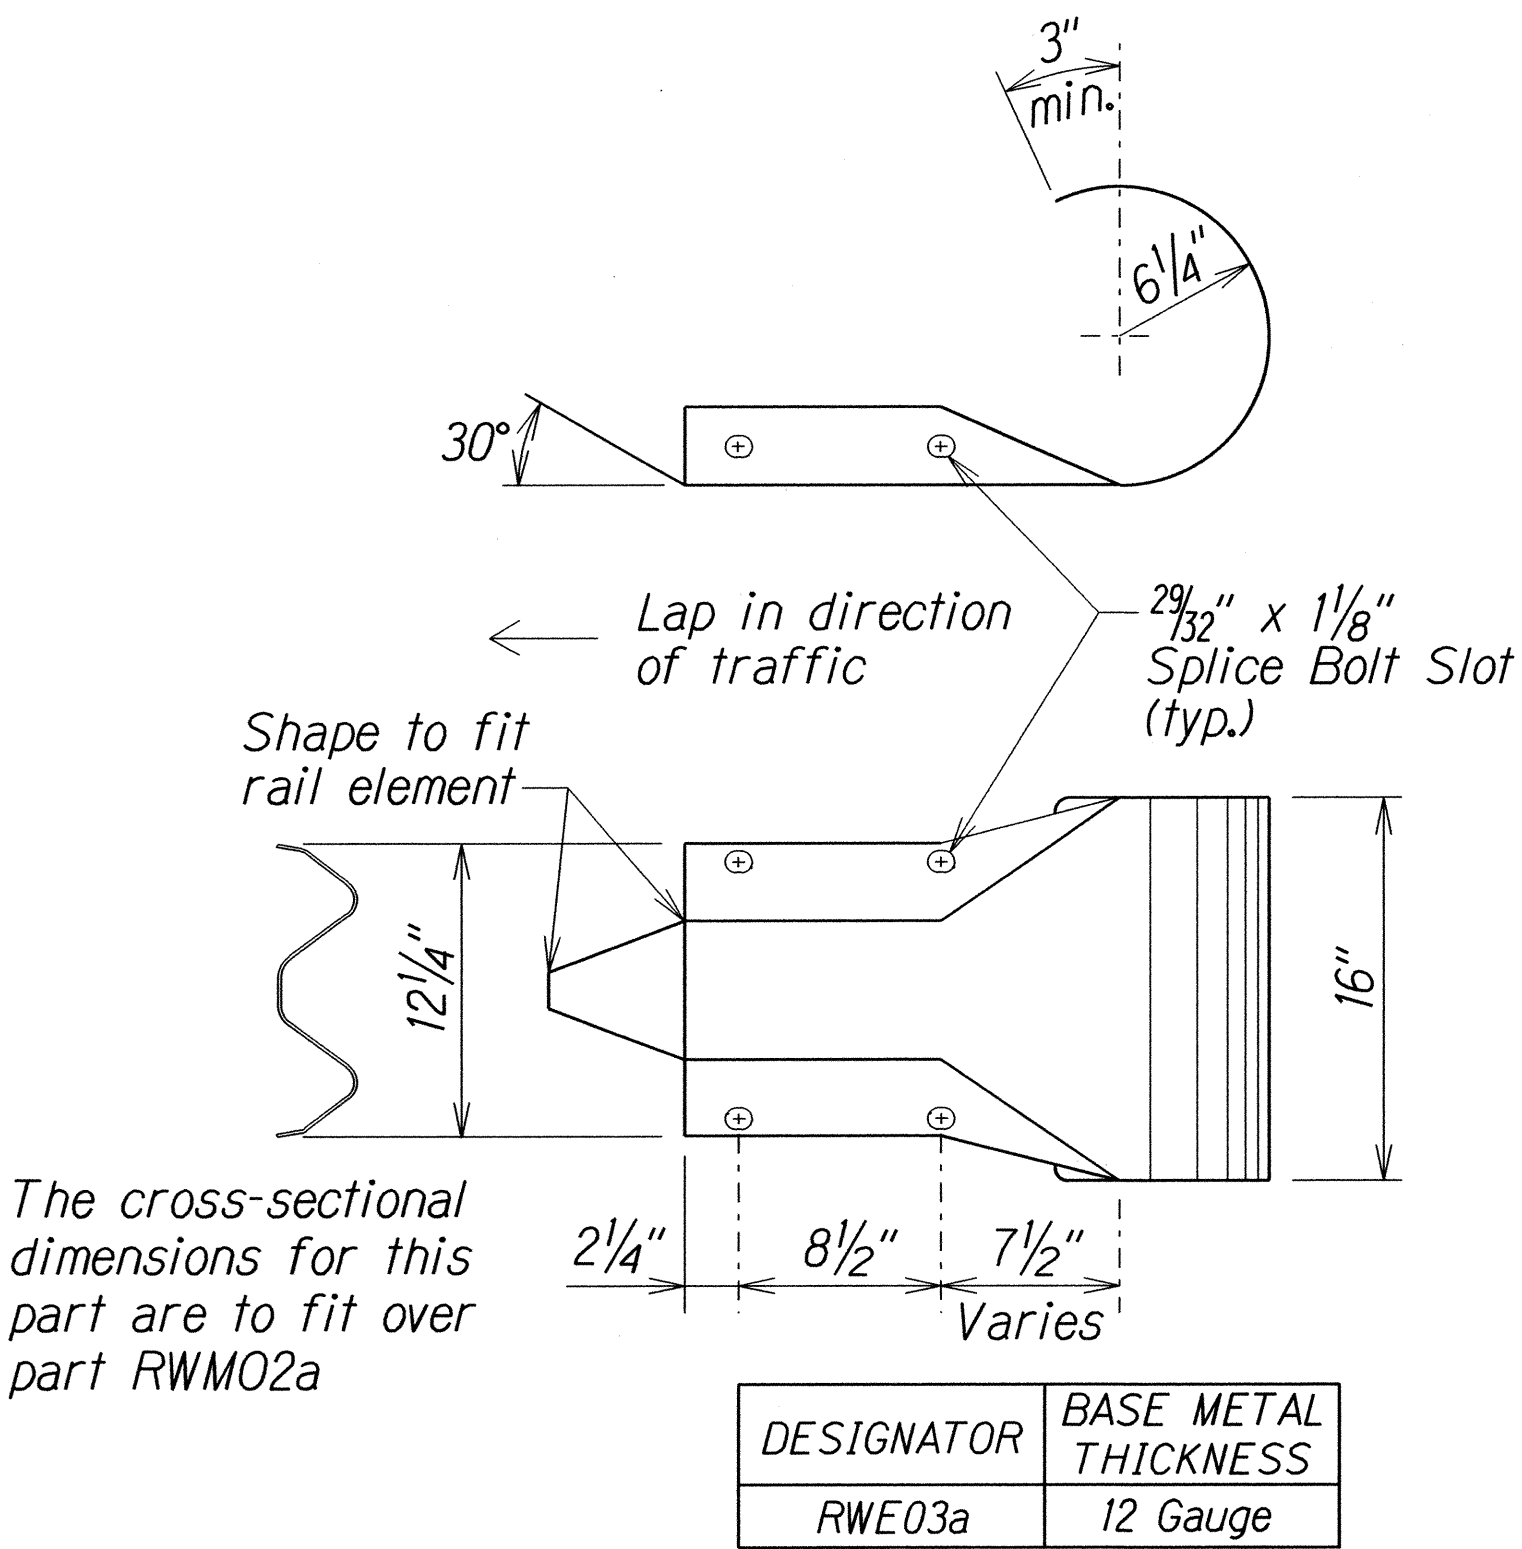

W-BEAM END SECTION (ROUNDED RWE03a)

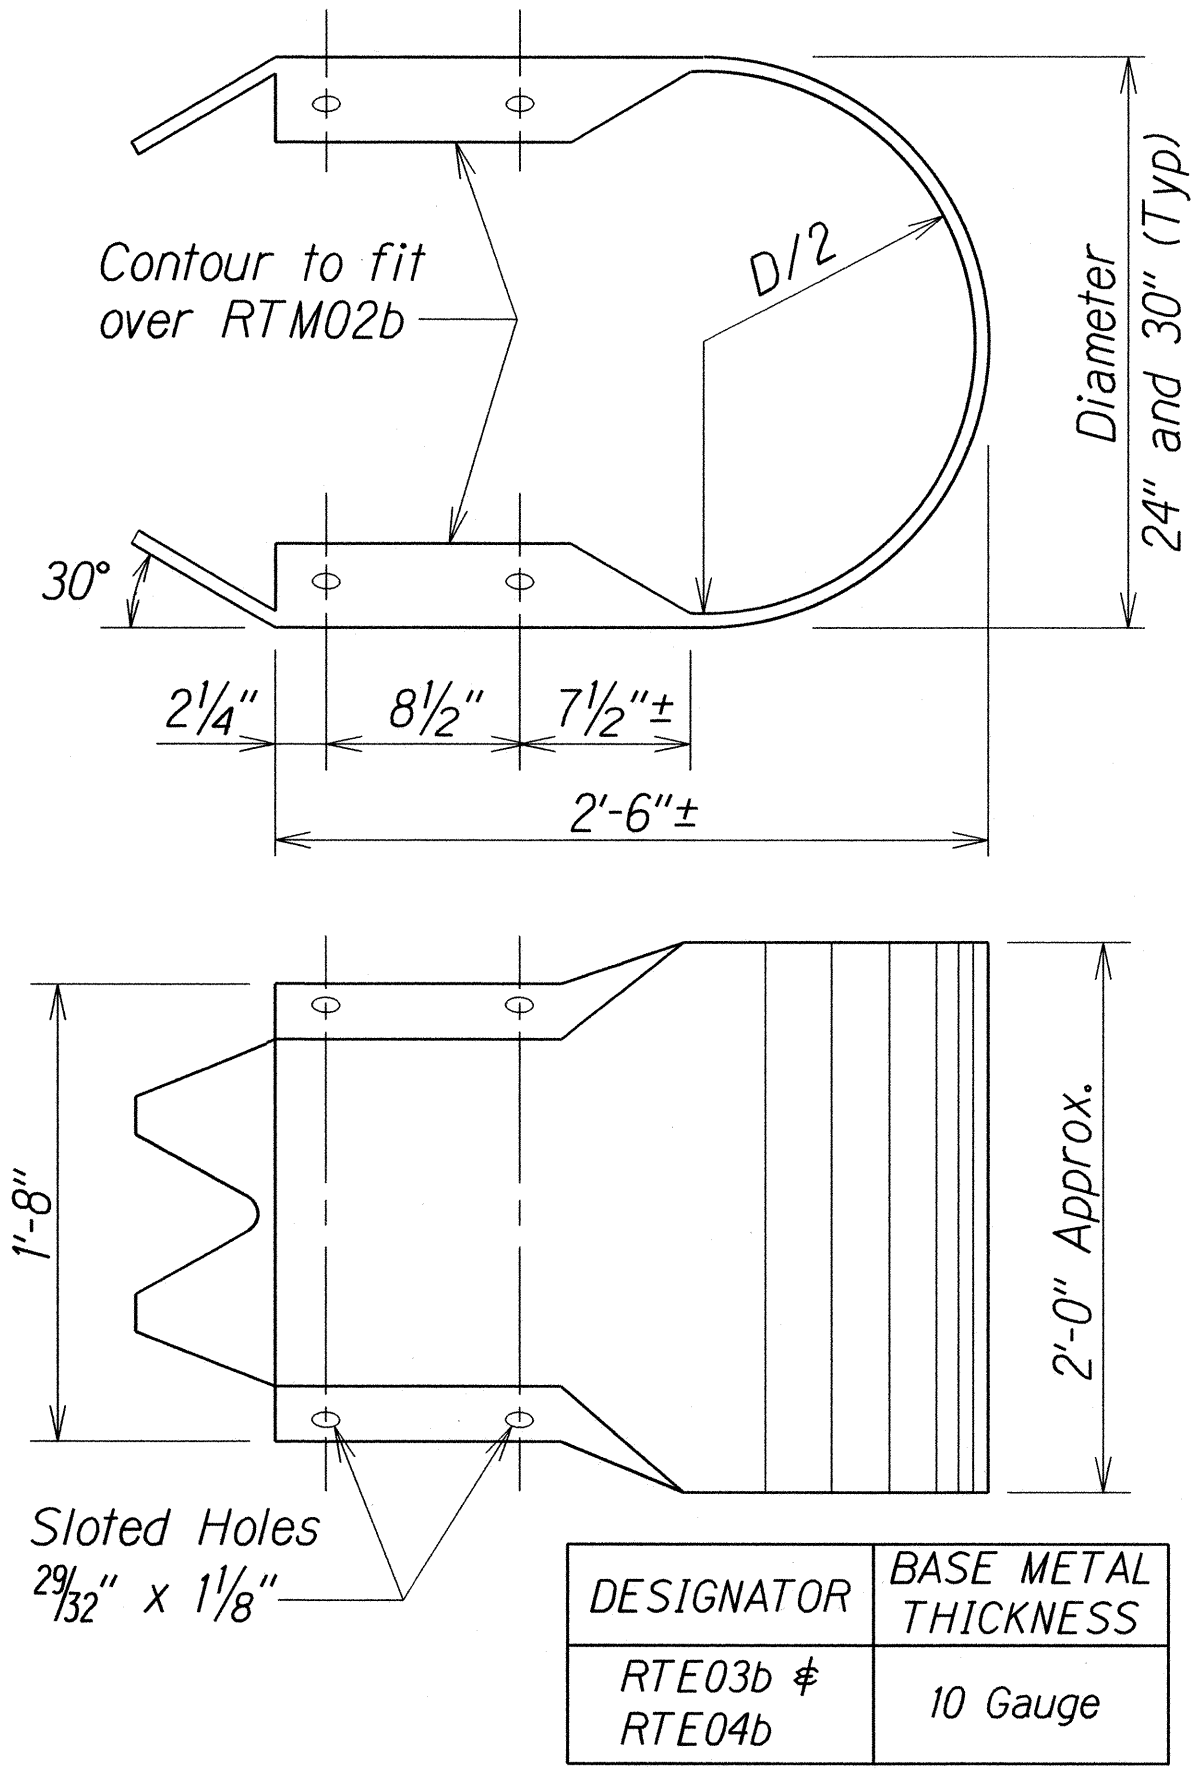

THRIE-BEAM END SECTION (BUFFER RTE03b or RTE04b)

4-12-16	Additional Details of Guardrail.
DATE	REVISION
STATE OF HAWAII DEPARTMENT OF TRANSPORTATION HIGHWAYS DIVISION <b>GUARDRAIL TERMINAL CONNECTORS AND END SECTIONS</b> HANA HWY. RESURFACING, Haleakala Hwy. to Paia and HALEAKALA HIGHWAY RESURFACING Hana Highway to North Firebreak Rd. Project No. HWY-M-01-15M Scale: As Noted Date: April, 2016	
SHEET No. 3 OF 5 SHEETS	




FED. ROAD DIST. NO.	STATE	PROJ. NO.	FISCAL YEAR	SHEET NO.	TOTAL SHEETS
HAWAII	HAW.	HWY-M-01-15M	2016	ADD.11S-4	41

ITEM NO.	QTY.	BILL OF MATERIALS
F3000	1	IMPACT HEAD
F1303	1	W-BEAM GUARDRAIL END SECTION, 12 GA.
G1203	2	W-BEAM GUARDRAIL, 12 GA.
S730	2	*FOUNDATION SOIL TUBE, 6" x 8" x 72"
E750	1	BEARING PLATE
S760	1	CABLE ANCHOR BOX
E770	1	BCT CABLE ANCHOR ASSEMBLY
E780	1	GROUND STRUT
PB620	2	STEEL BREAKAWAY END POST
PB621	5	STEEL BREAKAWAY LINE POST
	5	RECYCLED PLASTIC BLOCKOUT OR OFFSET BLOCK
	1	IMPACT HEAD REFLECTOR MARKER - IHRM(R) OR (L)
HARDWARE		
B580122	25	5/8" Dia. x 1 1/4" SPLICE BOLT, POST #2
B580754	2	5/8" Dia. x 7 1/2" HEX BOLT
B341004	2	3/4" Dia. x 10" HEX BOLT
B581002	5	5/8" Dia. x 10" H.G.R. BOLT (POST 3 THRU 7)
N050	32	5/8" Dia. H.G.R. NUT (SPLICE 24, SOIL TUBES 2, POST 2 THRU 7, 6)
N030	2	3/4" Dia. HEX NUT
W050	6	H.G.R. WASHER
W030	4	3/4" ID WASHER
N100	2	1" ANCHOR CABLE HEX NUT
W100	2	1" ANCHOR CABLE WASHER
B140404	2	1/4" x 4" HEX BOLT
N014	2	1/4" HEX NUT
W014	4	1/4" WASHER
SB58A	8	CABLE ANCHOR BOX SHOULDER BOLT
N055A	8	1/2" A325 STRUCTURAL NUT
W050A	16	1 1/16" OD x 3/16" ID A325 STR. WASHER


Foundation Tube Options For Posts 1 & 2  
 \*6'-0" Split Foundation Tubes S730  
 \*6'-0" Solid Foundation Tubes E731  
 \*5'-0" Foundation Tubes S735 W/Soil Plates SP600  
 \*4'-6" Foundation Tubes E735 W/Soil Plates SP600

# GENERAL NOTES


- Breakaway steel posts are required with the FLEAT Terminal.
- All bolts, nuts, cable assemblies, cable anchors and bearing plates shall be galvanized.
- The soil tubes shall not protrude more than 4" above ground (measured along a 5' cord). Site grading may be necessary to meet this requirement.
- The soil tubes may be driven with an approved driving head. Soil tubes shall not be driven with the post in the tube. If the tubes are placed in drilled holes, the backfill material must be satisfactorily compacted to prevent settlement.
- When rock is encountered during excavation, a 12" Dia. post hole, 20" deep may be used if approved by the engineer. Granular material will be placed in the bottom of the hole approx. 2 1/2" deep to provide drainage. The soil tubes will be field cut to length, placed in the hole and backfilled with adequately compacted material excavated from the hole.
- The breakaway cable assembly must be taut. A locking device, (vice grips or channel lock pliers) should be used to prevent the cable from twisting when tightening nuts.
- (R) or (L) indicates right or left Impact Head Reflector Marker (IHRM). Providing and installing of IHRM shall be considered incidental to end treatment.
- The stripes for IHRM shall slope downward at an angle of 45° towards the side of the end treatment that traffic is to pass.

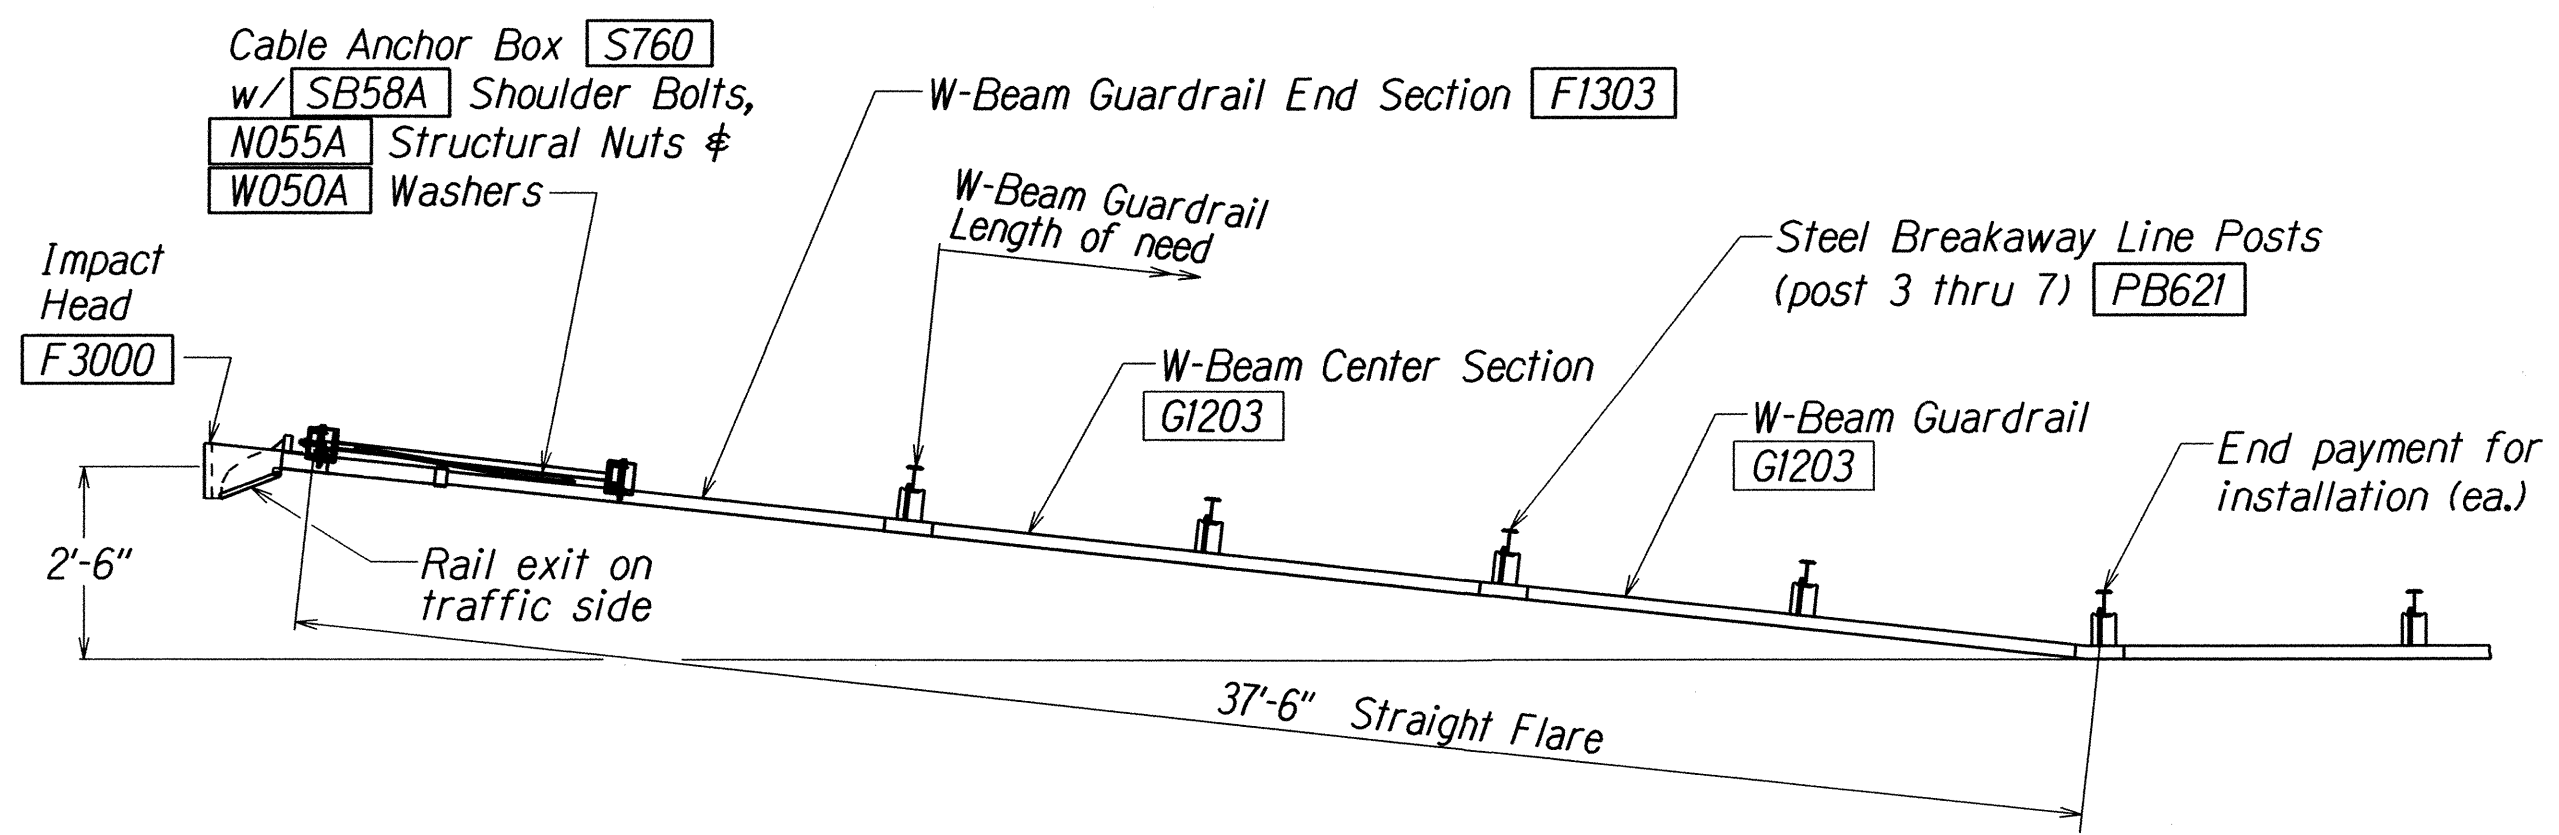


PLAN

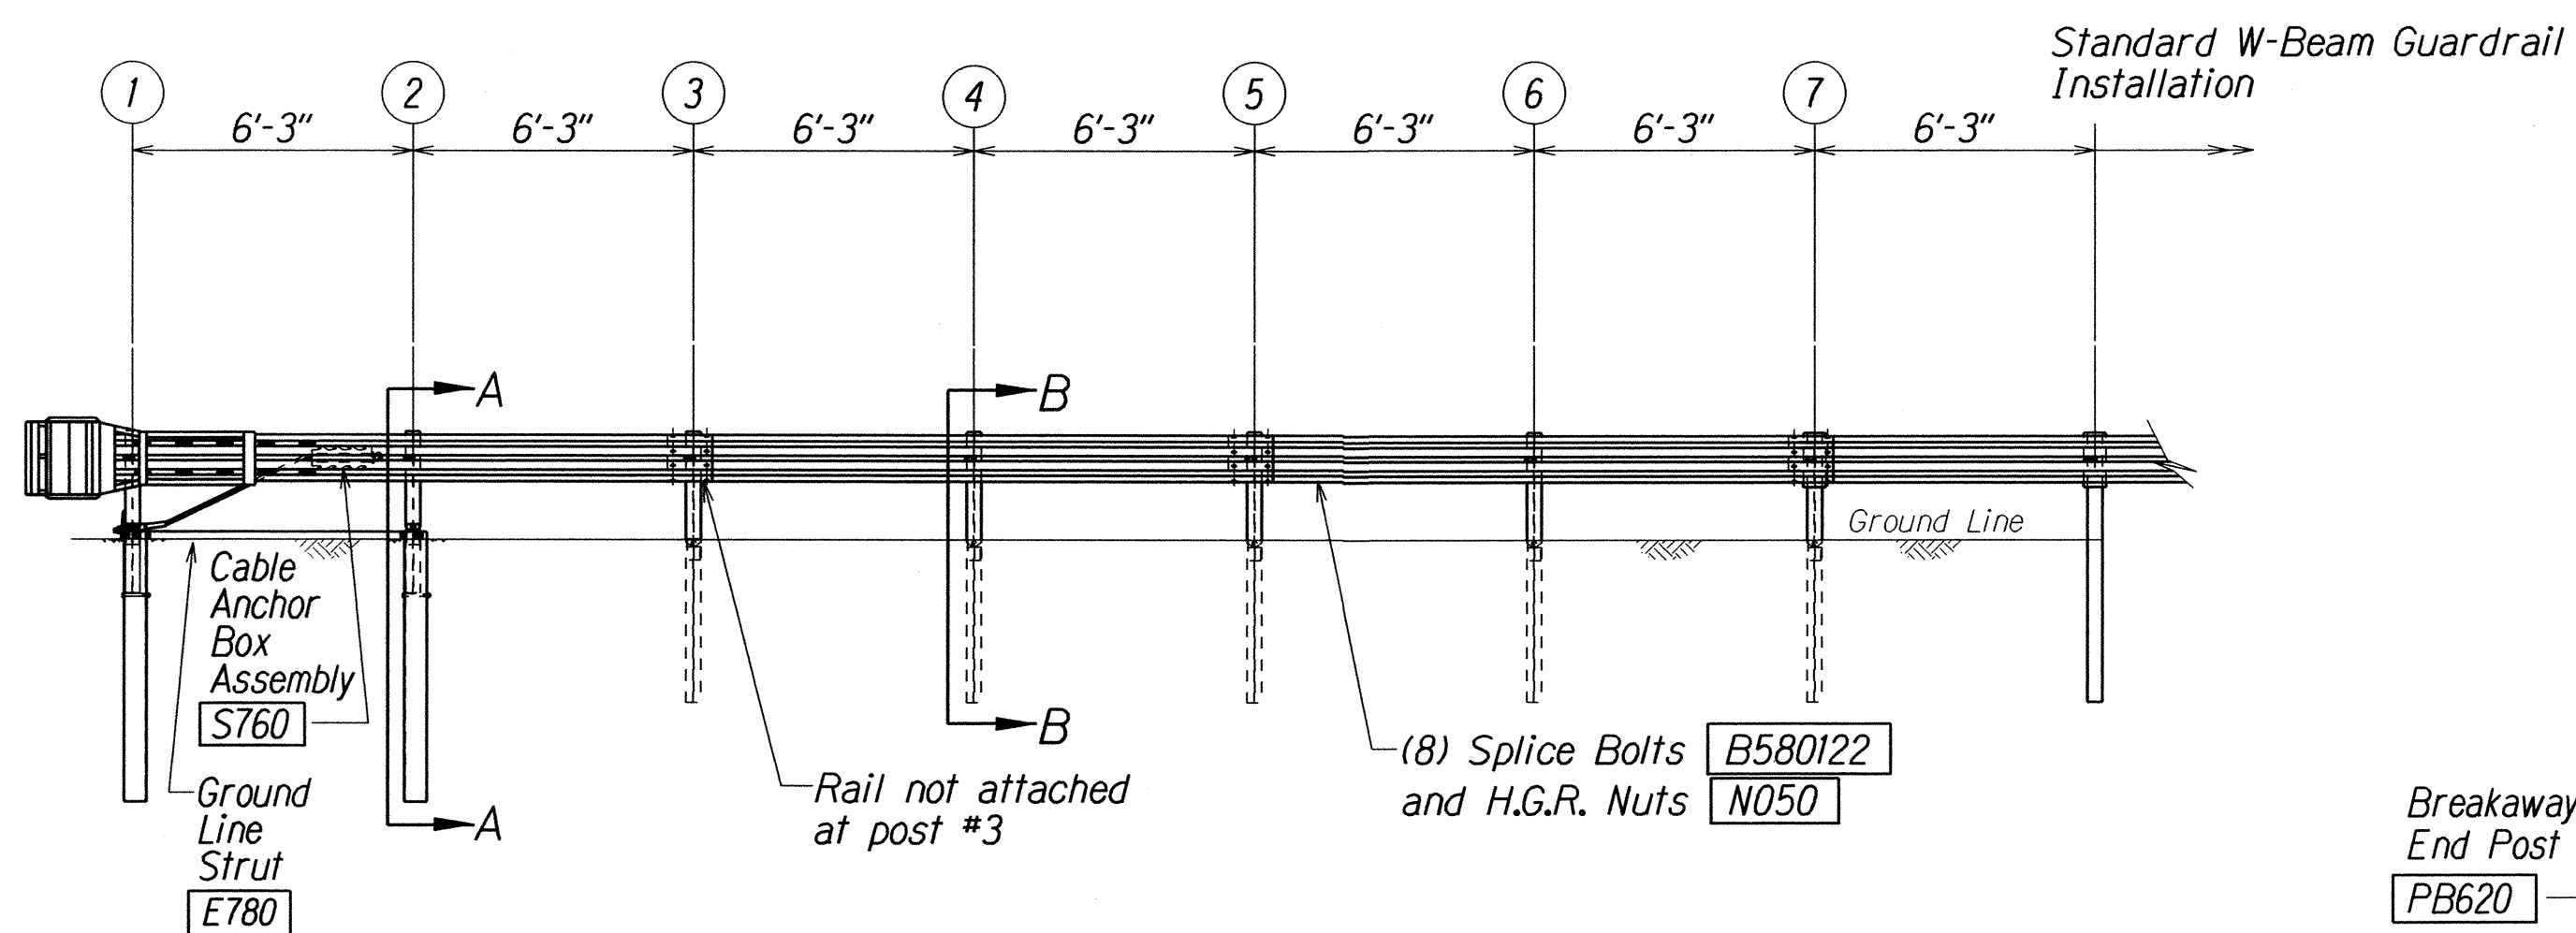


ELEVATION

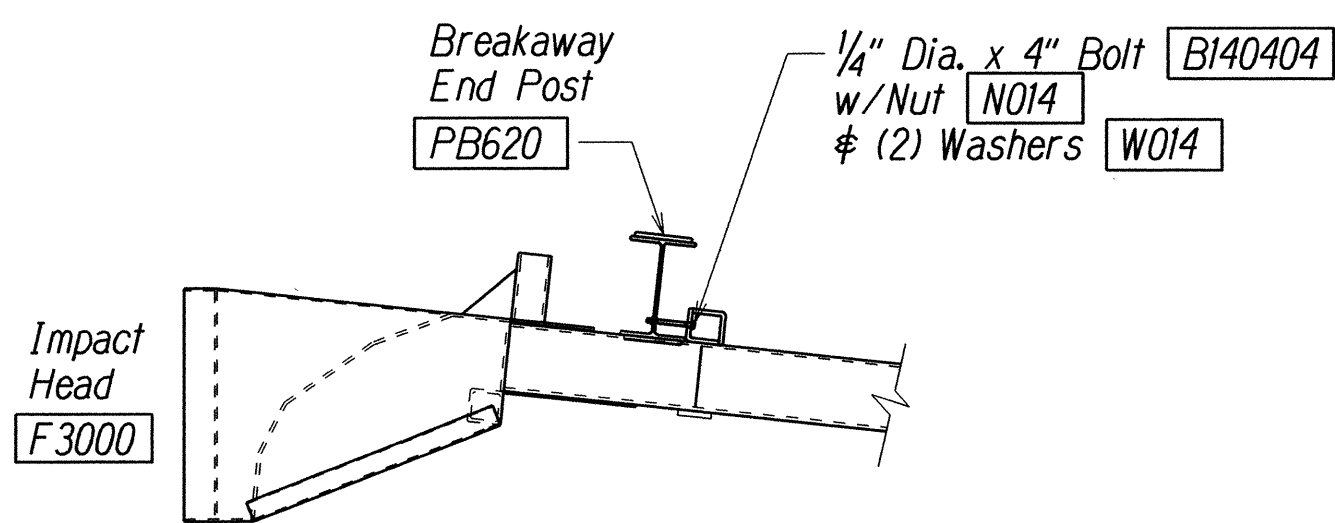


IMPACT HEAD CONNECTING DETAIL

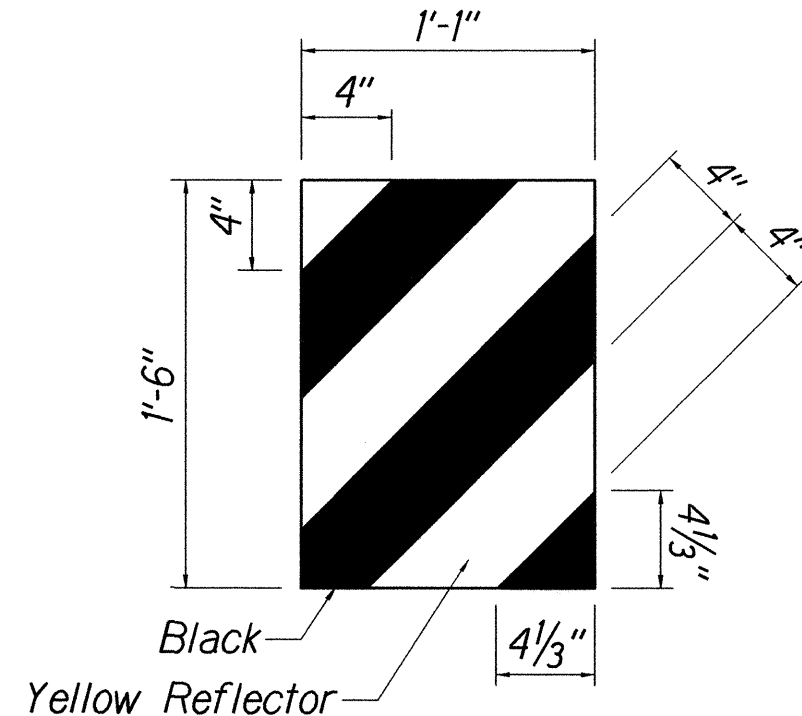


IHRM(R)  
IMPACT HEAD REFLECTOR  
MARKER INSERT  
DETAIL

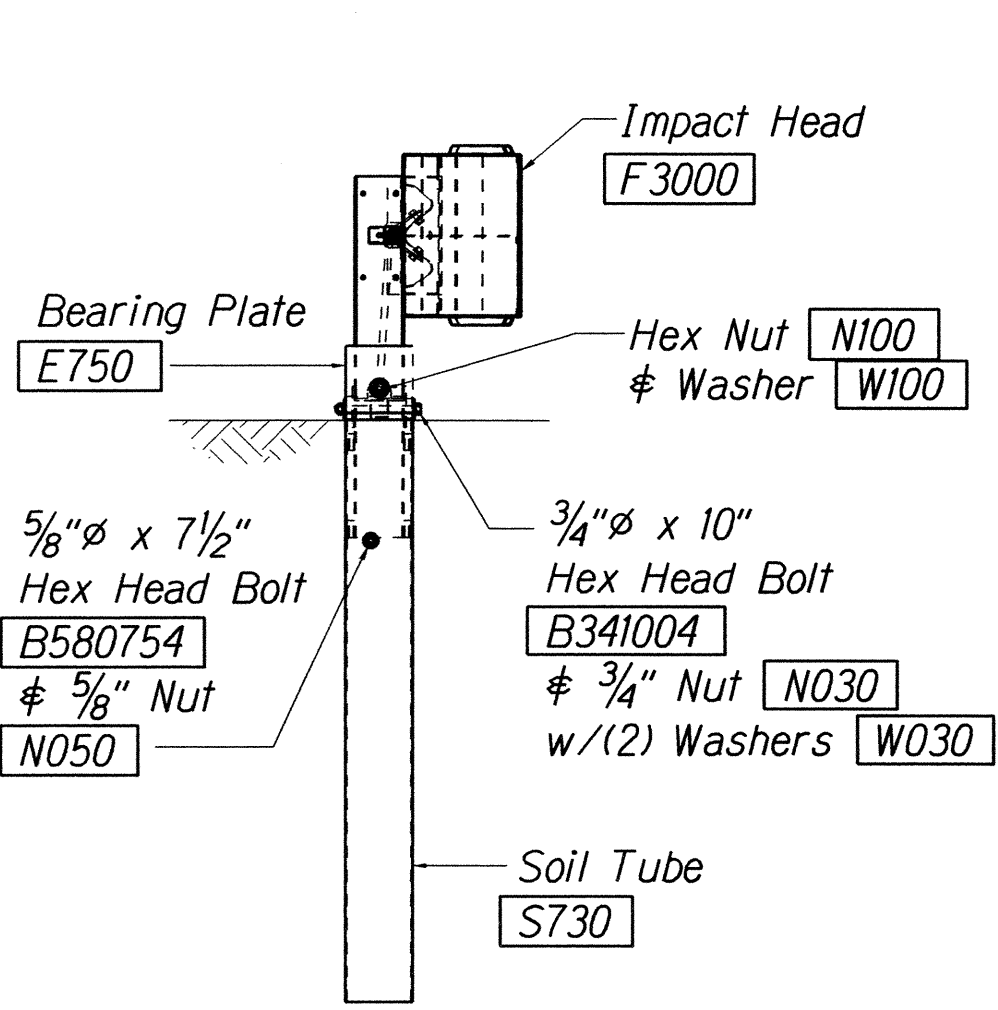


FRONT VIEW OF POST 1

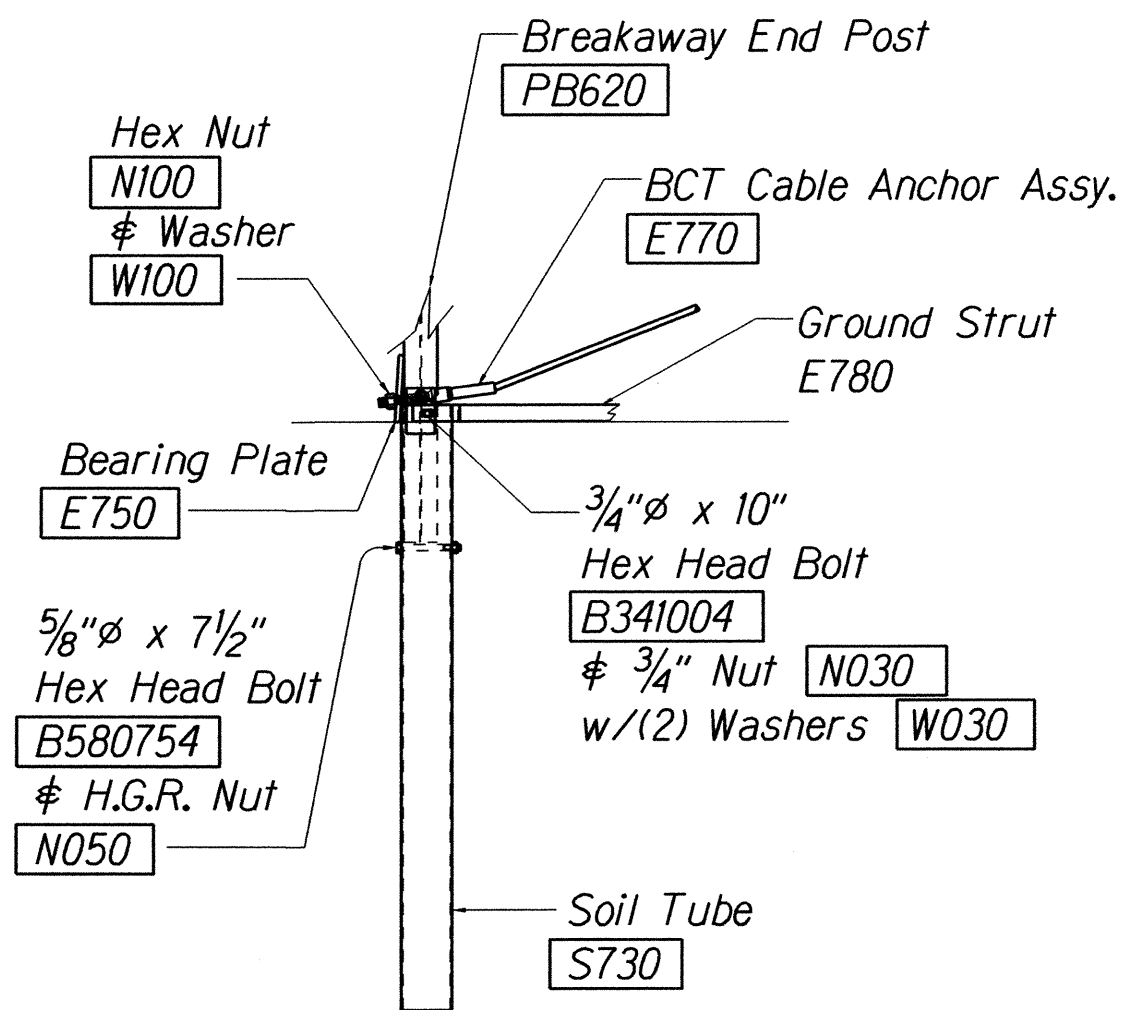

PARTIAL VIEW OF POST 1

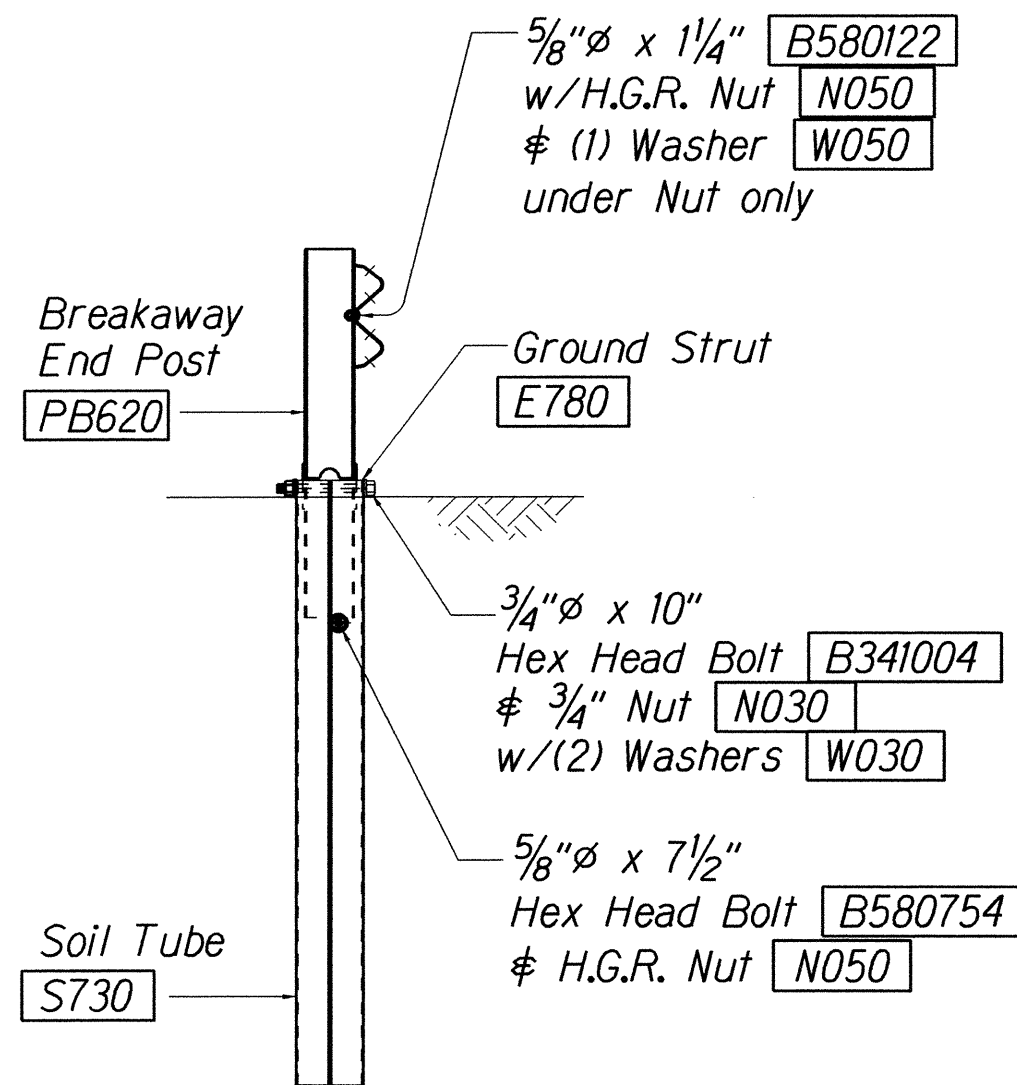

SECTION A-A  
at Post #2

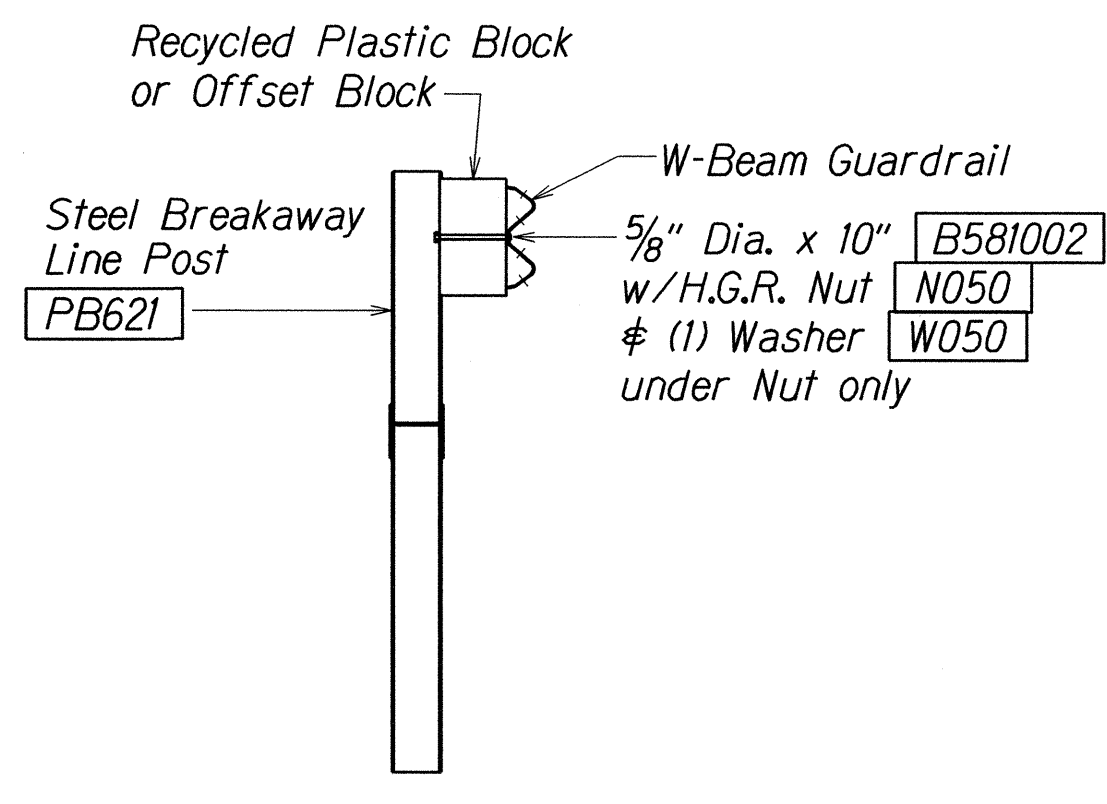


SECTION B-B  
(Typical @ Post 3 - 7)  
NOTE: RAIL NOT BOLTED @ POST #3

4-12-16	Additional Details of FLEAT-350.
DATE	REVISION
STATE OF HAWAII DEPARTMENT OF TRANSPORTATION HIGHWAYS DIVISION <b>FLEAT-350</b> <b>FLARED ENERGY ABSORBING TERMINAL</b> HANA HWY. RESURFACING, Haleakala Hwy. to Paia and HALEAKALA HIGHWAY RESURFACING Hana Highway to North Firebreak Rd. Project No. HWY-M-01-15M Scale: As Noted Date: April, 2016 SHEET No. 4 OF 5 SHEETS	


SURVEY PLOTTED BY	DATE
DESIGNED BY	
NOTED BY	
CHECKED BY	
ORIGINAL	
NOTE BOOK	
QUANTITIES BY	
CHECKED BY	

Standard plan TE-61 11/02/89 & TE-62 109/01/87  
 tdl:rubyl/guardrail/fleat350.dgn  
 18/12/02


FED. ROAD DIST. NO.	STATE	PROJ. NO.	FISCAL YEAR	SHEET NO.	TOTAL SHEETS
HAWAII	HAW.	HWY-M-01-15M	2016	ADD.11S-5	41

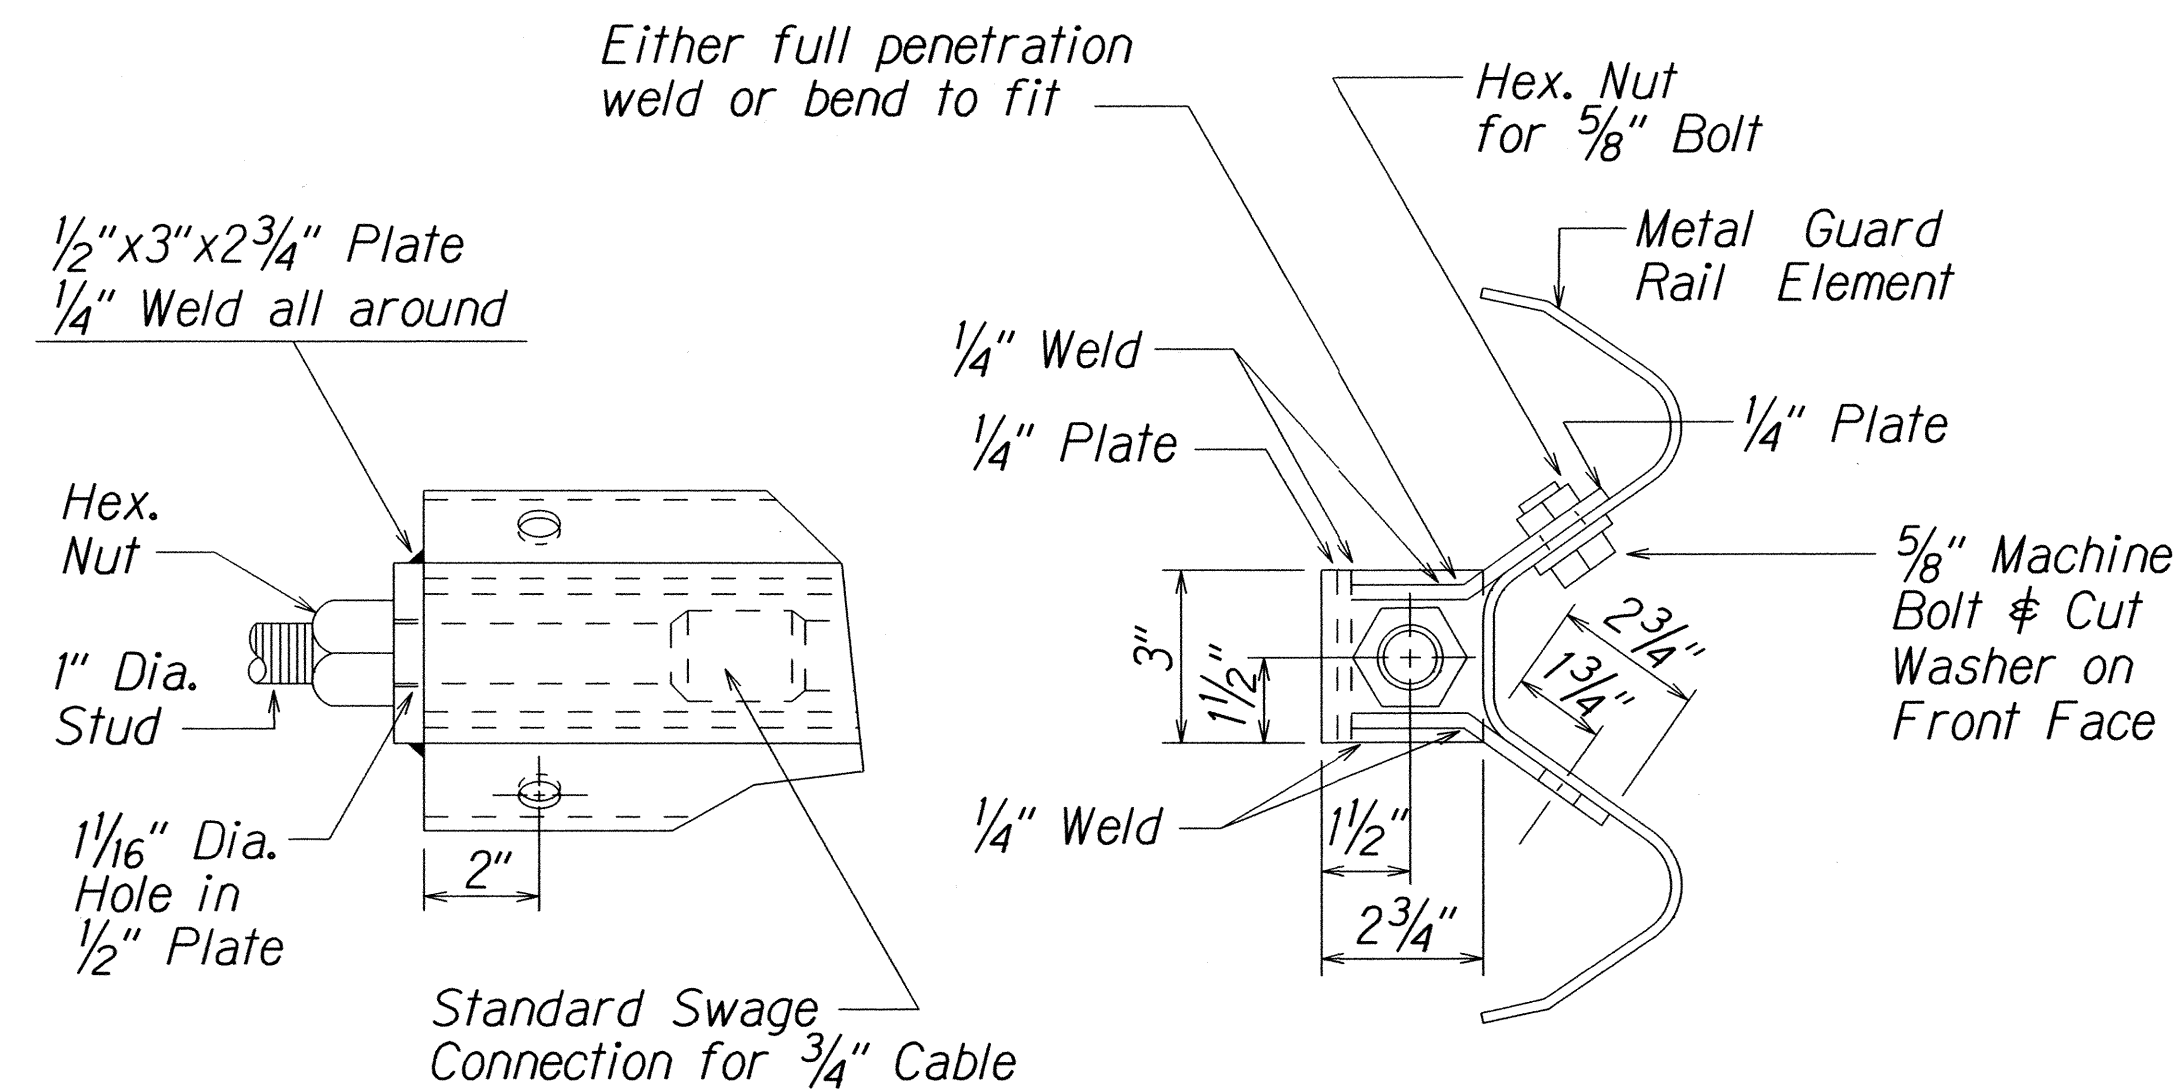

ANCHOR PLATE DETAILS

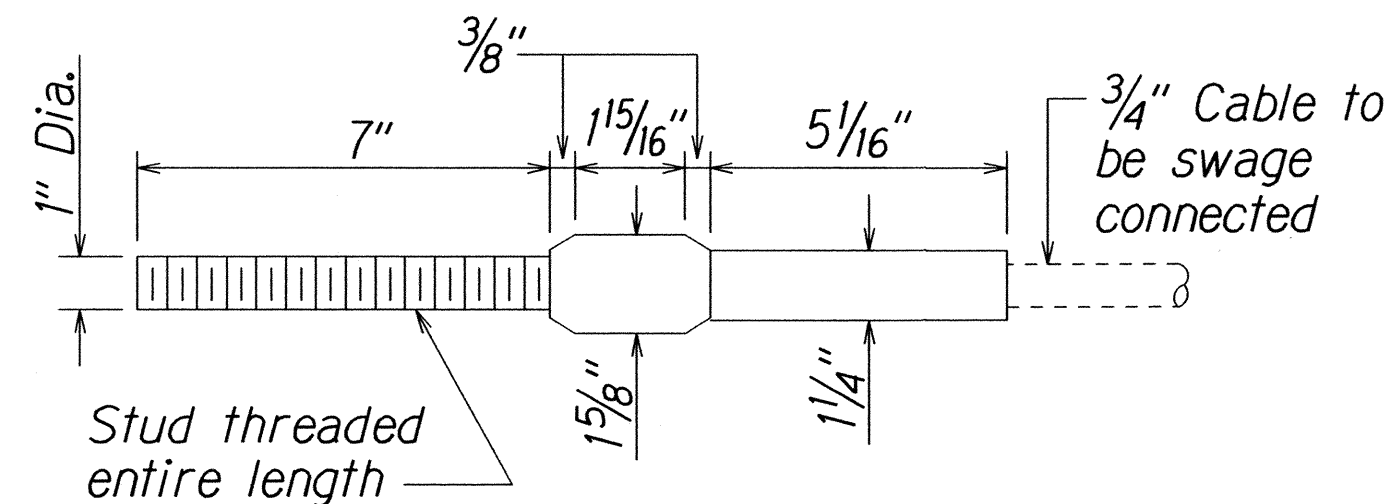


STANDARD SWAGED FITTING  
AND STUD

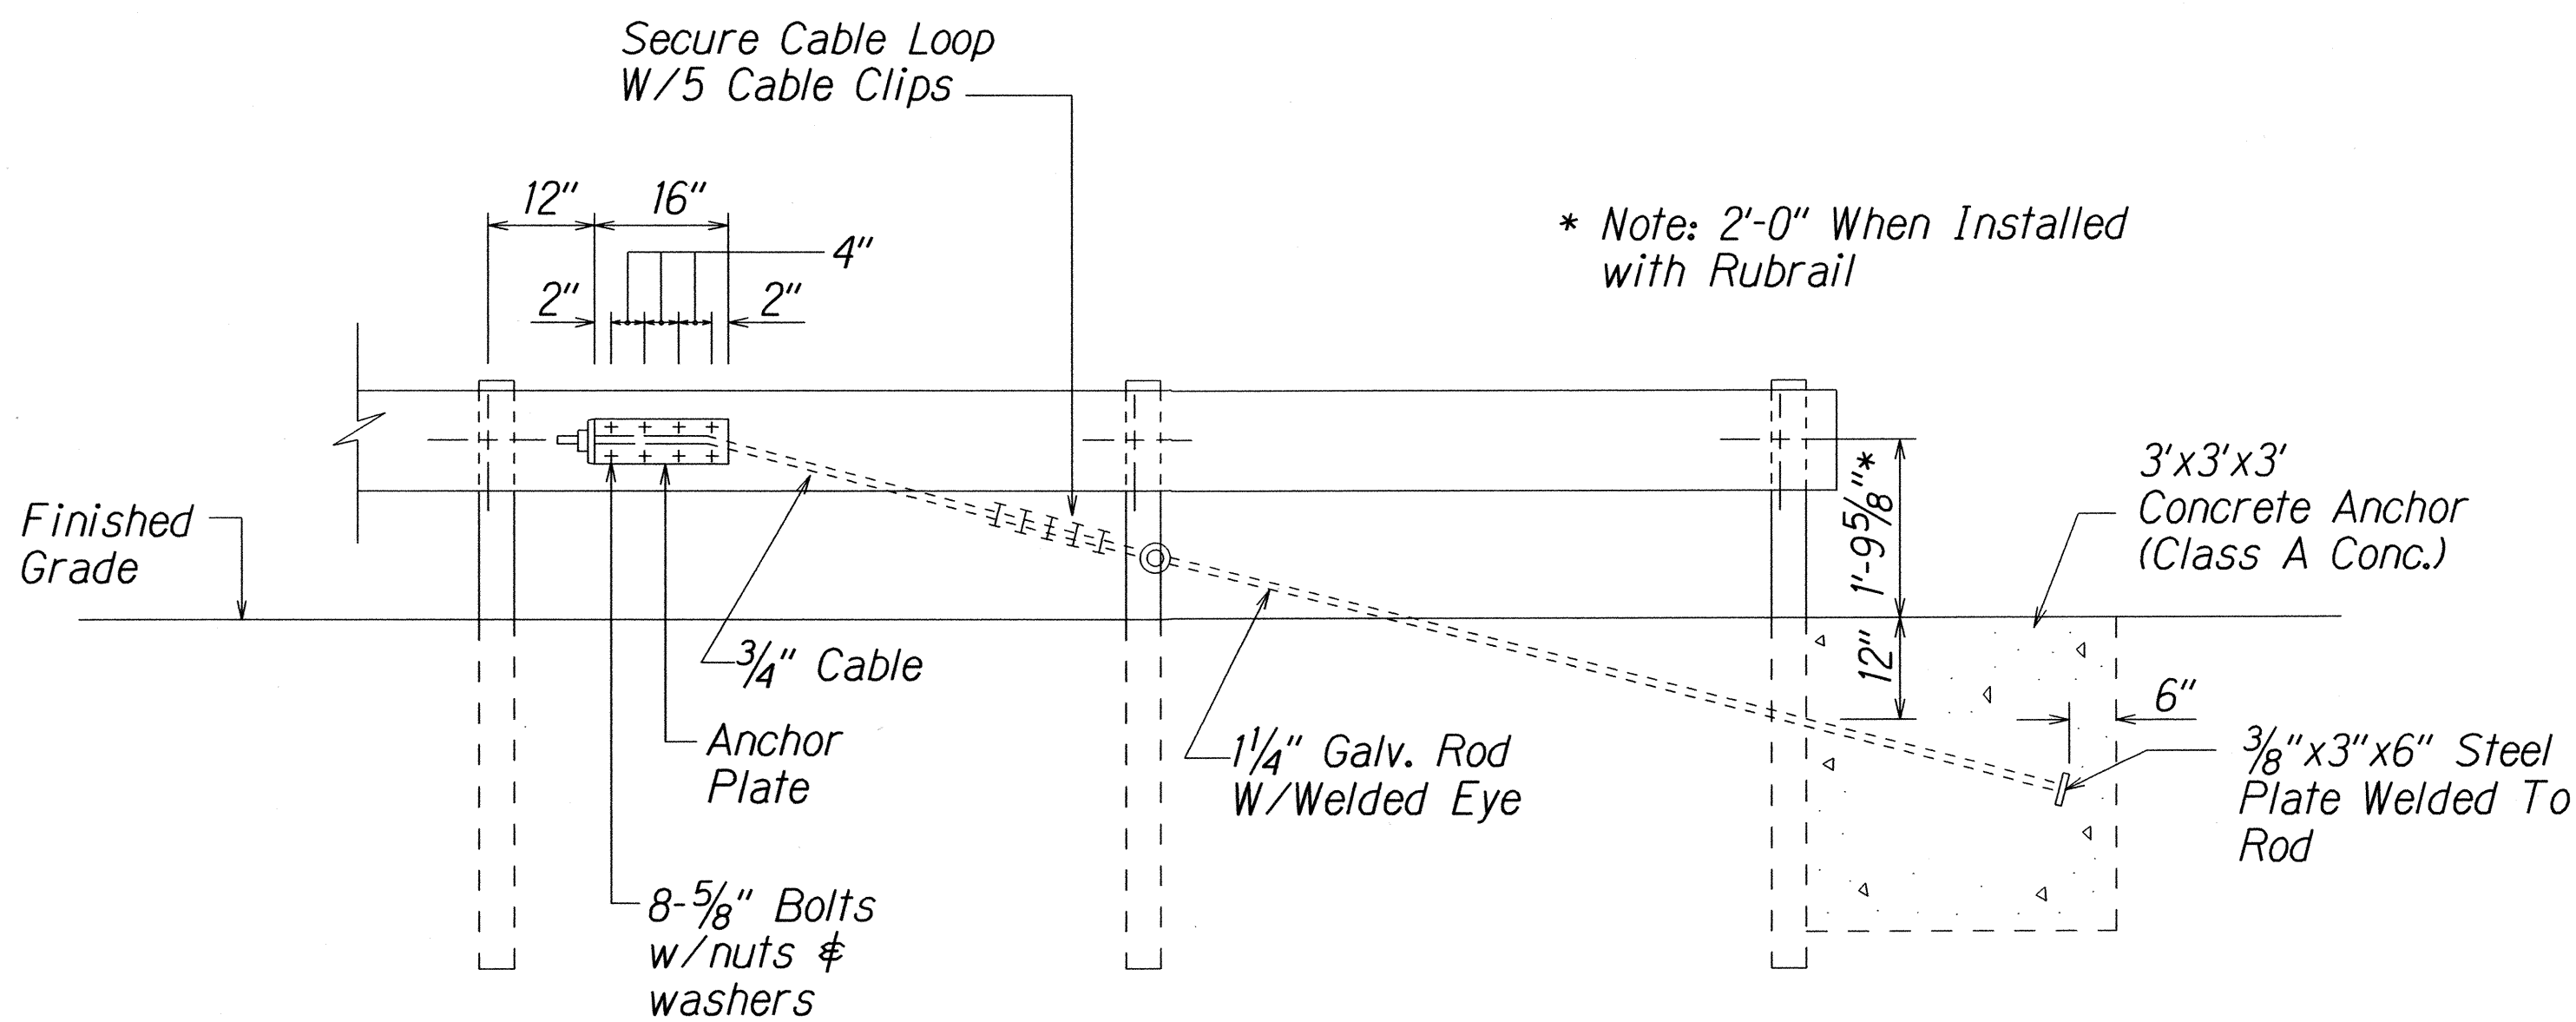

ANCHOR BLOCK DETAIL

- Concrete, G.R.P., excavation, anchor rod and miscellaneous appurtenances necessary to anchor the guardrail ends shall be incidental to metal guardrail.

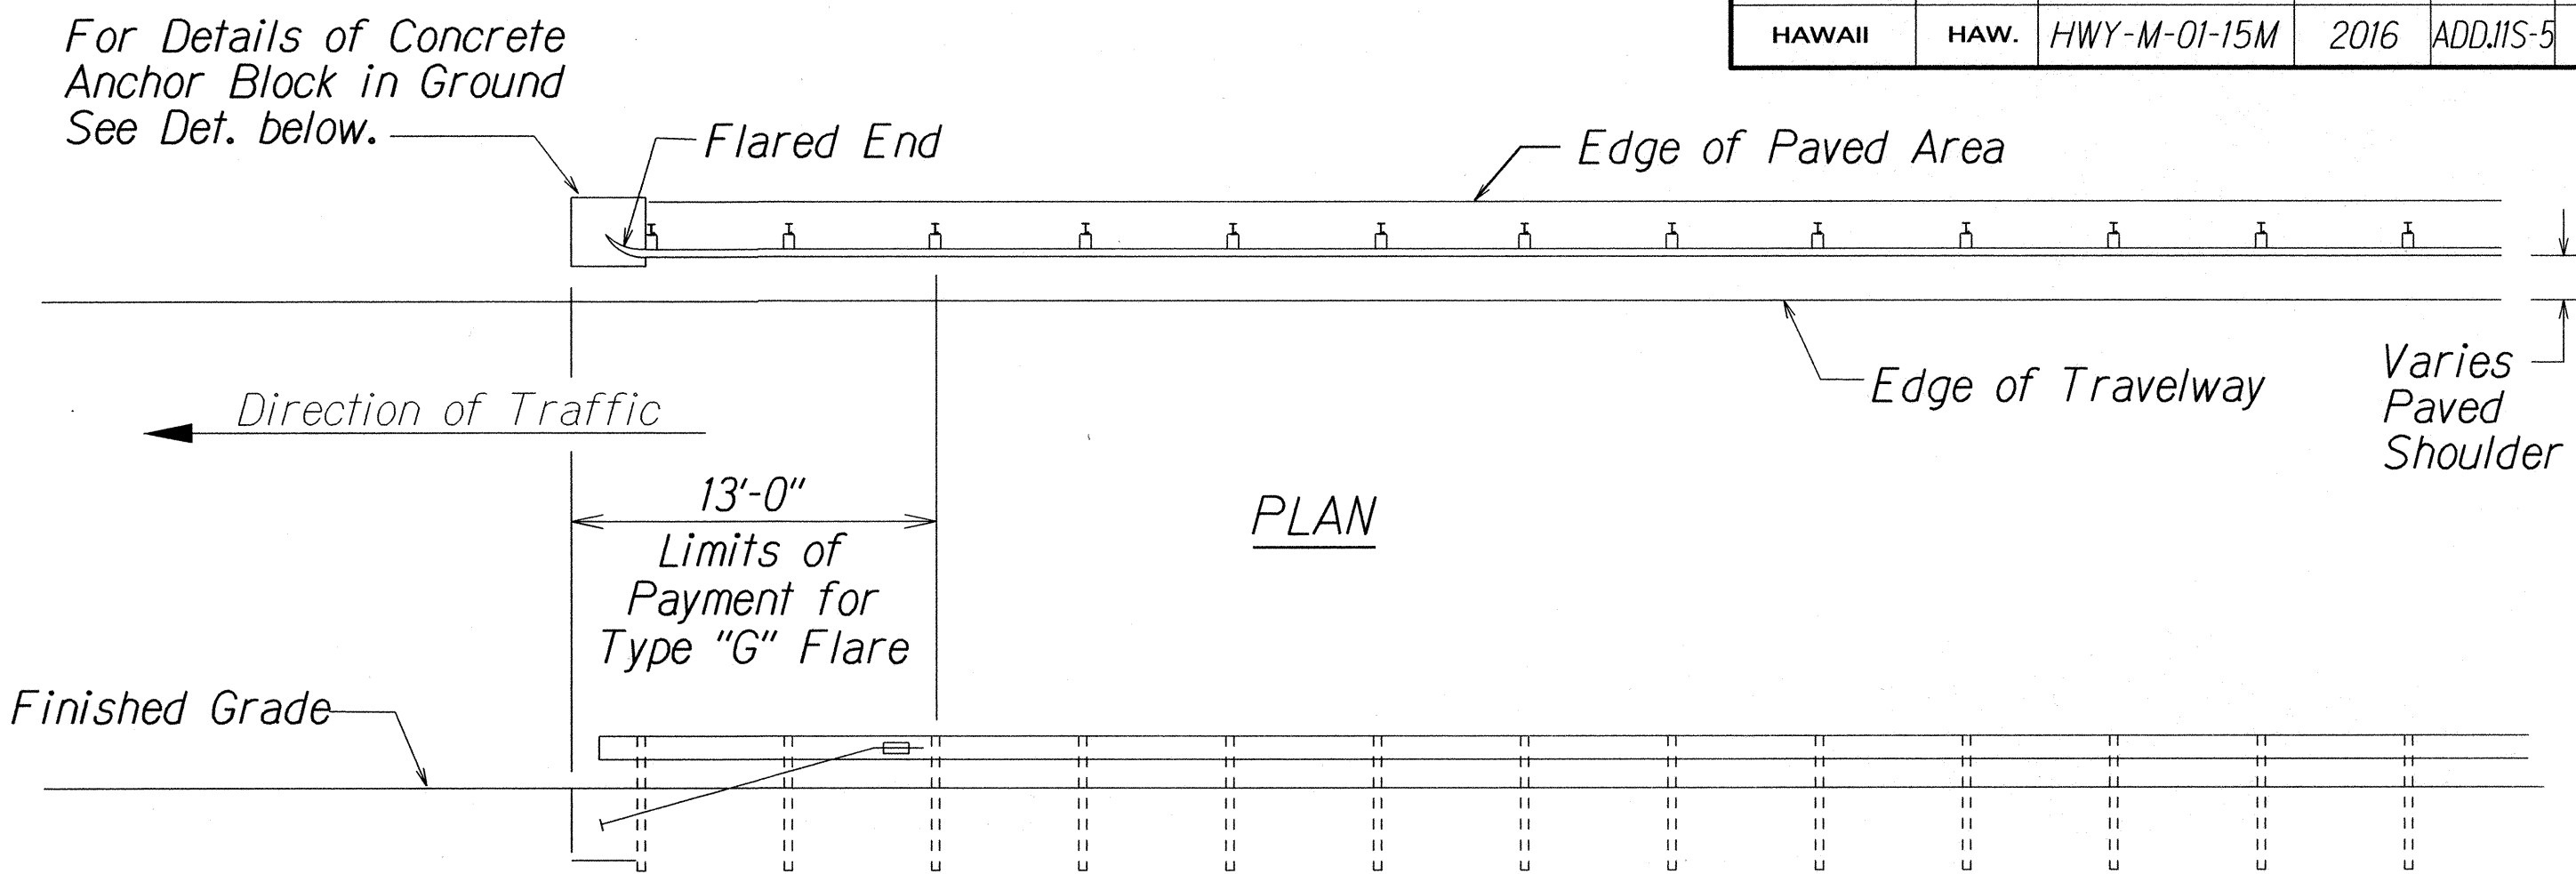

ELEVATION

TYPE "G" FLARE END TERMINAL

NOTE:

Type "G" Modified End Terminal is a site specific end terminal with a taper and radial termini. A site specific detailed drawing is required for all Type "G" Modified End Terminal and must receive Engineer's approval.

The taper (flare rate) of the guardrail shall follow the latest edition of AASHTO'S Roadside Design Guide (currently, Table 5.6 - Suggested Flare Rate for Barrier Design, page 5-21, Jan. 1996 edition).

The radius of the radial termini is an Engineer's judgement based on the site evaluation. The Engineer shall consider safety (minimize the spearing & blunt end situation); degree and potential seriousness of the hazard; bicycle and pedestrian accessibility; maintenance equipment accessibility; Right-of-Way availability; the smallest radii the metal w-beam/thrie-beam railing can be constructed (check with supplier/contractor); posted speed limit; angle of vehicle impact; and aesthetics when designing the Type "G" Modified End Terminal.

During construction, the Contractor shall layout the proposed Type "G" Modified End Terminal and receive approval from the Construction Engineer prior to installation.

ORIGINAL PLAN	SURVEY PLOTTED BY	DATE
NOTE BOOK	DRAWN BY	
	DESIGNED BY	
	QUANTITIES BY	
	CHECKED BY	

12/13/02 141-ruby/guardrail/1452/rev.dgn (standard plan TE-59 rev/03/89)

4-12-16	Additional Details of Type G End Terminal.
DATE	REVISION

STATE OF HAWAII DEPARTMENT OF TRANSPORTATION HIGHWAYS DIVISION <b>GUARDRAIL DETAILS</b> HANA HIGHWAY RESURFACING Haleakala Highway to Paia and HALEAKALA HIGHWAY RESURFACING Hana Highway to North Firebreak Rd. Project No. HWY-M-01-15M Scale: As Shown Date: April, 2016 SHEET No. 5 OF 5 SHEETS
---