

INDEX TO DRAWINGS	
SHEET NO.	DESCRIPTION
1	TITLE SHEET
2-3	GENERAL NOTES FOR CONSTRUCTION
4-6	WATER POLLUTION AND EROSION CONTROL NOTES
7	TRAFFIC SIGNAL LOCATION MAP 1
8	TRAFFIC SIGNAL LOCATION MAP 2
9	TRAFFIC SIGNAL LOCATION MAP 3

STATE OF HAWAII

DEPARTMENT OF TRANSPORTATION

HIGHWAYS DIVISION

HONOLULU, HAWAII

"AS-BUILT"

PLANS FOR

TRAFFIC SIGNAL MODERNIZATION



AT VARIOUS LOCATIONS

PROJ. NO. HWY-M-02-17

DISTRICTS OF LAHAINA, MAKAWAO AND WAILUKU

ISLAND OF MAUI

FED. ROAD DIST. NO.	STATE	PROJ. NO.	FISCAL YEAR	SHEET NO.	TOTAL SHEETS
HAWAII	HAW.	HWY-M-02-17	2017	1	9

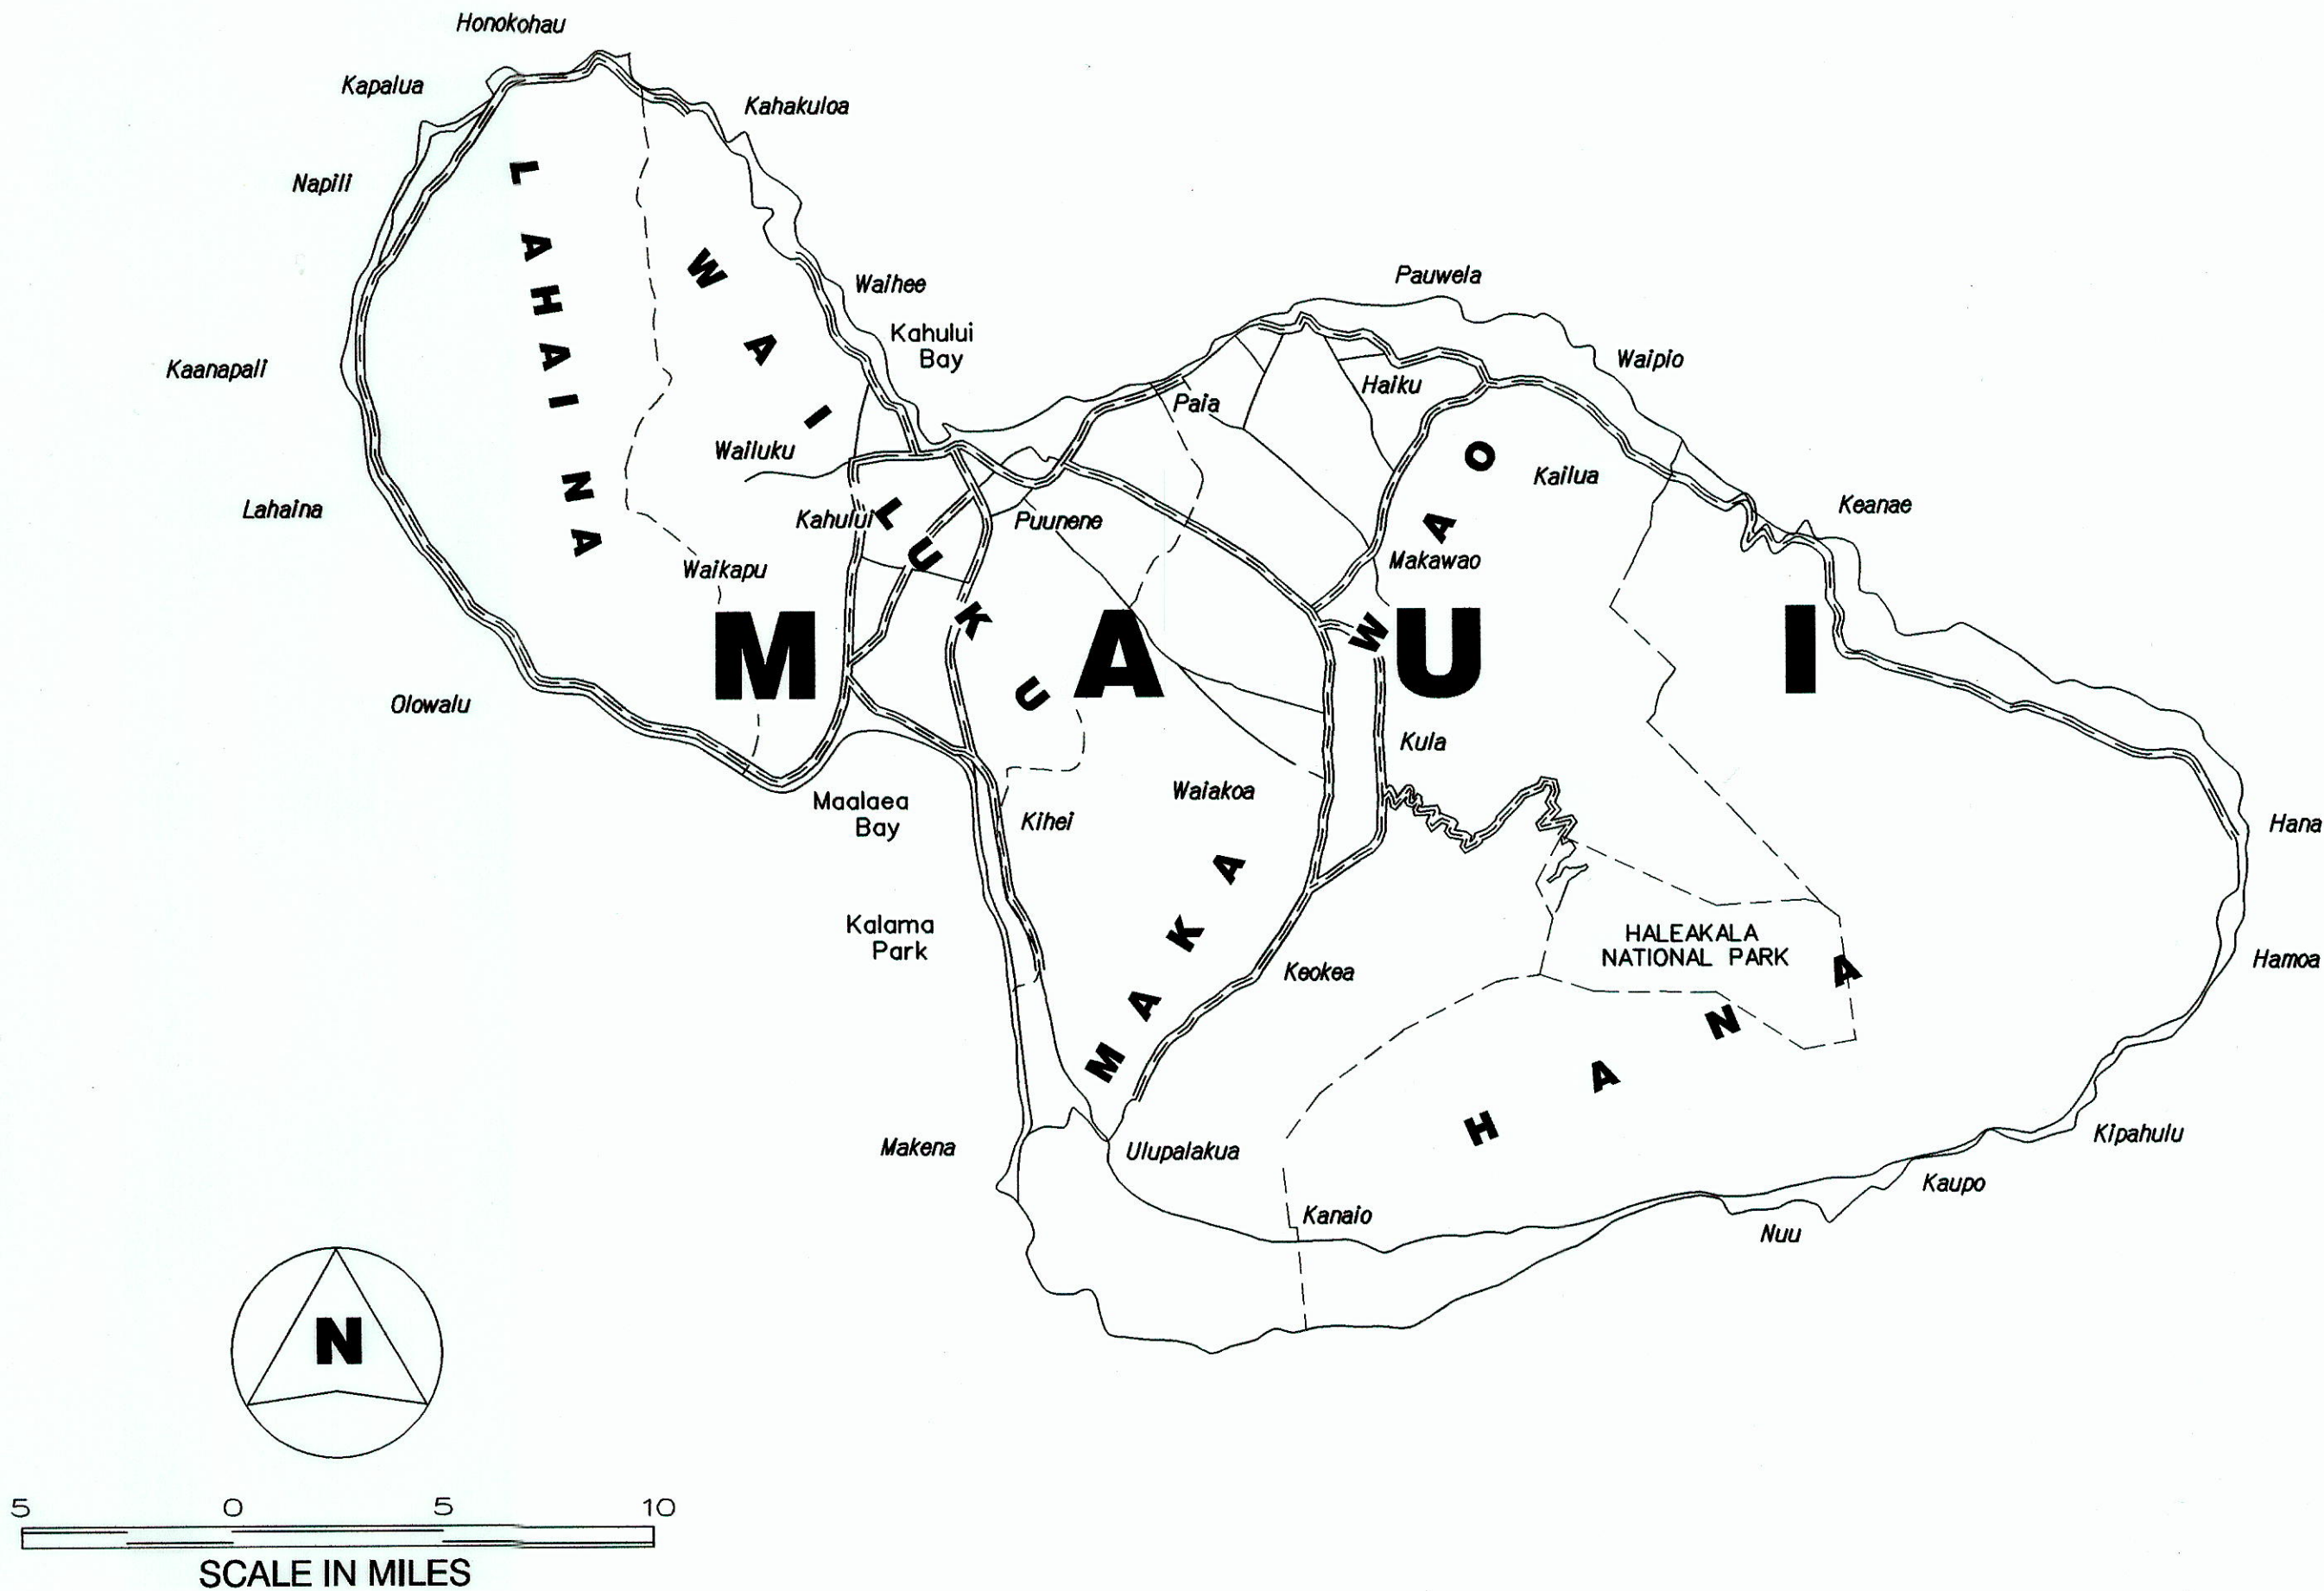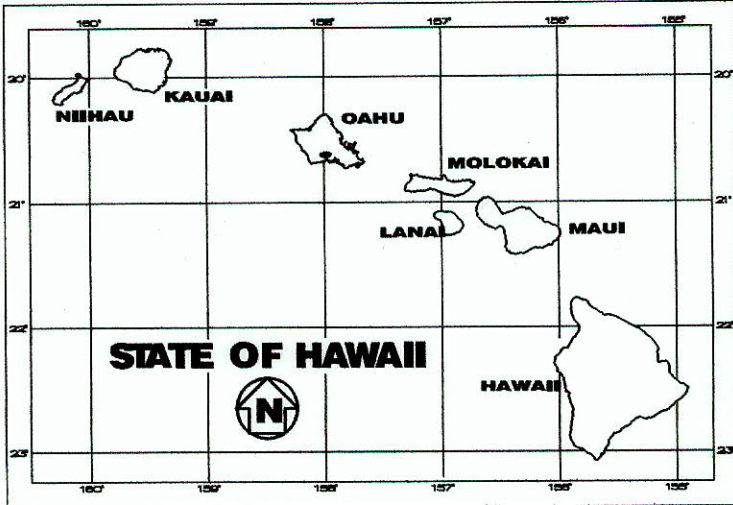

----- FEDERAL AID PROJECTS PREVIOUSLY CONSTRUCTED OR UNDER CONSTRUCTION

CHANGES MADE DURING CONSTRUCTION HAVE BEEN INCORPORATED ON THESE PLANS EXCEPT CHANGES IN THE ORIGINAL THEORETICAL QUANTITIES. FOR ACTUAL QUANTITIES, REFER TO PROJECT LEDGER AND/OR COMPUTATION BOOK.

RESIDENT ENGINEER 1/17/17 DATE

DEPARTMENT OF TRANSPORTATION
STATE OF HAWAII

APPROVED: *[Signature]* 5/22/17
DIR. OF TRANSPORTATION DATE

Austin Tsutsumi and Associates, Inc. X (808)244-8044 4/21/17 DATE
DESIGNED BY P. S. & E. BY PHONE

"AS-BUILT"