


Route No.	Route Name	Intersecting Street	Mile Post	Travel Time Device	Route No.	Route Name	Intersecting Street	Mile Post	Travel Time Device
30 32	Main Street	High Street	0	No YES	32	Kaahumanu Ave.	Lunalilo/Kainani	0.7	No
30 32	Main Street	Market Street	0.2	No	32	Kaahumanu Ave.	Maui Lani Parkway	0.9	Yes
30 32	Main Street	Central Avenue	0.3	Yes	32	Kaahumanu Ave.	Kanaloa/Mahalani	1.2	No
30	Honoapiilani	Kohalani	0.9	No	32	Kaahumanu Ave.	Papa/Wahinepi'o	1.4	No
30	Honoapiilani	Kuikahi	1	No	32	Kaahumanu Ave.	Wakea	1.7	No
30	Honoapiilani	Pilikana	2	No	32	Kaahumanu Ave.	Shopping Center	1.9	No
30	Honoapiilani	Waiko	2.9	No	32	Kaahumanu Ave.	Kahului Beach Rd./Kane	2.1	Yes

32	Kaahumanu Ave.	Lono	2.3	No
32	Kaahumanu Ave.	Puunene	2.5	Yes
32	Kaahumanu Ave.	Wharf	2.6	No
36	Hana Highway	Hobron/Kamehameha	0.1	No
36	HANA HIGHWAY	WAKEA ST.	0.4	NO
36	Hana Highway	Dairy	0.8	Yes NO
36	Hana Highway	Airport Access Rd.	1.0	Yes
36	Hana Highway	Hookele	1.3	No
36A	Haleakala	Keolani	0.1	No
308 380	Dairy	Alamaha	0.4	No
308 380	Dairy	Maui Market Pl. MARKETPLACE	0.6	No
308 380	Dairy	Pakaula/KAA PAKAULA/AIRPORT ACCESS RD.	0.8	No
308 380	Kuihelani/AIRPORT ACCESS RD.	Puunene/Mokulele MAUI VETERANS	1	Yes
308 380	Kuihelani	Maui Lani Pkwy.	2.4	Yes
308 380	Kuihelani	E. Waiko	3.5	No
308	Kuihelani	Cane-Haut NON-EXIST	3.8	No
311	Mokulele MAUI VETERANS	Hookele	0.1	No
311	Mokulele MAUI VETERANS	Hansen	0.8	No
3400	Kahului Beach Rd.	Wahinepi'o WAHINEPI'O	0.4	No
3400	Kahului Beach Rd.	Kanaloa	0.9	No
3400	Wahinepi'o Kahului Beach Rd.	Lower Main/Wahinepi'o Beach Rd.	1.1	No
3400	Wahinepi'o Kahului Beach Rd.	Eha	1.6	No
3500	Puunene	Kamehameha	0.2	No
3500	Puunene	Wakea	0.5	No
3500	Puunene	Papa	0.8	No

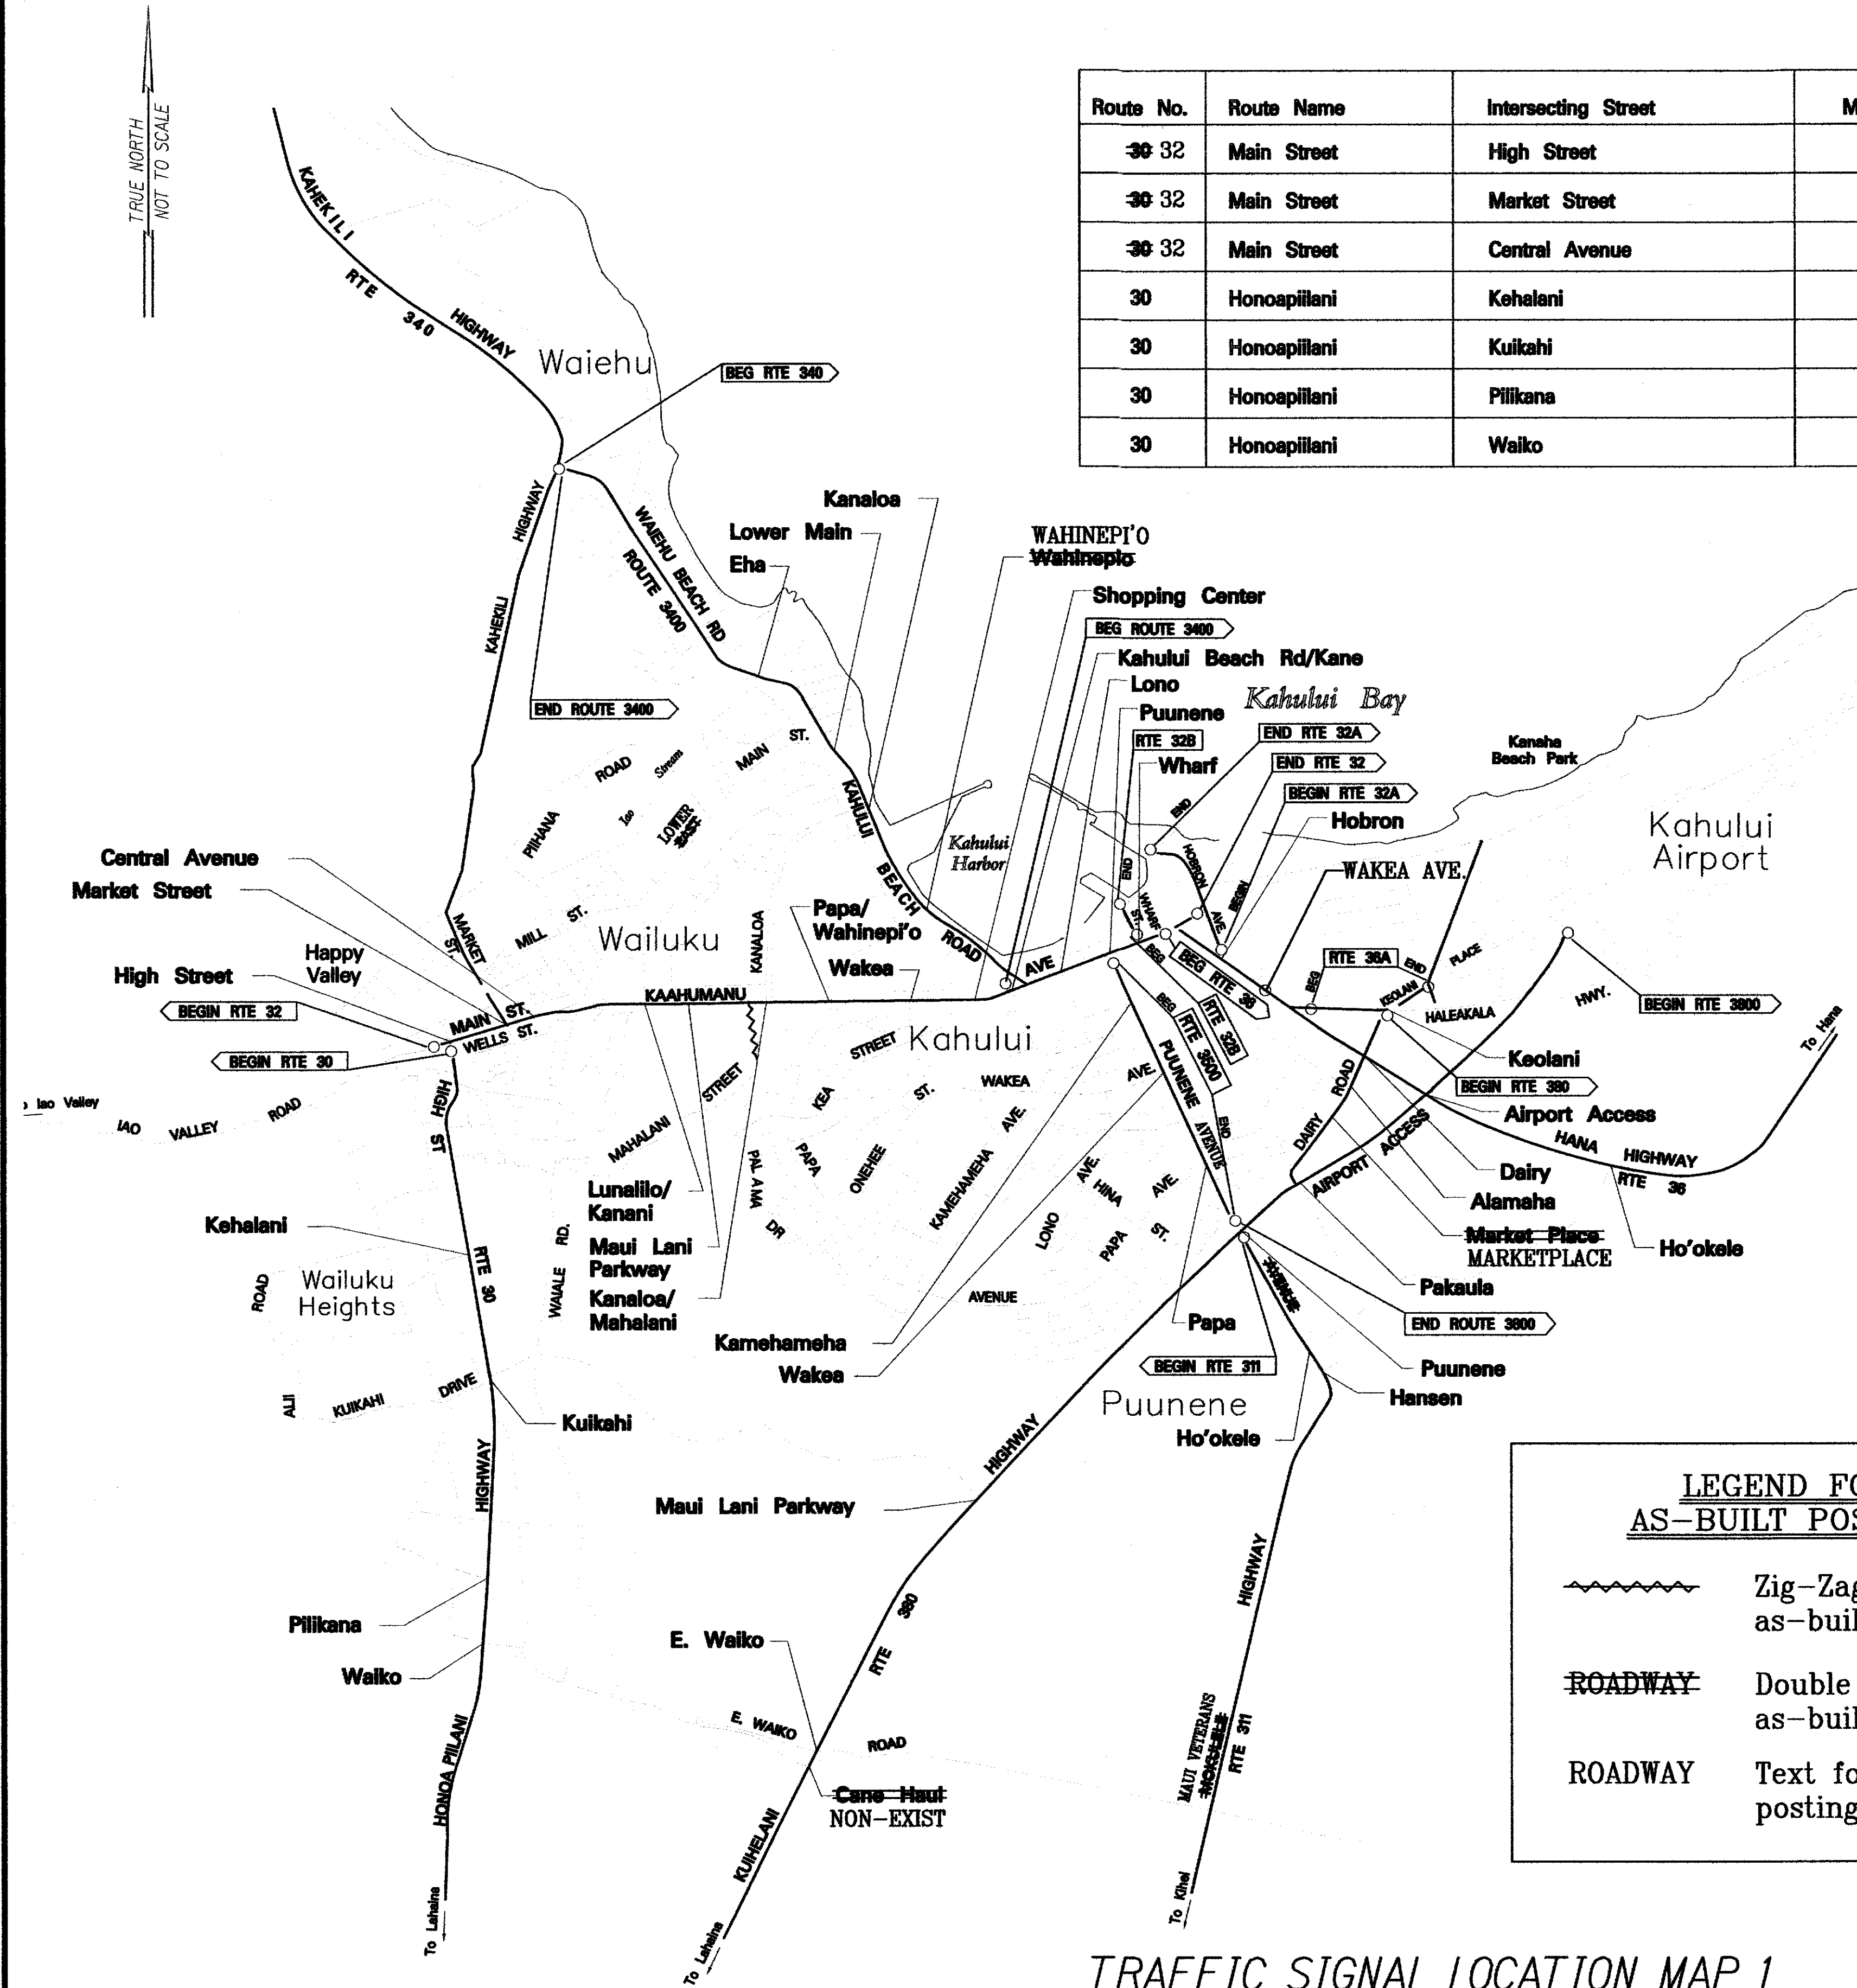


LEGEND FOR
AS-BUILT POSTING

Zig-Zag line for
as-built deletion

Double line for
as-built deletion

Text for as-built
posting

TRAFFIC SIGNAL LOCATION MAP 1
Not To Scale

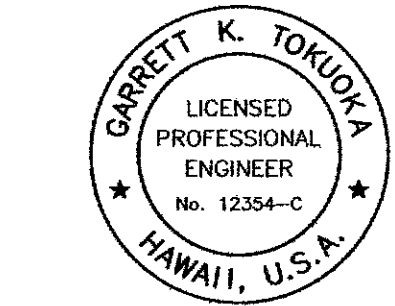

THIS WORK WAS PREPARED BY
ME OR UNDER MY SUPERVISION.
[Signature]
APRIL 30, 2018
LIC. EXP. DATE

STATE OF HAWAII
DEPARTMENT OF TRANSPORTATION
HIGHWAYS DIVISION

TRAFFIC SIGNAL LOCATION MAP 1

TRAFFIC SIGNAL MODERNIZATION
AT VARIOUS LOCATIONS
District of Maui

Scale: As Shown Date: January, 2017

SHEET No. C-6 OF 9 SHEETS