



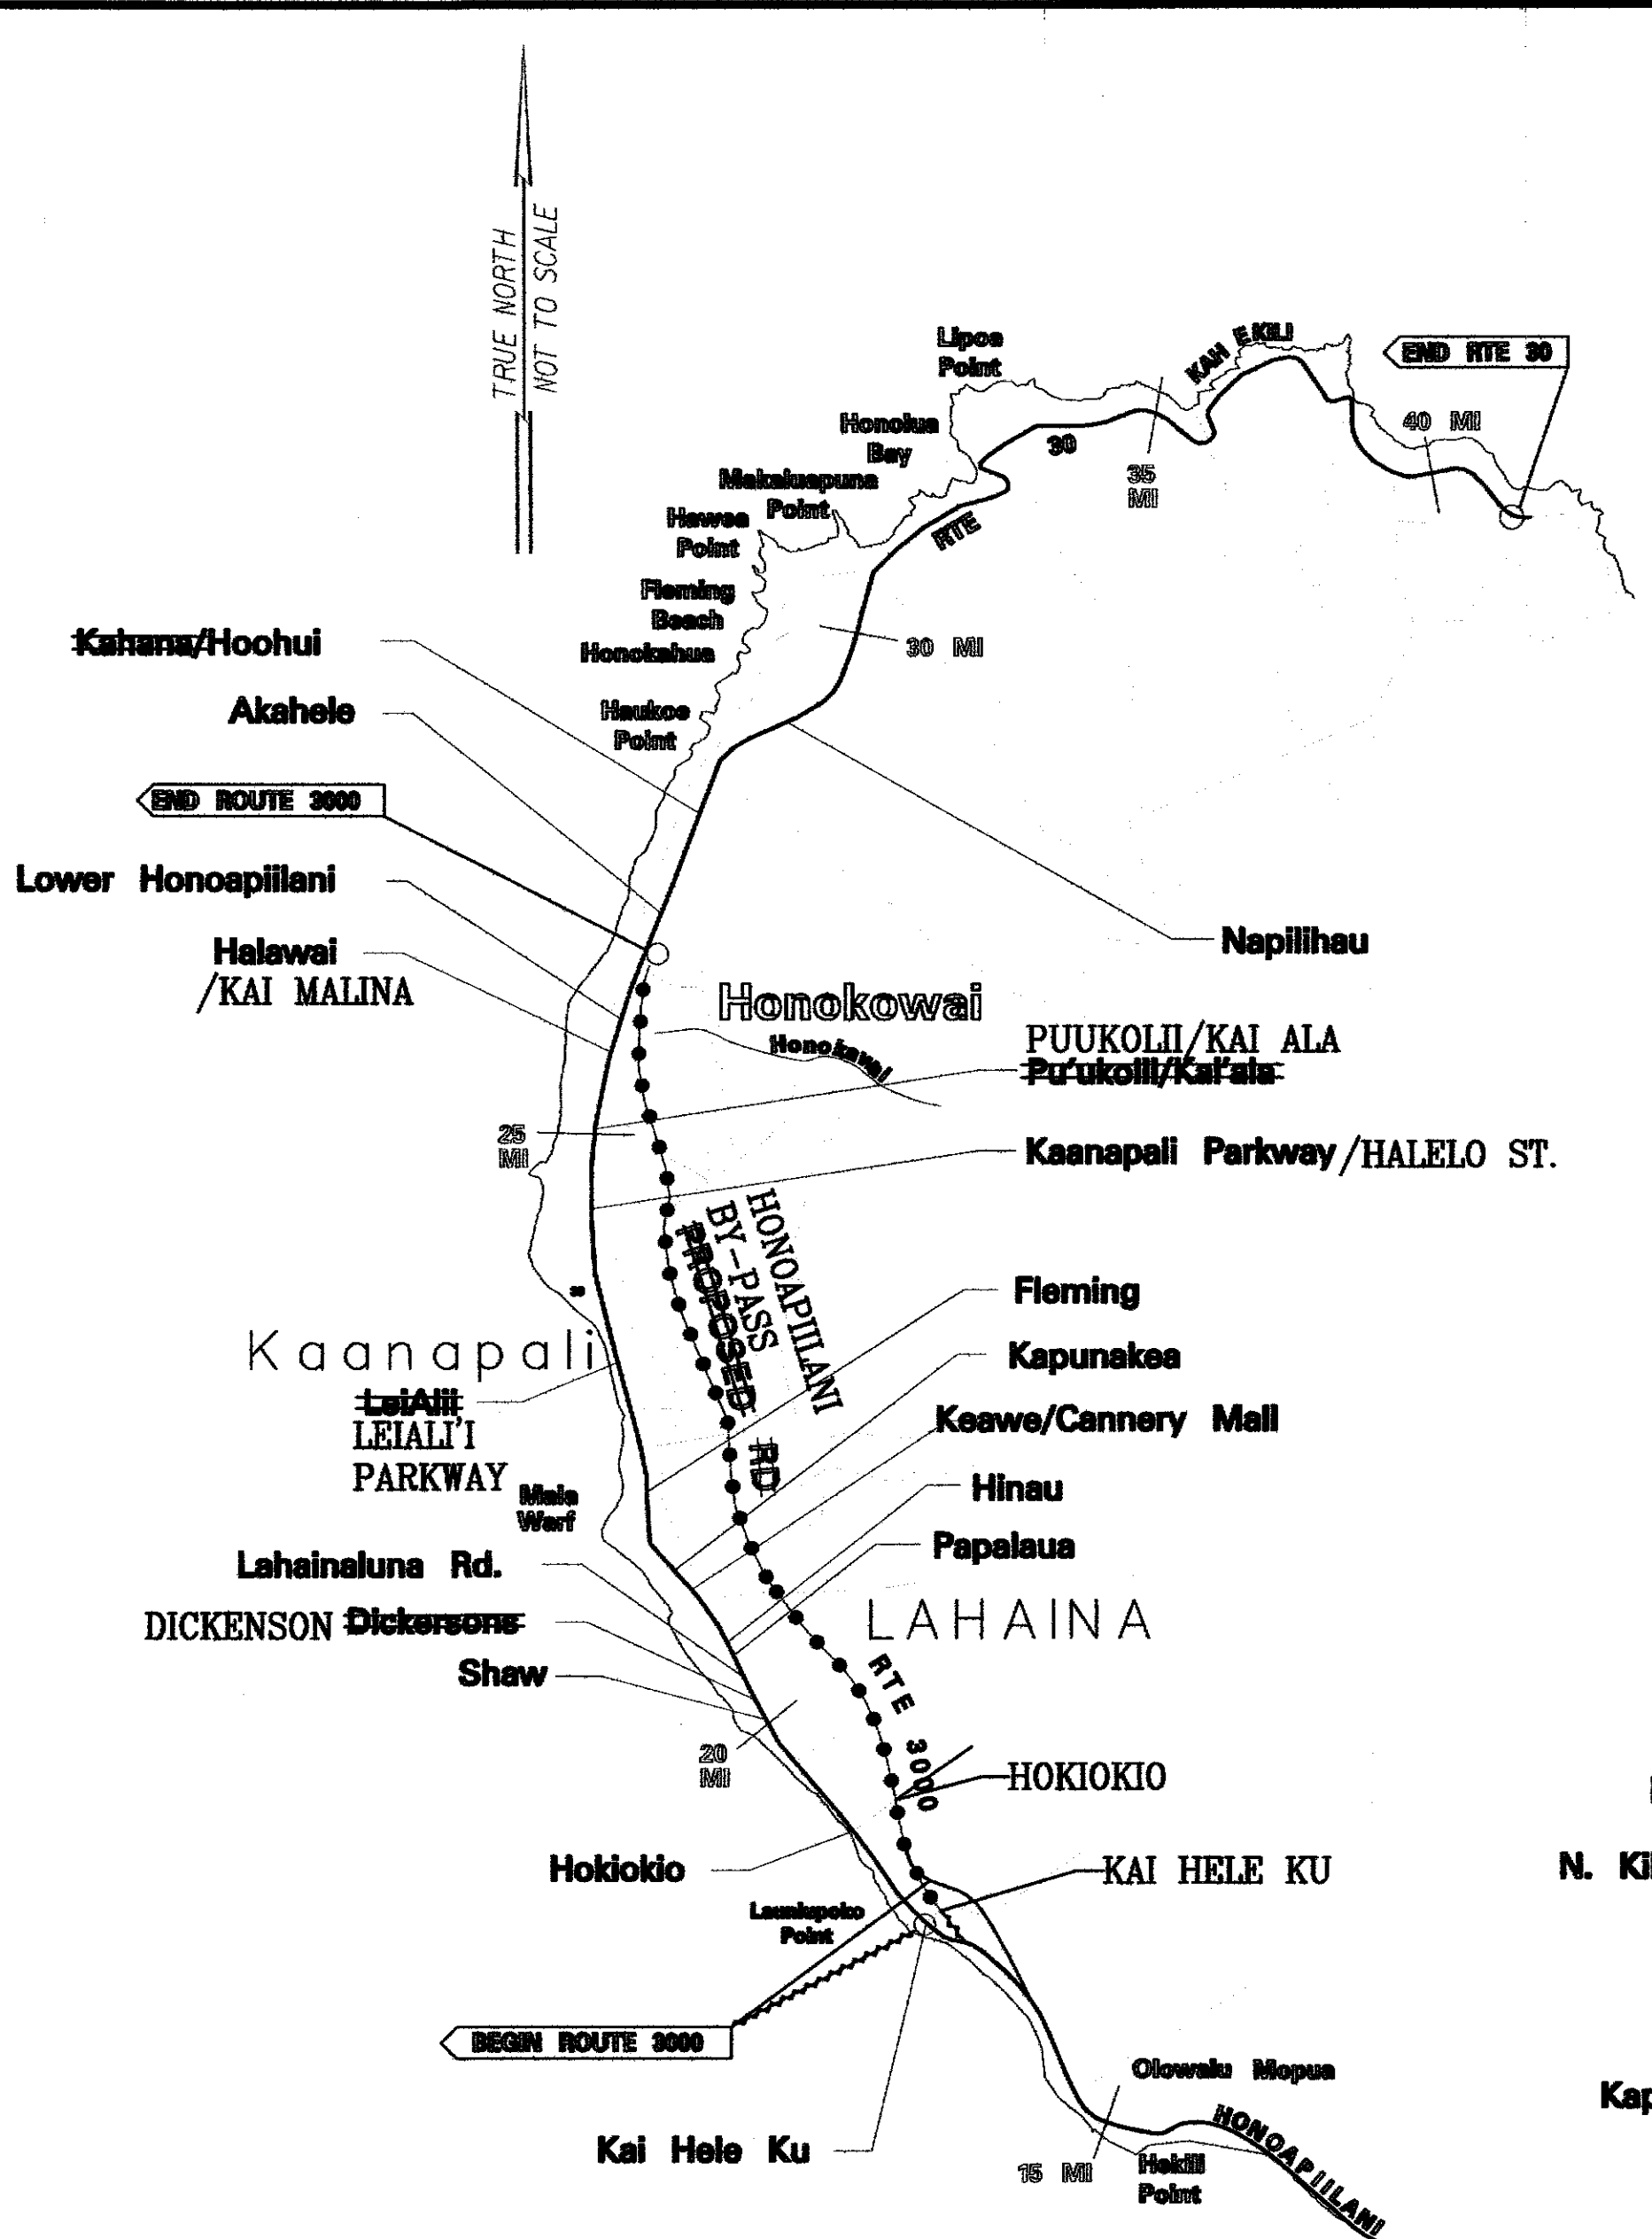


Route No.	Route Name	Intersecting Street	Mile Post	Travel Time Device	Route No.	Route Name	Intersecting Street	Mile Post	Travel Time Device
30	Honoapiilani	Kuihelani	4.9	Yes	30	Honoapiilani	Papalaua	21.1	No
30	Honoapiilani	N. Kihei Rd.	5.1	Yes	30	Honoapiilani	Hinau	21.3	No
30	Honoapiilani	Kapoli	6.2	No YES	30	Honoapiilani	Keawe/Cannery Mall	21.5	Yes
30	Honoapiilani	Kai Hele Ku	18.1	No YES	30	Honoapiilani	Kapunakea	21.6	No
30	Honoapiilani	Hokiokio Pl.	19.4	Yes NO	30	Honoapiilani	Fleming FLEMING	22.1	No
30	Honoapiilani	Shaw	20.3	No	30	Honoapiilani	LEIALI LEIALI Pkwy.	22.8	No
30	Honoapiilani	Dickenson	20.9	No	30	Honoapiilani	Kaanapali Pkwy.	24	Yes
30	Honoapiilani	Lahainaluna	21	No	30	Honoapiilani	PUUKOLI/KAI ALA	25.1	No
3000	HONOAPIILANI BY PASS	KAI HELE KU	1.2	YES	30	Honoapiilani	Halawai/Kai Malina	25.8	No
3000	HONOAPIILANI BY PASS	HOKIOKIO PLACE	2.7	NO	30	Honoapiilani	Lower Honoapiilani	25.9	No
					30	Honoapiilani	Akahole	27.2	No
					30	Honoapiilani	Kahana/Hoohui	27.9	No
					30	Honoapiilani	Napilihua NAPILIHAU	29	No
					31	Piilani	Mokulele N. KIHEI RD.	3.4	Yes
					31	Piilani	Uwapo/Kaiwahine	3.9	No
					31	Piilani	Ohukai	4.2	No
					31	Piilani	Piikea	6.1	Yes NO
					31	Piilani	Lipoa	6.7	No YES
					31	Piilani	Kanani	7.9	No
					31	Piilani	Alanui Ke Ali'i	8.8	No
					31	Piilani	Kilohana/Mapu	9.6	Yes
					310	N. Kihei	S. Kihei	3.3	No
					311	Mokulele MAUI VETERANS	Cane Haul Rd.	1	No
					311	Mokulele MAUI VETERANS	Central Maui Baseyard	2.8	No
					311	Mokulele MAUI VETERANS	Mehameha/Kamaaina	3.9	No

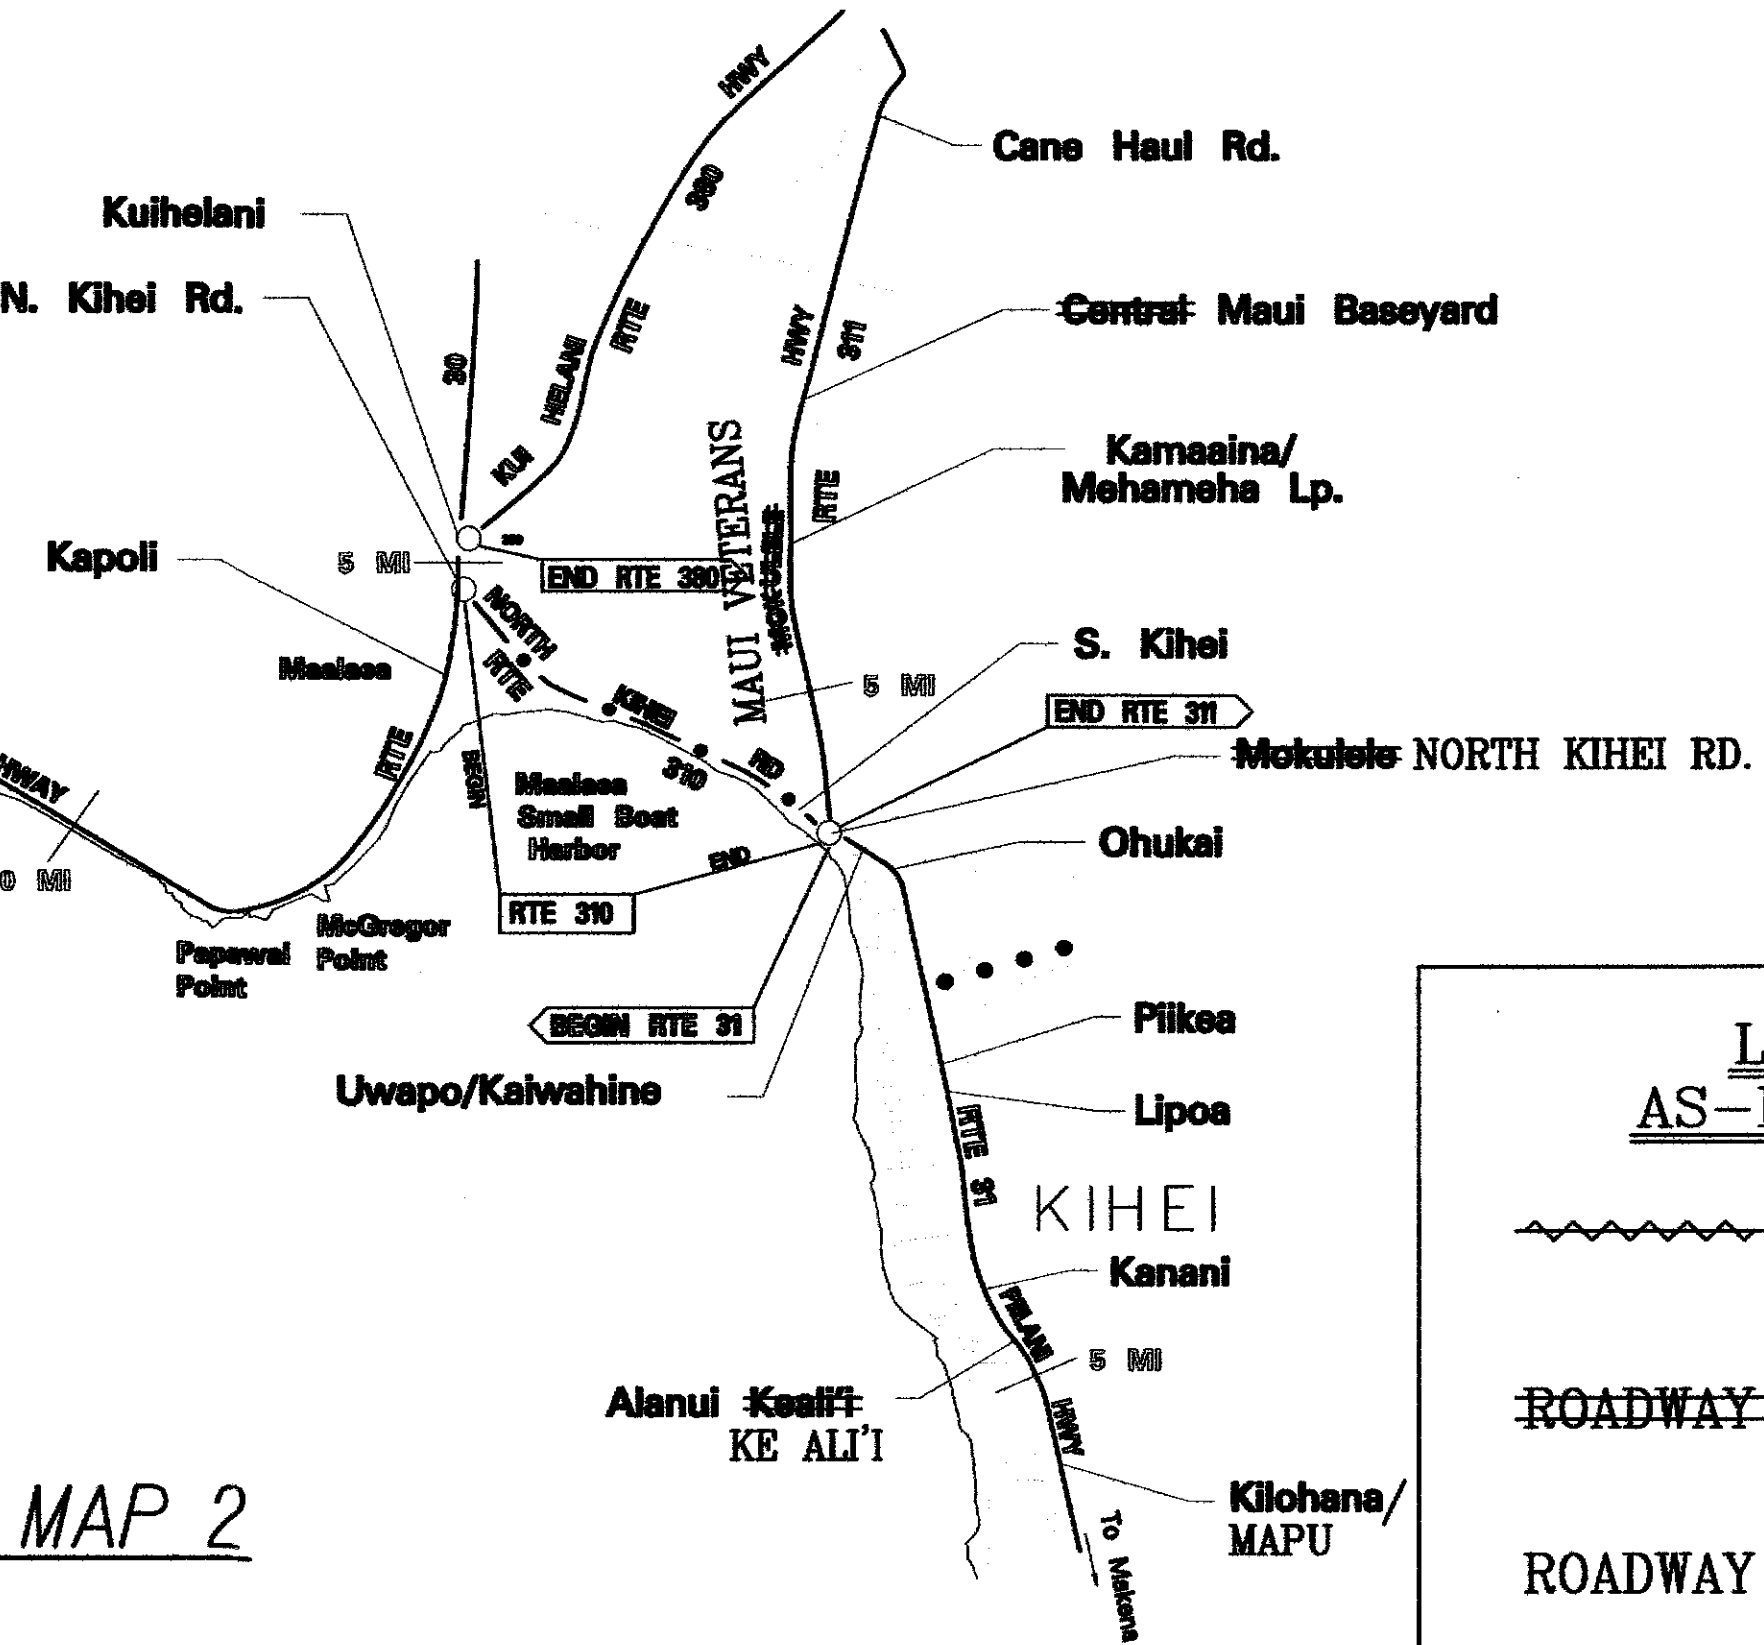

LEGEND FOR AS-BUILT POSTING

- Zig-Zag line for as-built deletion
- ROADWAY Double line for as-built deletion
- ROADWAY Text for as-built posting

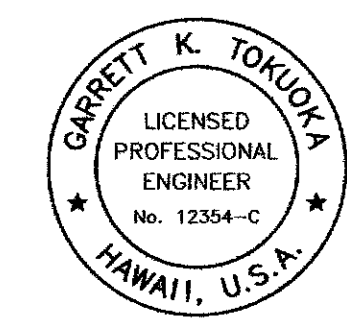

THIS WORK WAS PREPARED BY ME OR UNDER MY SUPERVISION.
APRIL 30, 2018
LIC. EXP. DATE

STATE OF HAWAII
DEPARTMENT OF TRANSPORTATION
HIGHWAYS DIVISION
TRAFFIC SIGNAL LOCATION
MAP 2
TRAFFIC SIGNAL MODERNIZATION
AT VARIOUS LOCATIONS
District of Maui
Scale: As Shown Date: January, 2017
SHEET No. C-7 OF 9 SHEETS

SURVEY PLOTTED BY	DATE
DRAWN BY	
DESIGNED BY	
QUANTITIES BY	
CHECKED BY	
ORIGINAL PLAN	No.
NOTE BOOK	No.

TRAFFIC SIGNAL LOCATION MAP 2
Not To Scale