


DIST. NO.	STATE	PROJ. NO.	FISCAL YEAR	SHEET NO.	TOTAL SHEETS
MAUI	HAW.	HWY-M-02-17	2017	9	9

Route No.	Route Name	Intersecting Street	Mile Post	Travel Time Device
36	Hana Highway	Haleakala	2.9	Yes
36	Hana Highway	Baldwin	6.6	Yes
37	Haleakala Highway	N. FIRE BREAK RD. Fire Break Rd.	0.9	No
37	Haleakala Highway	Kehua Junction	3.7	No
37	Haleakala Highway	HALIIMAILE Haliimaile	4.9	Yes
37	Haleakala Highway	Makani	6.8	No
37	Haleakala Highway	Makawao	7.9	No
37	Haleakala Highway	Kula Highway	7.6	Yes
37	Kula Highway	A'apueo A'apueo	7.9	No

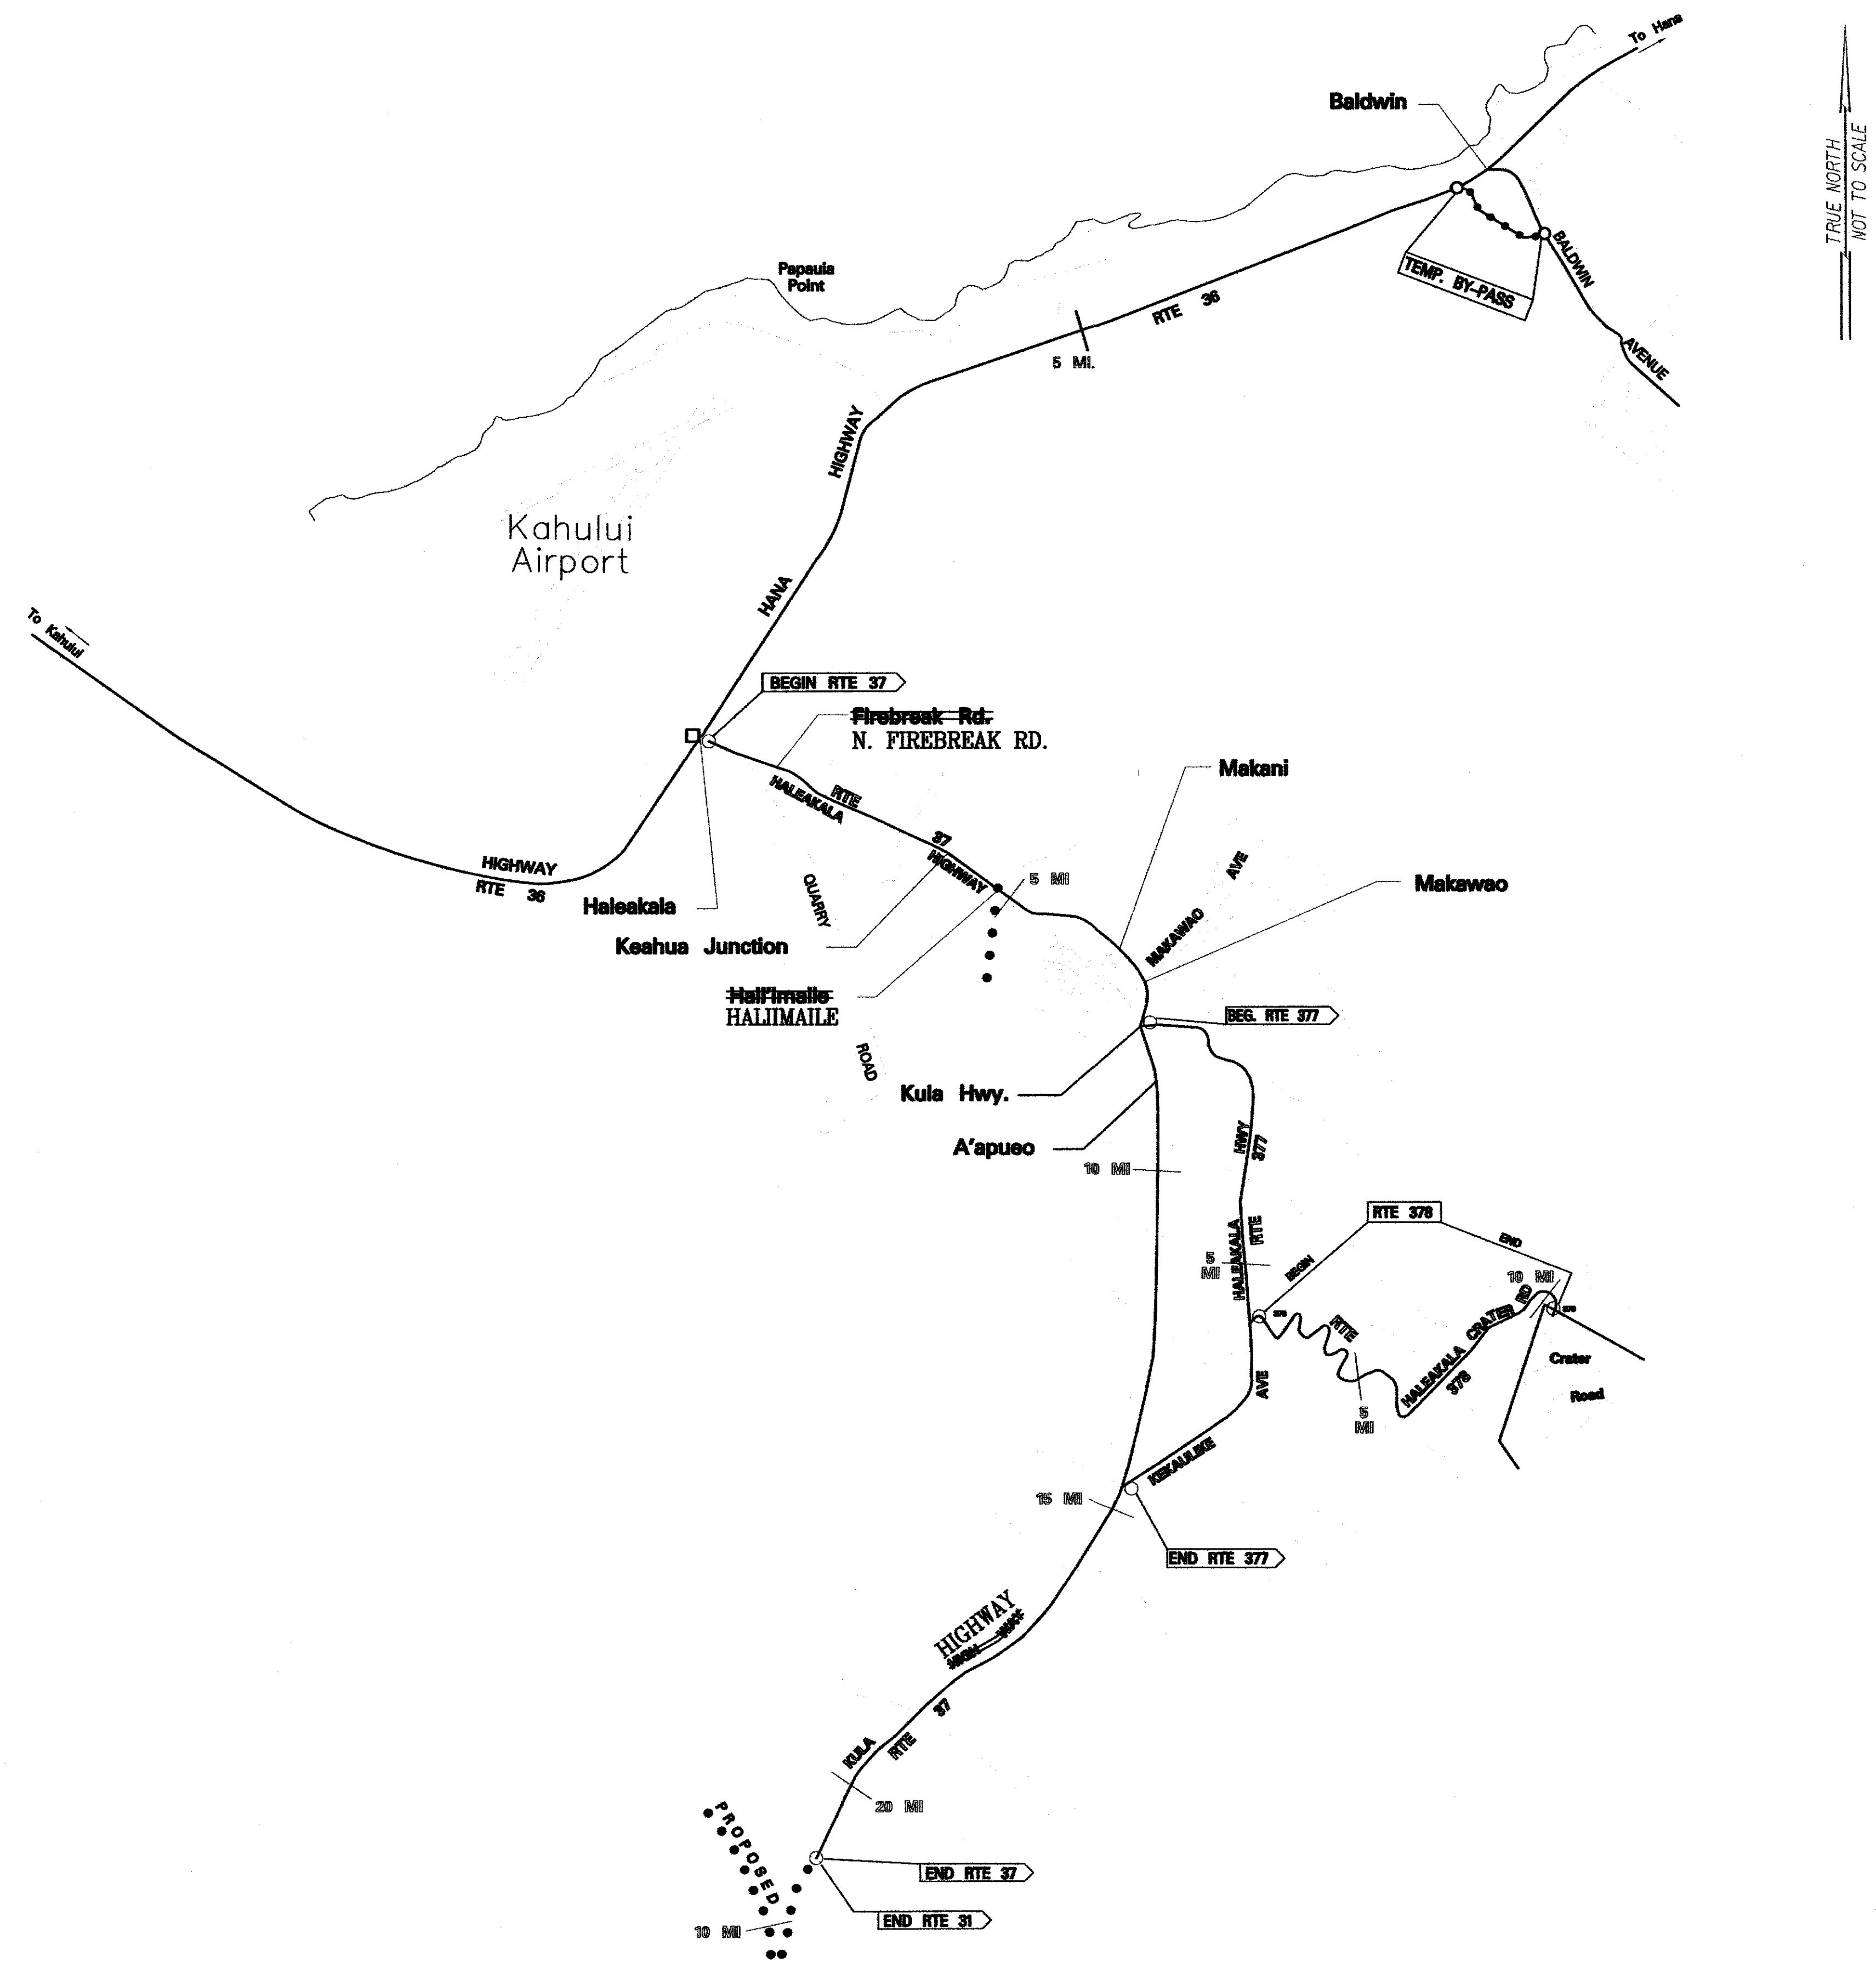

**LEGEND FOR
AS-BUILT POSTING**


Zig-Zag line for as-built deletion

~~ROADWAY~~ Double line for as-built deletion

ROADWAY Text for as-built posting

ORIGINAL PLAN	SURVEY PLOTTED BY	DATE
	DRAWN BY	
	DESIGNED BY	
	CHECKED BY	
NOTE BOOK	No.	

TRAFFIC SIGNAL LOCATION MAP 3
Not To Scale

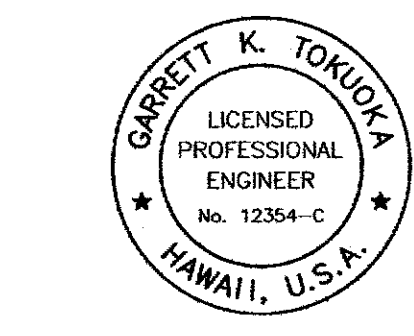

THIS WORK WAS PREPARED BY
ME OR UNDER MY SUPERVISION.
[Signature]
APRIL 30, 2018
LIC. EXP. DATE

STATE OF HAWAII
DEPARTMENT OF TRANSPORTATION
HIGHWAYS DIVISION

**TRAFFIC SIGNAL LOCATION
MAP 3**

TRAFFIC SIGNAL MODERNIZATION
AT VARIOUS LOCATIONS
District of Maui

Scale: As Shown Date: January, 2017

SHEET No. C-8 OF 9 SHEETS