

[illegible]

STATE OF HAWAII

DEPARTMENT OF TRANSPORTATION

HIGHWAYS DIVISION

"AS-BUILT" HONOLULU, HAWAII

PLANS FOR





**KULA HIGHWAY AND PIILANI HIGHWAY
GUARDRAIL AND SHOULDER
IMPROVEMENTS**

**VICINITY OF A'APUEO PARKWAY TO OMAOPIO ROAD
AND NORTH KIHEI ROAD TO LIPOA PARKWAY**

FEDERAL-AID PROJECT NO. STP-0900(100)

DISTRICTS OF MAKAWAO AND WAILUKU
ISLAND OF MAUI


FED. ROAD DIST. NO.	STATE	FED. AID PROJ. NO.	FISCAL YEAR	SHEET NO.	TOTAL SHEETS
HAWAII	HAW.	STP-0900(100)	2020	1	28

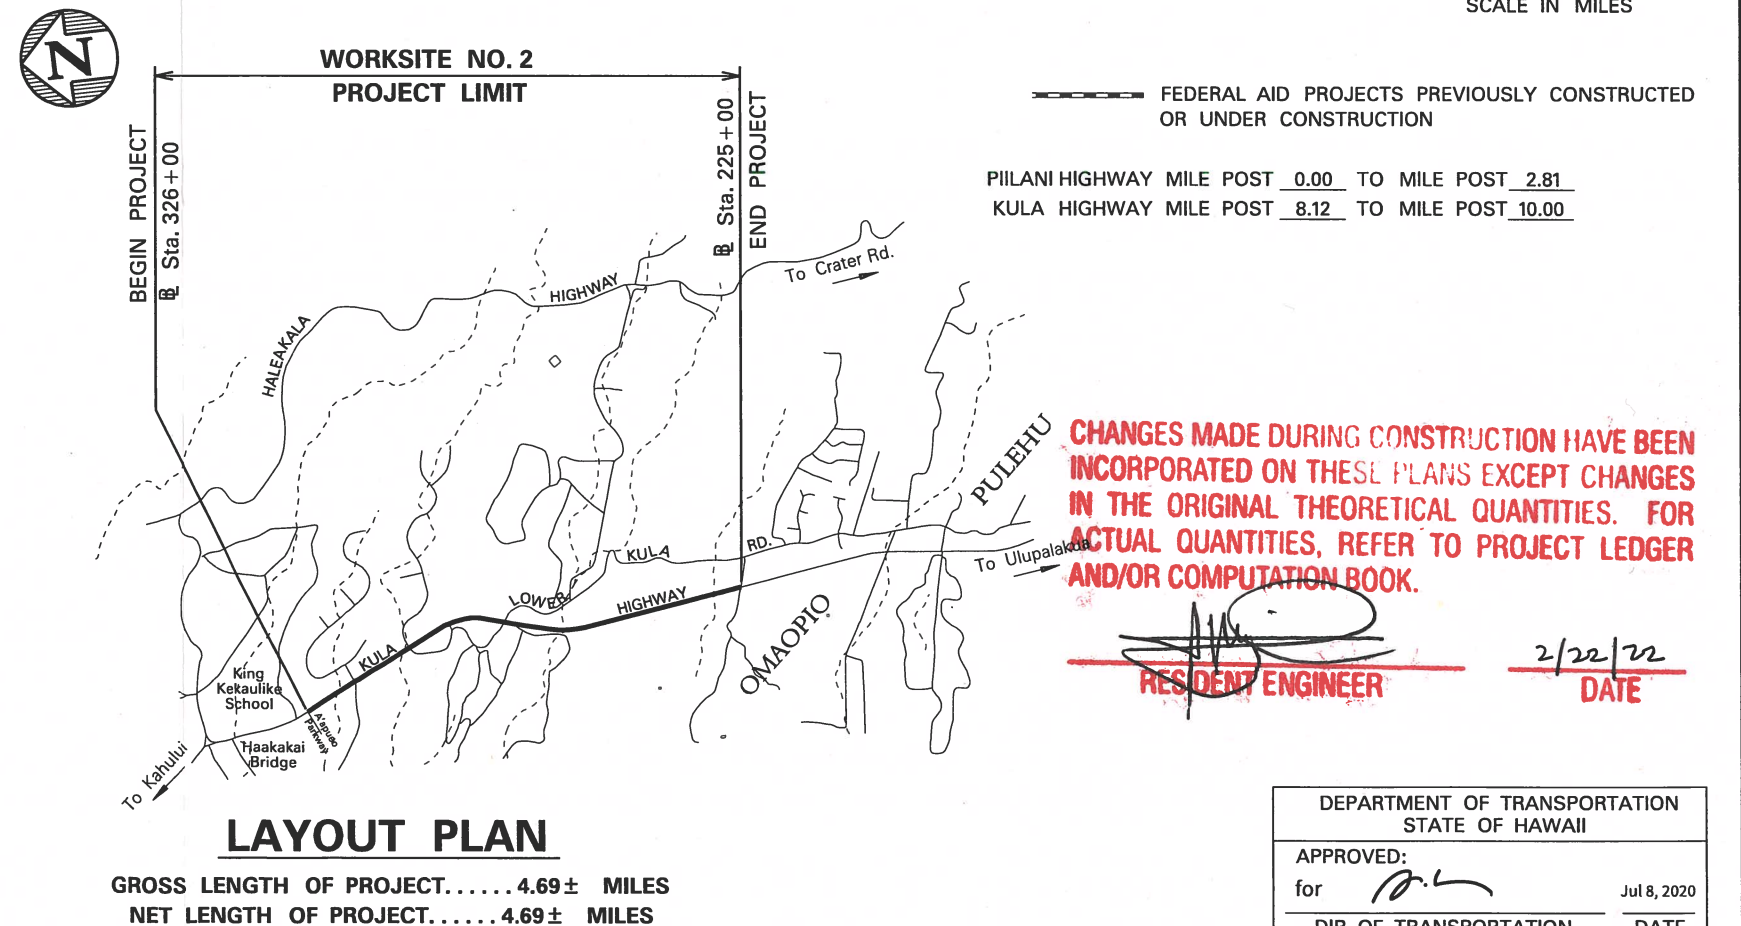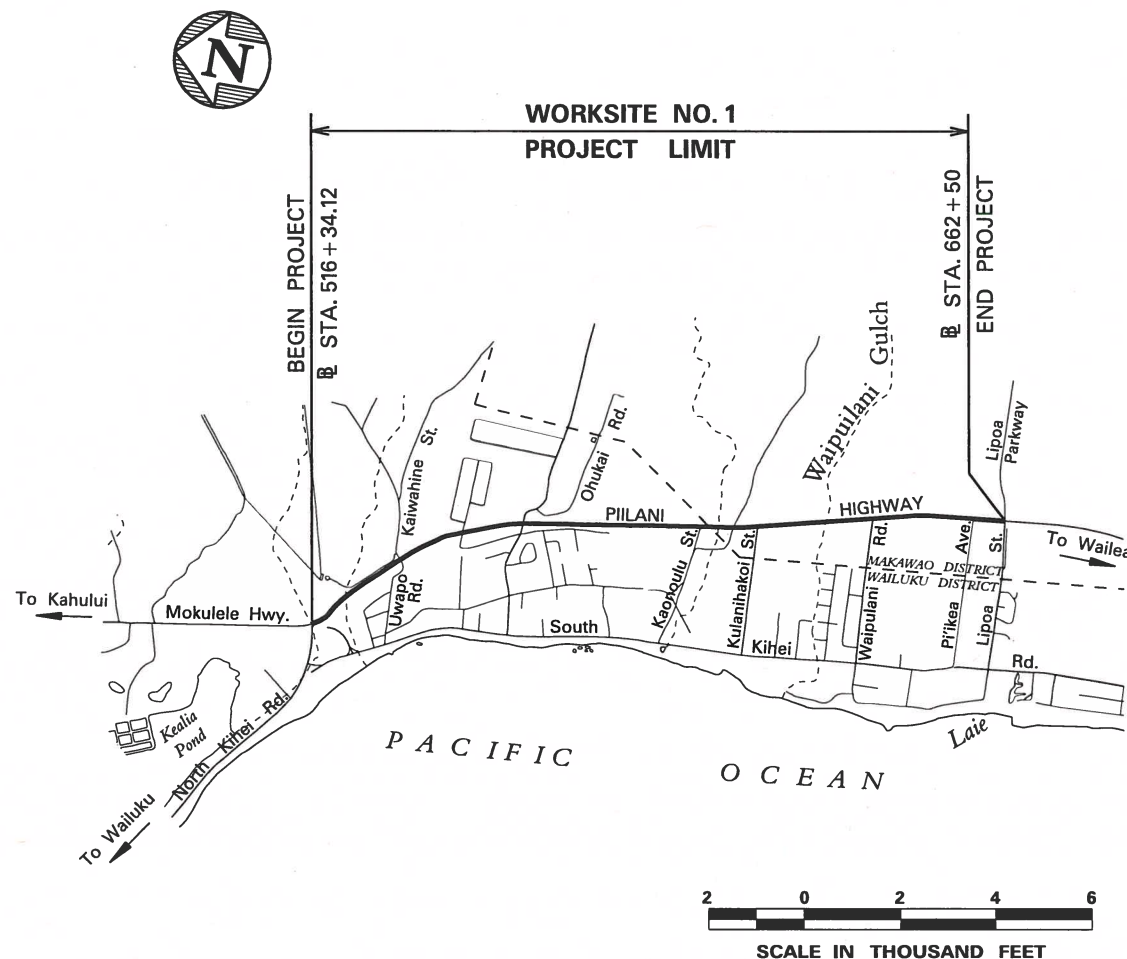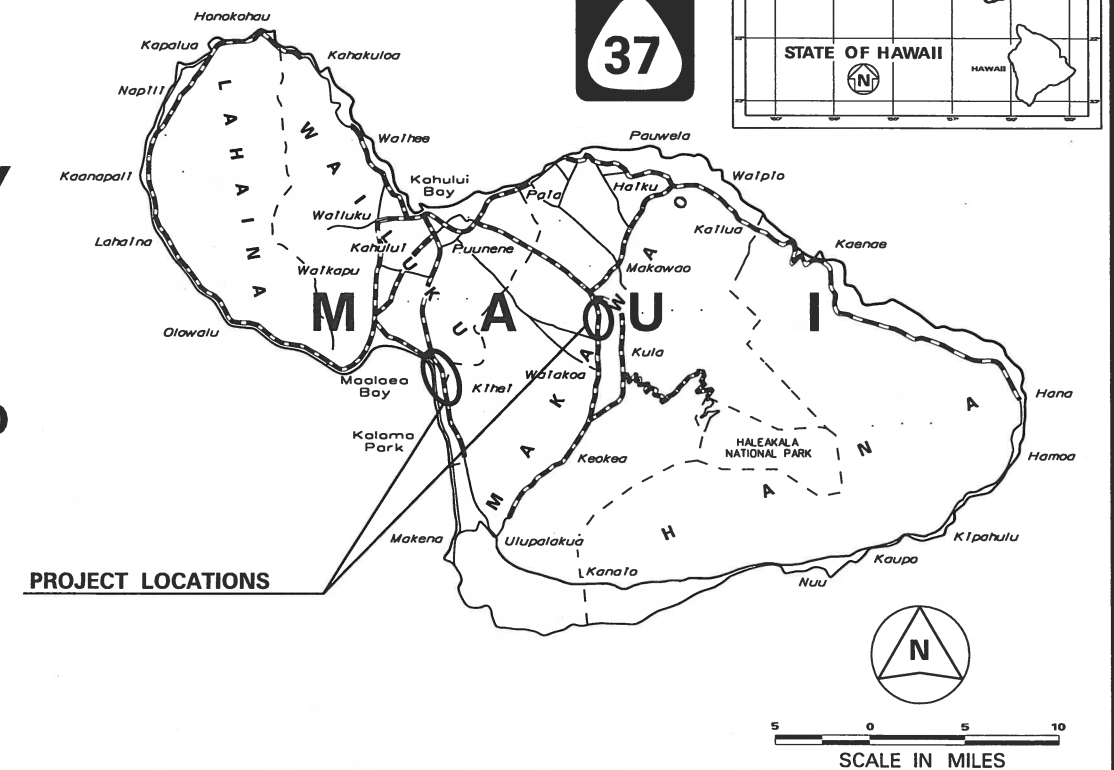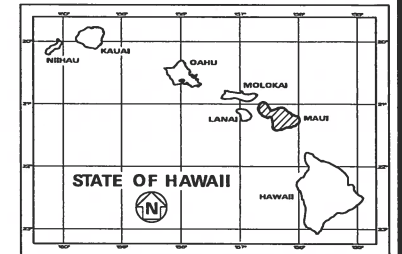

CHANGES MADE DURING CONSTRUCTION HAVE BEEN INCORPORATED ON THESE PLANS EXCEPT CHANGES IN THE ORIGINAL THEORETICAL QUANTITIES. FOR ACTUAL QUANTITIES, REFER TO PROJECT LEDGER AND/OR COMPUTATION BOOK.

RESIDENT ENGINEER

2/22/22
DATE

DEPARTMENT OF TRANSPORTATION STATE OF HAWAII	
APPROVED: for 	Jul 8, 2020
_____ DIR. OF TRANSPORTATION	_____ DATE