

FED. ROAD DIST. NO.	STATE	PROJ. NO.	FISCAL YEAR	SHEET NO.	TOTAL SHEETS
HAWAII	HAW.	HWY-M-01-13	2015	7	10



KAHULUI – KAAHUMANU & HANA HWY


**LEGEND FOR
AS-BUILT POSTINGS**

Squiggly line for as-built deletion

Double line for as-built deletion

Text for as-built posting


- NOTES:**
- PEDESTRIAN SIGNALS ALREADY HAVE COUNTDOWN TIMERS FOR INTERSECTIONS 27, 28, 29, 31, 32, 33, 37, 39, 40, 41, 43, 44, AND 45. LOCATIONS NOT SHOWN ON PLANS.
 - NO CROSSWALKS AND/OR PEDESTRIAN SIGNAL HEADS INSTALLED FOR INTERSECTIONS 30, 46, AND 48. LOCATIONS NOT SHOWN ON PLANS.

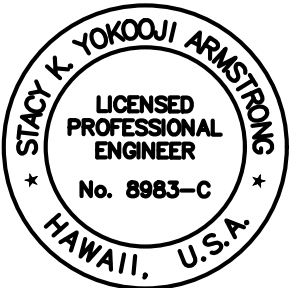

THIS WORK WAS PREPARED BY ME OR UNDER MY SUPERVISION AND CONSTRUCTION OF THIS PROJECT WILL BE UNDER MY OBSERVATION.

Stacy K. Yokoyama April 30, 2014
SIGNATURE DATE

"OBSERVATION OF CONSTRUCTION" IS DEFINED IN CHAPTER 16-115, HAWAII ADMINISTRATIVE RULES ENTITLED "PROFESSIONAL ENGINEERS, ARCHITECTS, SURVEYORS AND LANDSCAPE ARCHITECTS".

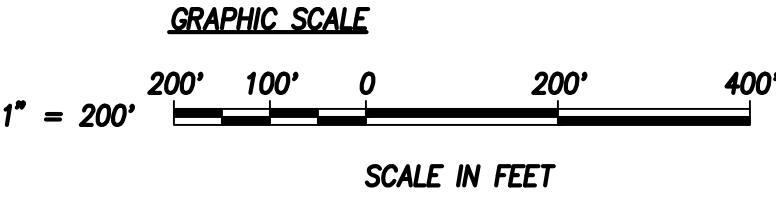

STATE OF HAWAII
DEPARTMENT OF TRANSPORTATION
HIGHWAYS DIVISION


LOCATION MAP – 3

PEDESTRIAN COUNTDOWN TIMERS
PHASE 2
Proj. No. HWY-M-01-13

Scale: 1" = 200'-0" Date: May 2013

SHEET No. C2.3 OF 10 SHEETS


SURVEY PLOTTED BY	DATE
DRAWN BY	
CHECKED BY	
NOTES BOOK	
No.	

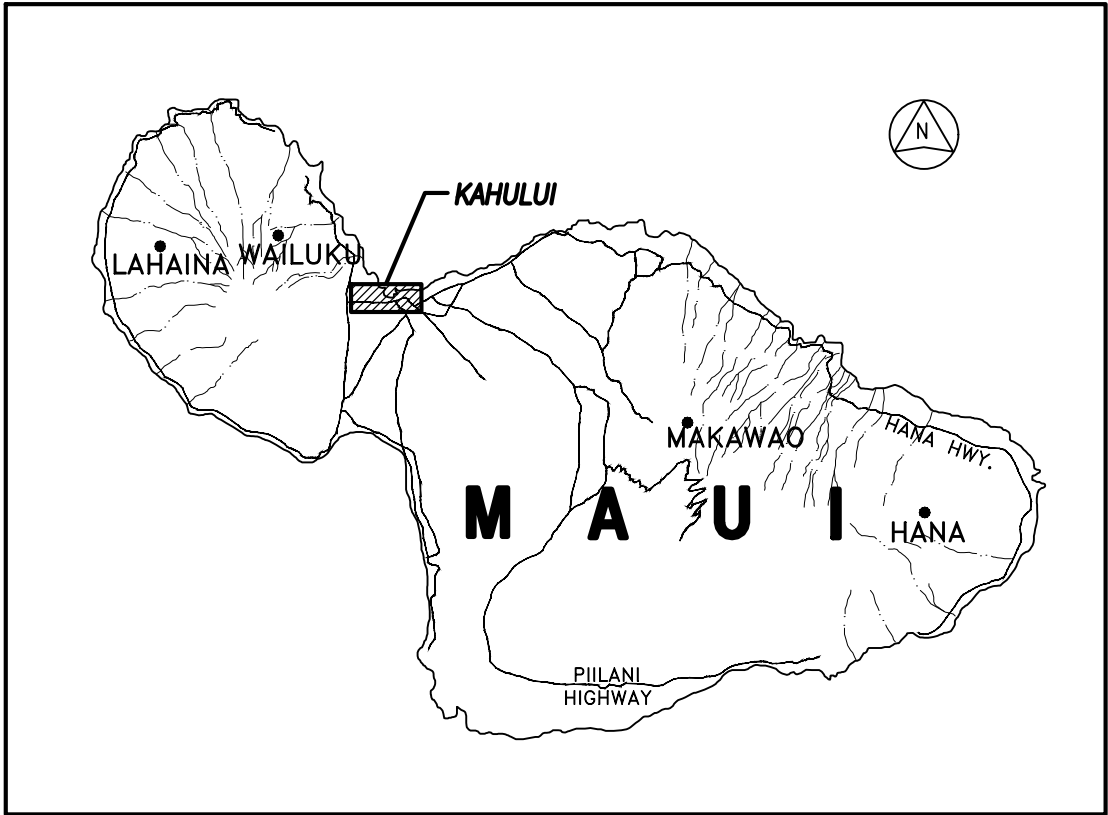


FED. ROAD DIST. NO.	STATE	PROJ. NO.	FISCAL YEAR	SHEET NO.	TOTAL SHEETS
HAWAII	HAW.	HWY-M-01-13	2015	8	10



MAKAWAO – HALEAKALA & KULA HWY

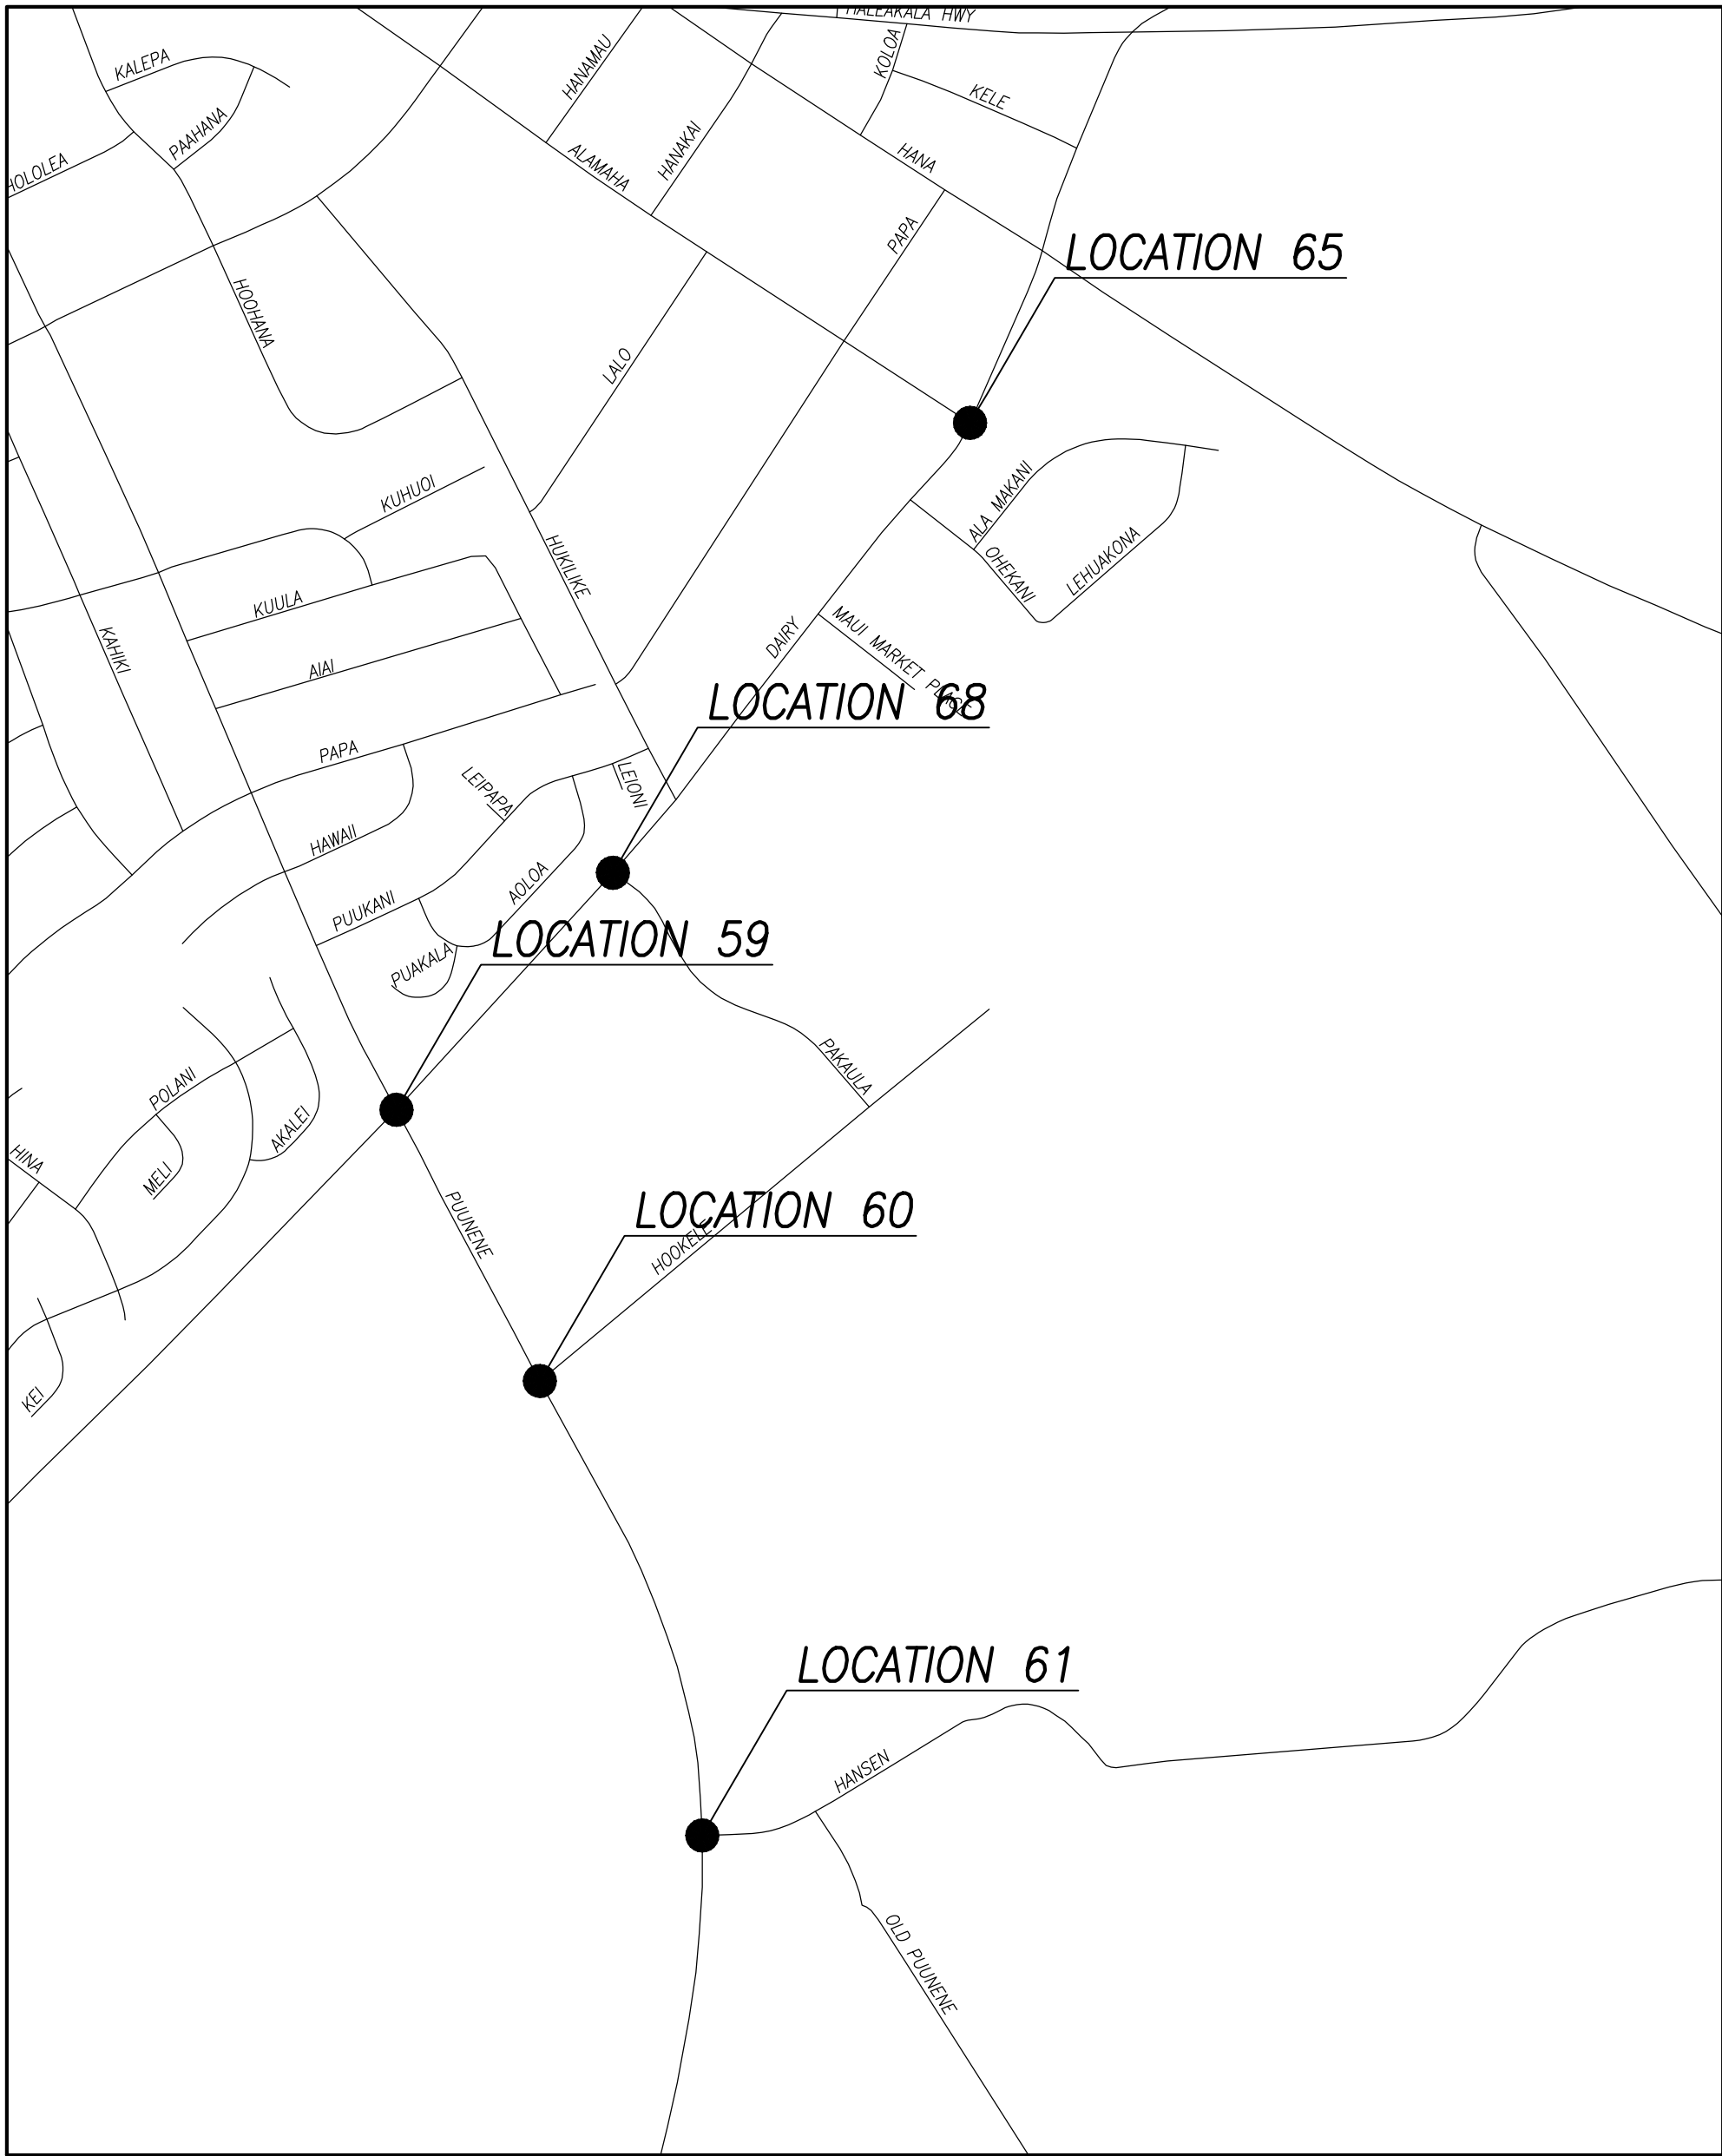


KAHULUI – PUUNENE AVE & DAIRY RD

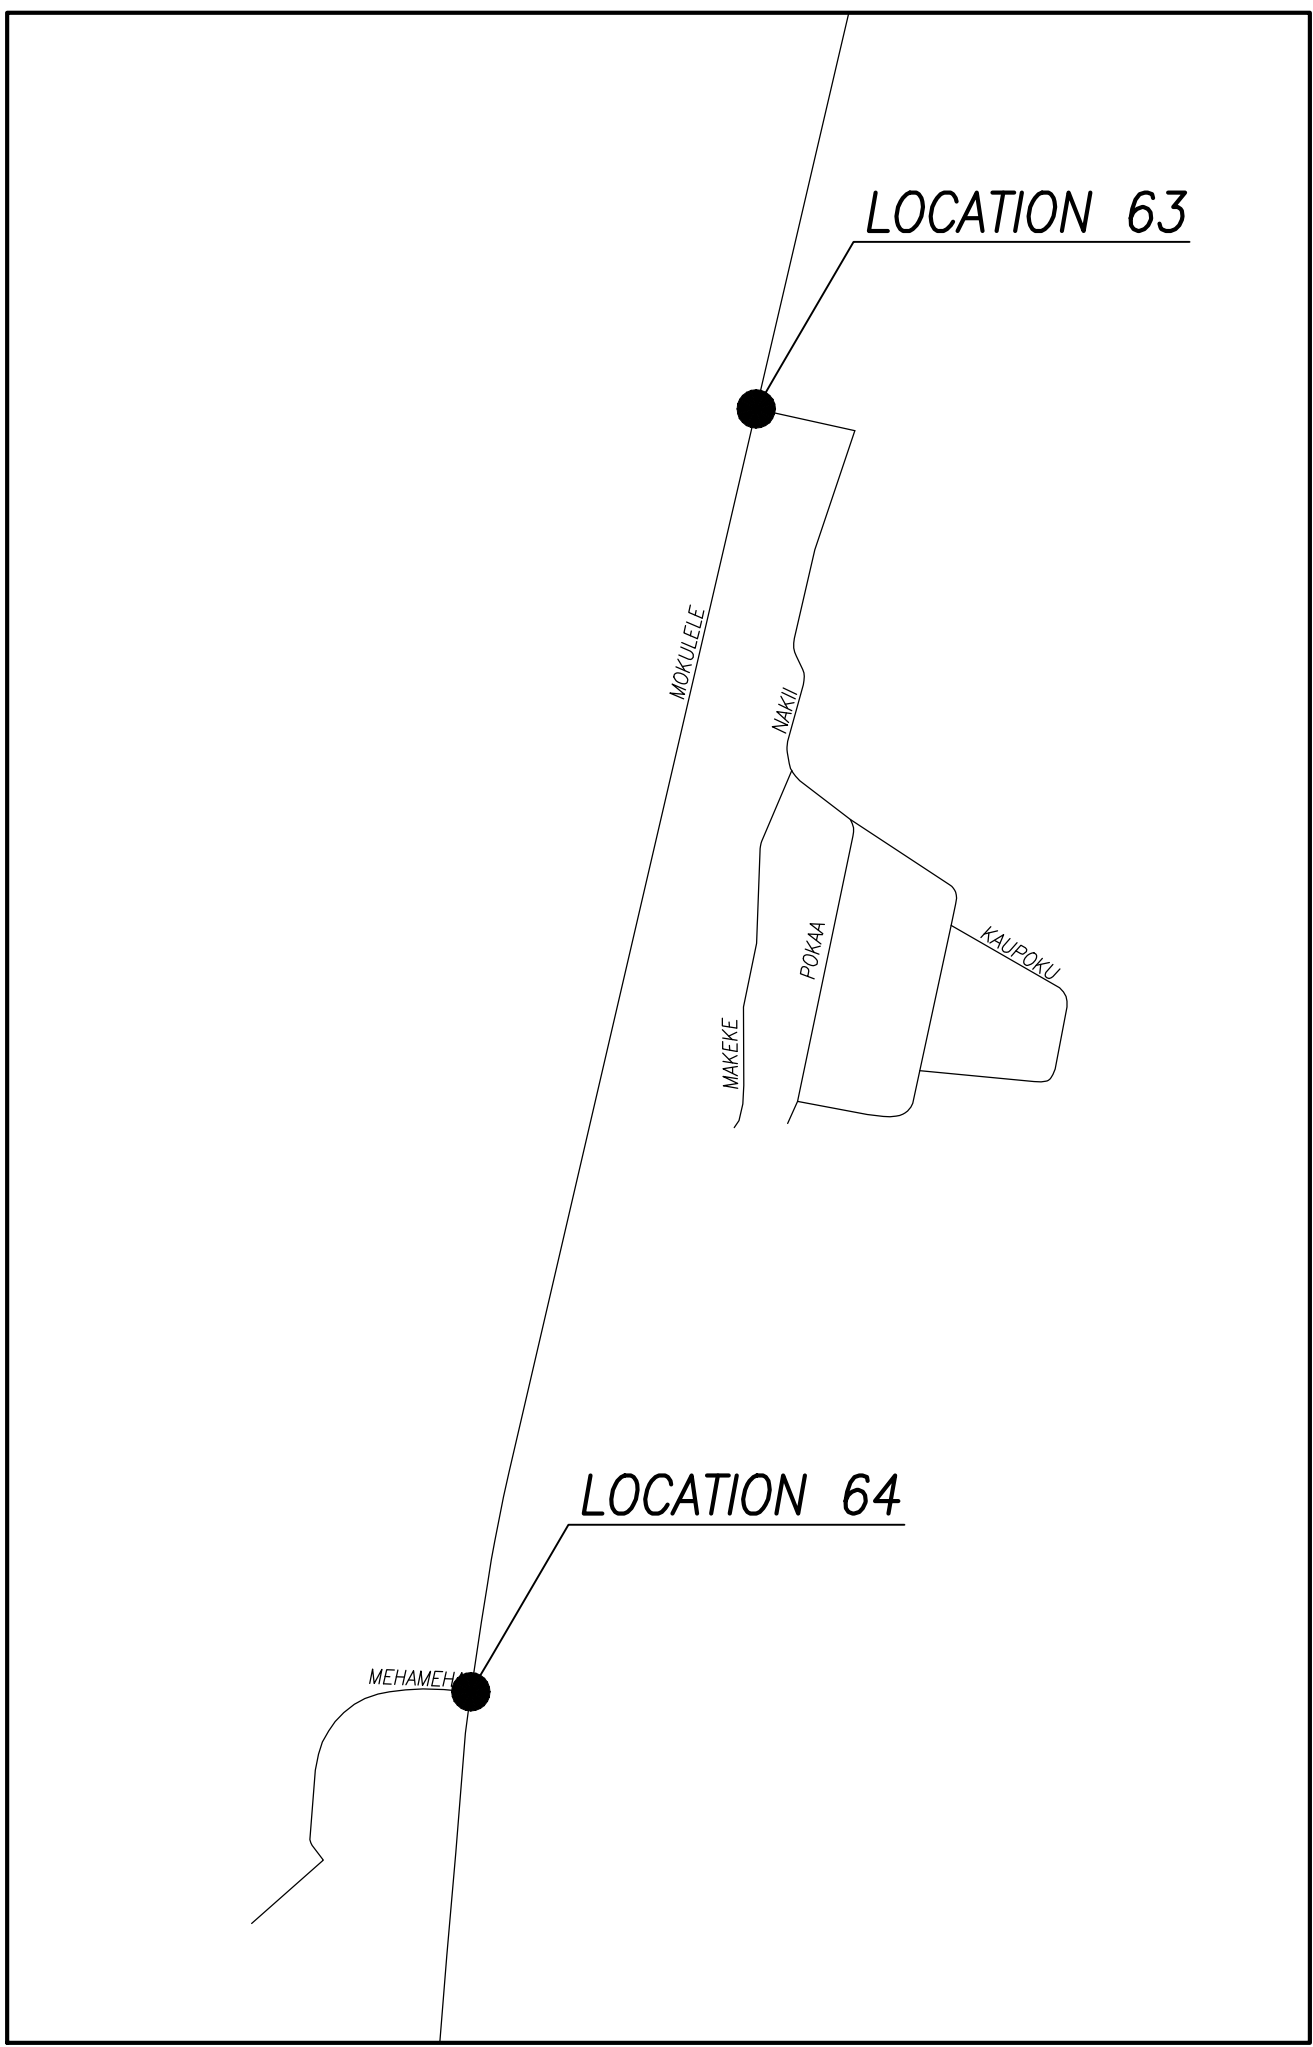


WAILUKU – MOKULELE HWY



SURVEY PLOTTED BY	DATE
DRAWN BY	
NOTES BY	
CHECKED BY	

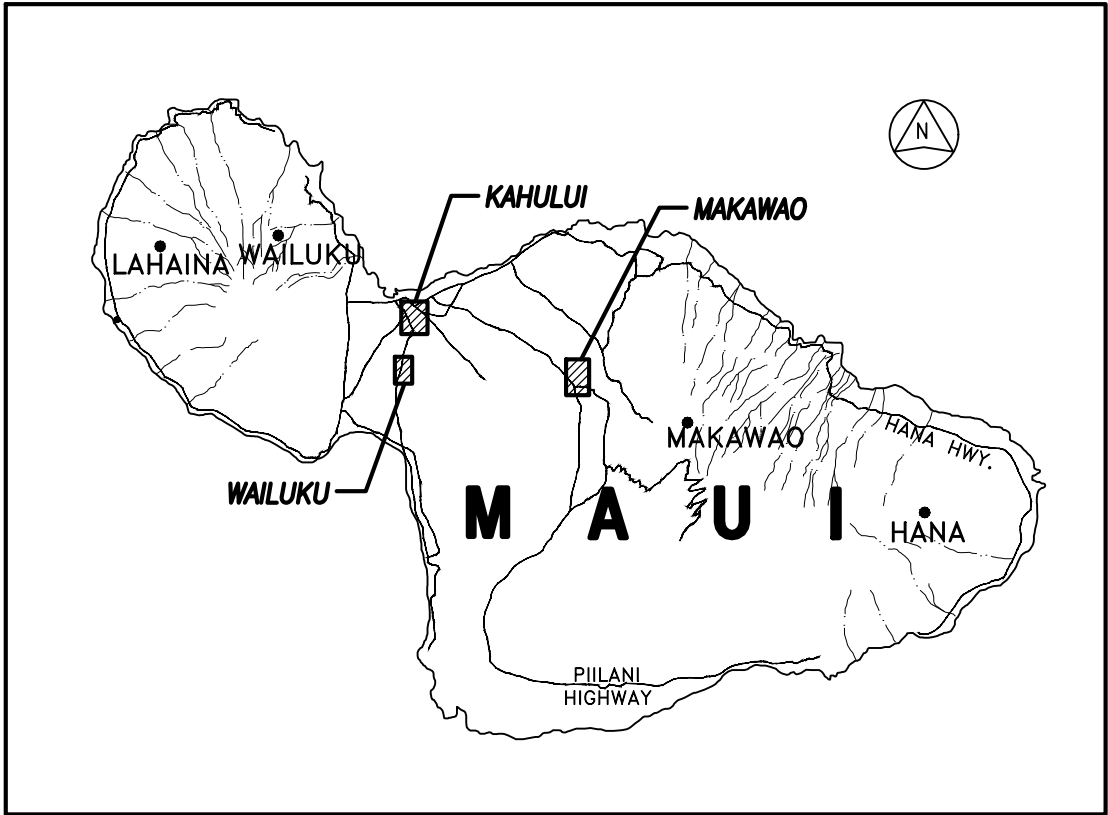


- NOTES:**
1. PEDESTRIAN SIGNALS ALREADY HAVE COUNTDOWN TIMERS FOR INTERSECTIONS 50, 51, 56, 57, AND 67. LOCATIONS NOT SHOWN ON PLANS.
 2. NO CROSSWALKS AND/OR PEDESTRIAN SIGNAL HEADS INSTALLED FOR INTERSECTIONS 52, 53, 54, 62, AND 66. LOCATIONS NOT SHOWN ON PLANS.
 3. INTERSECTION 69 IS THE SAME AS INTERSECTION 59, PUUNENE & KUIHELANI HWY (RTE 380).

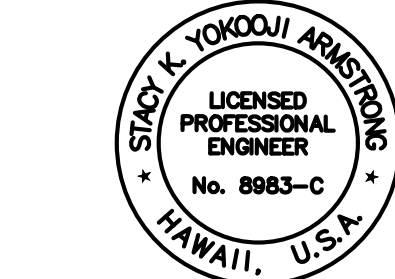

THIS WORK WAS PREPARED BY ME OR UNDER MY SUPERVISION AND CONSTRUCTION OF THIS PROJECT WILL BE UNDER MY OBSERVATION.

Stacy K. Yokoyama April 30, 2014
SIGNATURE DATE

"OBSERVATION OF CONSTRUCTION" IS DEFINED IN CHAPTER 16-115, HAWAII ADMINISTRATIVE RULES ENTITLED "PROFESSIONAL ENGINEERS, ARCHITECTS, SURVEYORS AND LANDSCAPE ARCHITECTS".

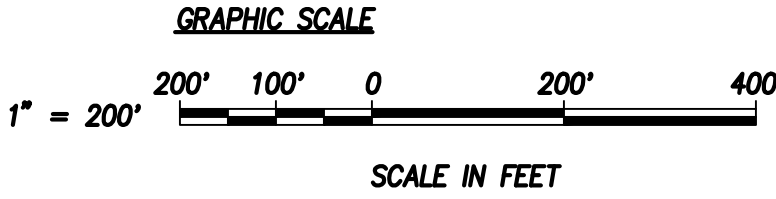

STATE OF HAWAII
DEPARTMENT OF TRANSPORTATION
HIGHWAYS DIVISION


LOCATION MAP – 4

PEDESTRIAN COUNTDOWN TIMERS
PHASE 2
Proj. No. HWY-M-01-13

Scale: 1" = 200'-0" Date: May 2013

SHEET No. C2.4 OF 10 SHEETS

FED. ROAD DIST. NO.	STATE	PROJ. NO.	FISCAL YEAR	SHEET NO.	TOTAL SHEETS
HAWAII	HAW.	HWY-M-01-13	2015	9	10

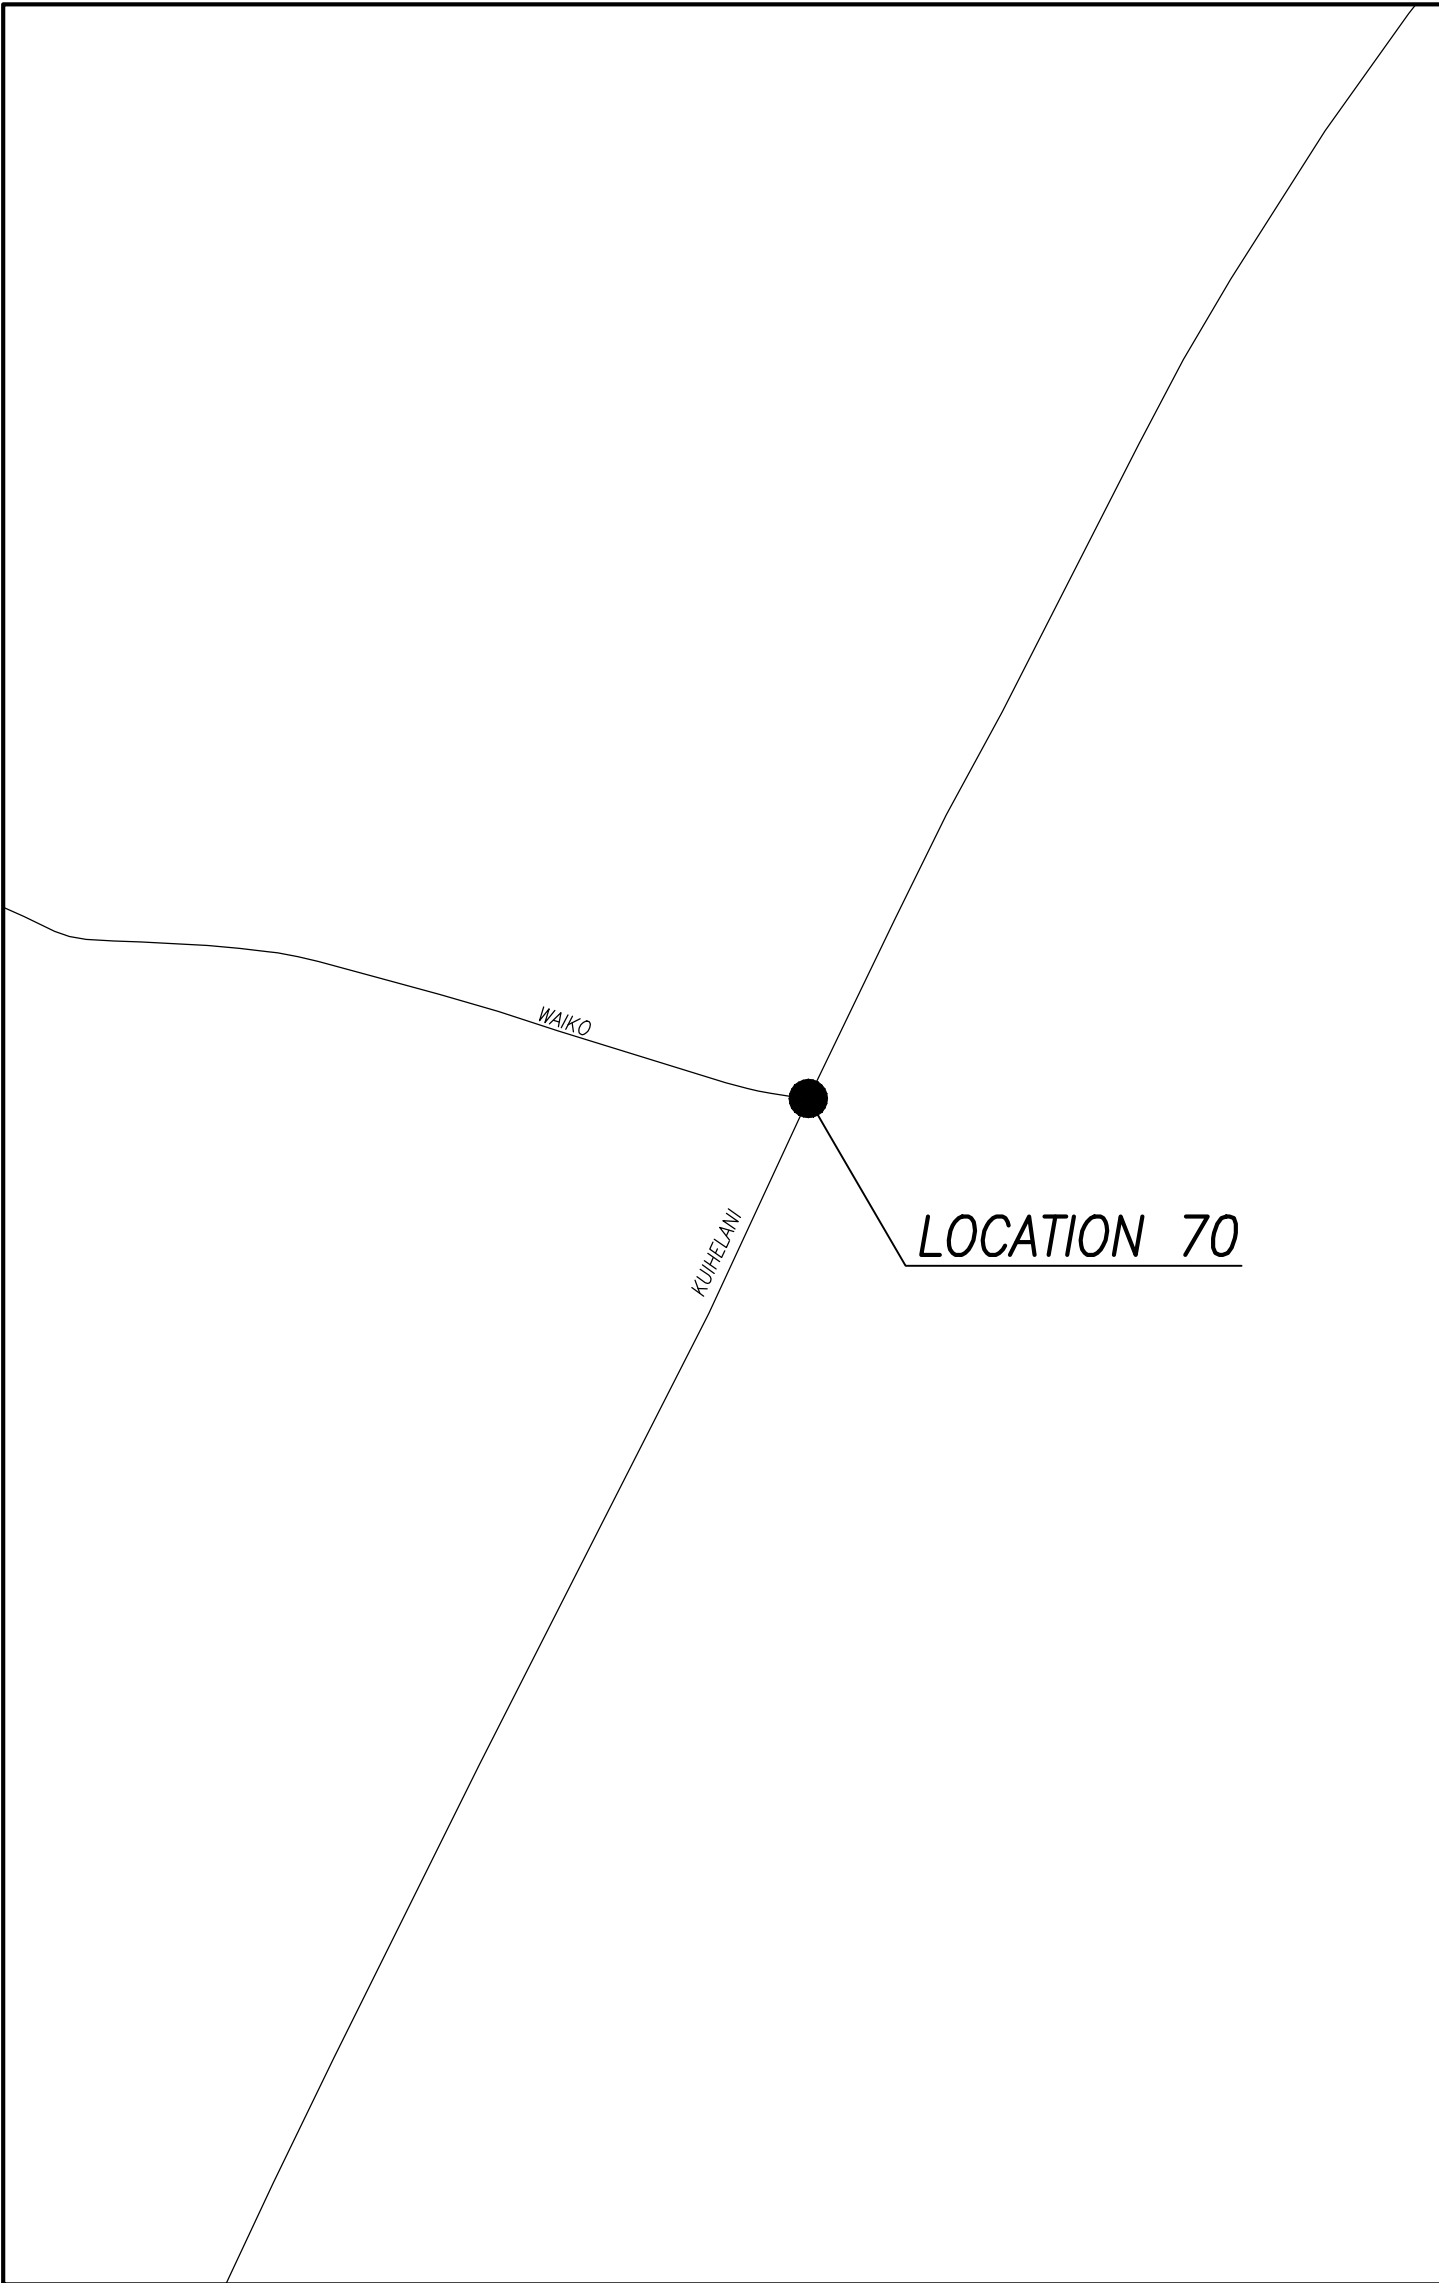


WAILUKU – KUIHELANI HWY



KAHULUI – KAHULUI BEACH RD



SURVEY PLOTTED BY	DATE
DRAWN BY	
TRACED BY	
NOTES BY	
CHECKED BY	

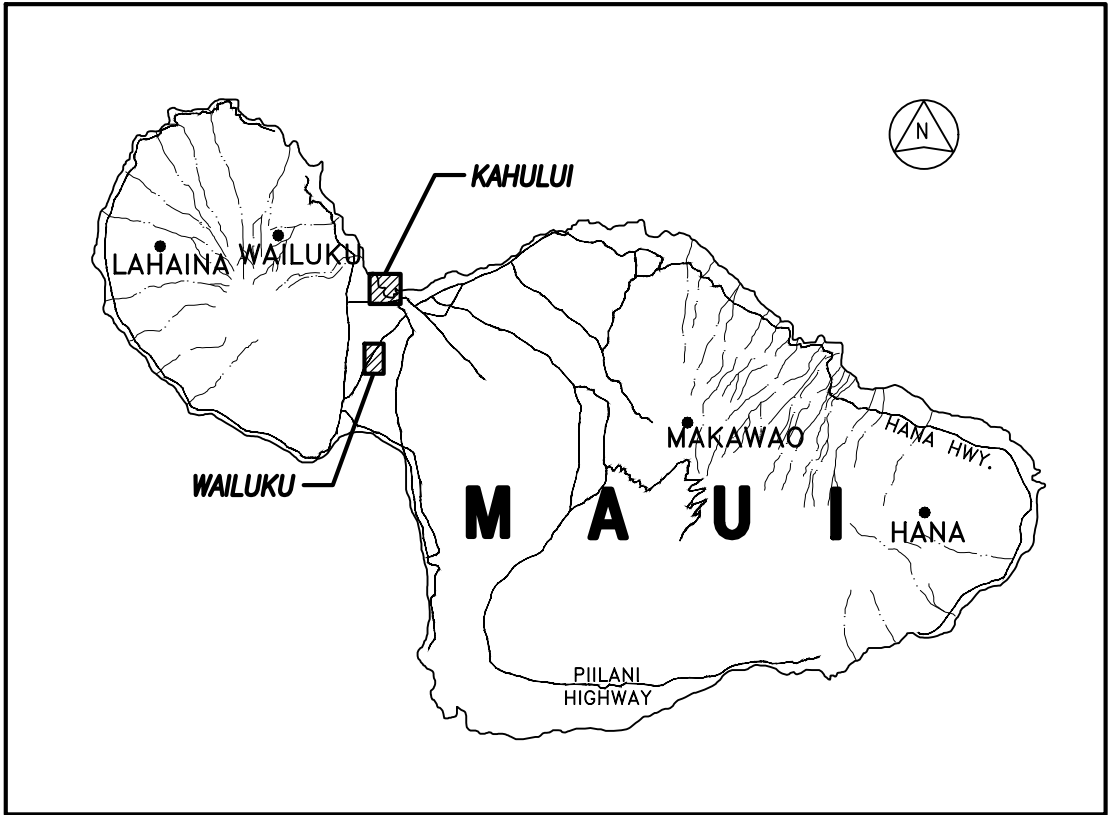

LEGEND FOR AS-BUILT POSTINGS

Squiggly line for as-built deletion

Double line for as-built deletion


Text for as-built posting

- NOTES:**
- PEDESTRIAN SIGNALS ALREADY HAVE COUNTDOWN TIMERS FOR INTERSECTIONS 74, 75, 76, 77 AND 78. LOCATIONS NOT SHOWN ON PLANS.
 - NO CROSSWALKS AND/OR PEDESTRIAN SIGNAL HEADS INSTALLED FOR INTERSECTION 71. LOCATION NOT SHOWN ON PLANS.

THIS WORK WAS PREPARED BY ME OR UNDER MY SUPERVISION AND CONSTRUCTION OF THIS PROJECT WILL BE UNDER MY OBSERVATION.

DATE: April 30, 2014
SIGNATURE:

"OBSERVATION OF CONSTRUCTION" IS DEFINED IN CHAPTER 16-115, HAWAII ADMINISTRATIVE RULES ENTITLED "PROFESSIONAL ENGINEERS, ARCHITECTS, SURVEYORS AND LANDSCAPE ARCHITECTS".

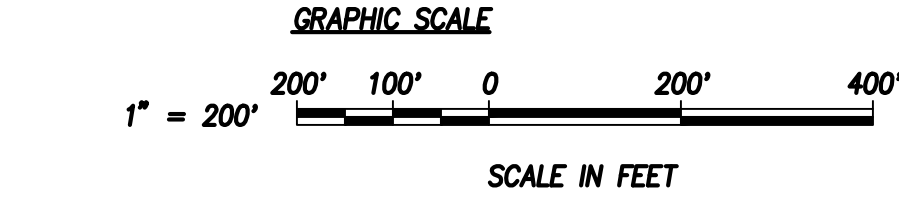

STATE OF HAWAII
DEPARTMENT OF TRANSPORTATION
HIGHWAYS DIVISION

LOCATION MAP – 5

PEDESTRIAN COUNTDOWN TIMERS
PHASE 2
Proj. No. HWY-M-01-13

Scale: 1" = 200'-0" Date: May 2013

SHEET No. C2.5 OF 10 SHEETS