

FED. ROAD DIST. NO.	STATE	PROJ. NO.	FISCAL YEAR	SHEET NO.	TOTAL SHEETS
HAWAII	HAW.	HWY-M-01-13	2015	10	10

TRAFFIC SIGNAL LOCATION					QUANTITIES
NO.	RTE	MILE	HIGHWAY	INTERSECTION	
1 *	30	0	HIGH ST	MAIN ST (RTE 32)	0
2 *	30	1.08	HONOAPIILANI HWY	KUIKAHI ST	0
3 *	30	1.98	HONOAPIILANI HWY	PILIKANA ST	0
4 *	30	2.21	HONOAPIILANI HWY	WAIKO RD (NEW TRAFFIC SIGNAL)	0
5 *	30	4.86	HONOAPIILANI HWY	KUIHELANI HWY (RTE 380)	-
6 *	30	5.22	HONOAPIILANI HWY	NORTH KIHEI RD (SOUTH) (RTE 310)	-
7 *	30	6.36	HONOAPIILANI HWY	KAPOLI ST	-
8	30	18.06	HONOAPIILANI HWY	KAI HELEKU ST	0 ≡
9	30	20.25	HONOAPIILANI HWY	SHAW ST	0 ≡
10*	30	20.77	HONOAPIILANI HWY	DICKENSON ST	0
11	30	20.93	HONOAPIILANI HWY	LAHAINALUNA RD	0 ≡
12	30	21.06	HONOAPIILANI HWY	PAPALAUA ST	0 ≡
13*	30	21.30	HONOAPIILANI HWY	HINAU ST	0
14	30	21.56	HONOAPIILANI HWY	KEAWE ST	0 ≡
15	30	21.74	HONOAPIILANI HWY	KAPUNAKEA ST	0 ≡
16	30	22.17	HONOAPIILANI HWY	FLEMING RD/FRONT ST	0 ≡
17	30	22.76	HONOAPIILANI HWY	LEIALI'I PKWY (RECREATION CENTER)	0
18	30	23.88	HONOAPIILANI HWY	HALELO RD/KAANAPALI PKWY	1 ≡
19	30	25.16	HONOAPIILANI HWY	PUUKOLII RD/KAI ALA DR	0 ≡
20	30	25.62	HONOAPIILANI HWY	HALAWAI DR	0 ≡
21	30	25.88	HONOAPIILANI HWY	LOWER HONOAPIILANI RD	0 ≡
22	30	27.18	HONOAPIILANI HWY	AKAHELE ST	0 ≡
23	30	27.77	HONOAPIILANI HWY	HOOHUI RD	0 ≡
24	30	29.02	HONOAPIILANI HWY	NAPILIHAI ST	0 ≡
25	31	0.00	PIILANI HWY	MOKULELE HWY/PIILANI HWY	3 ≡
26	31	0.41	PIILANI HWY	UWAPO RD/KAIWAHINE ST	0 ≡
27 *	31	0.93	PIILANI HWY	OHUKAI RD	0
28 *	31	2.62	PIILANI HWY	PI'IKEA AVE	0
29 *	31	2.82	PIILANI HWY	LIPOA ST	0
30 *	31	4.33	PIILANI HWY	KANANI RD	-
31 *	31	4.73	PIILANI HWY	ALANUI KE ALI'I DR	0
32 *	31	5.93	PIILANI HWY	KILOHANA DR/MAPU PL	0
33 *	32	0.23	MAIN ST	MARKET ST	0
34	32	0.34	MAIN ST	CENTRAL AVE	1 ≡
35	32	0.75	KAAHUMANU AVE	KAINANI ST/LUNALILO DR	0 ≡
36	32	0.91	KAAHUMANU AVE	MAUI LANI PKWY	0 ≡
37 *	32	1.19	KAAHUMANU AVE	MAHALANI ST/KANALOA AVE	0
38 *	32	1.42	KAAHUMANU AVE	PAPA AVE/WAHINE PI'O AVE	0
39 *	32	1.72	KAAHUMANU AVE	WAKEA AVE	0
40 *	32	1.90	KAAHUMANU AVE	KAAHUMANU CENTER RD	0
41 *	32	2.10	KAAHUMANU AVE	KANE ST/KAHALUI BEACH RD (RTE 3400)	0
42	32	2.29	KAAHUMANU AVE	LONO AVE	0 ≡
43 *	32	2.48	KAAHUMANU AVE	PUUNENE AVE (RTE 3500)	0
44 *	32	2.60	KAAHUMANU AVE	WHARF ST	0
45 *	36	0.19	HANA HWY	HOBRON AVE (RTE 32A)/KAMEHAMEHA AVE	0
46 *	36	0.43	HANA HWY	WAKEA AVE	-
47	36	0.87	HANA HWY	DAIRY RD/KUIHELANI HWY (RTE 380)	0 ≡
48 *	36	1.80	HANA HWY	CANE HAUL RD	-
49	36	2.91	HANA HWY	HALEAKALA HWY (RTE 37)	0 ≡
50 *	36	6.70	HANA HWY	BALDWIN AVE	0

TRAFFIC SIGNAL LOCATION					QUANTITIES
NO.	RTE	MILE	HIGHWAY	INTERSECTION	
51*	36A	0.32	HALEAKALA HWY/KEOLANI PL	HALEAKALA HWY/KEOLANI PL	0
52*	36A	3.20	HALEAKALA HWY	KEAHUA RD	-
53*	37	0.70	HALEAKALA HWY	NORTH FIREBREAK RD	-
54*	37	4.76	HALEAKALA HWY	HAILIMAILE RD	-
55	37	6.73	HALEAKALA HWY	MAKANI RD	0 ≡
56*	37	7.23	HALEAKALA HWY	MAKAWAO AVE (RTE 365)	0 ≡
57*	37	7.76	KULA HWY (KULA JUNCTION)	OLD HALEAKALA HWY (RTE 377)	0
58	37	8.19	KULA HWY	A'APUEO PKWY	0 ≡
59	311	0.00	PUUNENE AVE	KUIHELANI HWY (RTE 380)	0 ≡
60	311	0.20	PUUNENE AVE	HO'OKELE RD	0 ≡
61	311	0.58	PUUNENE AVE	HANSEN RD	0 ≡
62*	311	0.91	MOKULELE HWY	CANE HAUL RD	-
63	311	2.21	MOKULELE HWY	MAUI BASEYARD RD	0 ≡
64	311	3.06	MOKULELE HWY	MEHAMEHA LP	0 ≡
65	380	0.30	DAIRY RD	ALAMAHA ST	0 ≡
66*	380	0.38	DAIRY RD	OHEKANI ST	-
67*	380	0.48	DAIRY RD	MAUI MARKETPLACE DR	0
68*	380	0.73	DAIRY RD	PAKA'ULA ST	0 ≡
69*	380	0.97	DAIRY RD	PUUNENE AVE (RTE 3500)	-
70	380	3.46	KUHELANI HWY	WAIKO RD	0 ≡
71*	380	3.62	KUHELANI HWY	CANE HAUL RD	-
72	3400	0.45	KAHULUI BEACH RD	WAHINE PI'O AVE	3 ≡
73	3400	0.88	KAHULUI BEACH RD	KANALOA AVE	0
74*	3400	1.13	WAIEHU BEACH RD	WAIEHU BEACH RD/LOWER MAIN ST	0
75*	3400	1.54	WAIEHU BEACH RD	NUKUWAI PL/EHA ST	0
76*	3500	0.18	PUUNENE AVE	KAMEHAMEHA AVE/WEST KAMEHAMEHA AVE	0
77*	3500	0.46	PUUNENE AVE	WAKEA AVE	0
78*	3500	0.85	PUUNENE AVE	WEST PAPA AVE/EAST PAPA AVE	0

* INTERSECTIONS WITH COUNTDOWN TIMERS ALREADY INSTALLED: 1, 2, 3, 4, 10, 13, 27, 28, 29, 31, 32, 33, 37, 38, 39, 40, 41, 43, 44, 45, 50, 51, 56, 57, 67, 74, 75, 76, 77, 78

* INTERSECTIONS WITH NO CROSSWALKS AND/OR PEDESTRIAN SIGNAL HEADS INSTALLED: 5, 6, 7, 30, 46, 48, 52, 53, 54, 62, 66, 71


* INTERSECTION 68: TEMPORARY TRAFFIC LIGHTS USE, PEDESTRIAN SIGNALS NOT IN USE

* INTERSECTION 69: DUPLICATE, SAME AS INTERSECTION 59, PUUNENE & KUIHELANI HWY (RTE 380)

LEGEND FOR
AS-BUILT POSTINGS


~~100-00~~
Roadway

Squiggly line for as-built deletion
Double line for as-built deletion
Text for as-built posting

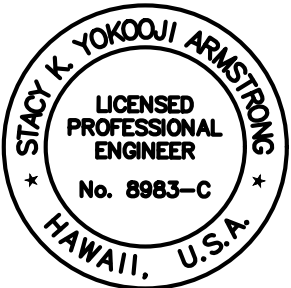

THIS WORK WAS PREPARED BY ME OR UNDER MY SUPERVISION AND CONSTRUCTION OF THIS PROJECT WILL BE UNDER MY OBSERVATION.

Stacy K. Yokooji April 30, 2014
SIGNATURE DATE

"OBSERVATION OF CONSTRUCTION" IS DEFINED IN CHAPTER 16-115, HAWAII ADMINISTRATIVE RULES ENTITLED "PROFESSIONAL ENGINEERS, ARCHITECTS, SURVEYORS AND LANDSCAPE ARCHITECTS".

NOTE:
REMOVE ALL EXISTING PEDESTRIAN MODULES AND REPLACE WITH NEW COUNTDOWN MODULES.

STATE OF HAWAII
DEPARTMENT OF TRANSPORTATION
HIGHWAYS DIVISION

MAUI SCHEDULE

PEDESTRIAN COUNTDOWN TIMERS
PHASE 2
Proj. No. HWY-M-01-13

Scale: N/A Date: May 2013

SHEET No. C2.6 OF 10 SHEETS

ORIGINAL PLAN	SURVEY PLOTTED BY _____	DATE _____
	DRAWN BY _____	_____
	NOTES BOOK _____	_____
	QUANTITIES BY _____	_____
No. _____	CHECKED BY _____	_____