

FED. ROAD DIST. NO.	STATE	FED. AID PROJ. NO.	FISCAL YEAR	SHEET NO.	TOTAL SHEETS
HAWAII	HAW	NRH 13C	1934	3	17

NOTE:

Figures in Red are notes from Survey made on the ground by T.Y. Awana, May 20, 1935
 " " Blue " " " " " " " " " " T.Y. Awana, " " "
 See F.B. 338, Calc. Folder No. 7



F.A. MARKER
F.A.P
N.R.H. 13 C

LIST OF COMMON ABBREVIATIONS

- ✓ C.R.M. - Cement rubble masonry.
- ✓ D.R.M. - Dry rubble masonry
- ✓ C.R.M.P - Cement rubble masonry paving
- W. - Wall
- ✓ H.L.R.R. - Hand laid rip-rap
- ✓ Conc. Culvert - Means circular concrete culvert
which is either a- cast in place circular concrete
culvert. b- conc. pipe culvert.
- ✓ Box Culvert:- Various reinforced conc. box culvert
as detailed.
- ✓ M.D.I. - Masonry drop intake
- ✓ M.H.W. - Masonry head wall.

NOTE!

All existing buildings, fences and other structures etc., on the right-of-way shall be demolished and removed by the contractor and disposed of as directed under the item of cleaning and Grubbing, unless removed by their owners.

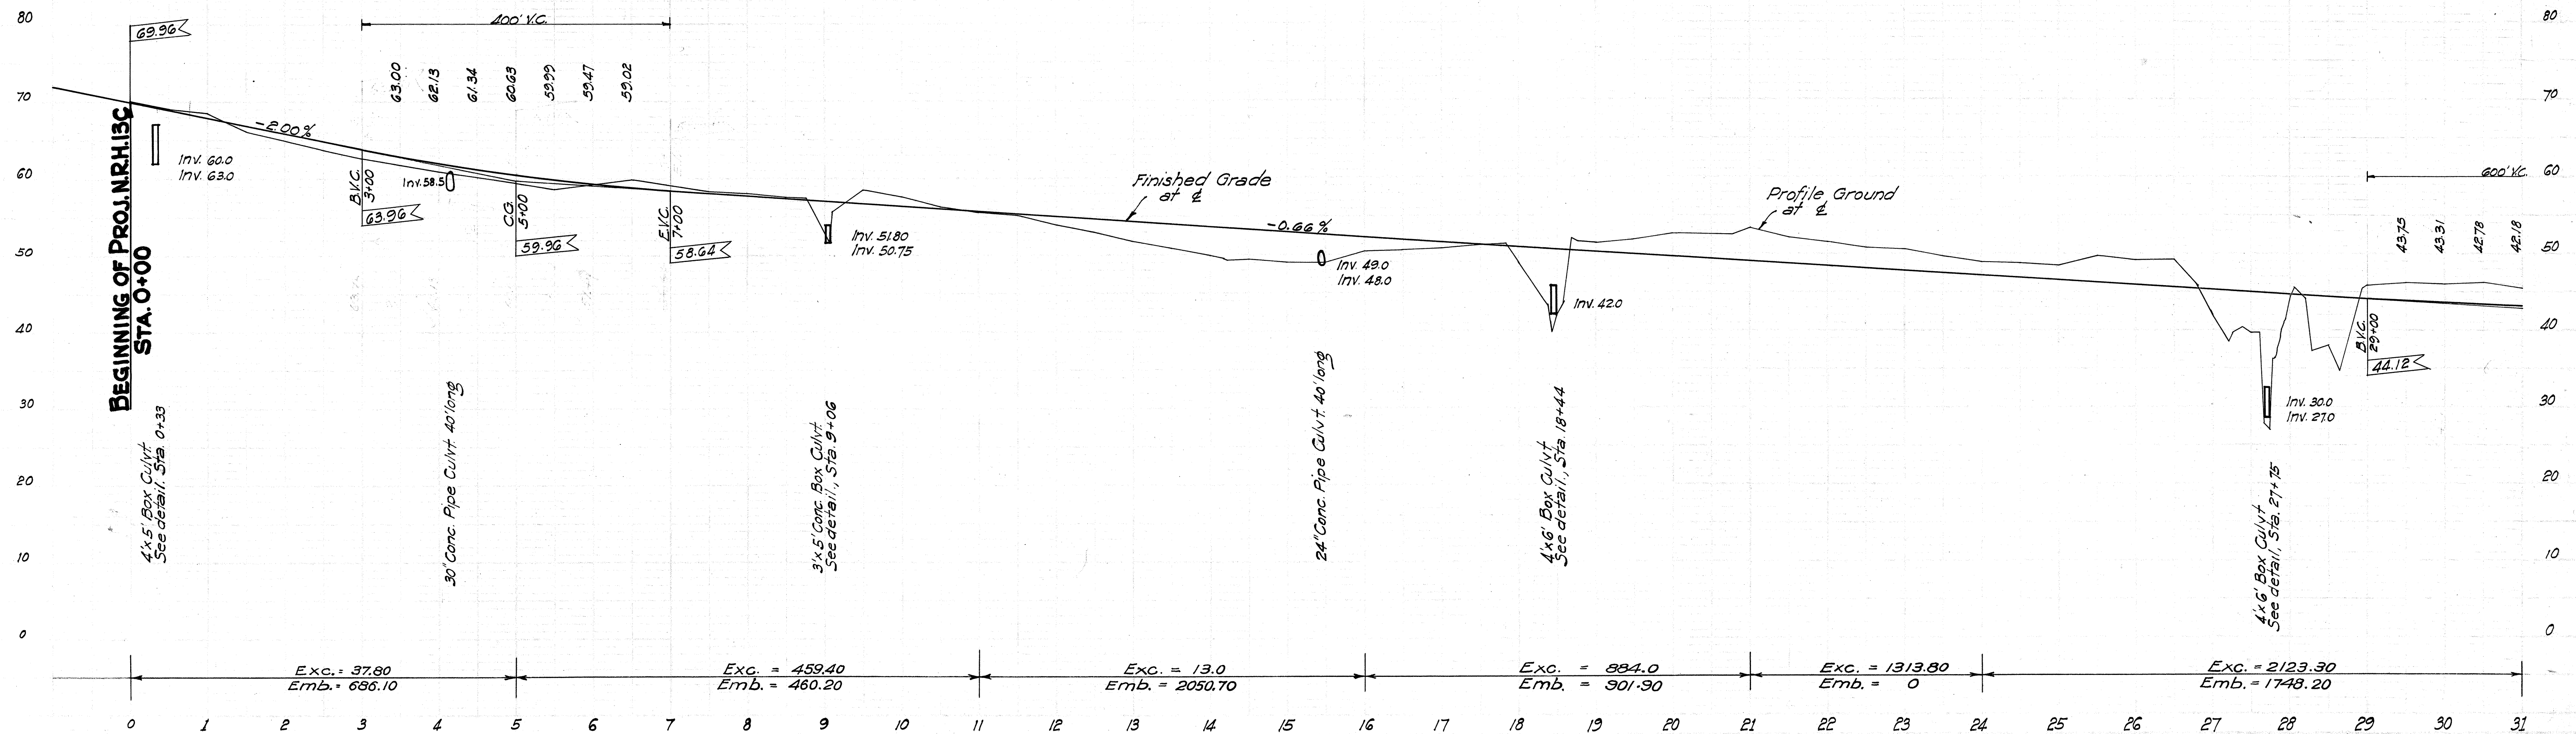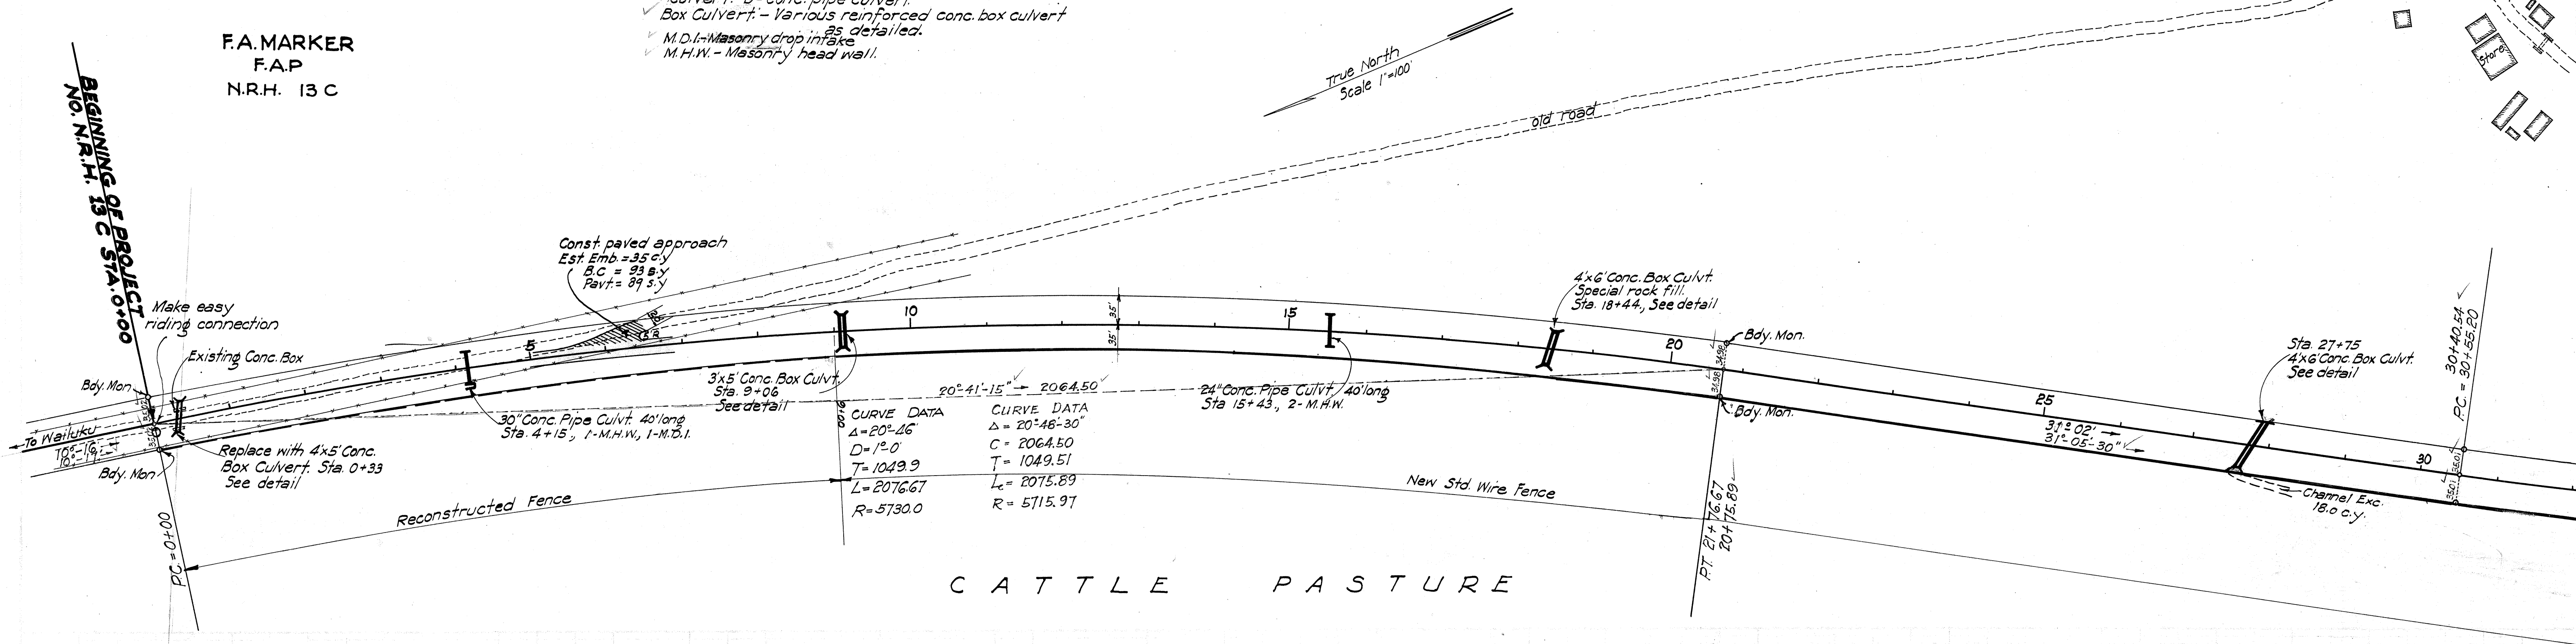

4 3 1 5 . 3

F.A. MARKER
F.A.P.
N.R.H. 13C

