
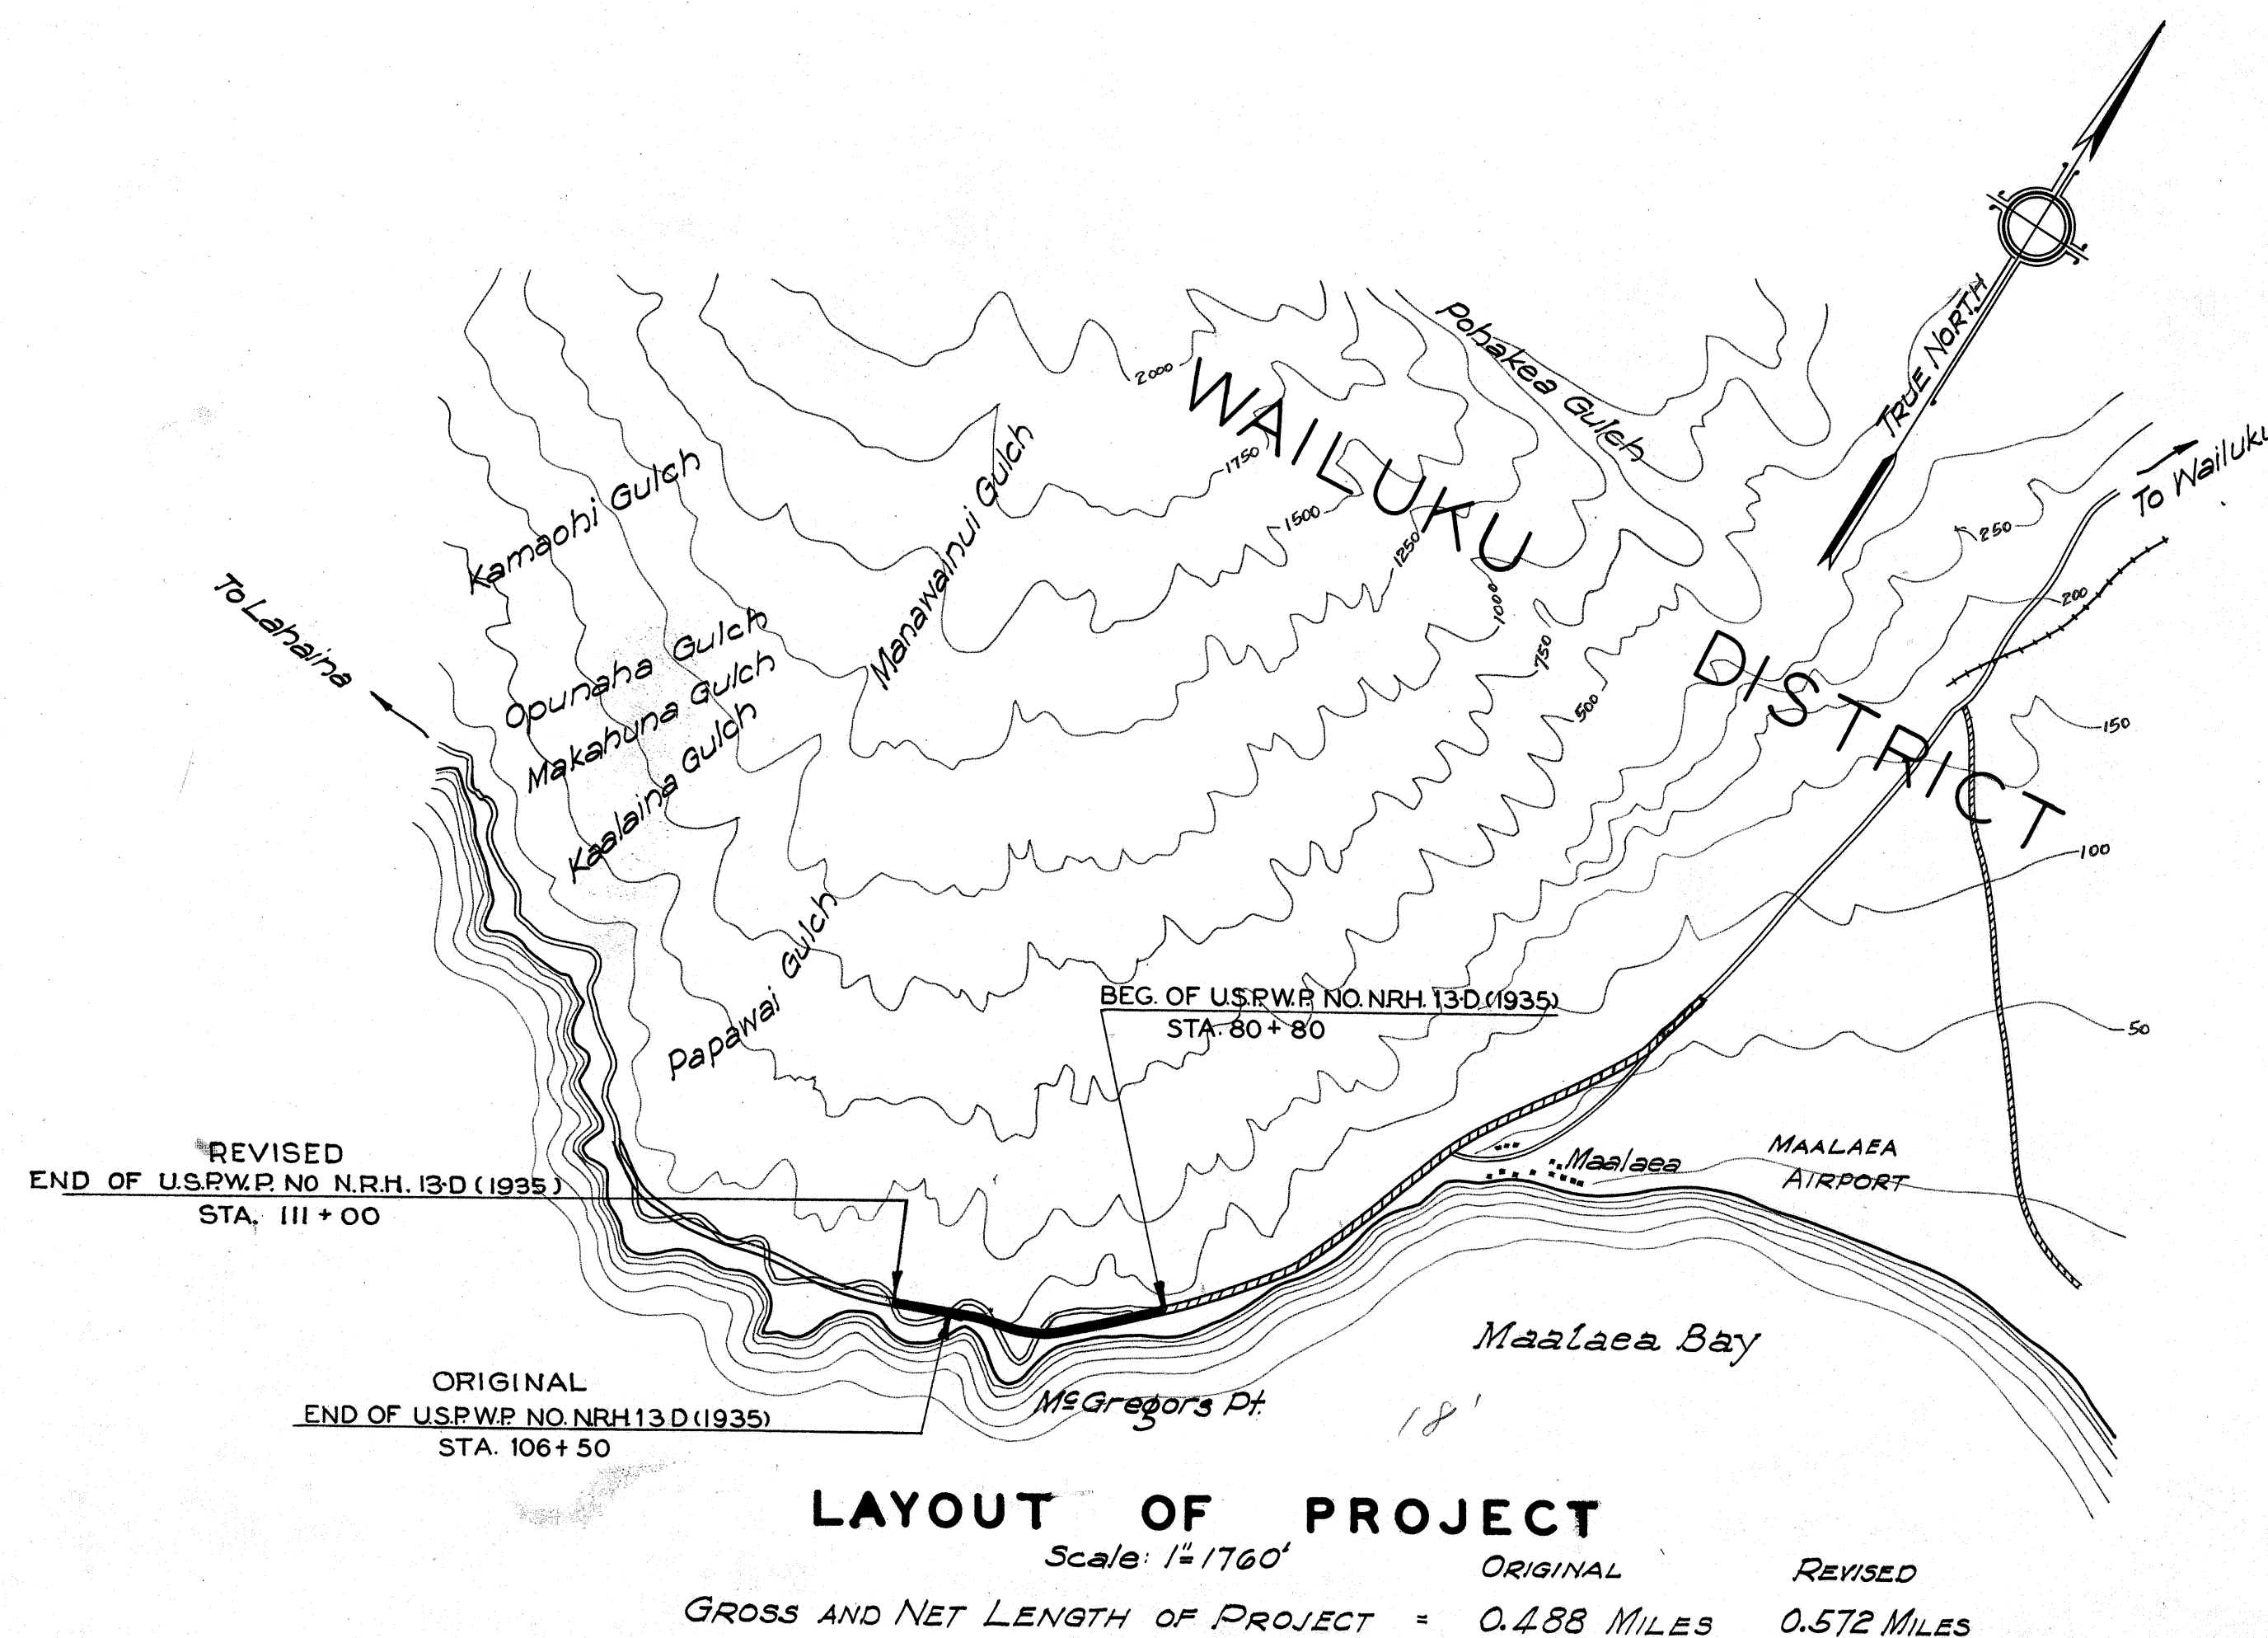


CONVENTIONAL	SIGNS
Existing Fence	
Existing Stonewall Fence	
Existing Road	
Center Line	
Culverts	
Railroad	

SCALES	
PLANS	1 INCH = 100 FEET
PROFILE	HOR. 1 INCH = 100 FEET
	VERT. 1 INCH = 10 FEET
CROSS SECTIONS	1 INCH = 10 FEET

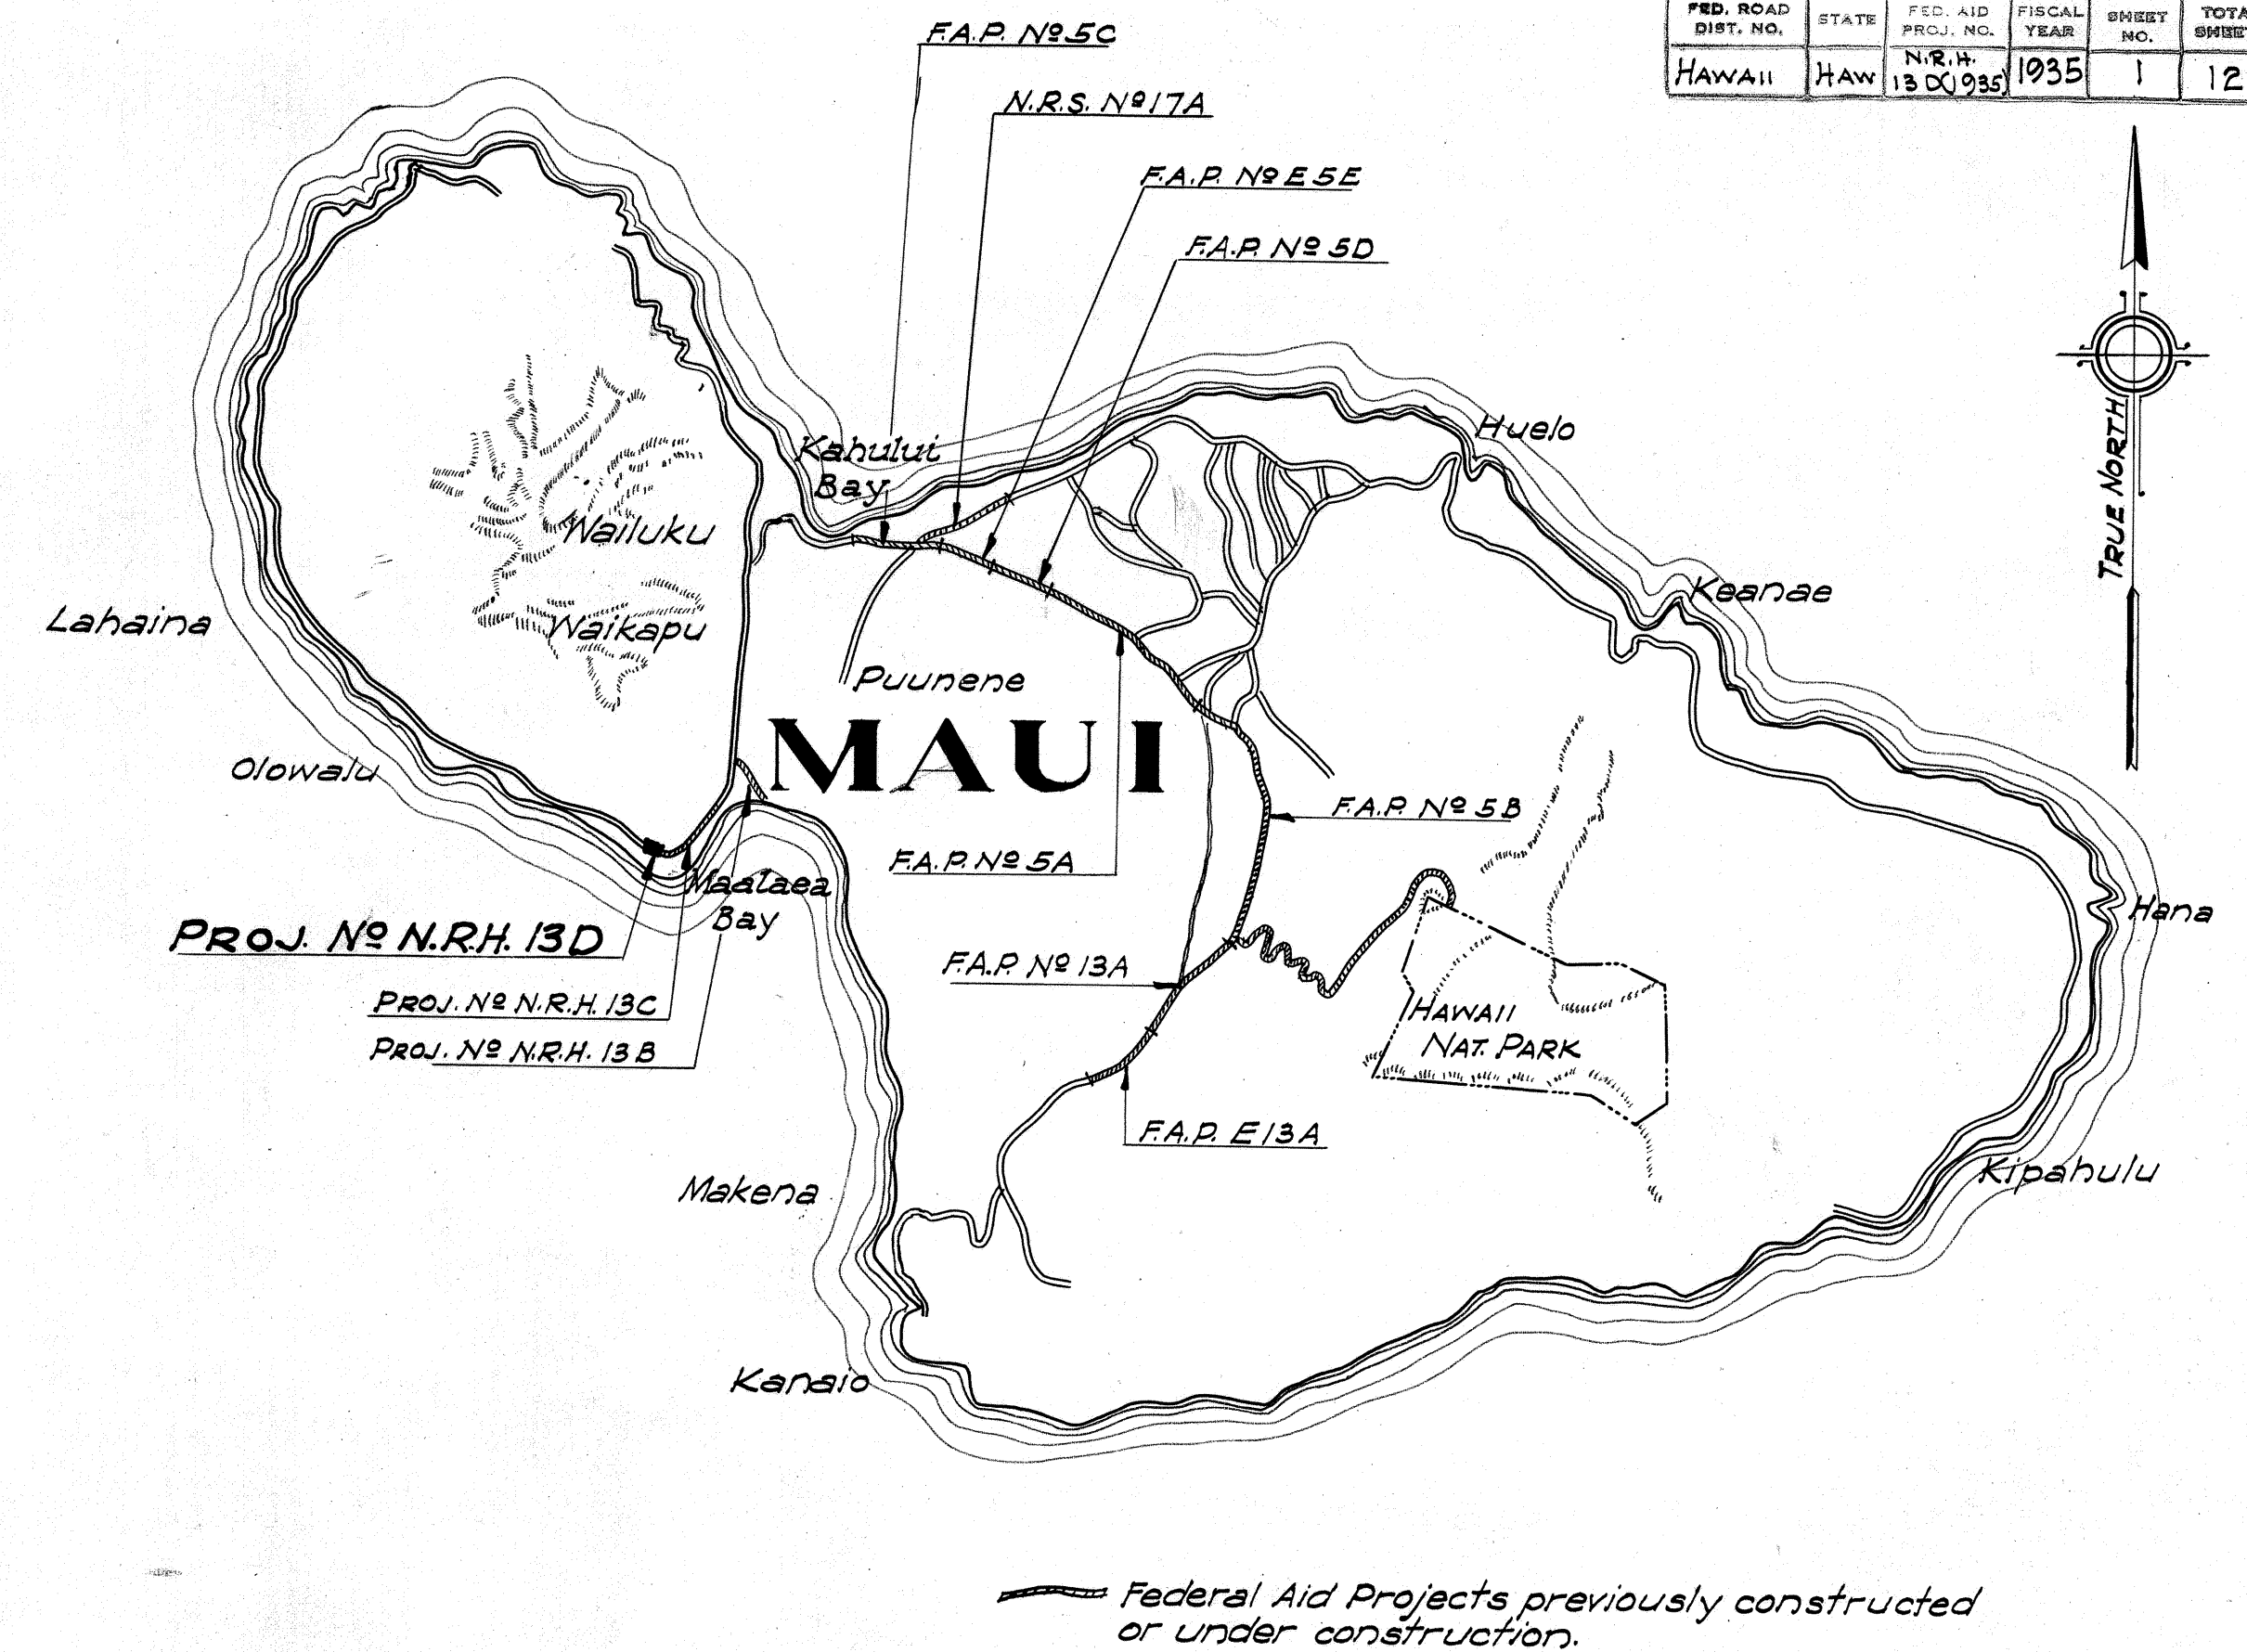

RECOMMENDED FOR APPROVAL

E.S. Wheeler. 32535.

PRINCIPAL HIGHWAY ENGINEER Bu. of Pub. Rds.

RECOMMENDED FOR APPROVAL

CHIEF ENGINEER, Bureau of Public Roads

APPROVED

CHIEF, Bureau of Public Roads

4326.1

ORIGINAL PLAN	SURVEY PLOTTED BY	DATE
NOTE BOOK	DESIGNED BY	
	DRAWN BY	J.C.M.
	TRADED BY	J.C.M.
	QUANTITIES BY	
No. _____	CHECKED BY	

REVISED BY: J.C.M. 8/5/35 as per survey submitted by D.F.B July 1935