
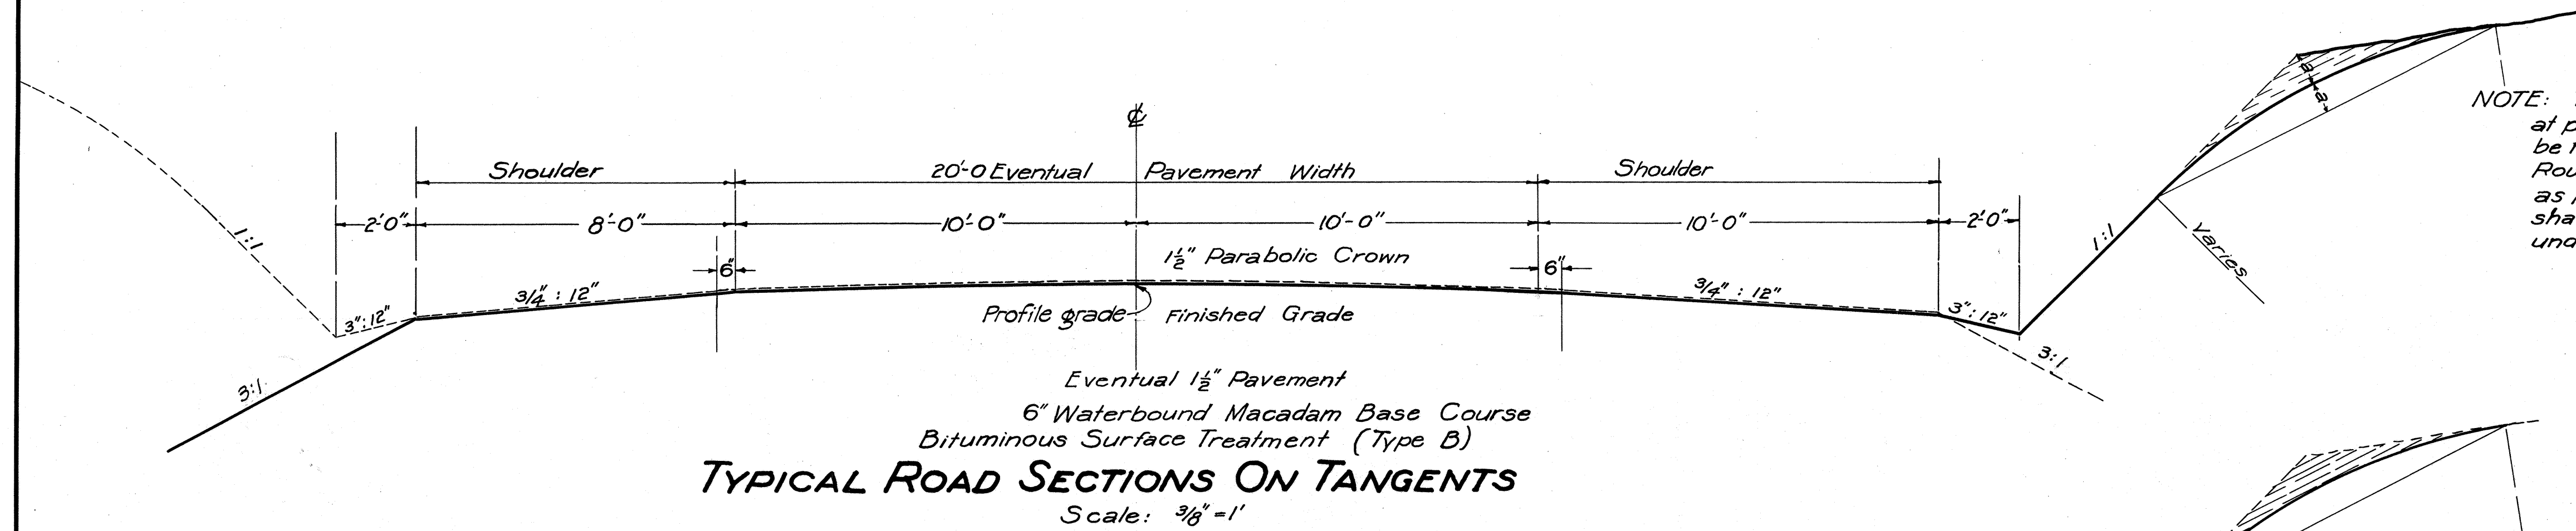


NOTES ON BASE COURSE

BASE COURSE: Total compacted thickness of 6" to be as shown by the typical sections above of Waterbound Macadam Base Course; constructed in accordance with Pamphlet "H-6" of the Territorial Highway Dept.

BITUMINOUS SURFACE TREATMENT: Type B

GENERAL NOTES: Special reference is made to the specifications and special provisions covering all these items of work.

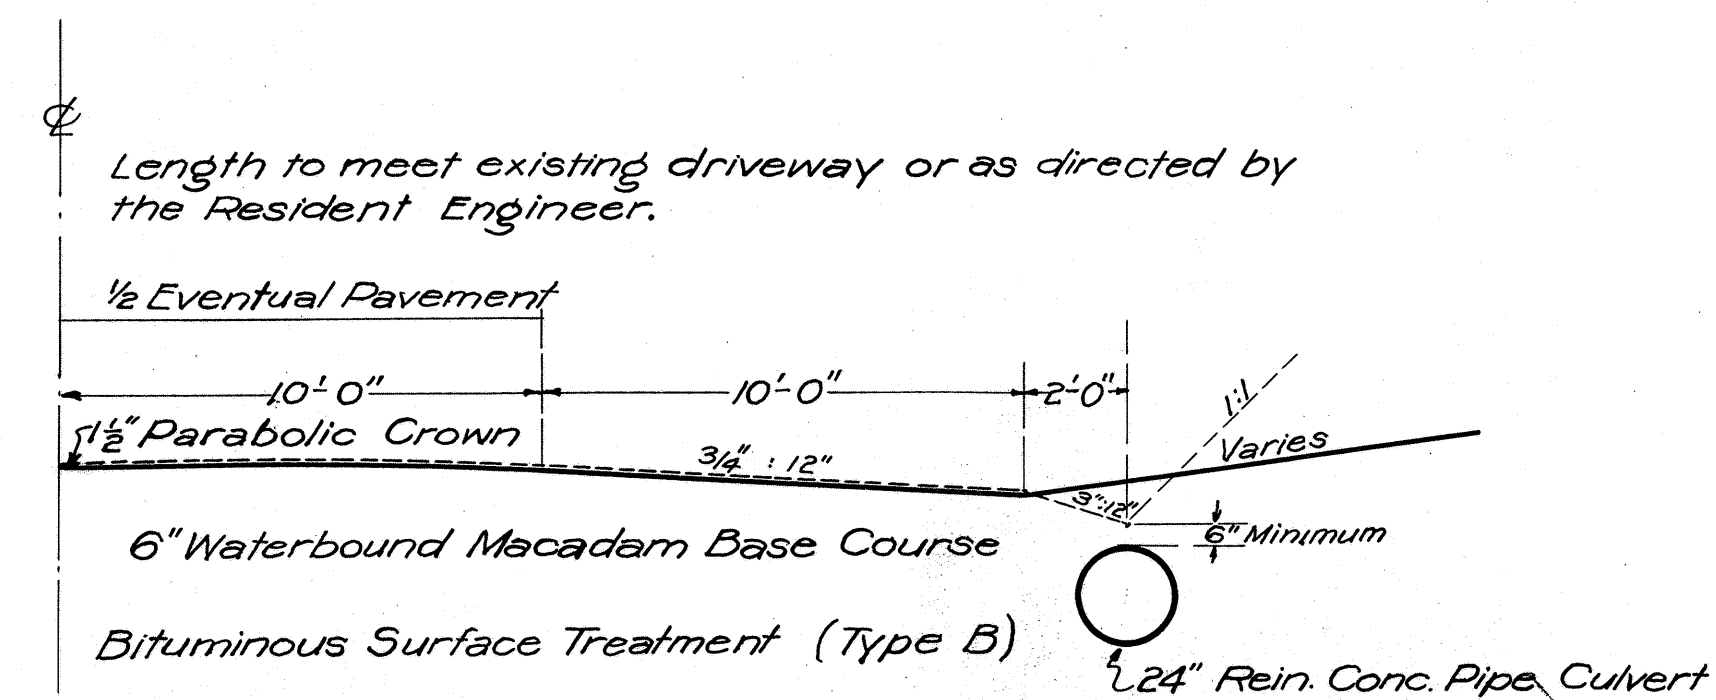

DETAIL OF APPROACHES

Scale: 1/4" = 1'