


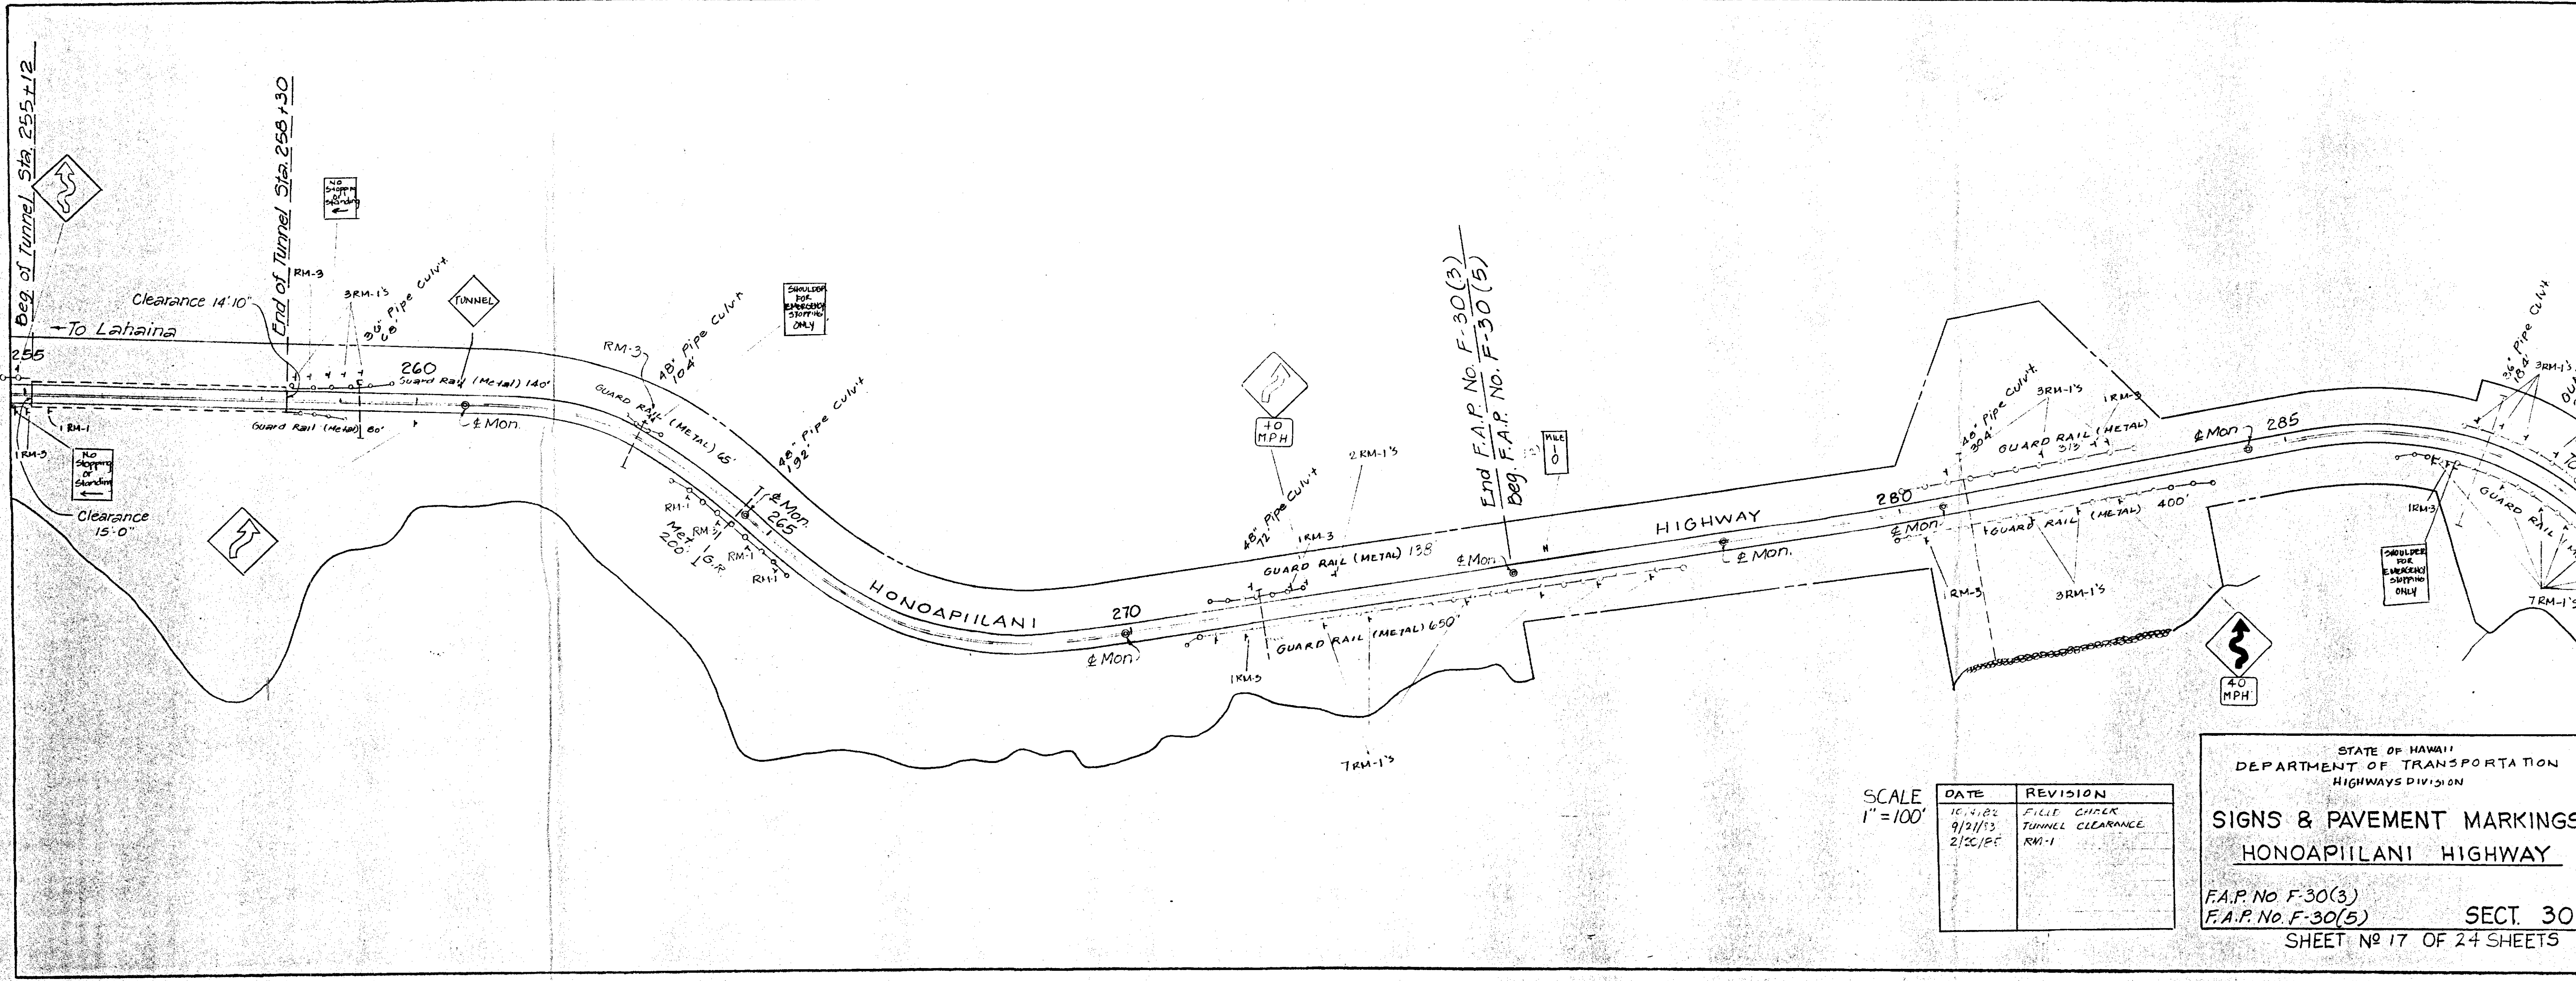

Beg of Tunnel Sta. 255+12

End of Tunnel Sta. 258+30

End F.A.P. No. F-30(3)
Beg. F.A.P. No. F-30(5)

SCALE
1"=100'


DATE	REVISION
10/4/82	FILL CHALK
9/21/83	TUNNEL CLEARANCE
2/22/85	RM-1

STATE OF HAWAII
DEPARTMENT OF TRANSPORTATION
HIGHWAYS DIVISION

SIGNS & PAVEMENT MARKINGS
HONOAPIILANI HIGHWAY

F.A.P. No. F-30(3)
F.A.P. No. F-30(5)

SECT. 30
SHEET No 17 OF 24 SHEETS

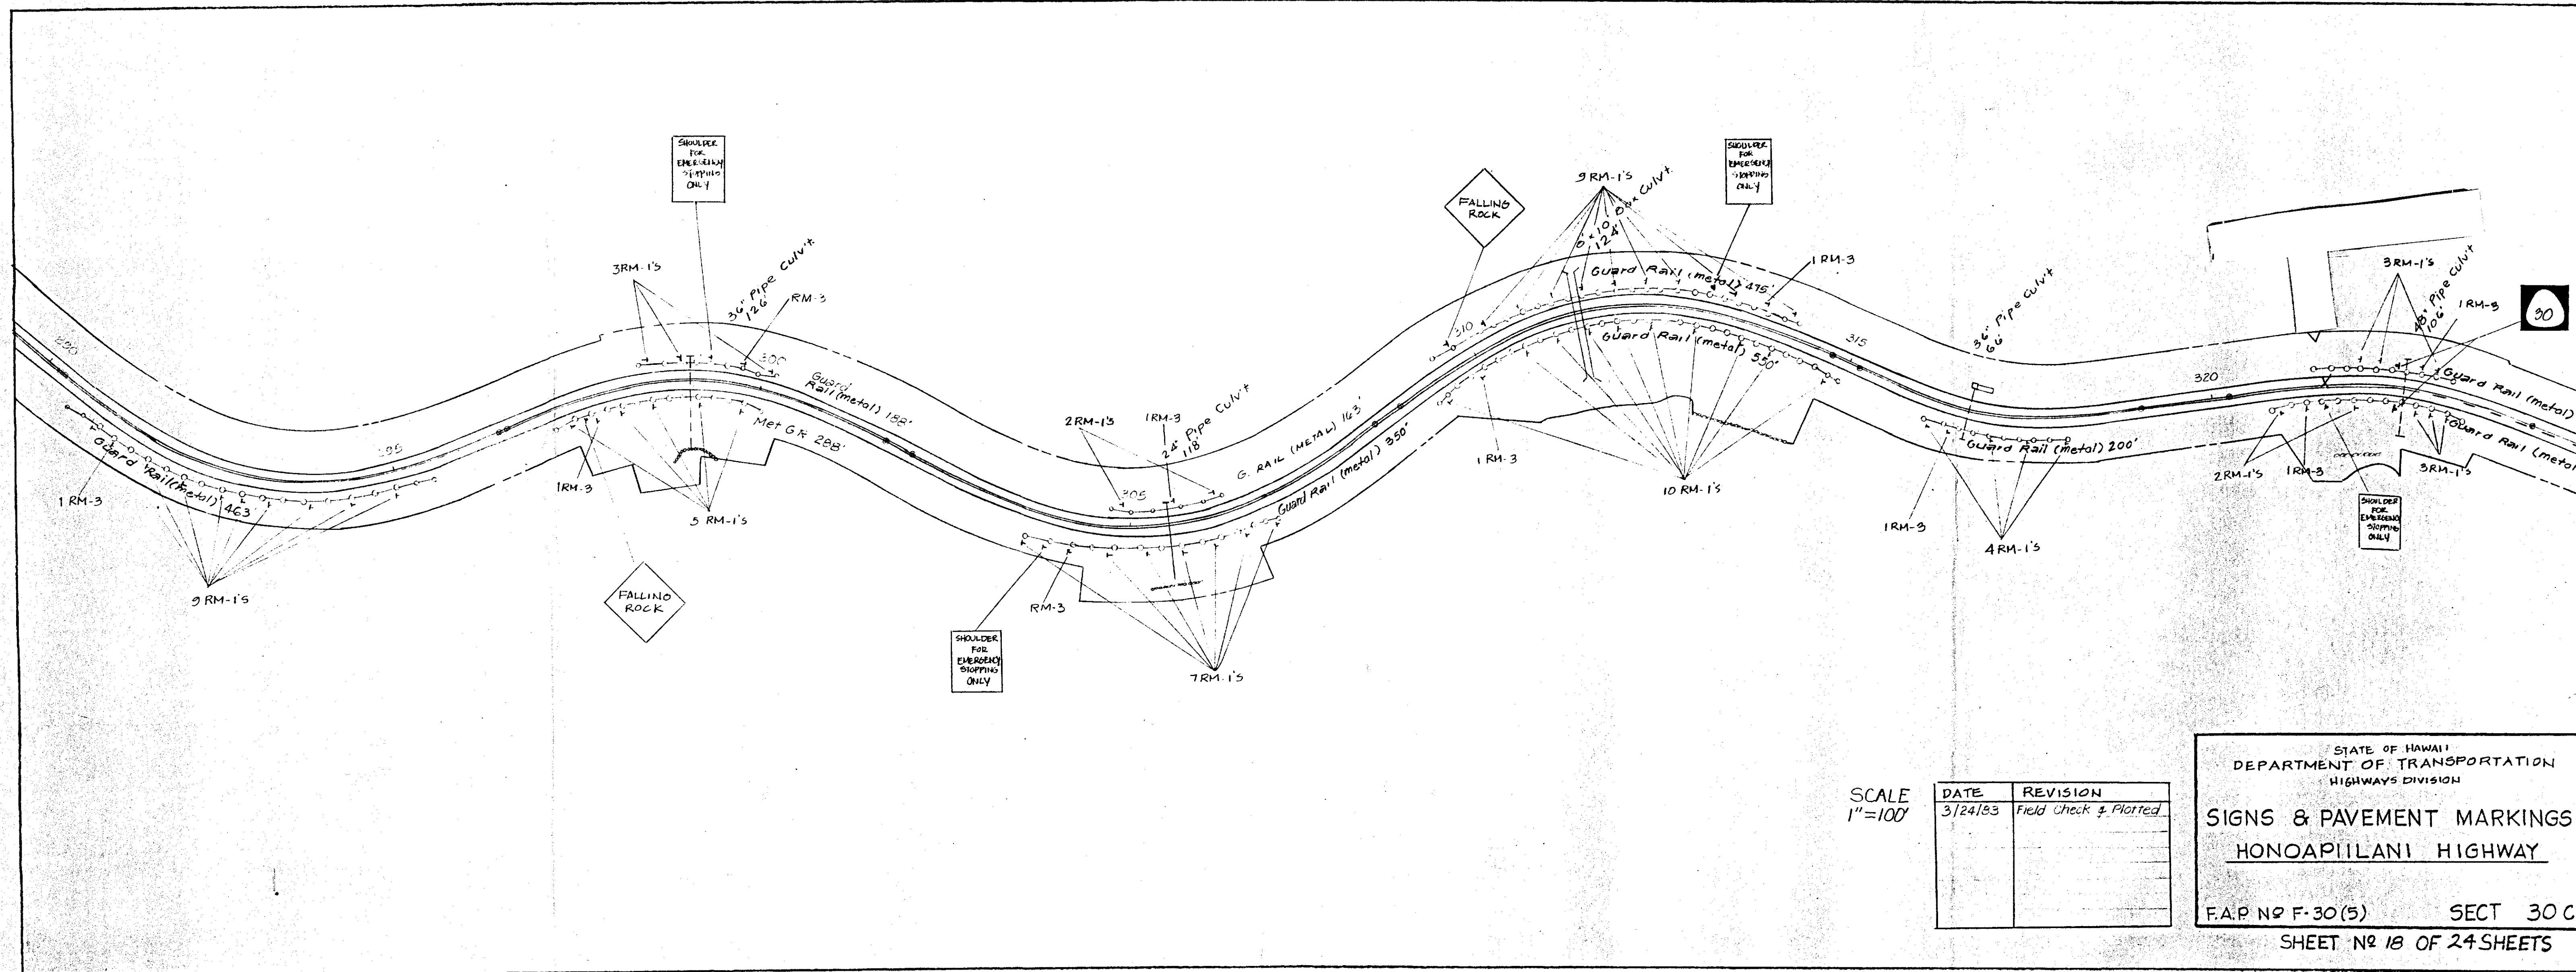

SCALE
1"=100'

DATE	REVISION
3/24/83	Field Check & Plotted

STATE OF HAWAII
DEPARTMENT OF TRANSPORTATION
HIGHWAYS DIVISION

SIGNS & PAVEMENT MARKINGS
HONOAPIILANI HIGHWAY

F.A.P. NO F-30(5) SECT 30 C

SHEET NO 18 OF 24 SHEETS