


INDEX TO DRAWINGS	
SHEET NO	DESCRIPTION
1	TITLE SHEET
2	TYPICAL SECTION
3-7	PLAN & PROFILE

TERRITORY OF HAWAII TERRITORIAL HIGHWAY DEPARTMENT HONOLULU, T. H.

PLANS FOR WIDENING AND SURFACING OF LAHAINA-WAILUKU ROAD OLOWALU SECTION FEDERAL AID PROJECT NO. F 30(4) DISTRICT OF LAHAINA ISLAND OF MAUI

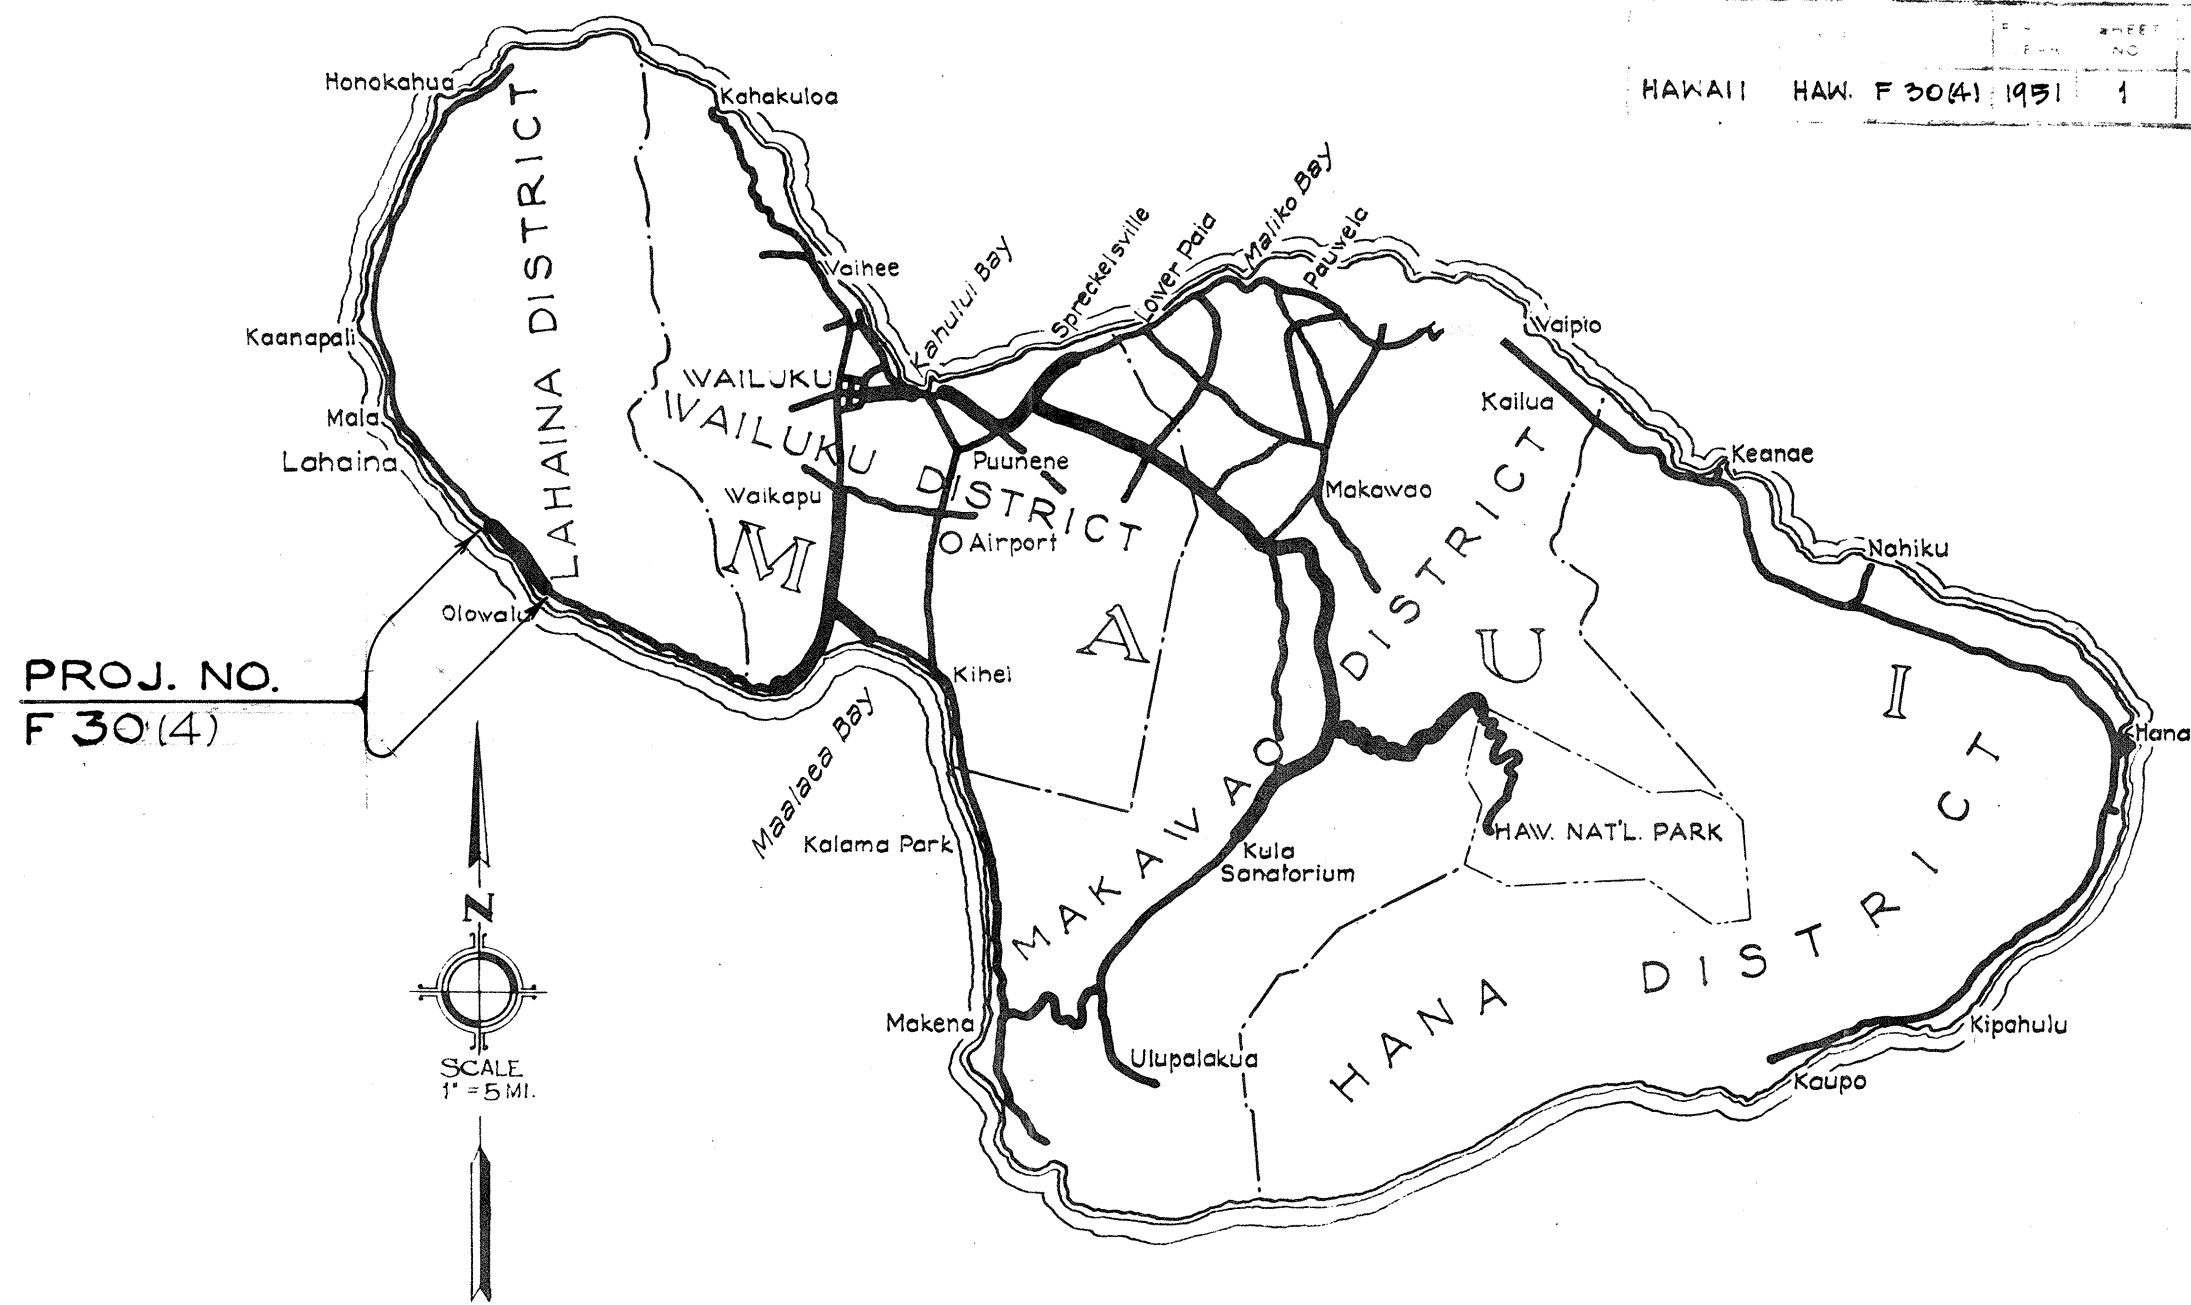

LOCATION MAP

Federal Aid Projects previously constructed or under construction.

CONVENTIONAL SIGNS USED


Centerline	85
Centerline Monument	2 ft. Mon.
Boundary Lines	
Existing Road	
Circular Pipe Culvert	
Box Culvert	
Bridge	
Trees	

SCALE

PLAN	1 IN. = 100 FT.
PROFILE	VER. 1 IN. = 10 FT.
	HOR. 1 IN. = 100 FT.

NOTE:
ALL CHANGES MADE DURING CONSTRUCTION HAVE
BEEN NOTED IN RED ON THESE TRACINGS AND
CHECKED BY:

[Signature]
RESIDENT ENGINEER
March 6th 1952
DATE

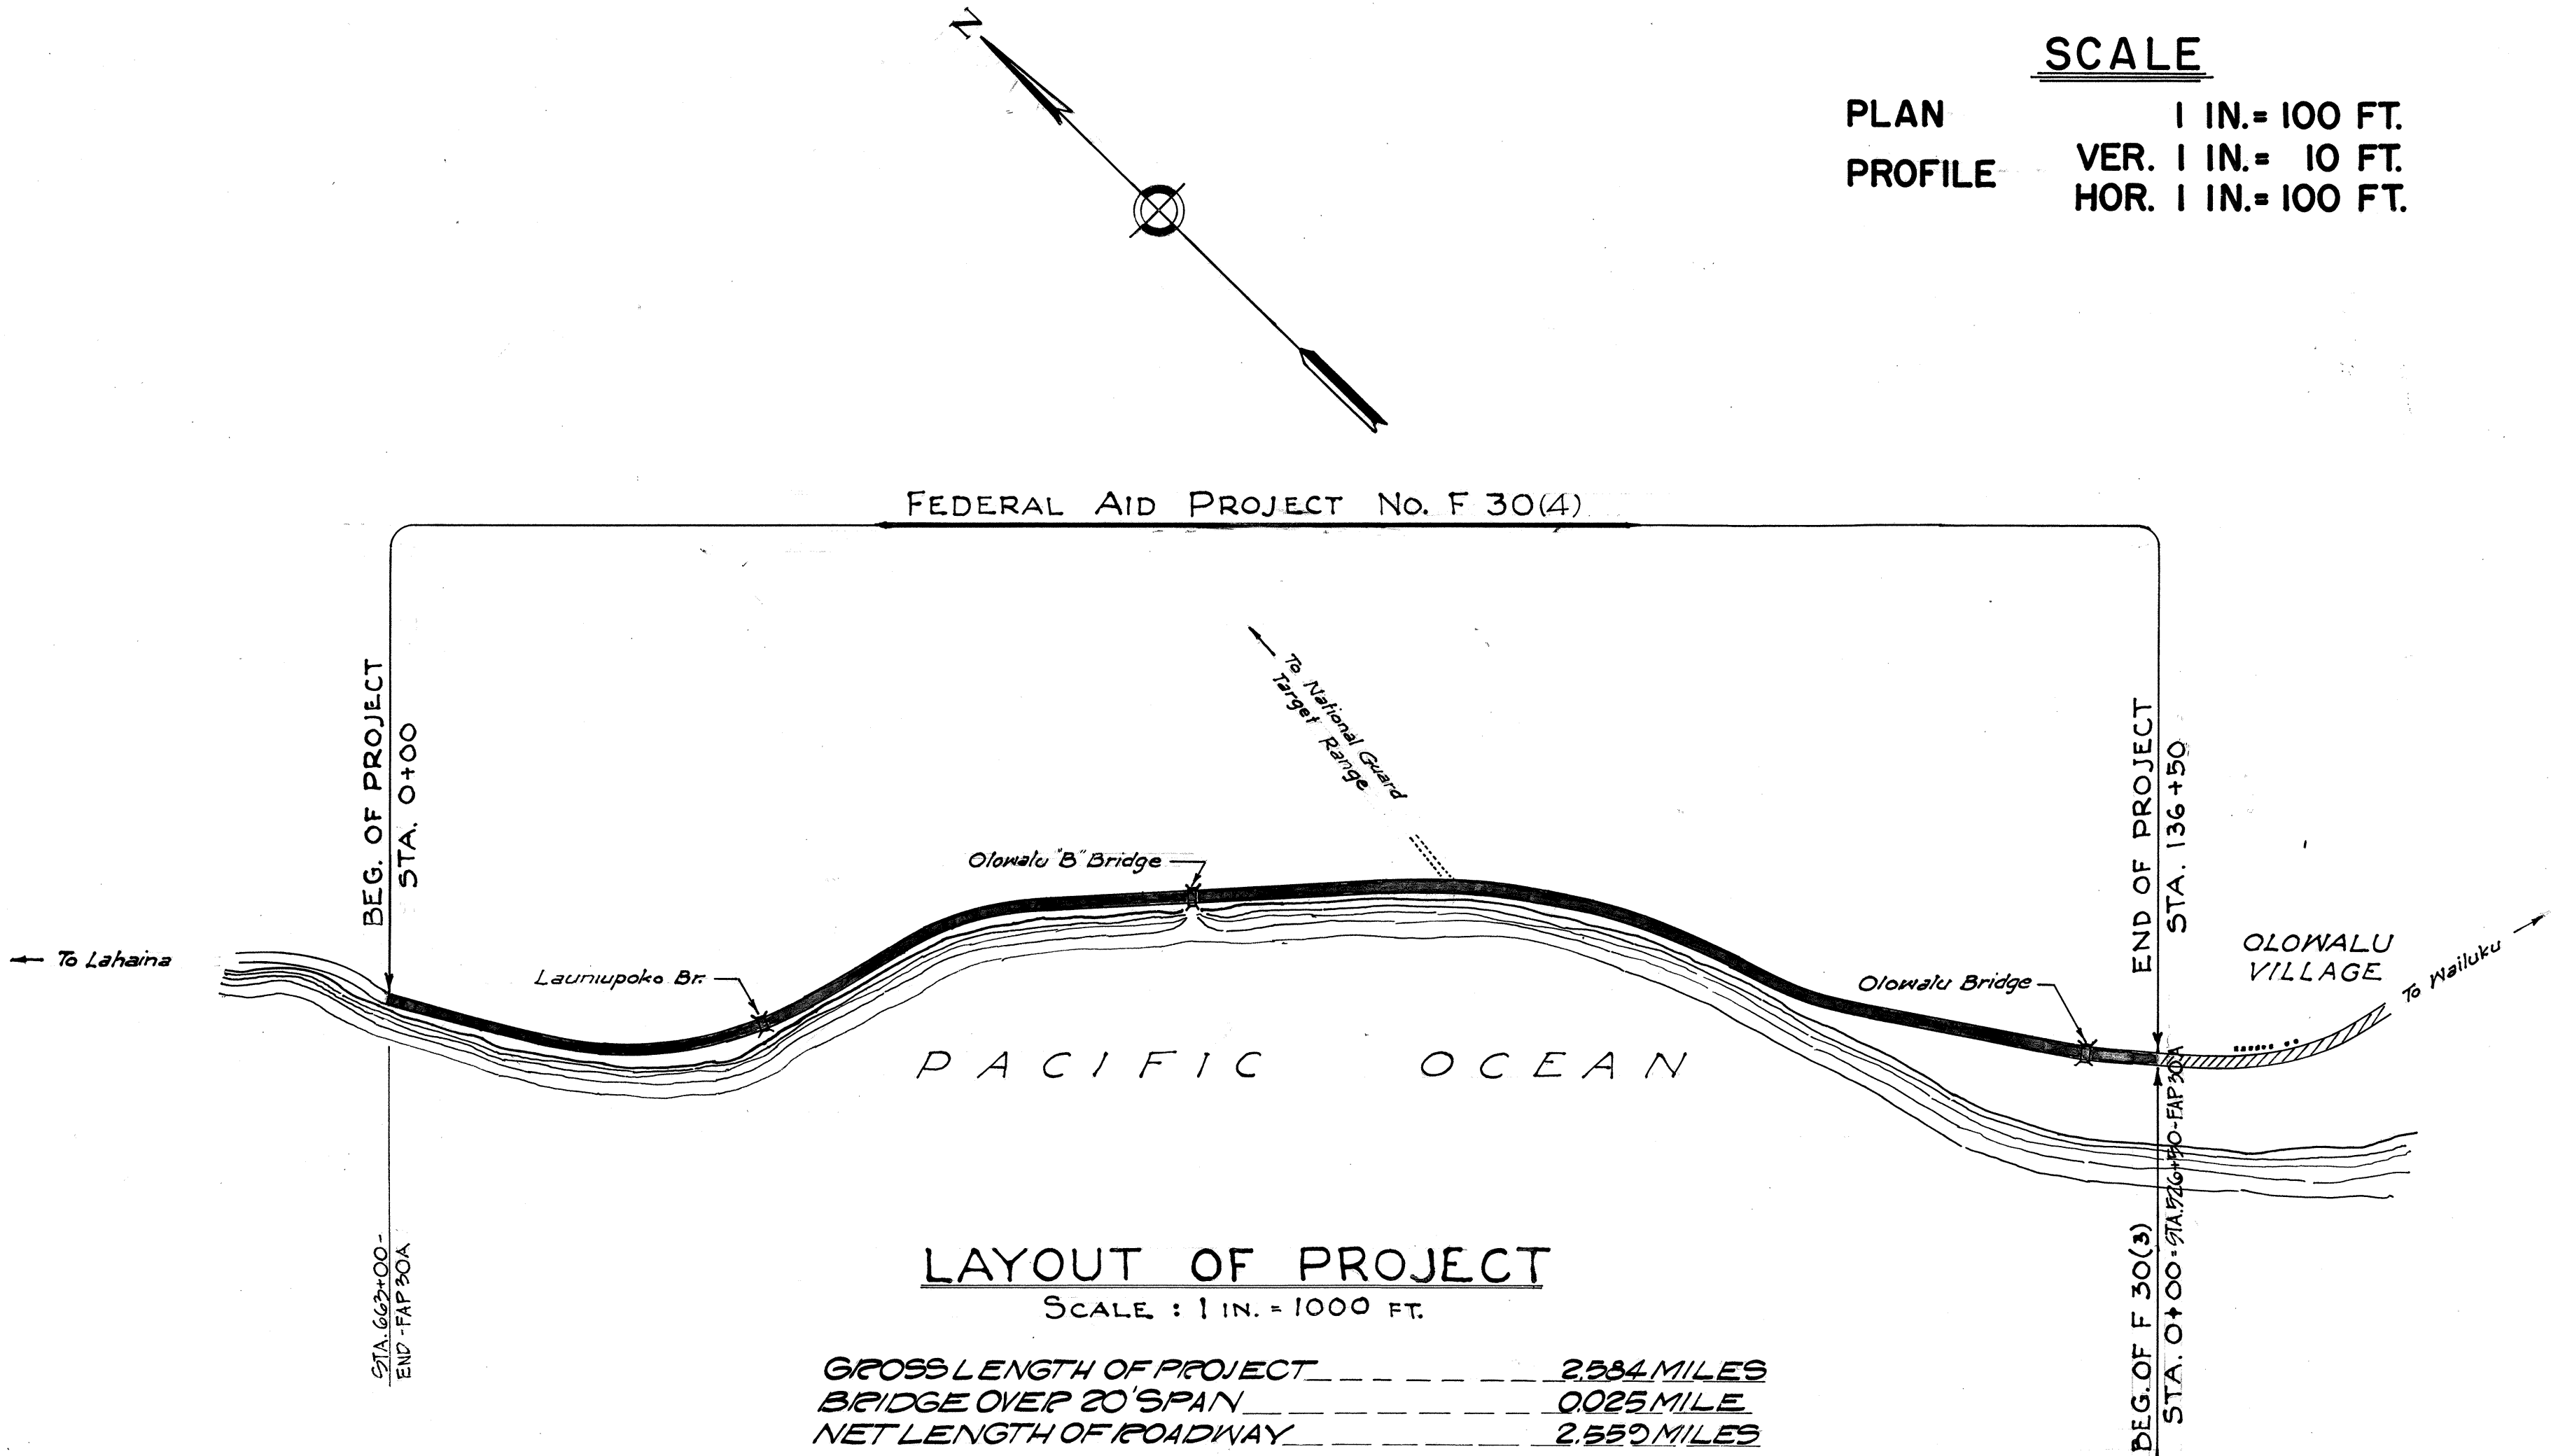

APPROVED: *[Signature]* DATE 7-18-51
TERRITORIAL HIGHWAY ENGINEER

DEPARTMENT OF COMMERCE BUREAU OF PUBLIC ROADS	
RECOMMENDED FOR APPROVAL	
DISTRICT ENGINEER	DATE
APPROVED	
DIVISION ENGINEER	DATE