


DATE	BY	REVIEWED	DATE
FINAL SURVEY		NO. _____	
SURVEYED		PLOTTED	
NOTE BOOK		AREAS CHECKED	

DATE	BY	REVIEWED	DATE
ORIGINAL SURVEY		NO. _____	
SURVEYED		PLOTTED	
NOTE BOOK		AREAS CHECKED	

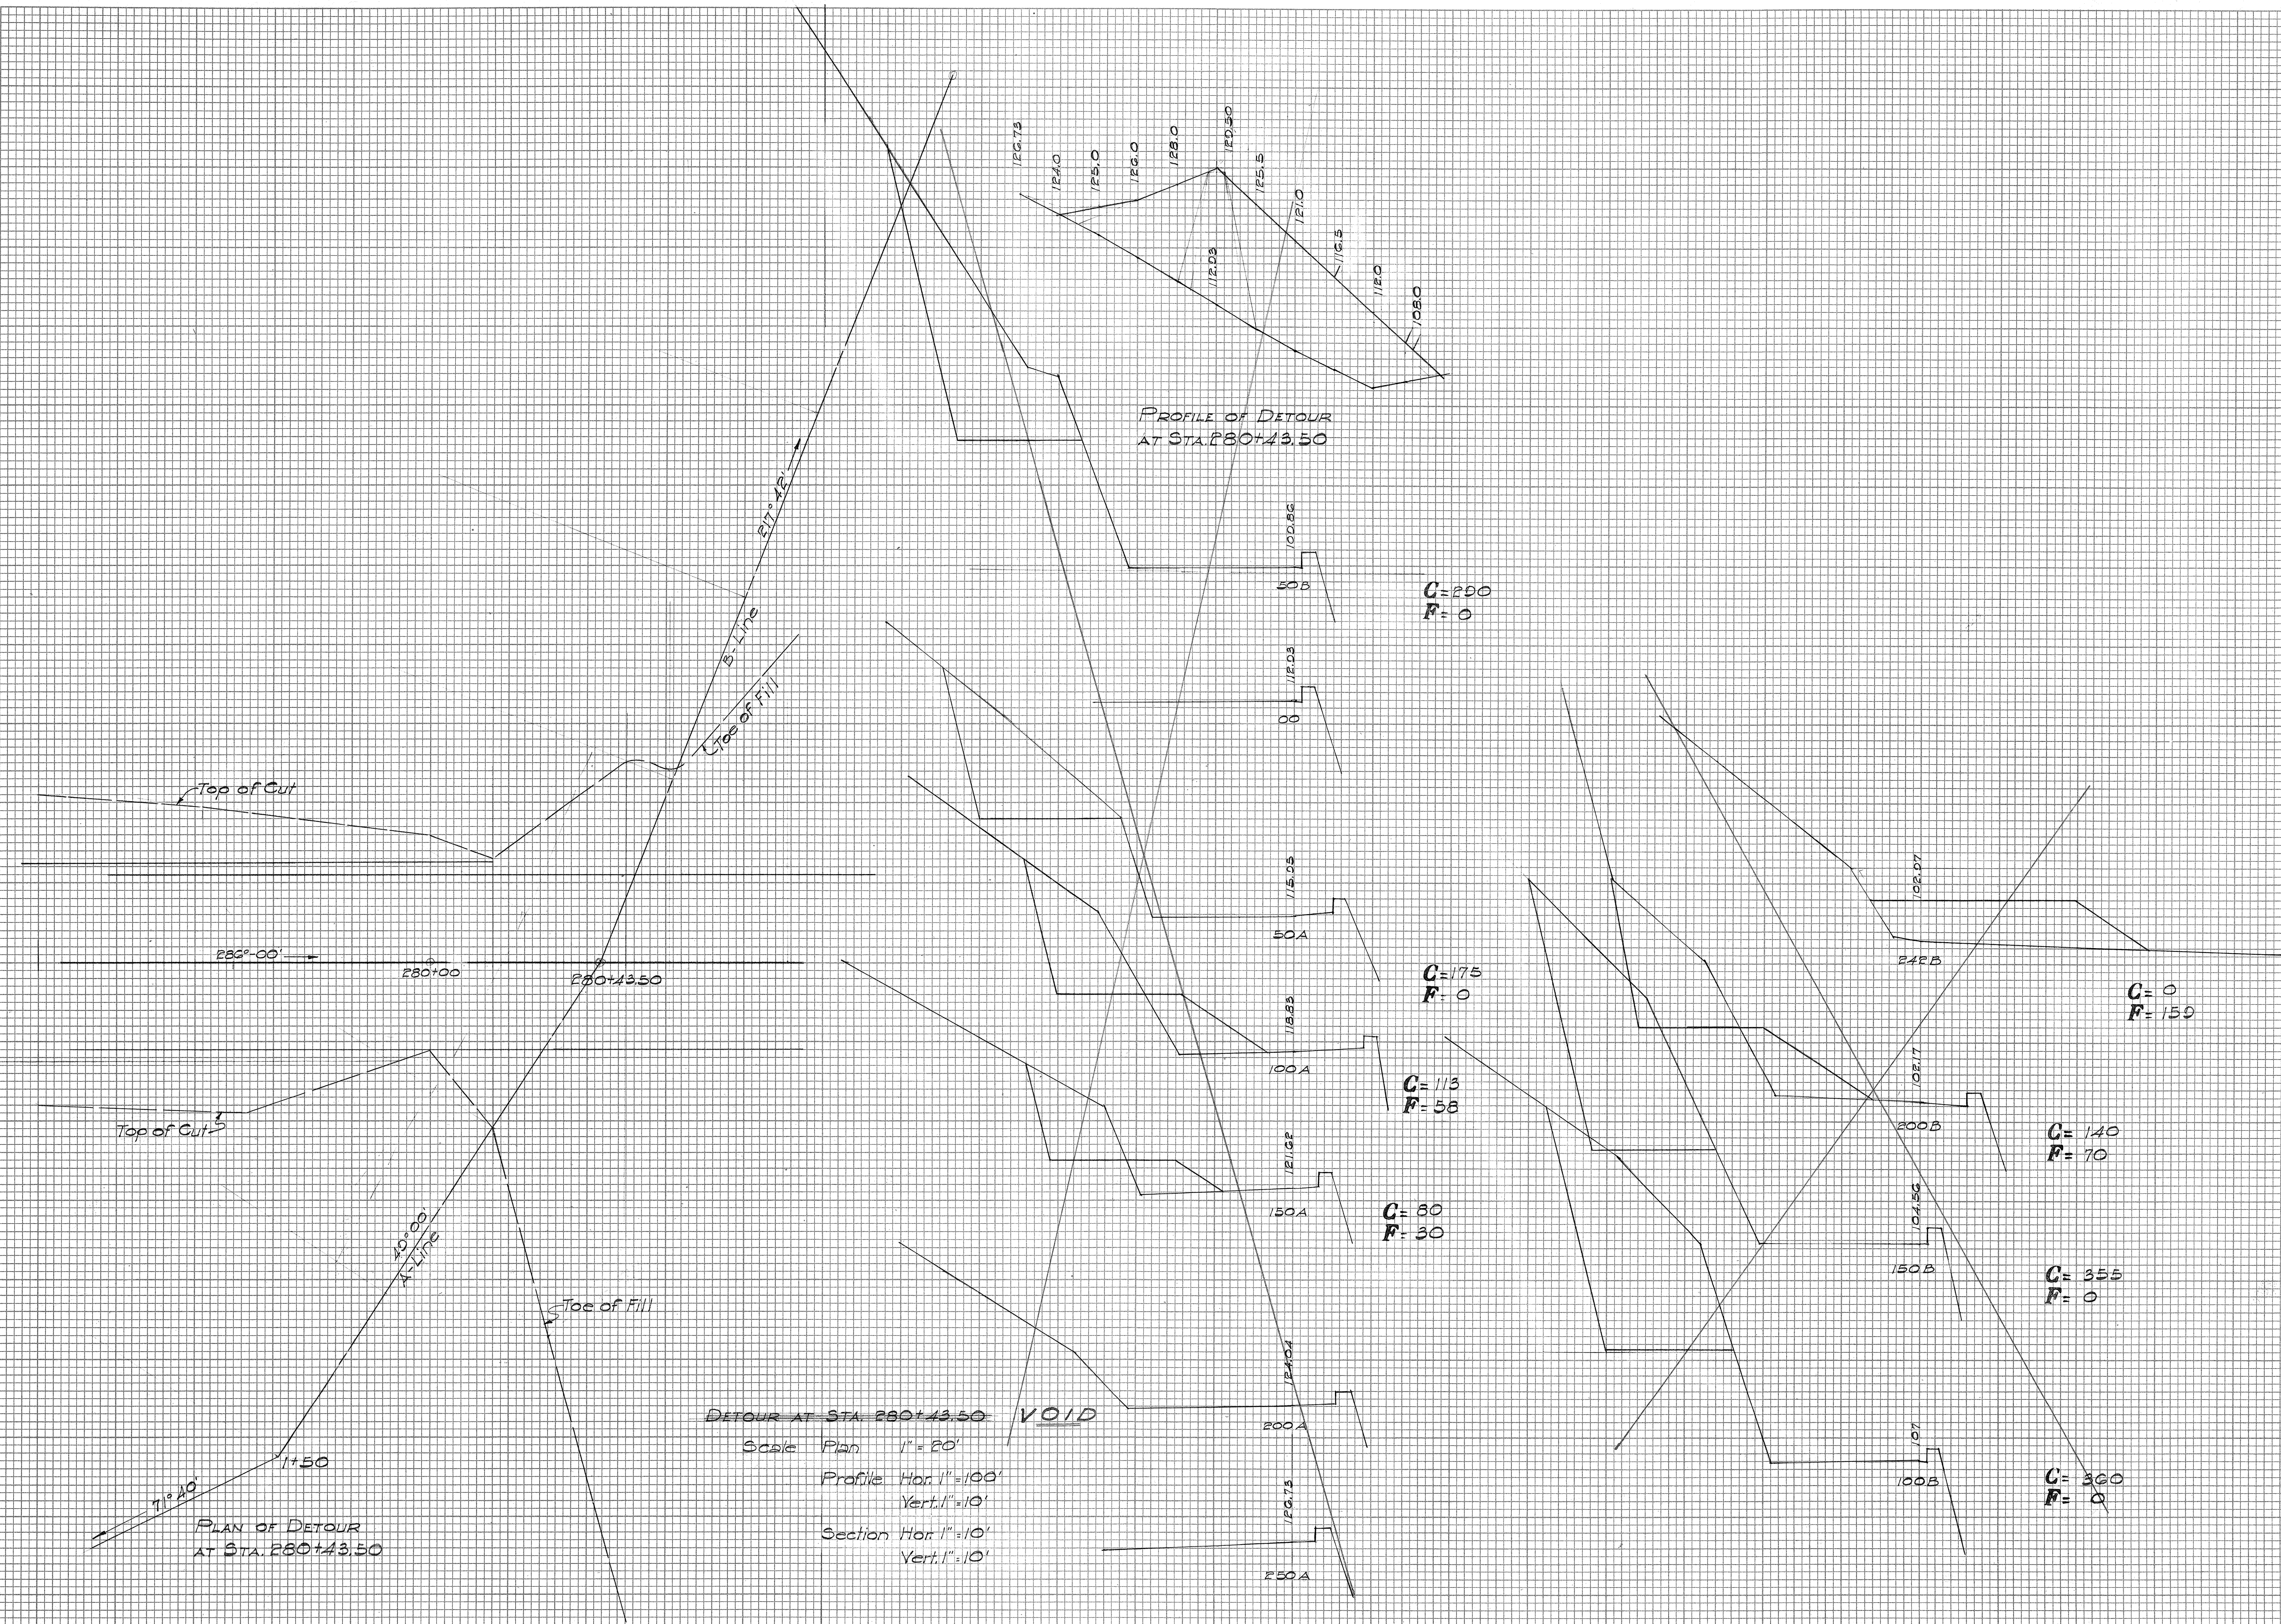

FED. ROAD DIST. NO.	STATE	FED. AID PROJ. NO.	FISCAL YEAR	SHEET NO.	TOTAL SHEETS
1000000	IND.	F 30(3)	1953	16	24

FINAL SURVEY	DATE	BY
SURVEYED		
PLOTTED		
NOTE BOOK		
AREAS CHECKED		

ORIGINAL SURVEY	DATE	BY
SURVEYED		
PLOTTED		
NOTE BOOK		
AREAS CHECKED		

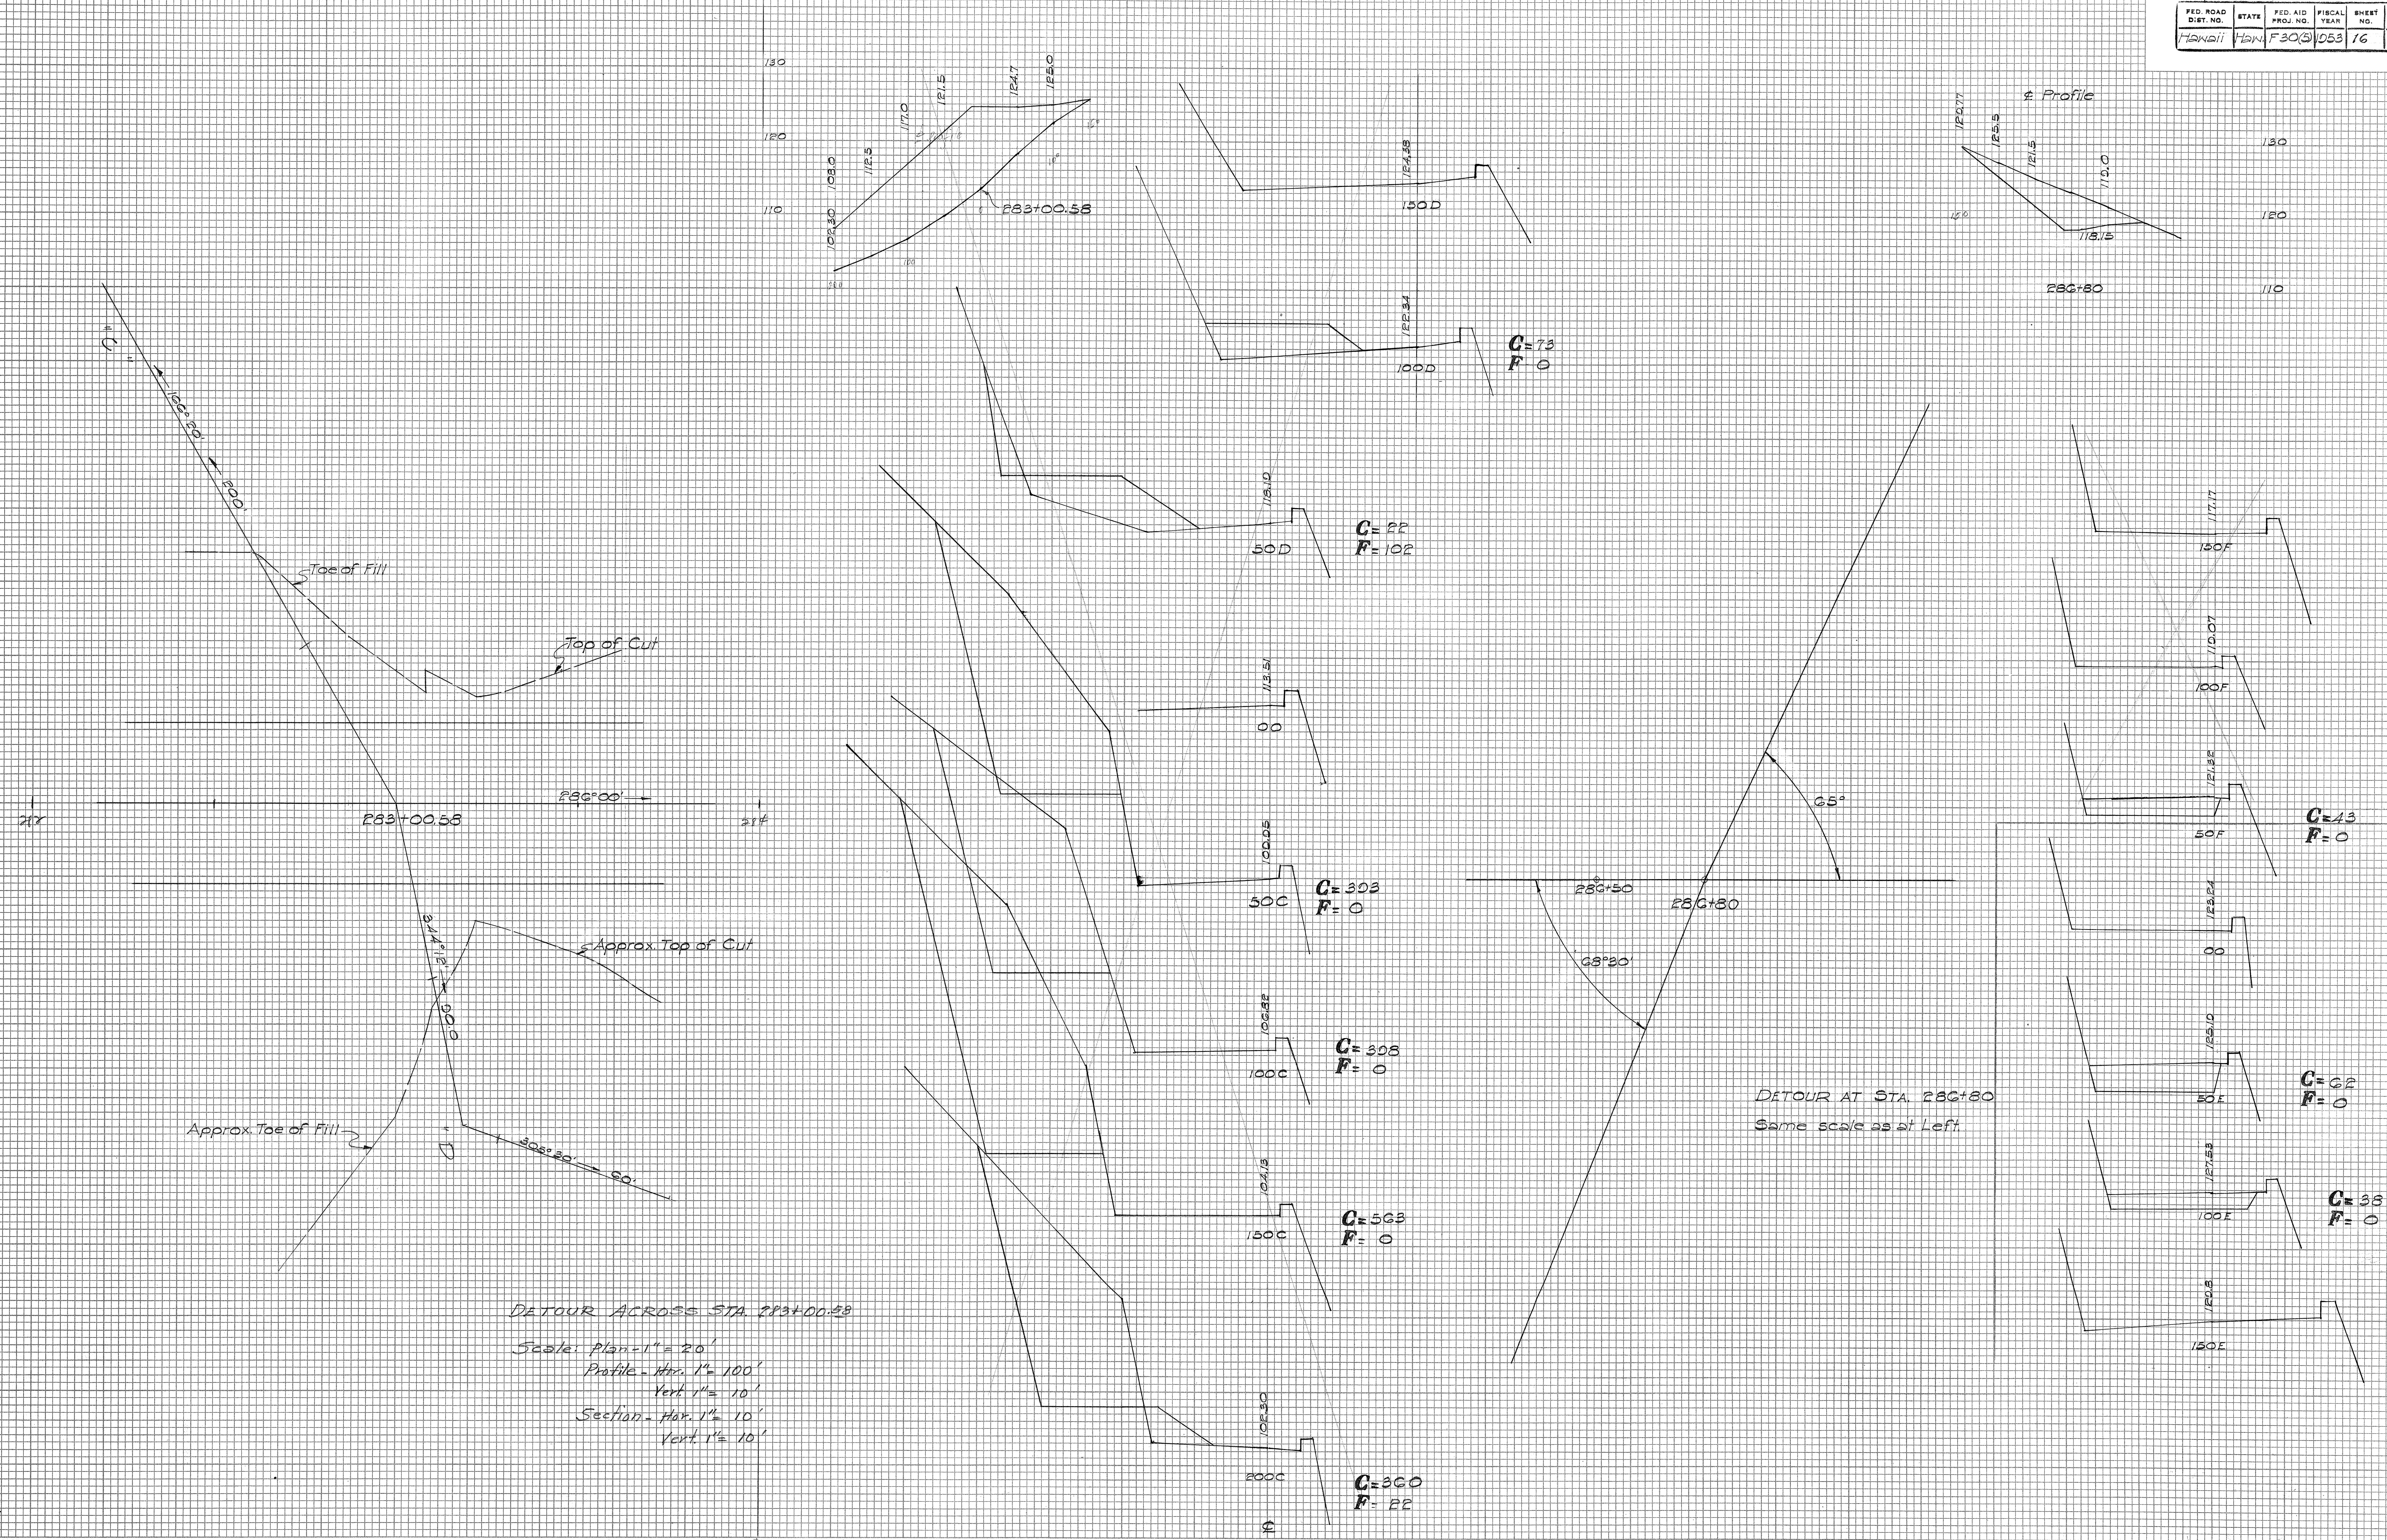


PLATE 3 CROSS SECTION O. P. R. & R. E. STANDARD
 100% RAG PAPER-MADE AND PRINTED IN U. S. A.
 EUGENE DIETZEN CO.

5662.16