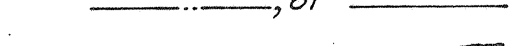
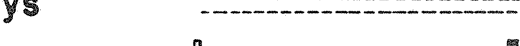
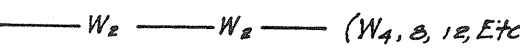
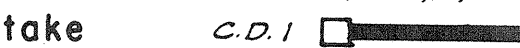
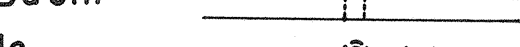


INDEX TO DRAWINGS	
SHEET NO	DESCRIPTION
1	TITLE SHEET
2	TYPICAL SECTION
3 - 6	PLAN & PROFILE
7 - 9	STANDARD DETAILS
10 - 14	BOX CULVERT DETAILS
15 - 16	DETOUR CROSS OVER SECTIONS
17 - 24	CROSS SECTIONS

CONVENTIONAL SIGNS

Centerline	
Boundary Lines	
Fences (Named)	
Existing Roadways	
Circular Culvert	
Box Culvert	
Bridge	
Telephone Pole	
Electric Power Pole	
Water Main	
Storm Drain	
Concrete Drop Intake	
Standard Catch Basin	
Standard Manhole	
Sewer Manhole	
Telephone Manhole	
Fire Hydrant	
Trees (Named)	
Railroad	

TERRITORY OF HAWAII
TERRITORIAL HIGHWAY DEPARTMENT
HONOLULU, T. H.


PLANS OF
LAHAINA — WAILUKU ROAD
PALI SECTION
FEDERAL AID PROJECT N^o F 30(5)

LAHAINA — WAILUKU DISTRICT

ISLAND OF MAUI


SCALE

PLAN	1 IN. = 100 FT.
PROFILE	HOR. 1 IN. = 100 FT. VER. 1 IN. = 10 FT.
X-SECTIONS	HOR. 1 IN. = 10 FT. VER. 1 IN. = 10 FT.

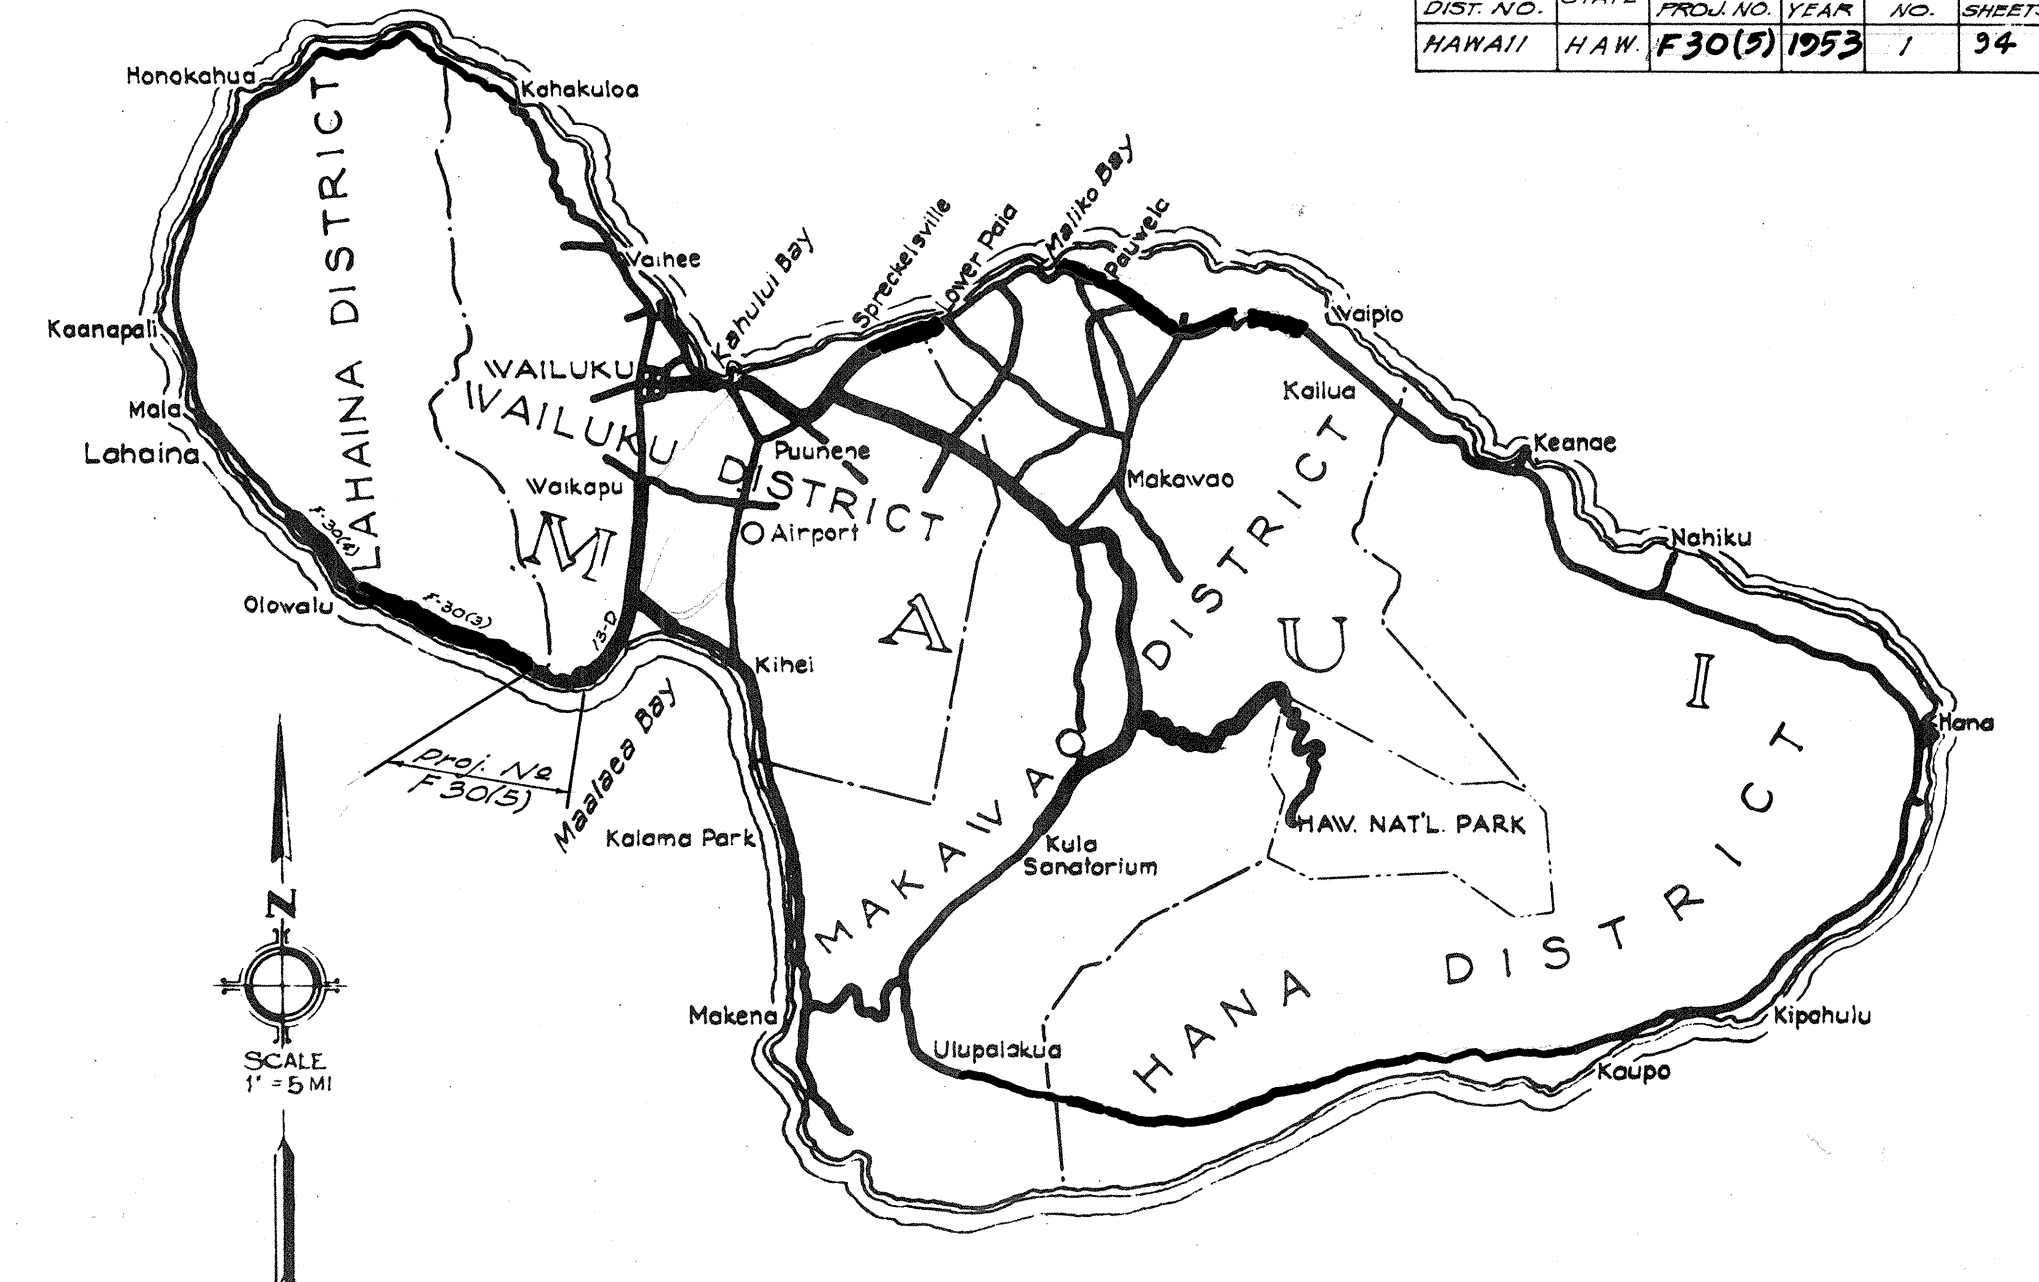

LOCATION MAP

Federal Aid Projects previously constructed or under construction.

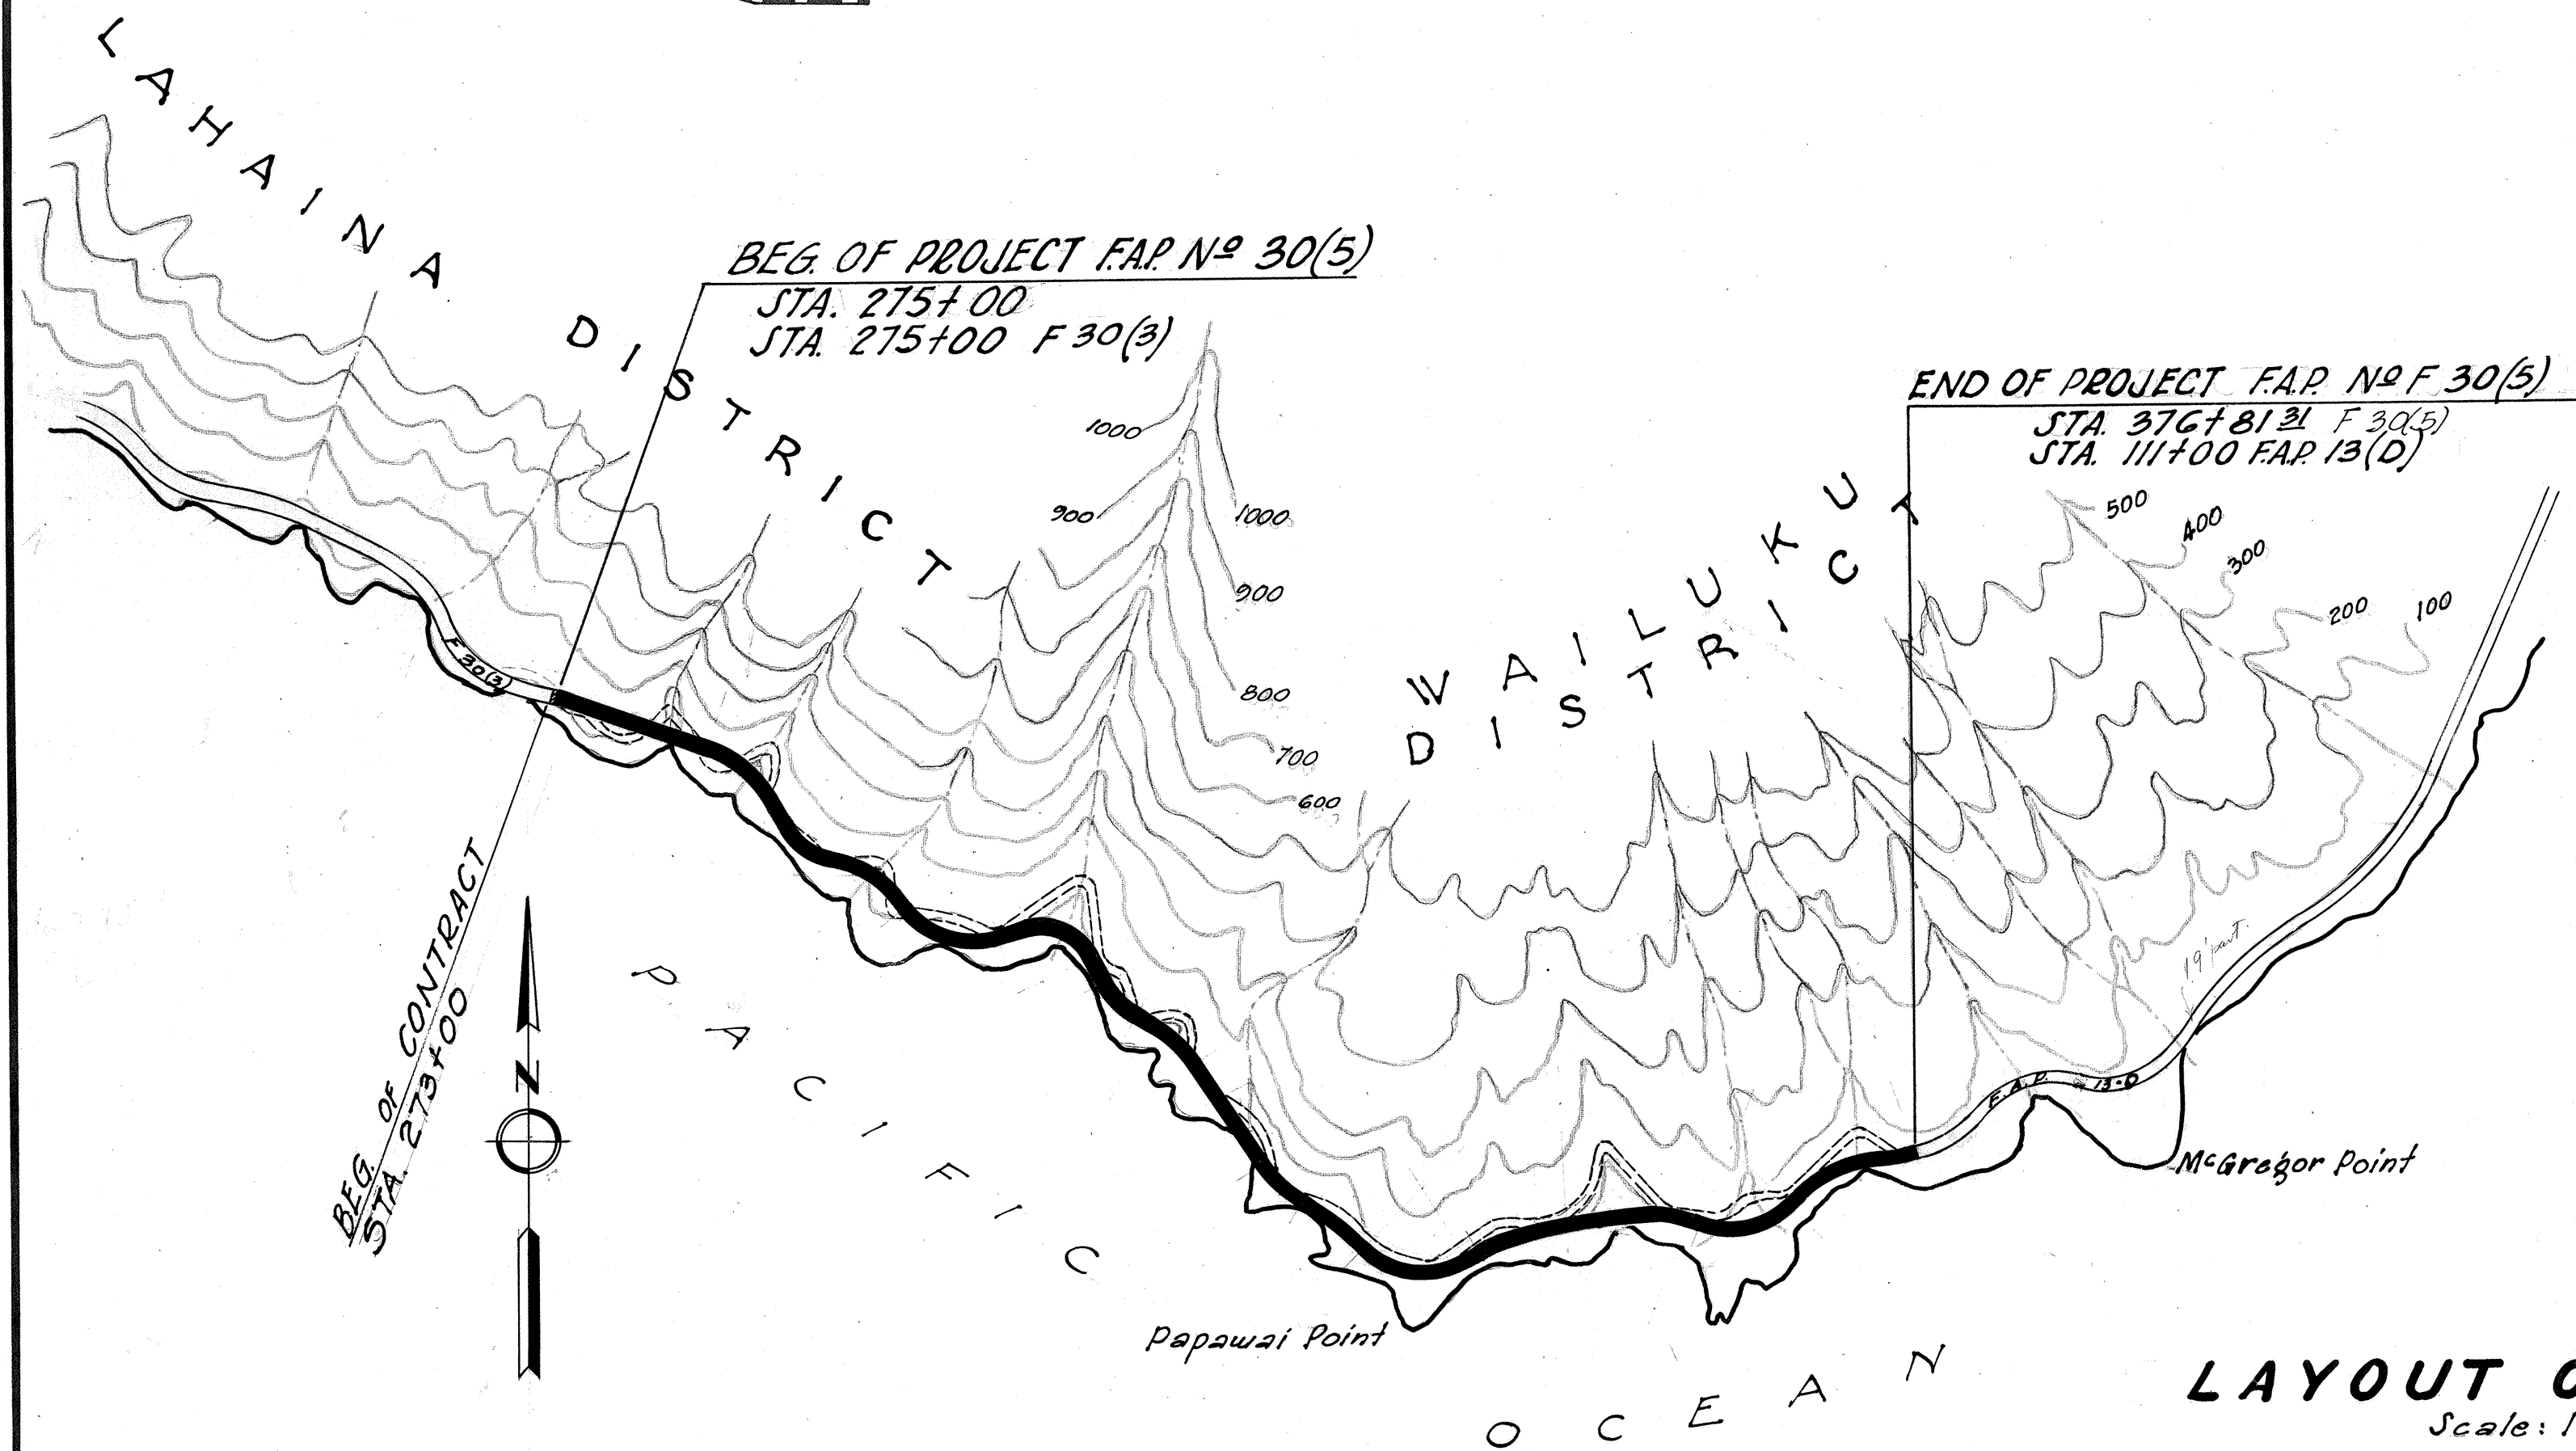

LAYOUT OF PROJECT

Scale: 1 inch = 1000 feet

GROSS LENGTH OF PROJECT	1.928 Miles
BRIDGES	0 "
NET LENGTH OF PROJECT	1.928 "

NOTE:

ALL CHANGES MADE DURING CONSTRUCTION
HAVE BEEN NOTED IN RED ON THESE
SHEETS AND CHECKED BY

[Signature]
DISTRICT ENGINEER
June 9, 1953
DATE

APPROVED: *[Signature]* DATE 9/17/53
TERRITORIAL HIGHWAY ENGINEER

DEPARTMENT OF COMMERCE
BUREAU OF PUBLIC ROADS
APPROVED: _____
DISTRICT ENGINEER DATE

5662.1