




Launiupoko

Launiupoko Stream

End of Project No. F-030-1(1) Sta. 233+90.71  
Beginning of Project No. F-30(4)

Hawaii National Guard Rifle Range

Olowalu-Launiupoko Boundary

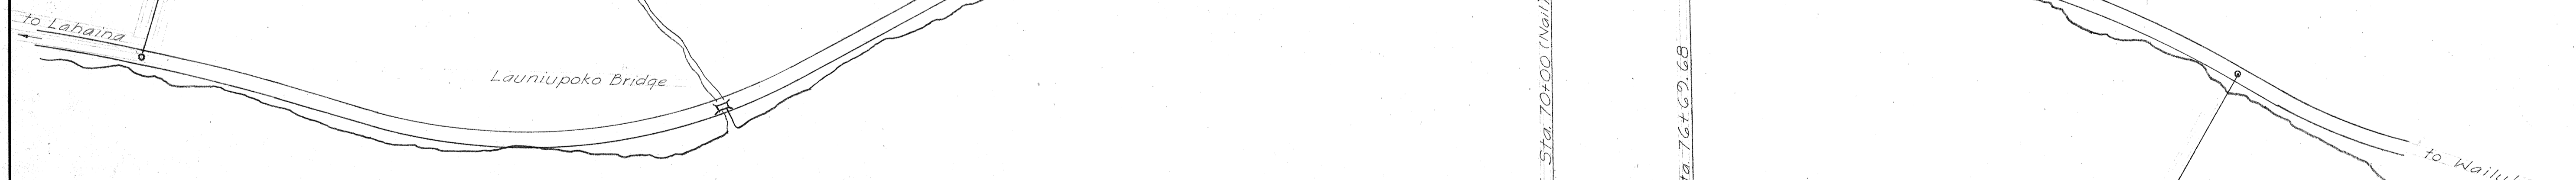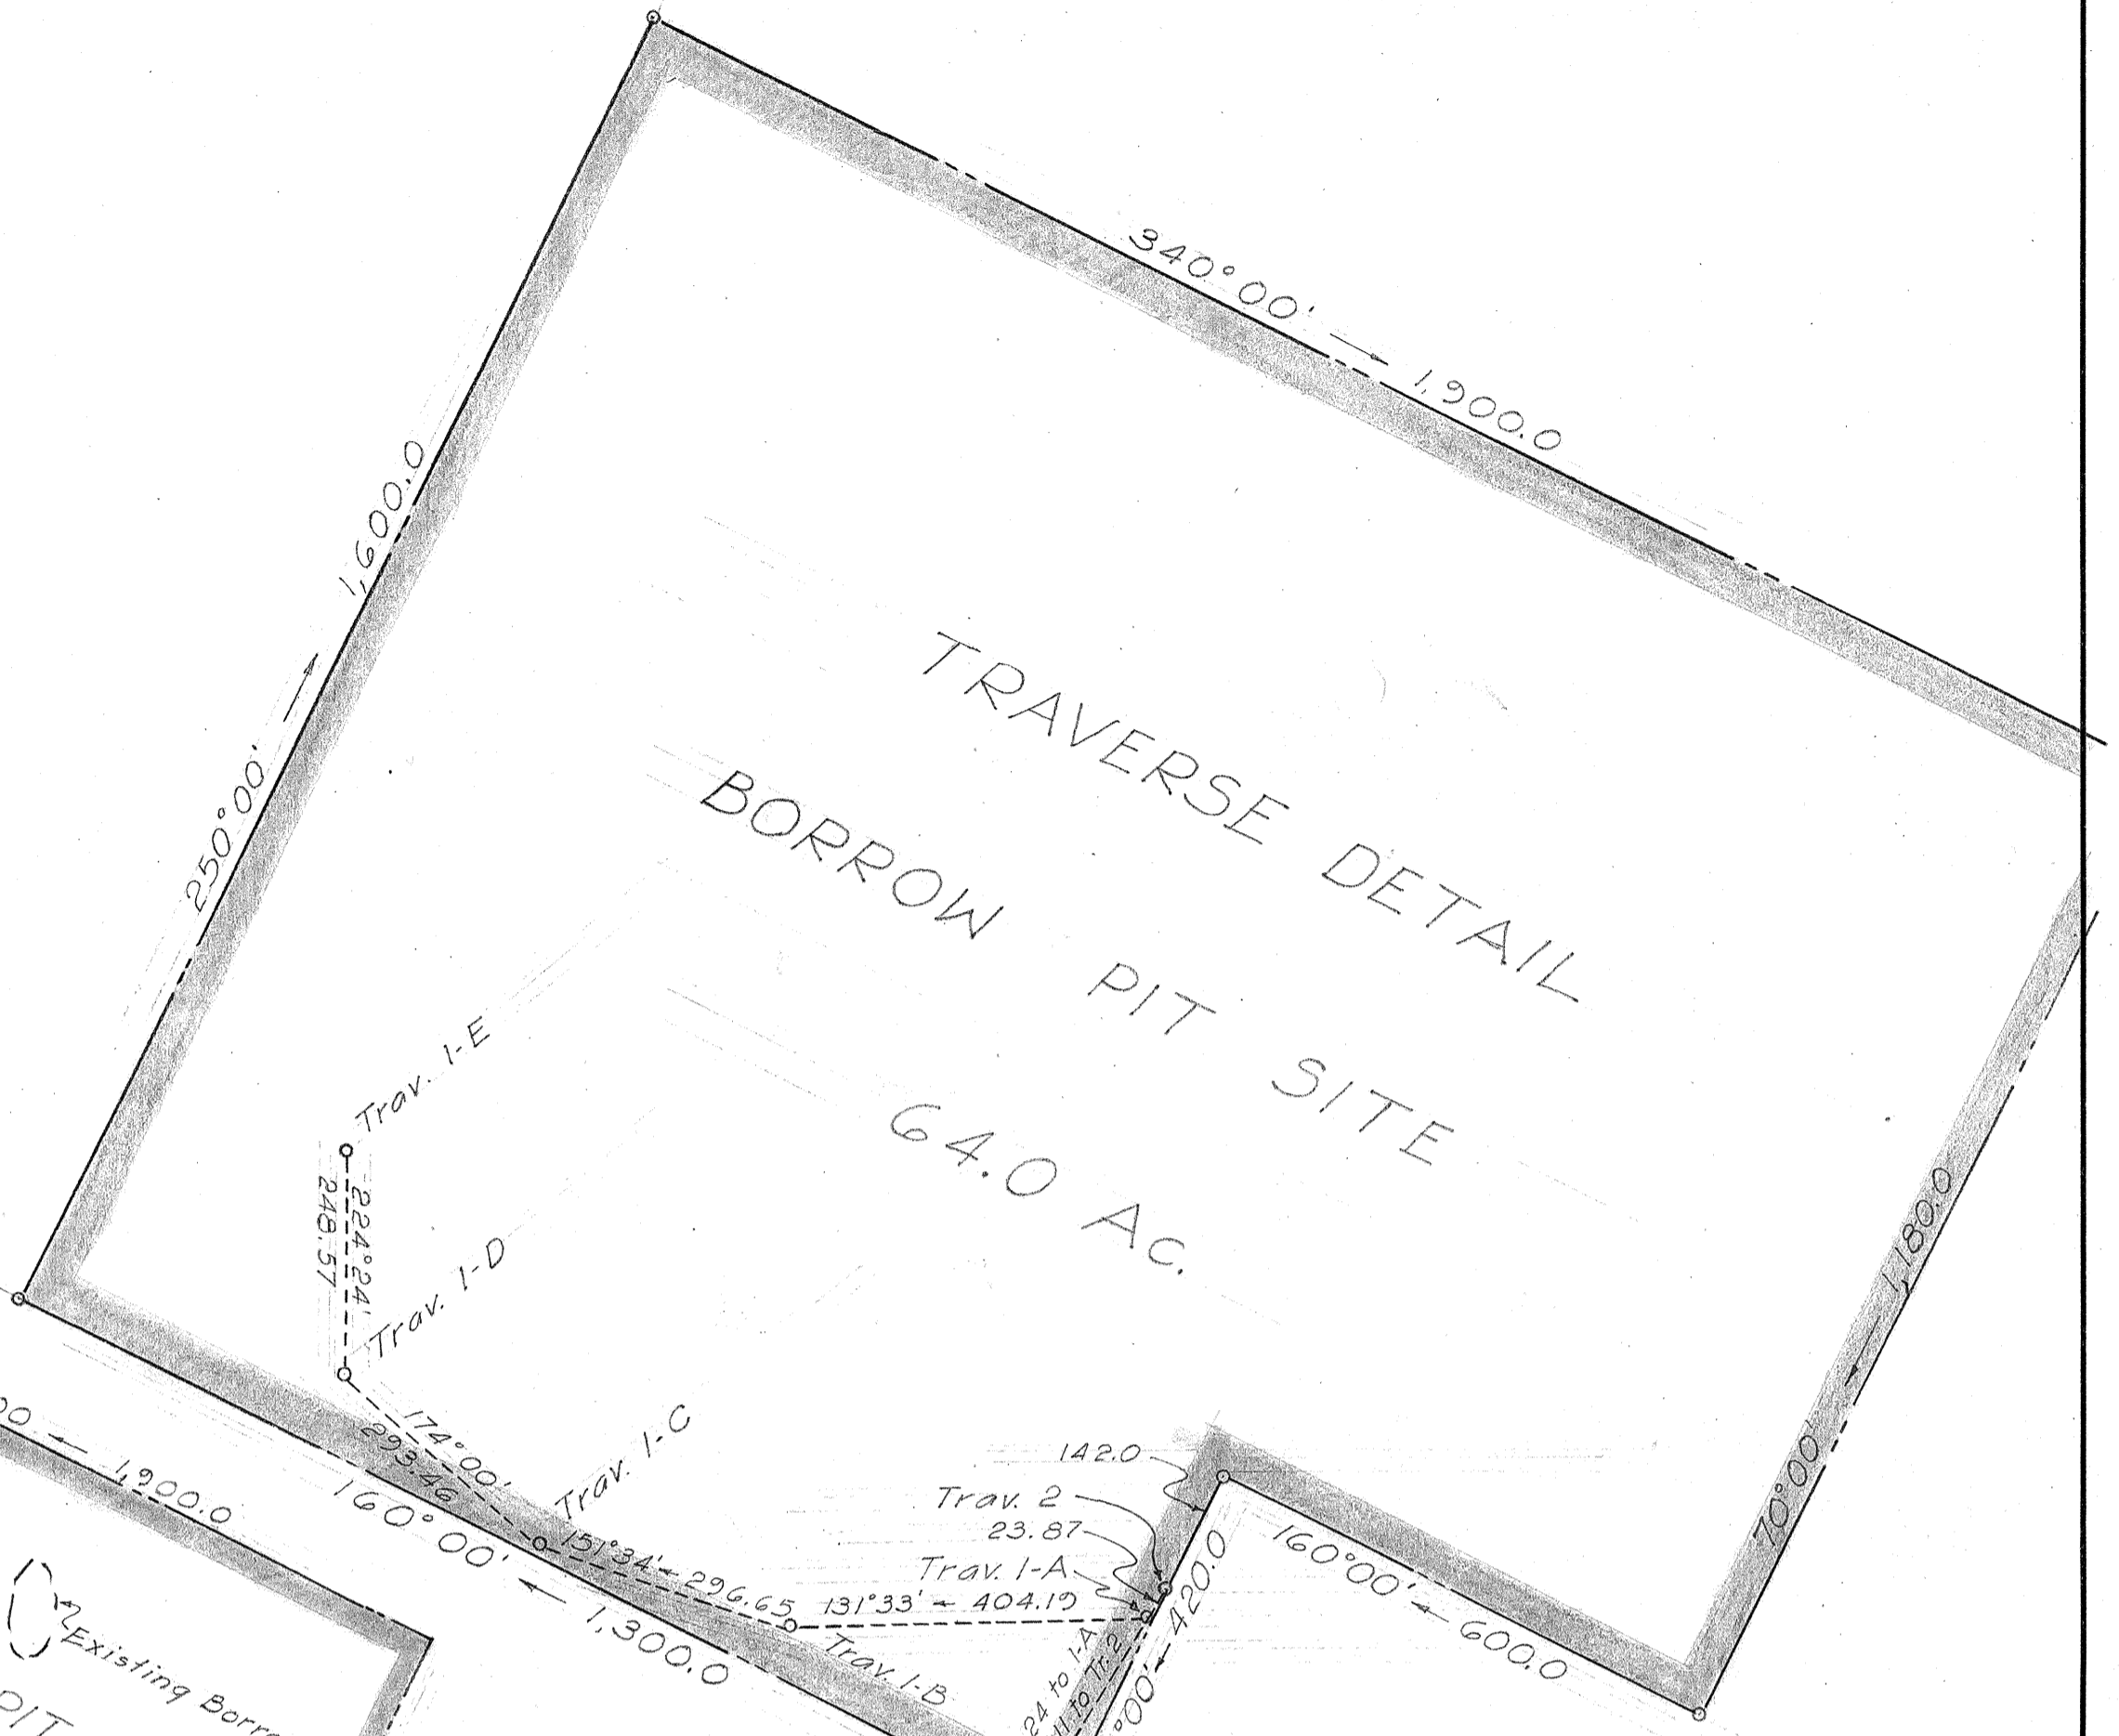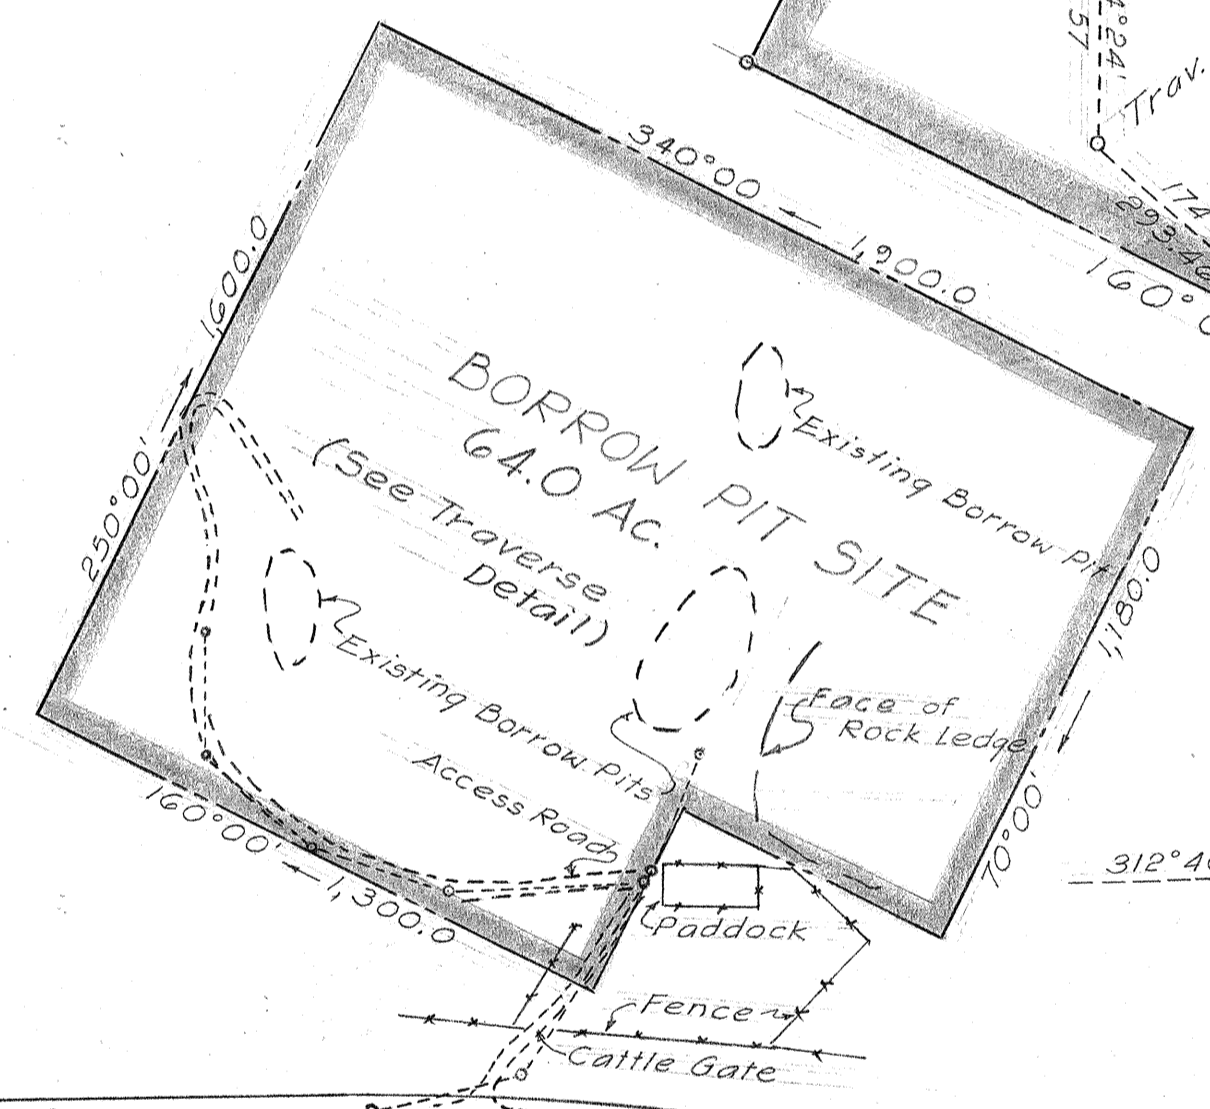

Note:  
Borrow Pit is located approximately 1.5 miles from end of project F-030-1(1)

SURVEY PLOTTED BY	DATE
DESIGNED BY	"
TRACED BY	"
QUANTITIES BY	"
CHECKED BY	"
NOTE BOOK No.	

TERRITORIAL HIGHWAY DEPARTMENT  
TERRITORY OF HAWAII  
LOCATION OF  
LAUNIUPOKO BORROW PIT  
LAHAINA - WAILUKU RD. PROJ. NO. F-030-1(1)  
Revised: Aug. 17, 1956  
December 1955  
Scale: 1" = 400'

SHEET NO. OF SHEETS

5795.3