



INDEX TO DRAWINGS	
SHEET NO	DESCRIPTION
1	TITLE SHEET
2	TYPICAL SECTION
3	BORROW PIT
4-12	PLAN & PROFILE
13-18	STANDARD DETAILS
19	INTERSECTION DETAILS
20	RELOCATION OF STRUCTURES
21	SIPHON DETAILS
22-34	BOX CULVERTS
35	STANDARD BRIDGE DETAILS
36-60	CROSS SECTIONS
3A-3B	LOCATION OF ROCK MOUNDS

CONVENTIONAL SIGNS	
Centerline	
Boundary Lines	
Fences (Named)	
Existing Roadways	
Circular Culvert	
Box Culvert	
Bridge	
Telephone Pole	
Electric Power Pole	
Water Main	
Storm Drain	
Concrete Drop Intake	
Standard Catch Basin	
Standard Manhole	
Sewer Manhole	
Telephone Manhole	
Fire Hydrant	
Trees (Named)	
Railroad	

TERRITORY OF HAWAII TERRITORIAL HIGHWAY DEPARTMENT HONOLULU, T. H.

"AS BUILT" PLANS OF LAHAINA - WAILUKU ROAD LAHAINA SECTION FEDERAL AID PROJECT NO. F 030-I(I) LAHAINA DISTRICT ISLAND OF MAUI

SCALE	
PLAN	1 IN. = 100 FT.
PROFILE	HOR. 1 IN. = 100 FT. VER. 1 IN. = 10 FT.
X-SECTIONS	HOR. 1 IN. = 10 FT. VER. 1 IN. = 10 FT.

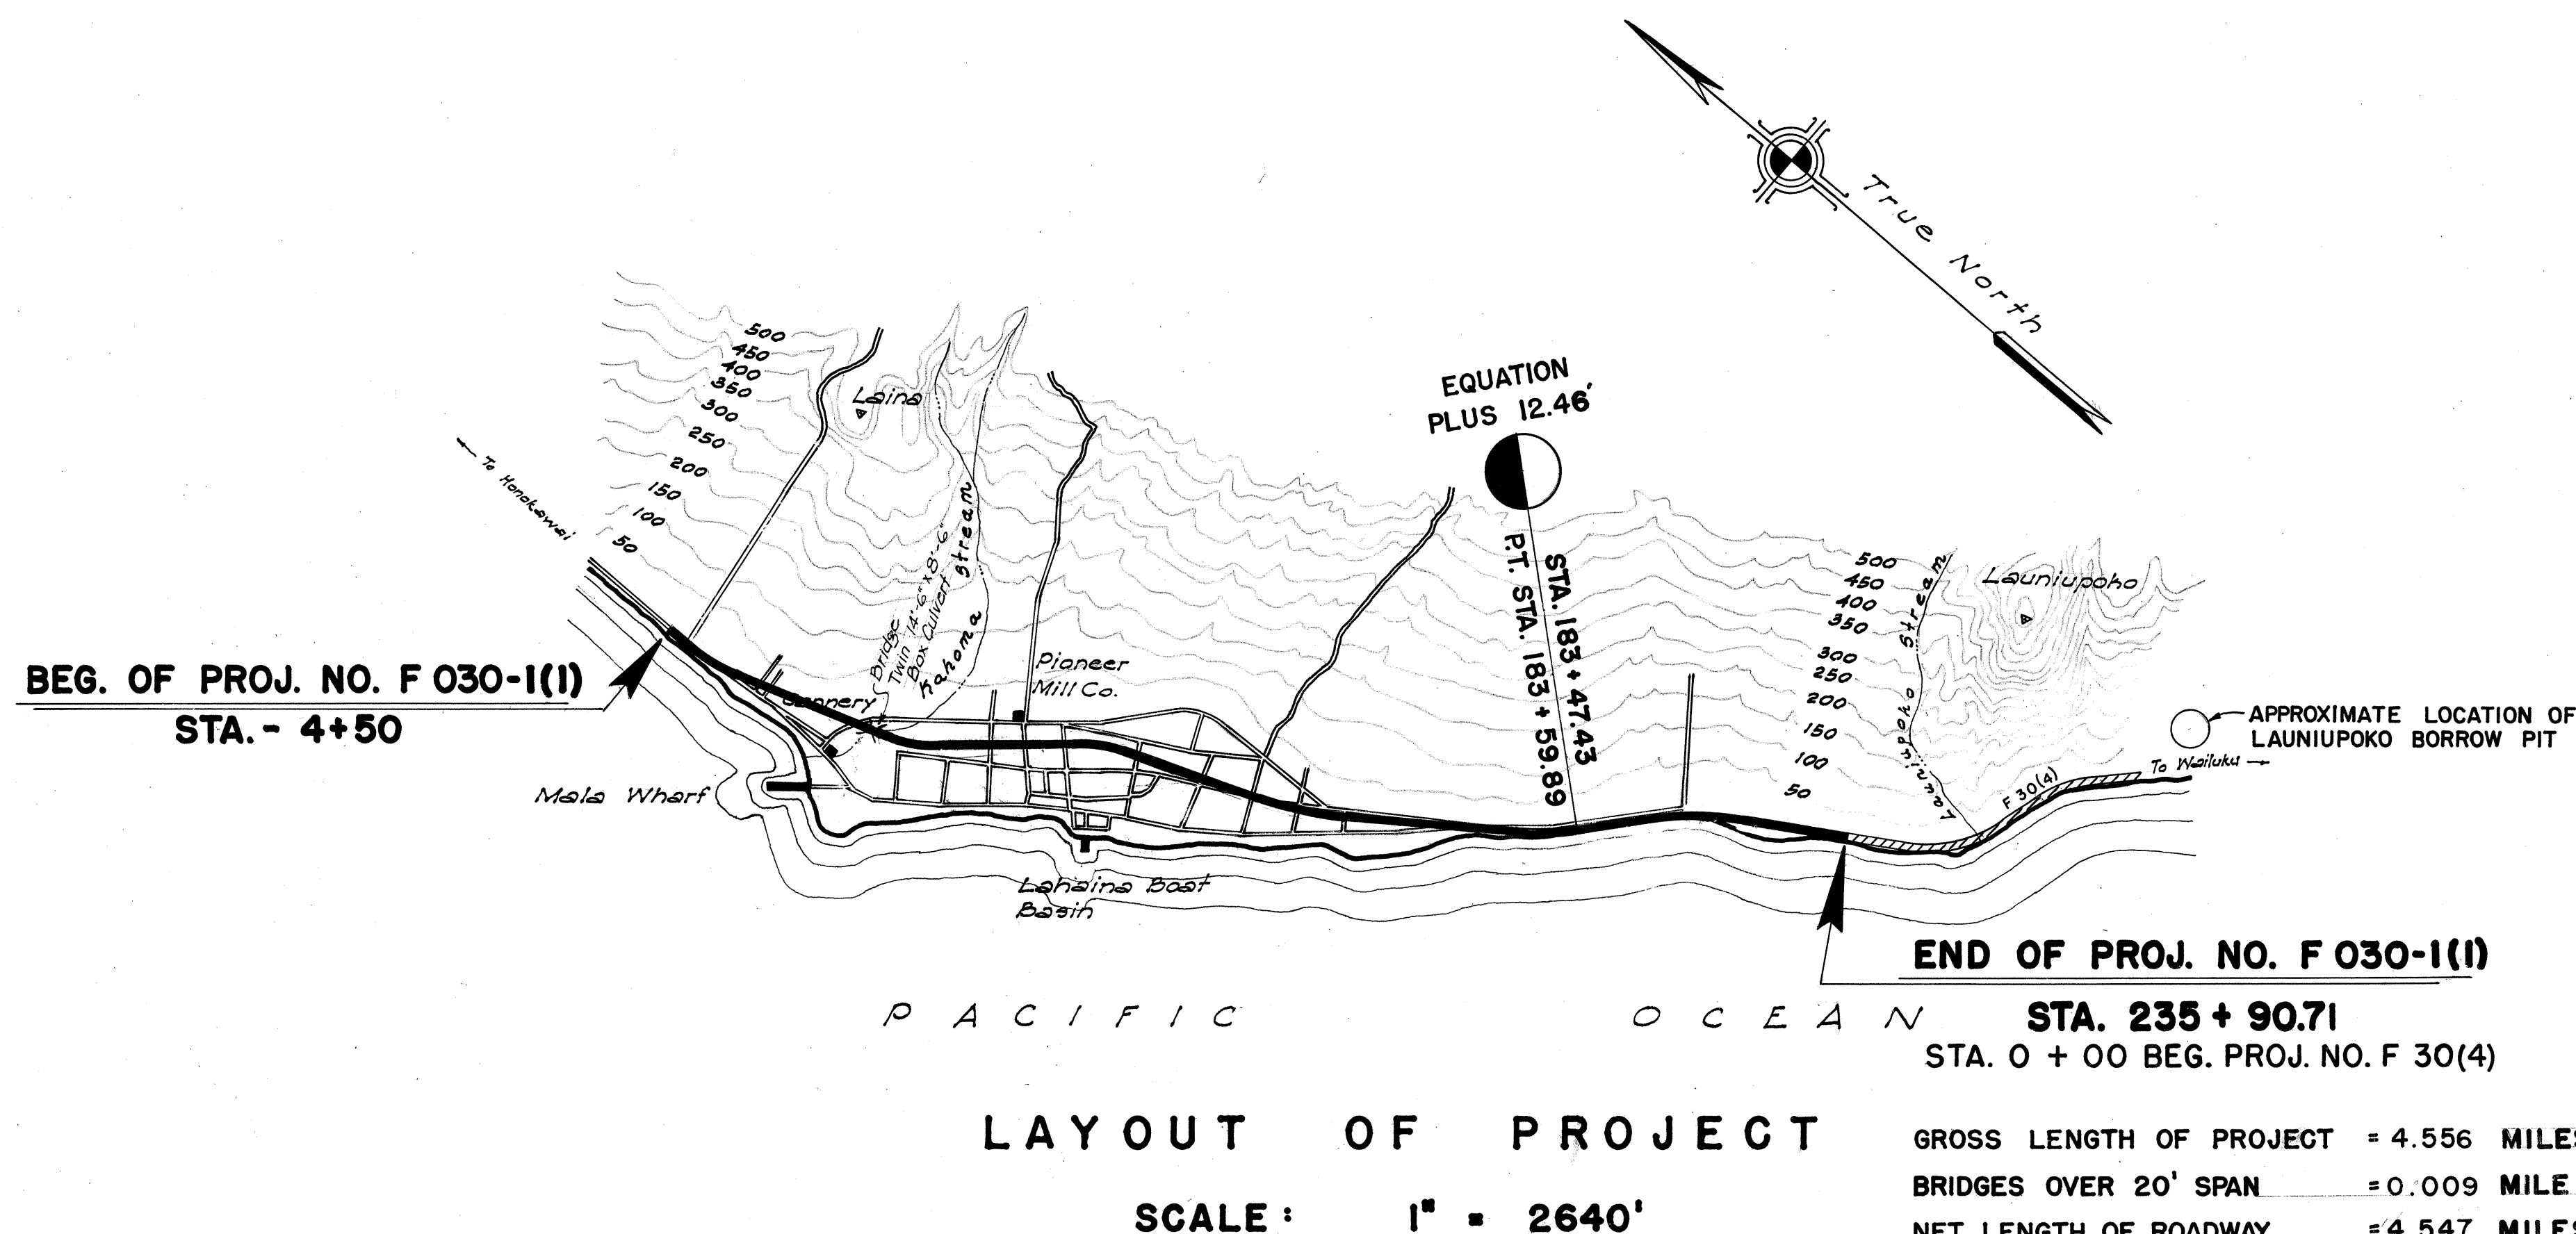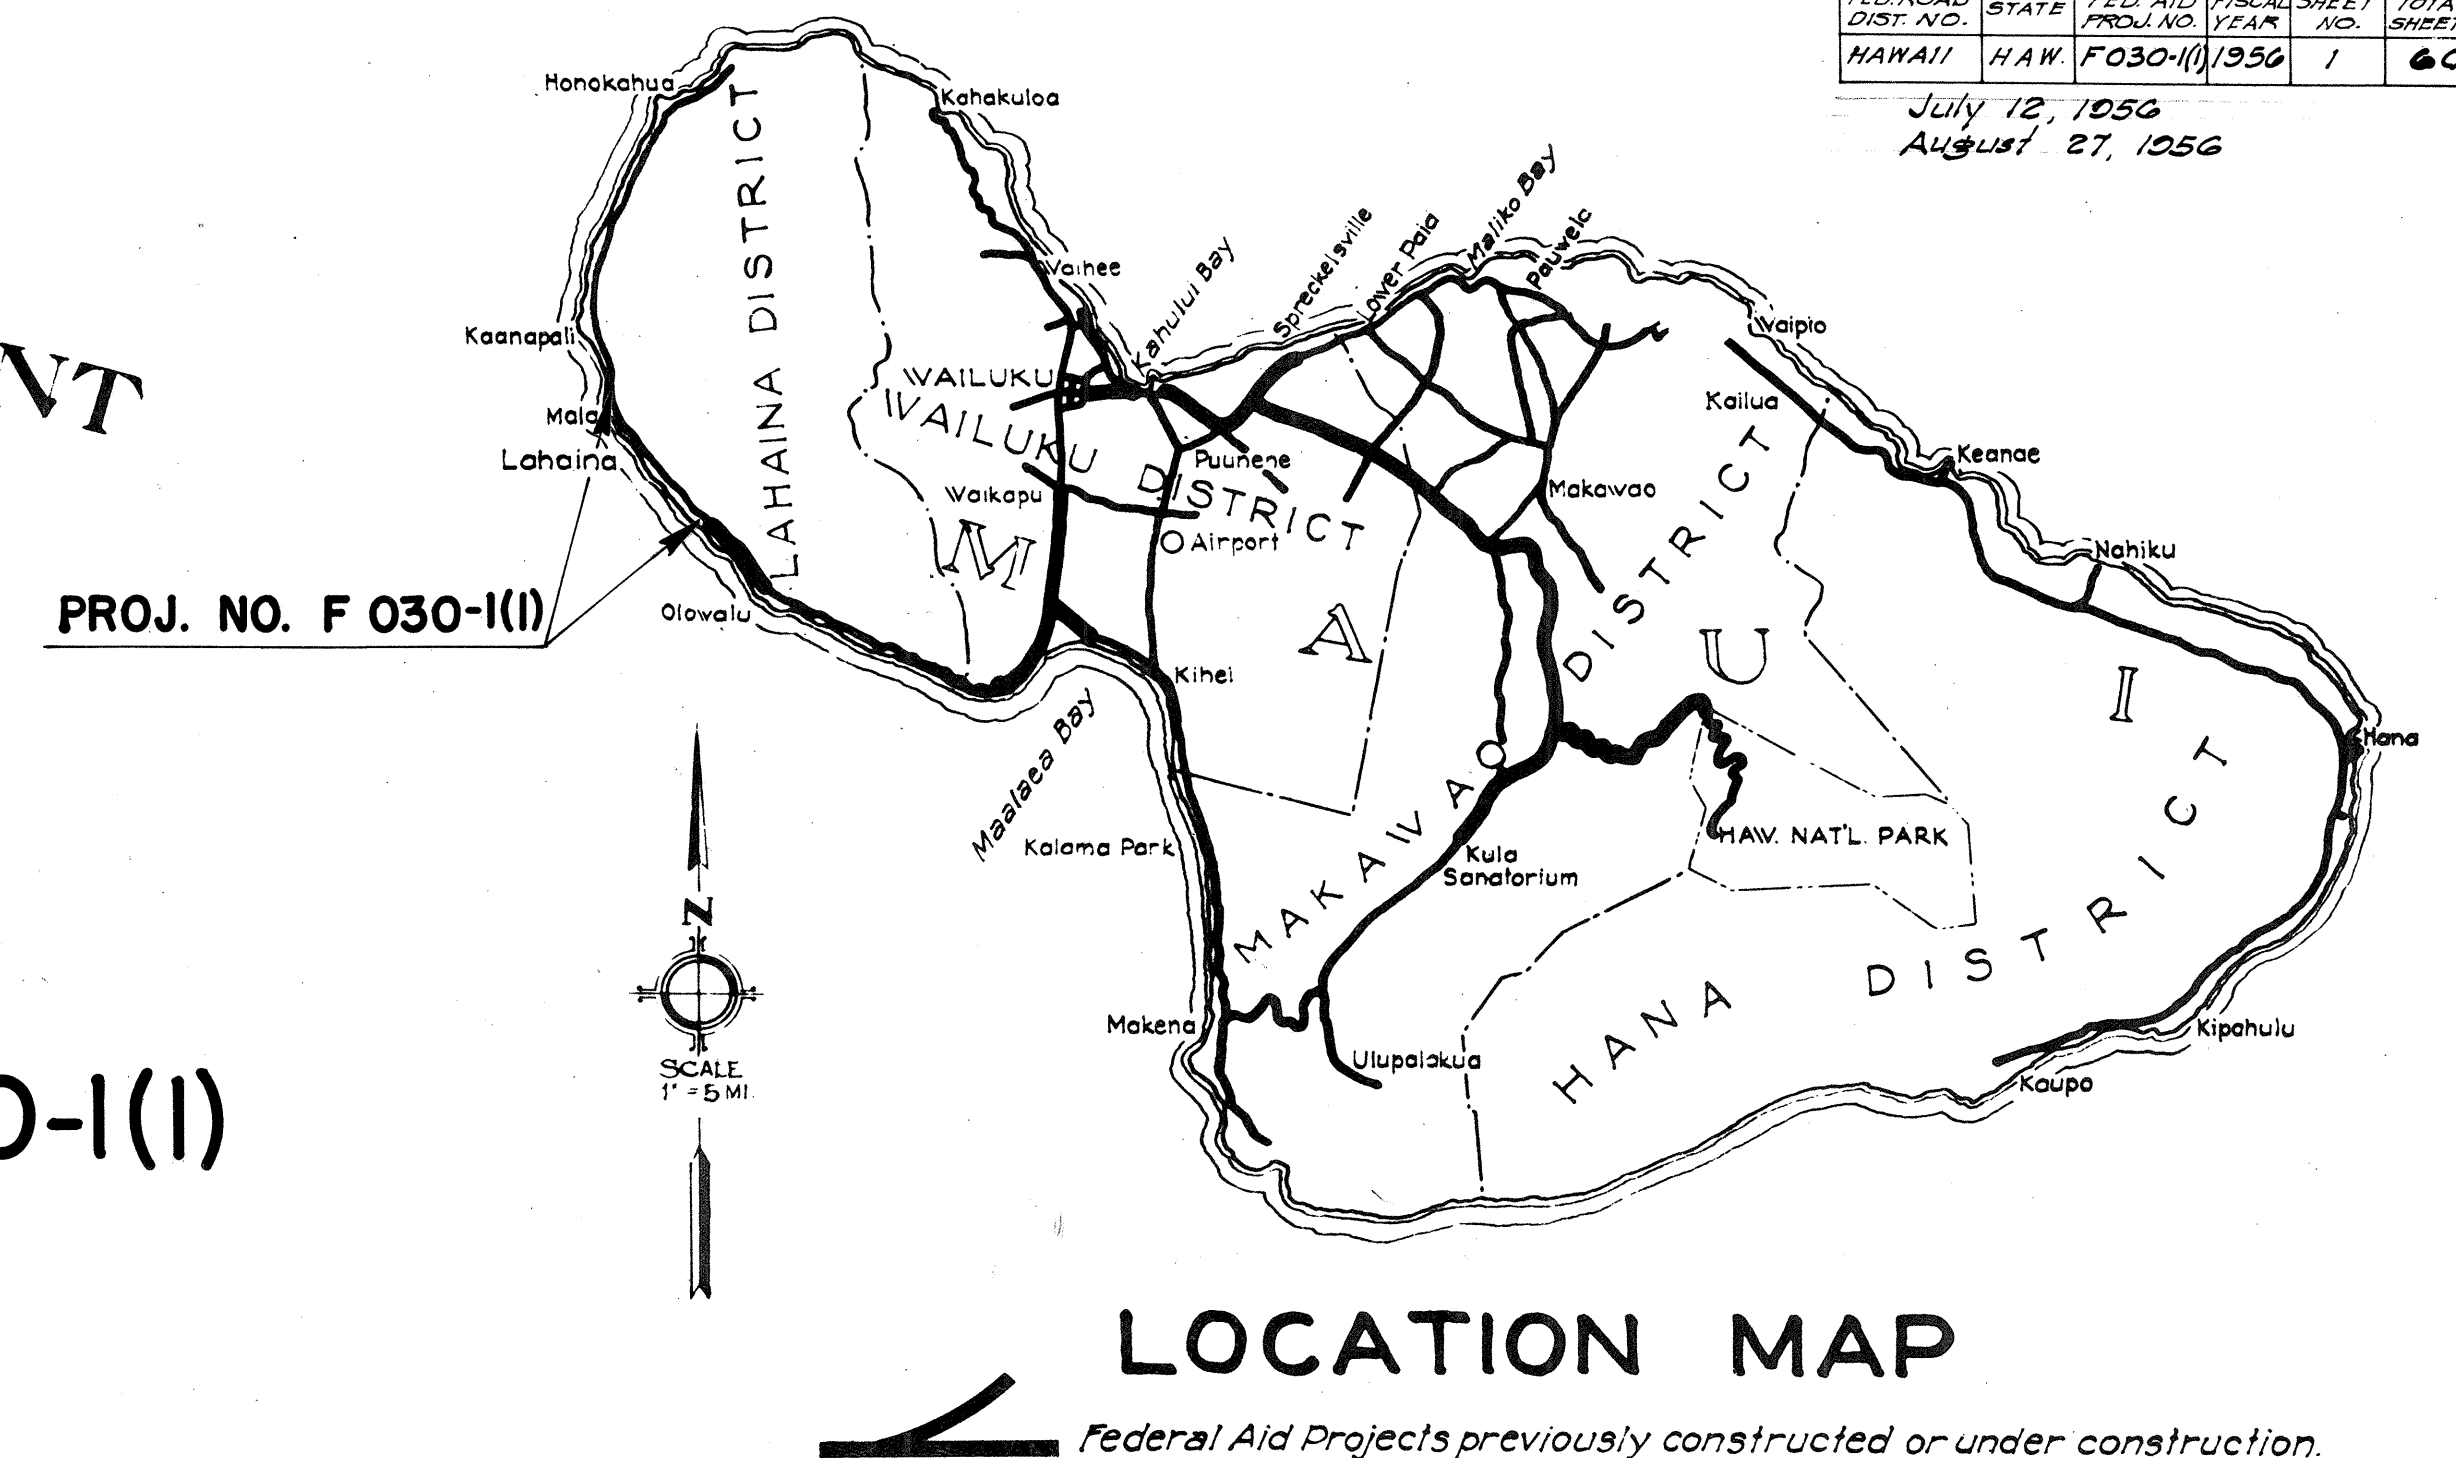

NOTE:
ALL CHANGES MADE DURING CONSTRUCTION
HAVE BEEN NOTED IN RED ON THESE TRACINGS
AND CHECKED BY:

[Signature]
DISTRICT ENGINEER
March 13 1958
DATE

APPROVED: DATE 3/13/58
[Signature]
ACT. TERRITORIAL HIGHWAY ENGINEER

DEPARTMENT OF COMMERCE
BUREAU OF PUBLIC ROADS
APPROVED:
DISTRICT ENGINEER DATE