
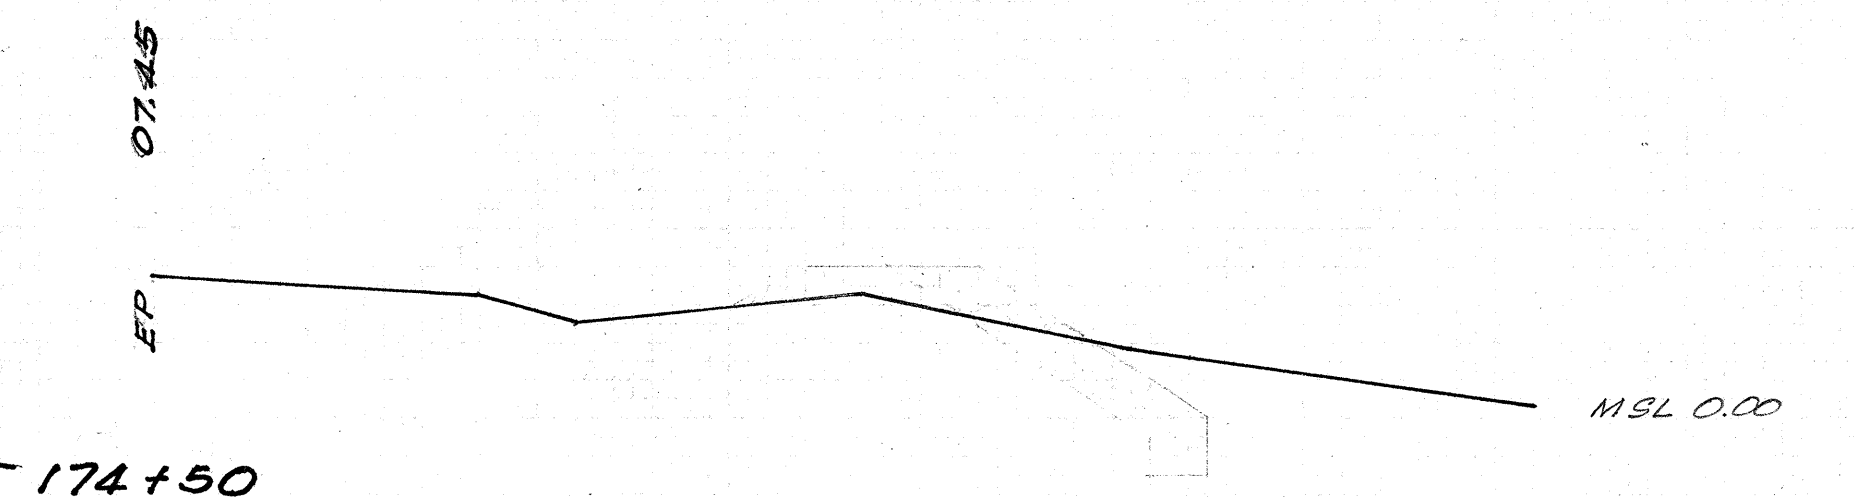
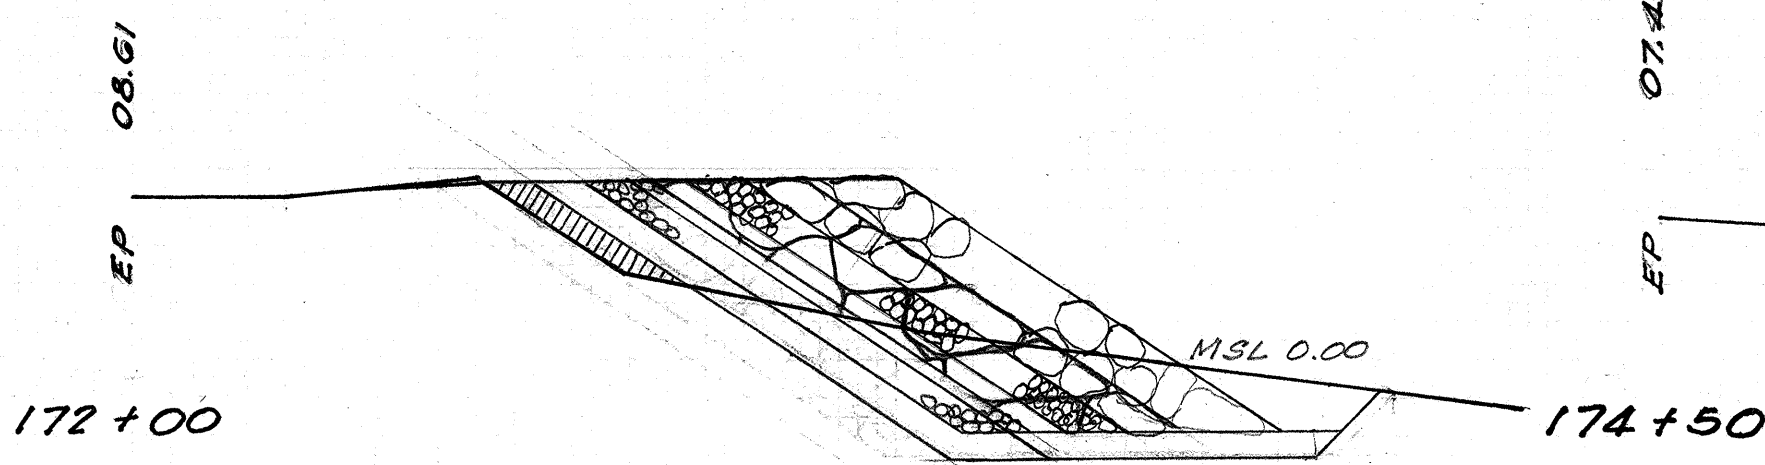
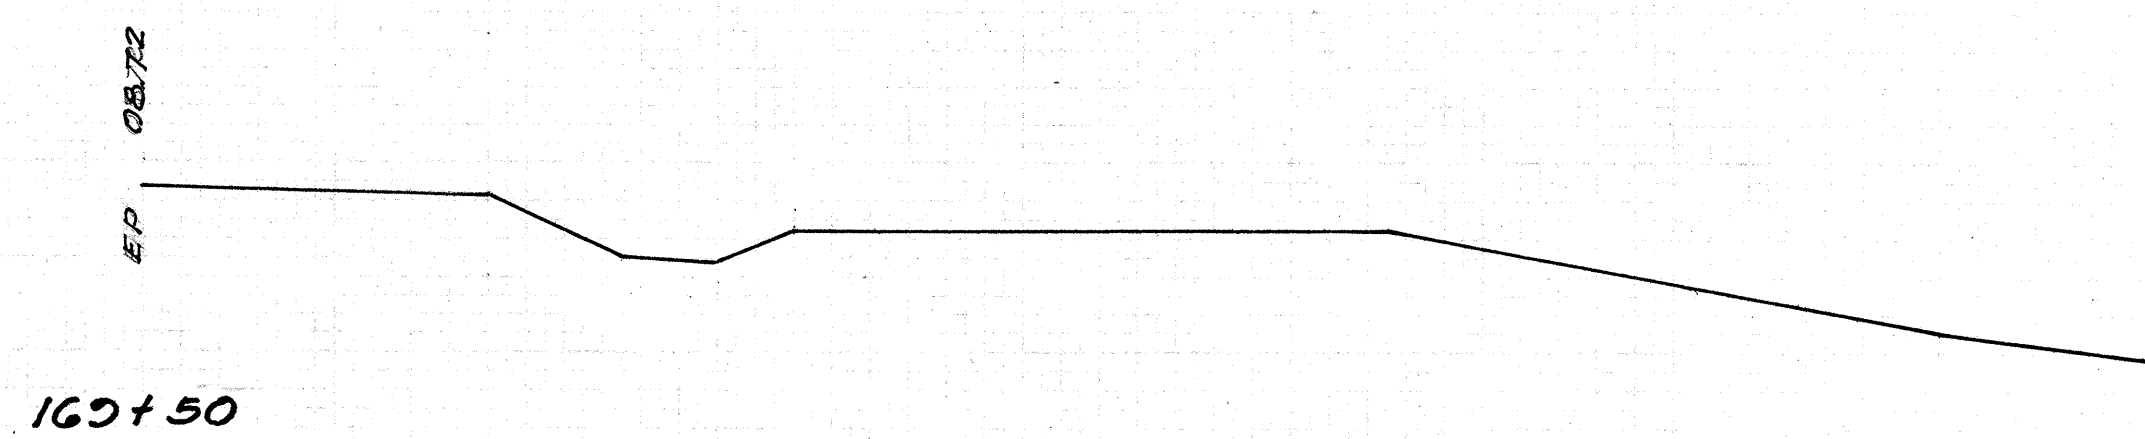
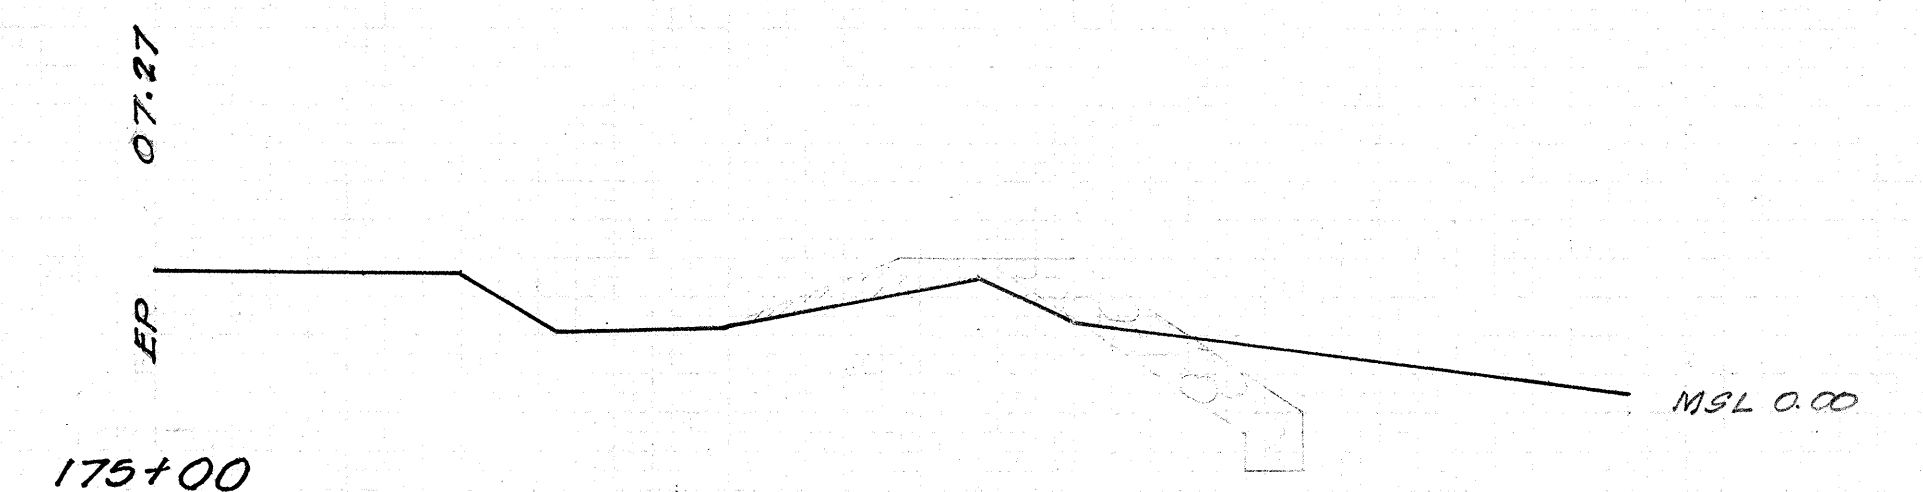
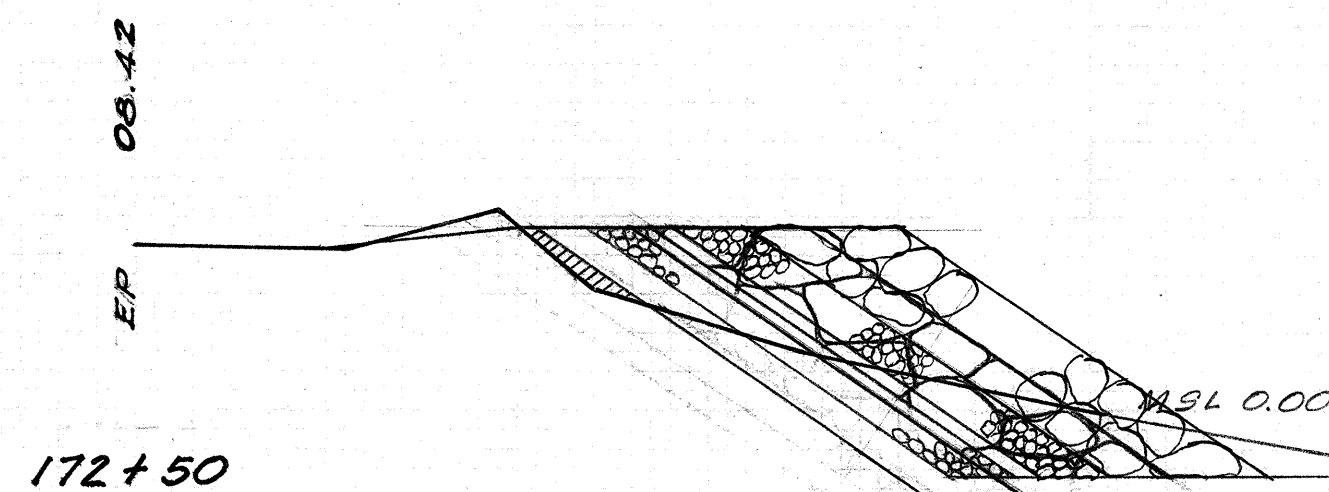
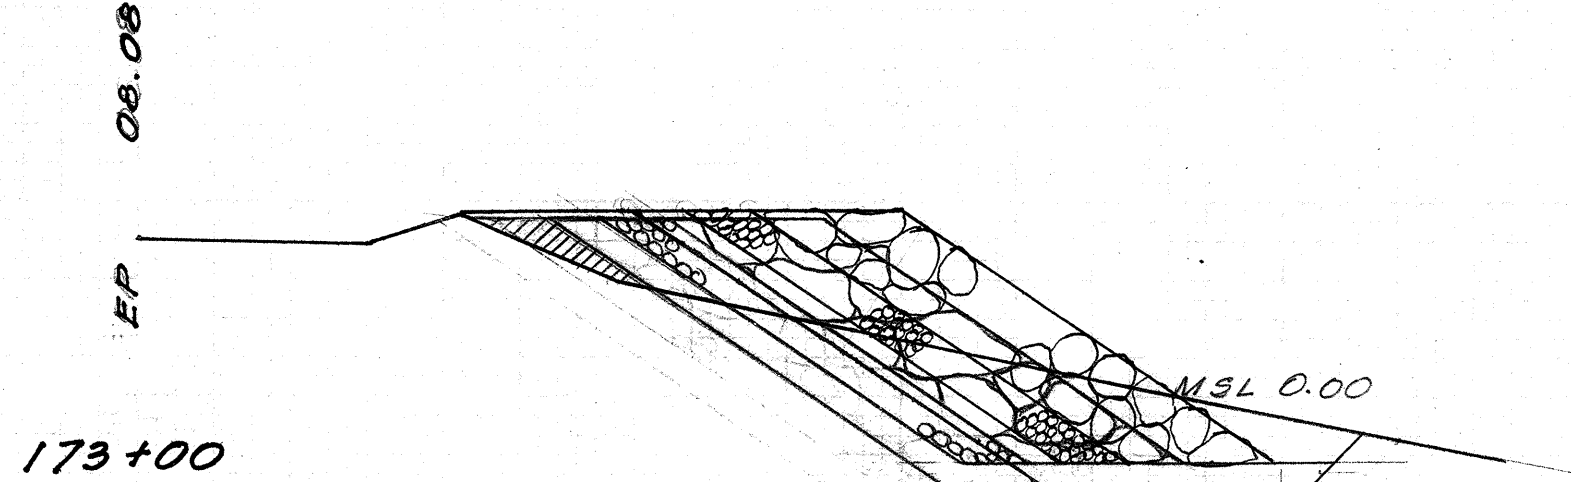
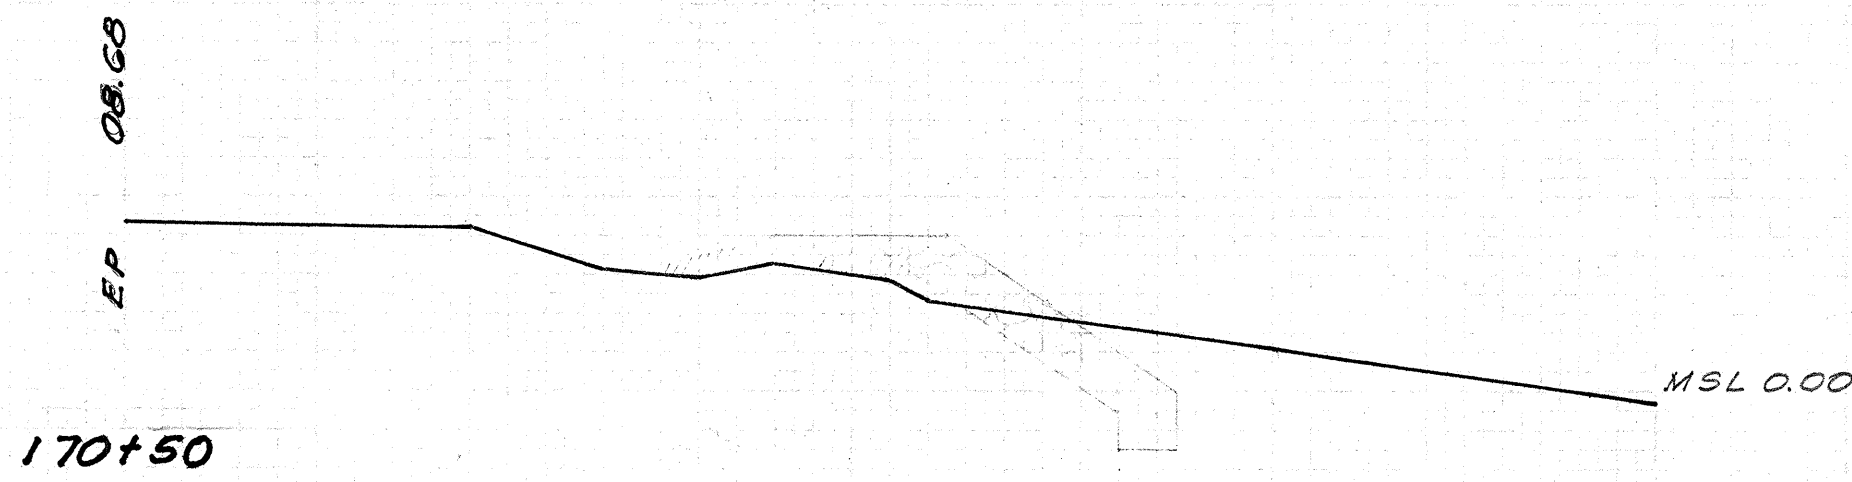
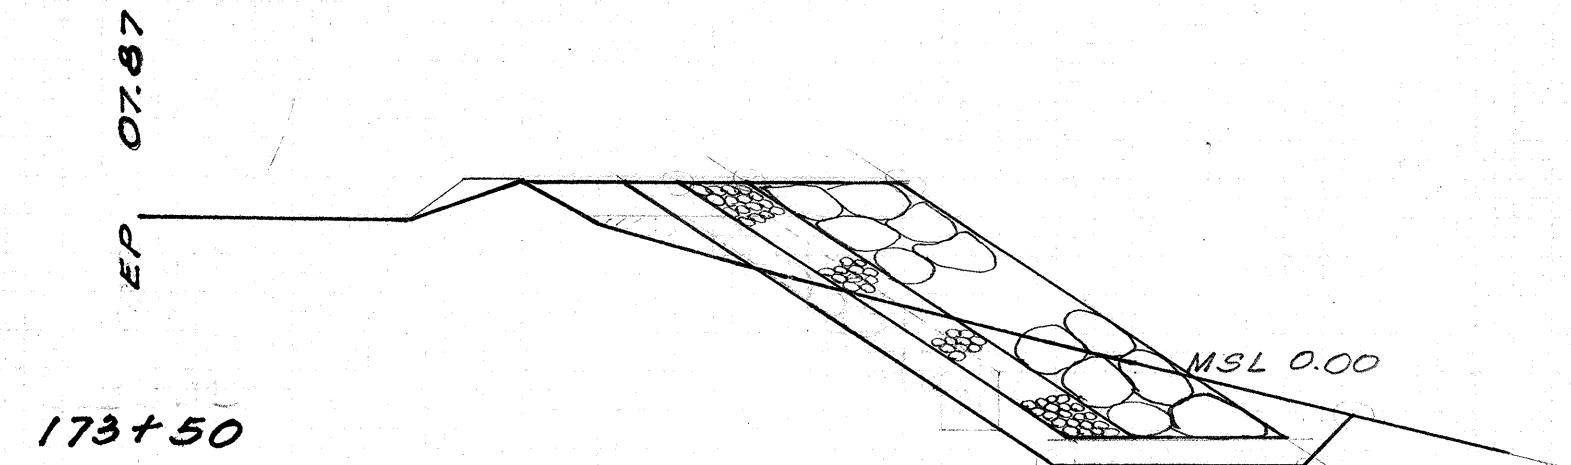
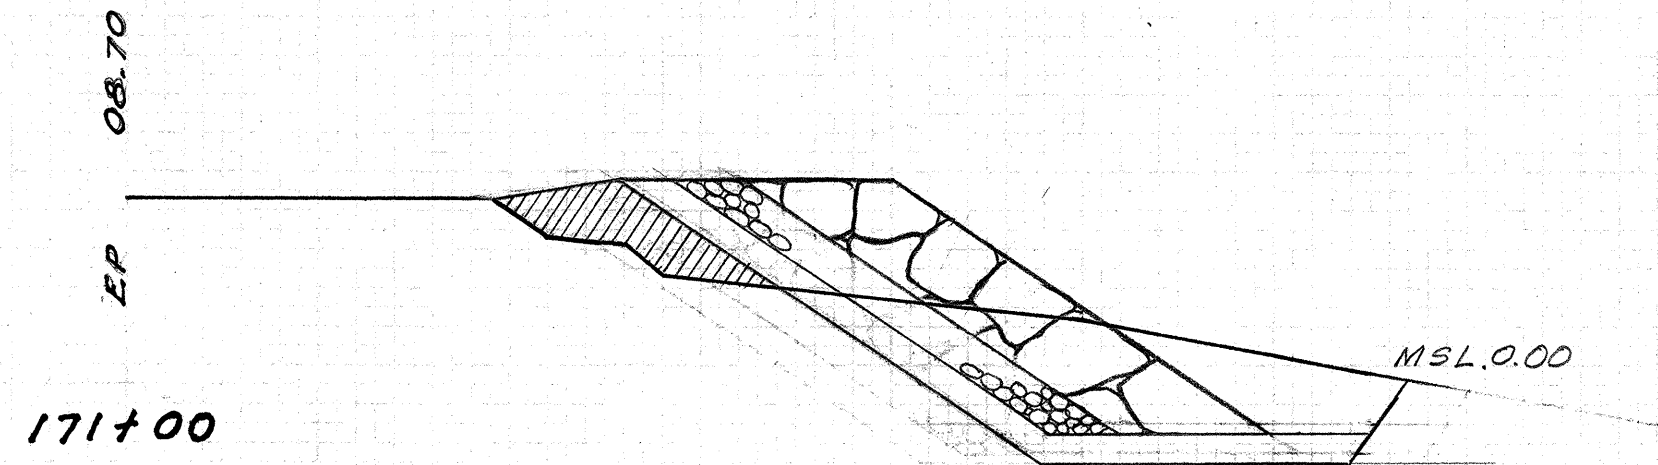
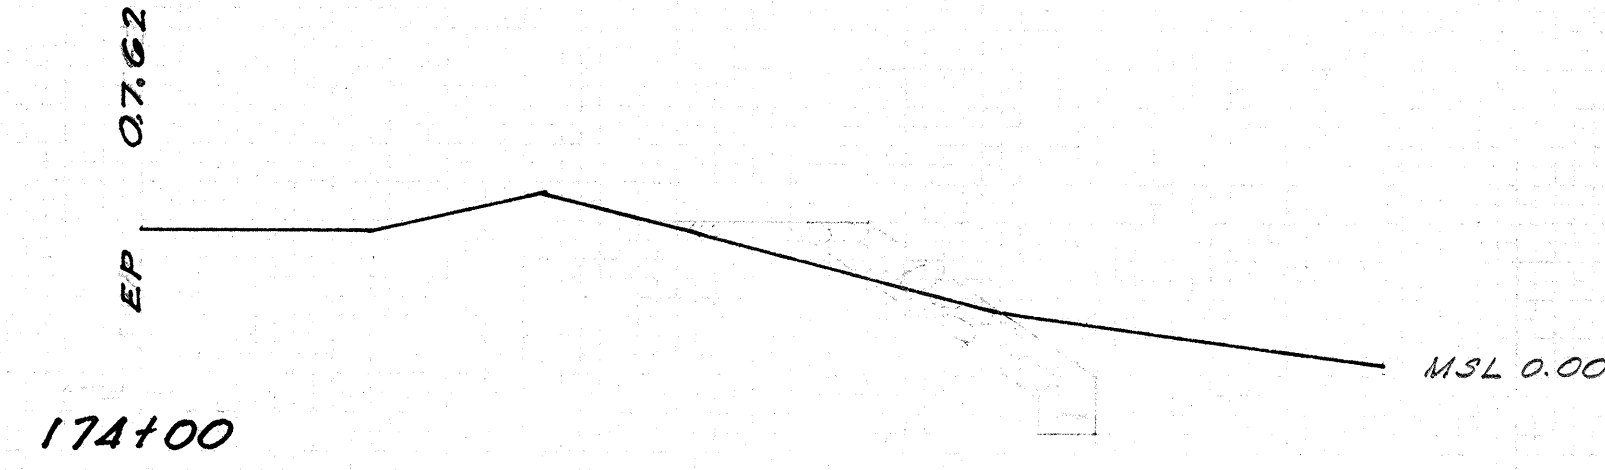


FED. ROAD DIST. NO.	STATE	PROJ. NO.	FISCAL YEAR	SHEET NO.	TOTAL SHEETS
HAWAII	HAW.	303-01-68	1967	2	2

Notes:

1. All elevations referred to Mean Sea Level.
2. Difference between Mean Lower Low Water and Mean Sea Level approximately 0.80 ft.
3. Edge of pavement shall be control for elevation and offsets.
4. All hatched areas to be backfilled with surplus excavated material.

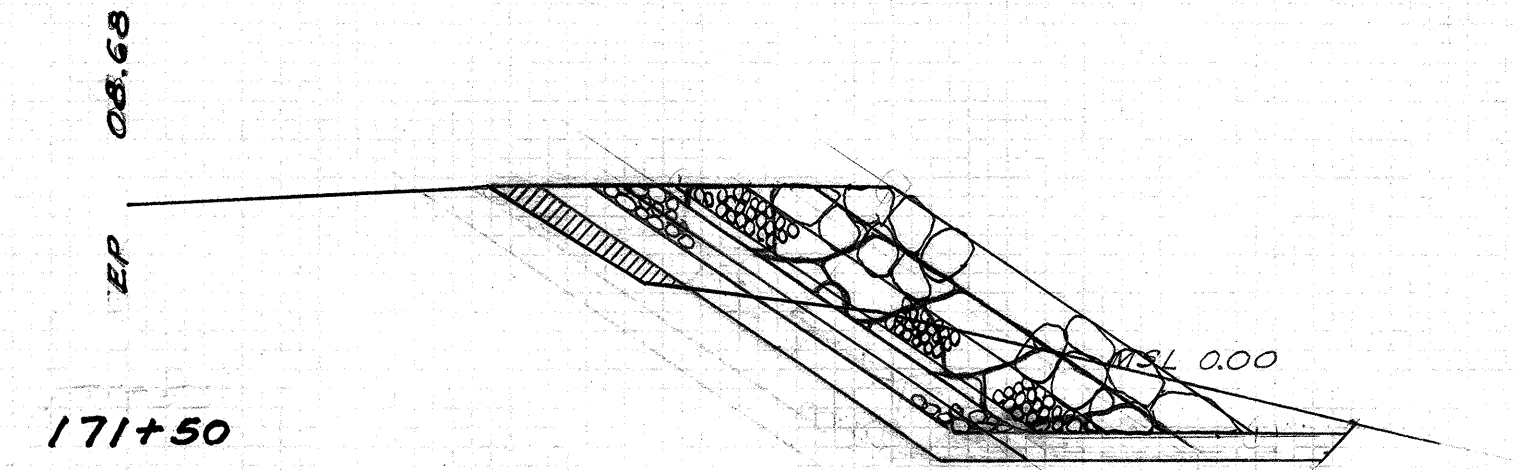

UKUMEHAME BEACH PARK